




- CONTRACTOR SHALL COORDINATE WITH MIDLAND COUNTY TO OBTAIN A SOIL EROSION & SEDIMENTATION CONTROL PERMIT BEFORE CONSTRUCTION.
- 2. CONTRACTOR TO VERIFY THAT ALL PERMITS ARE OBTAINED BEFORE STARTING

#### LANDSCAPE NOTES

- ALL LANDSCAPE MATERIALS SHALL BE HEALTHY AT THE TIME OF INSTALLATION.
- CONTRACTOR SHALL SUPPLY FINISH GRADE AND EXCAVATE AS NECESSARY TO SUPPLY A MINIMUM 6" TOPSOIL
- DEPTH IN ALL PLANTING BEDS AND 4" TOPSOIL IN ALL LAWN AREAS UNLESS NOTED OTHERWISE. 3. ALL TOPSOIL SHALL BE IMPORTED AND SCREENED. EXISTING TOPSOIL MAY ONLY BE REUSED IF APPROVED BY THE OWNER'S REPRESENTATIVE.
- 4. THE CONTRACTOR SHALL GUARANTEE ALL PLANTS TO BE IN A HEALTHY CONDITION FOR A PERIOD OF TWO YEARS FOLLOWING ACCEPTANCE. CONTRACTOR SHALL REPLACE WITHOUT COST TO THE OWNER ANY DEAD OR
- UNACCEPTABLE PLANTS, AS DETERMINED BY THE OWNER'S REPRESENTATIVE DURING AND AT THE END OF THE GUARANTEE PERIOD.
- 5. ALL PLANTINGS SHALL CONFORM TO ANSI 260.1 OR CURRENT EDITION. AREAS SPECIFIED WITH PLANT MATERIAL SHALL BE FINE GRADED AND SEEDED FOR TURF ESTABLISHMENT.
- 7. ALL EXCESS EXCAVATED MATERIALS AND DEBRIS WHICH ARE NOT ACCEPTED FOR DISPOSAL ON SITE BY THE OWNER SHALL BE REMOVED FROM THE SITE BY THE CONTRACTOR AND DISPOSED OF LEGALLY OFF SITE. 8. ALL LANDSCAPE AREAS SHALL HAVE PROPER DRAINAGE THAT PREVENTS EXCESS WATER FROM STANDING ON LAWN
- AREAS OR AROUND TREES & SHRUBS. 9. THE OWNER'S REPRESENTATIVE RESERVES THE RIGHT TO REJECT ANY MATERIAL NOT MEETING SPECIFICATIONS.
- 10. THE CONTRACTOR SHALL PLACE 4" OF SHREDDED BARK MULCH IN LANDSCAPE BEDS PER SPECIFICATIONS.
- 11. ALL LANDSCAPING SHALL BE MAINTAINED IN A HEALTHY ENVIRONMENT. THE OWNER SHALL MAINTAIN THE LANDSCAPING USING OWN STAFF OR CONTRACT WITH AN OUTSIDE LANDSCAPING SERVICE.

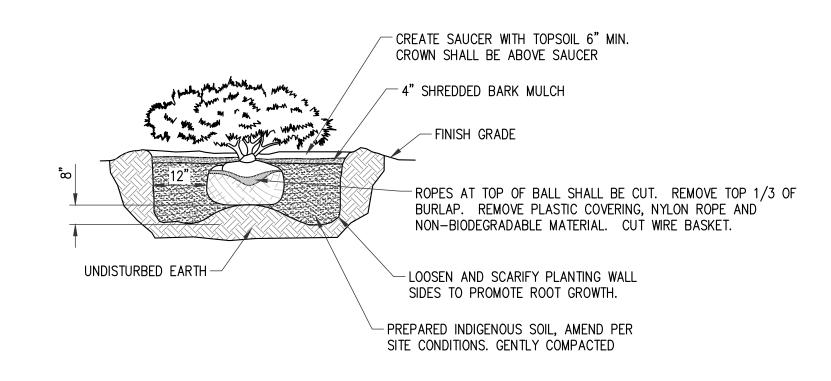

#### SHRUB PLANTING DETAIL

PLANT SCHEDULE					
SYM	KEY	BOTANICAL NAME	COMMON NAME	NOTES	QUANTITY
0	VC	VIBURNUM CARLESII	KOREAN SPICE VIBURNUM	NO. 5 CONT.	8 @ 5' SPACING
*	JC	JUNIPERUS CHINENSIS 'SEA GREEN'	SEA GREEN JUNIPER	NO. 5 CONT.	4 @ 5' SPACING




PROJECT DATE

CHECKED BY

DRS


AUGUST 31, 2023

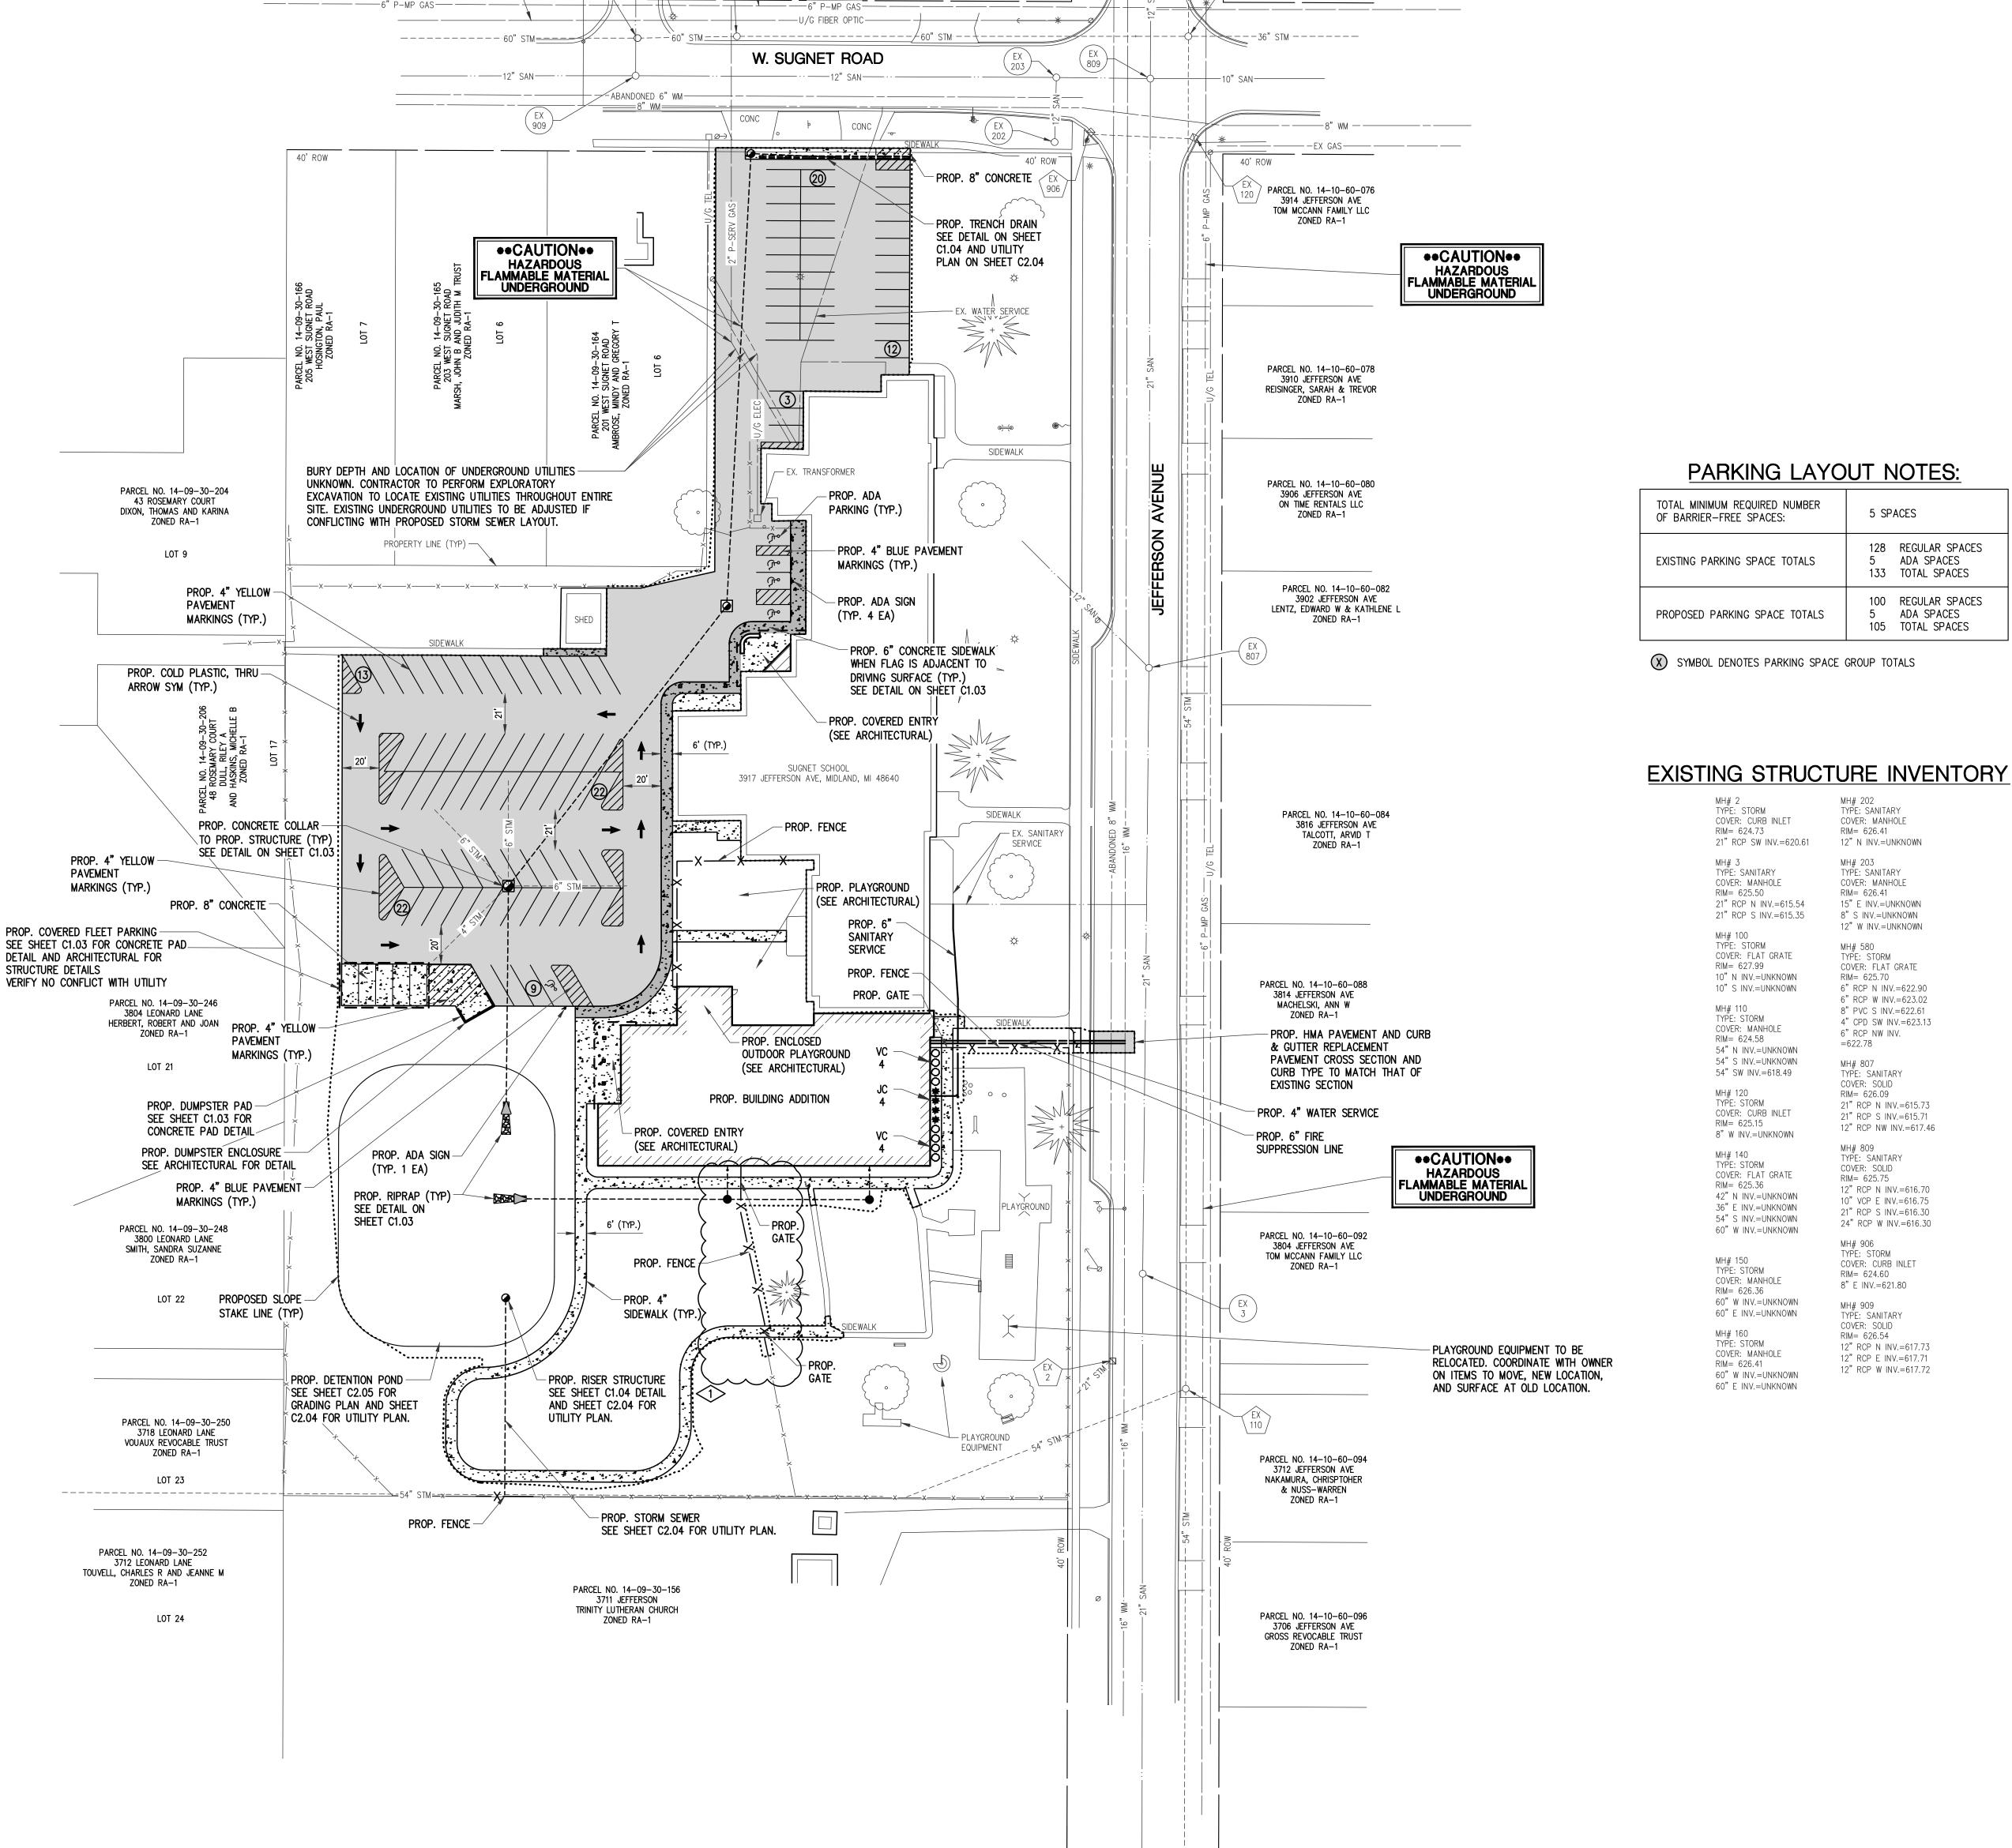


14-09-20-170, 14-09-20-172, 14-09-20-174, 14-09-20-176 4007 & 4015 JEFFERSON AVE MACNELLIS, SCOTT & EMILY

••CAUTION••

HAZARDOUS FLAMMABLE MATERIAL UNDERGROUND

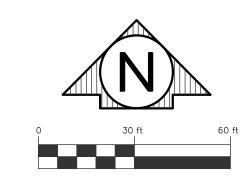

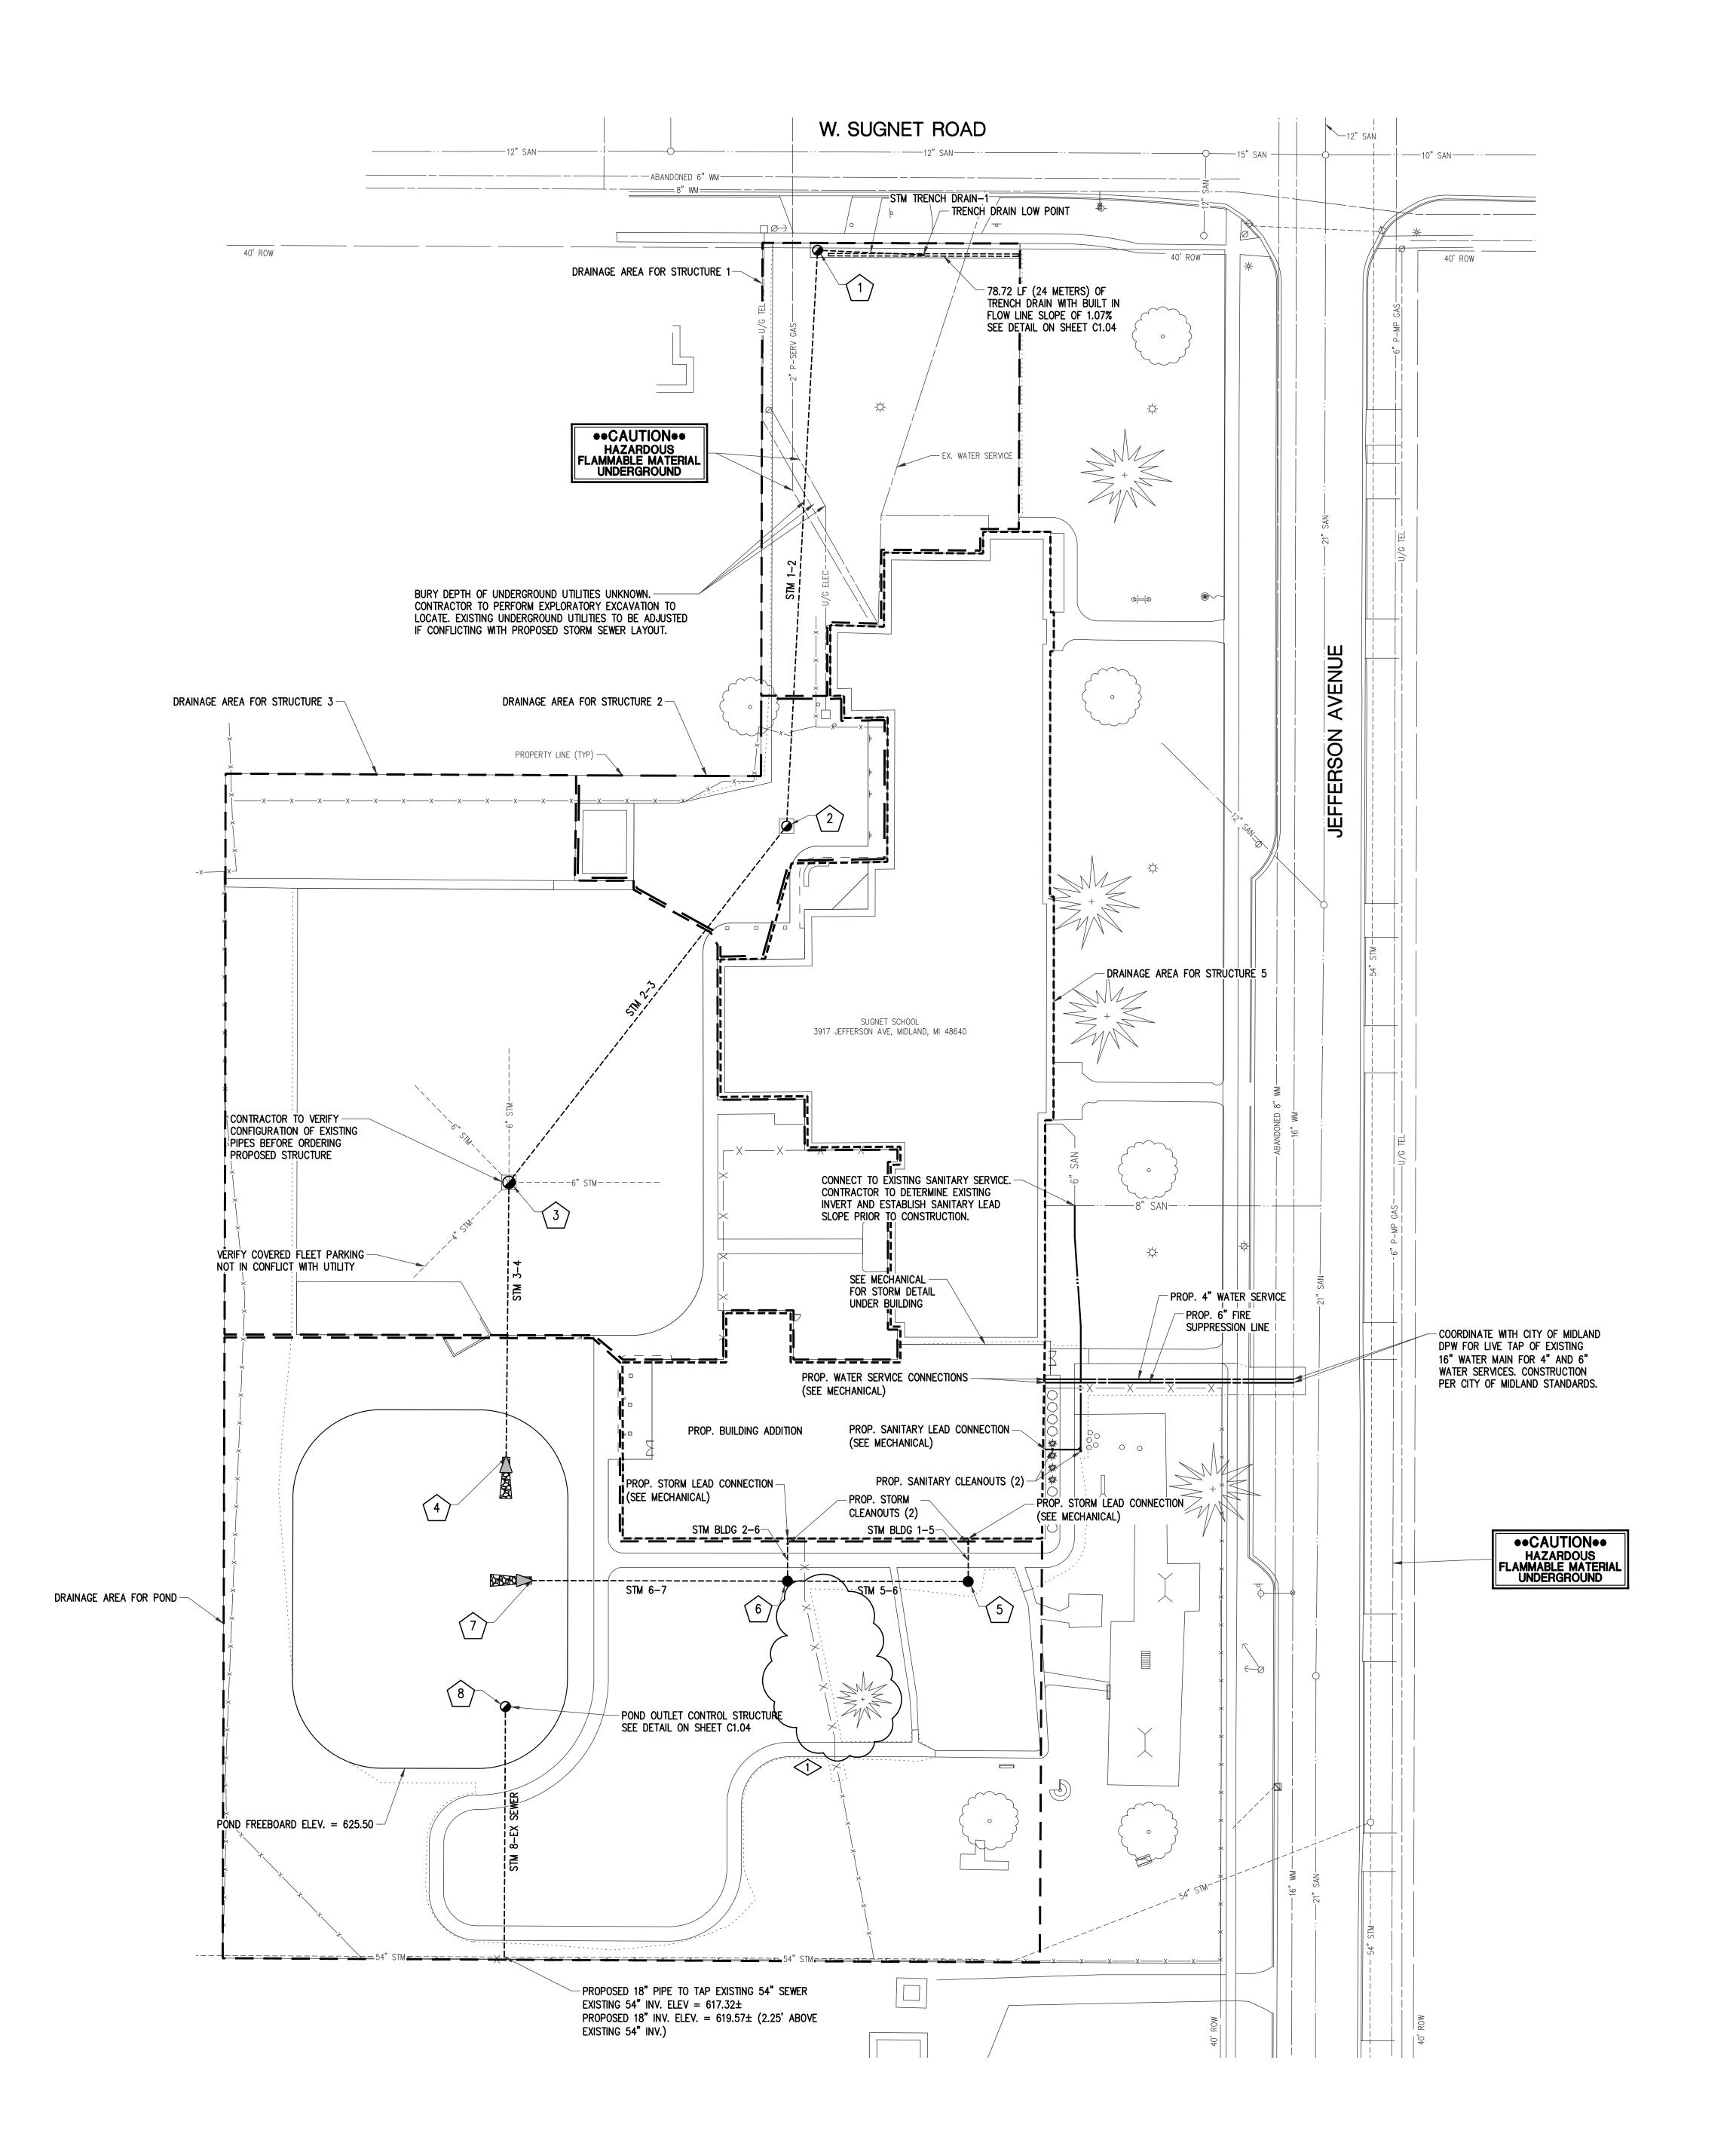

	PROPOSED STORM SEWER STRUCTURE TABLE						
STRUCT NO.	DIA.	COVER TYPE	RIM ELEVATION	INVERT	NORTHING	EASTING	SUMP DEPTH
1	24"	EJ 1040 M1	RIM=626.74	12" 623.78 S (PR) 8" 623.99 E (PR)	9960.02	9791.05	2.0'
2	48"	EJ 1040 M1	RIM=627.67	12" 622.58 N (PR) 15" 622.33 SW (PR)	9721.31	9778.22	2.0'
3	60"	EJ 1040 M1	RIM=625.70	15" 621.58 S (PR) 15" 621.58 NE (PR) 6" 622.90 N (EX) 6" 622.78 NW (EX) 4" 623.13 SW (EX) 6" 623.02 E (EX)	9573.59	9663.09	2.0'
5	48"	EJ 1040 A	RIM=626.52	15" 621.42 W (PR) 12" 621.85 N (PR)	9408.09	9853.49	2.0'
6	48"	EJ 1040 A	RIM=626.44	6" 621.87 N (PR) 15" 621.12 W (PR) 15" 621.12 E (PR)	9408.27	9778.59	0.0'
8	48"	*SPECIAL	RIM=624.57	18" 620.09 S (PR)	9356.28	9661.65	1.0'

\*SEE DETAIL ON SHEET C1.04 FOR MORE INFORMATION RELATING TO STRUCTURE 8 COVER TYPE AND ORIFICE.

SURVEY WAS PERFORMED ON A LOCAL HORIZONTAL COORDINATE SYSTEM
 CONTRACTOR TO CONTACT D&M SITE, INC TO OBTAIN LOCAL HORIZONTAL COORDINATE SYSTEM INFORMATION

PROPOSED STORM SEWER PIPE TABLE			
PIPE NUMBER	DIAMETER	TOTAL LENGTH	SLOPE
STM 1-2	12"	239'	0.50%
STM 2-3	15"	187'	0.40%
STM 3-4	15"	114'	0.46%
STM 5-6	15"	75'	0.40%
STM 6-7	15"	106'	0.40%
STM 8-EX SEWER	18"	104'	0.50%
STM BLDG 1-5	12"	18'	0.60%
STM BLDG 2-6	6"	18'	0.15%
STM TRENCH DRAIN-1	8"	44'	1.00%

PROPOSED STORM SEWER END SECTION TABLE				
STRUCT NO.	DIA.	END OF PIPE INVERT	END OF PIPE NORTHING	END OF PIPE EASTING
4	15"	15" 621.06	9459.62	9661.95
7	15"	15" 620.70	9408.53	9672.53

- 1. SURVEY WAS PERFORMED ON A LOCAL HORIZONTAL COORDINATE SYSTEM
- 2. CONTRACTOR TO CONTACT D&M SITE, INC TO OBTAIN LOCAL HORIZONTAL COORDINATE SYSTEM INFORMATION (SEE SHEET C2.01 FOR CONTACT INFORMATION)

1	ADDENDUM 1	08/31/23		
\	ISSUED FOR BIDS	08/23/23		
NO.	REVISION	DATE		
	B /	REA A		
NOR		ARCH.COM		
W	TAARCHITE	CTS		
Sagin	Jefferson Ave, Suite 601 aw, Michigan 48607 52 8107 COPYRIC	GHT © 2022		
	ROWE Profes Services Com			
PROJI	ECT TITLE			
RENOVATION AND ADDITION:				
MIDLAND COUNTY ESA				
MIDL	AND, MICHIGAN			
SHEET TITLE  CIVIL UTILITY PLAN				

SHEET NUMBER

PROJECT NUMBER


PROJECT DATE

CHECKED BY

DRS

2022006.1

AUGUST 31, 2023

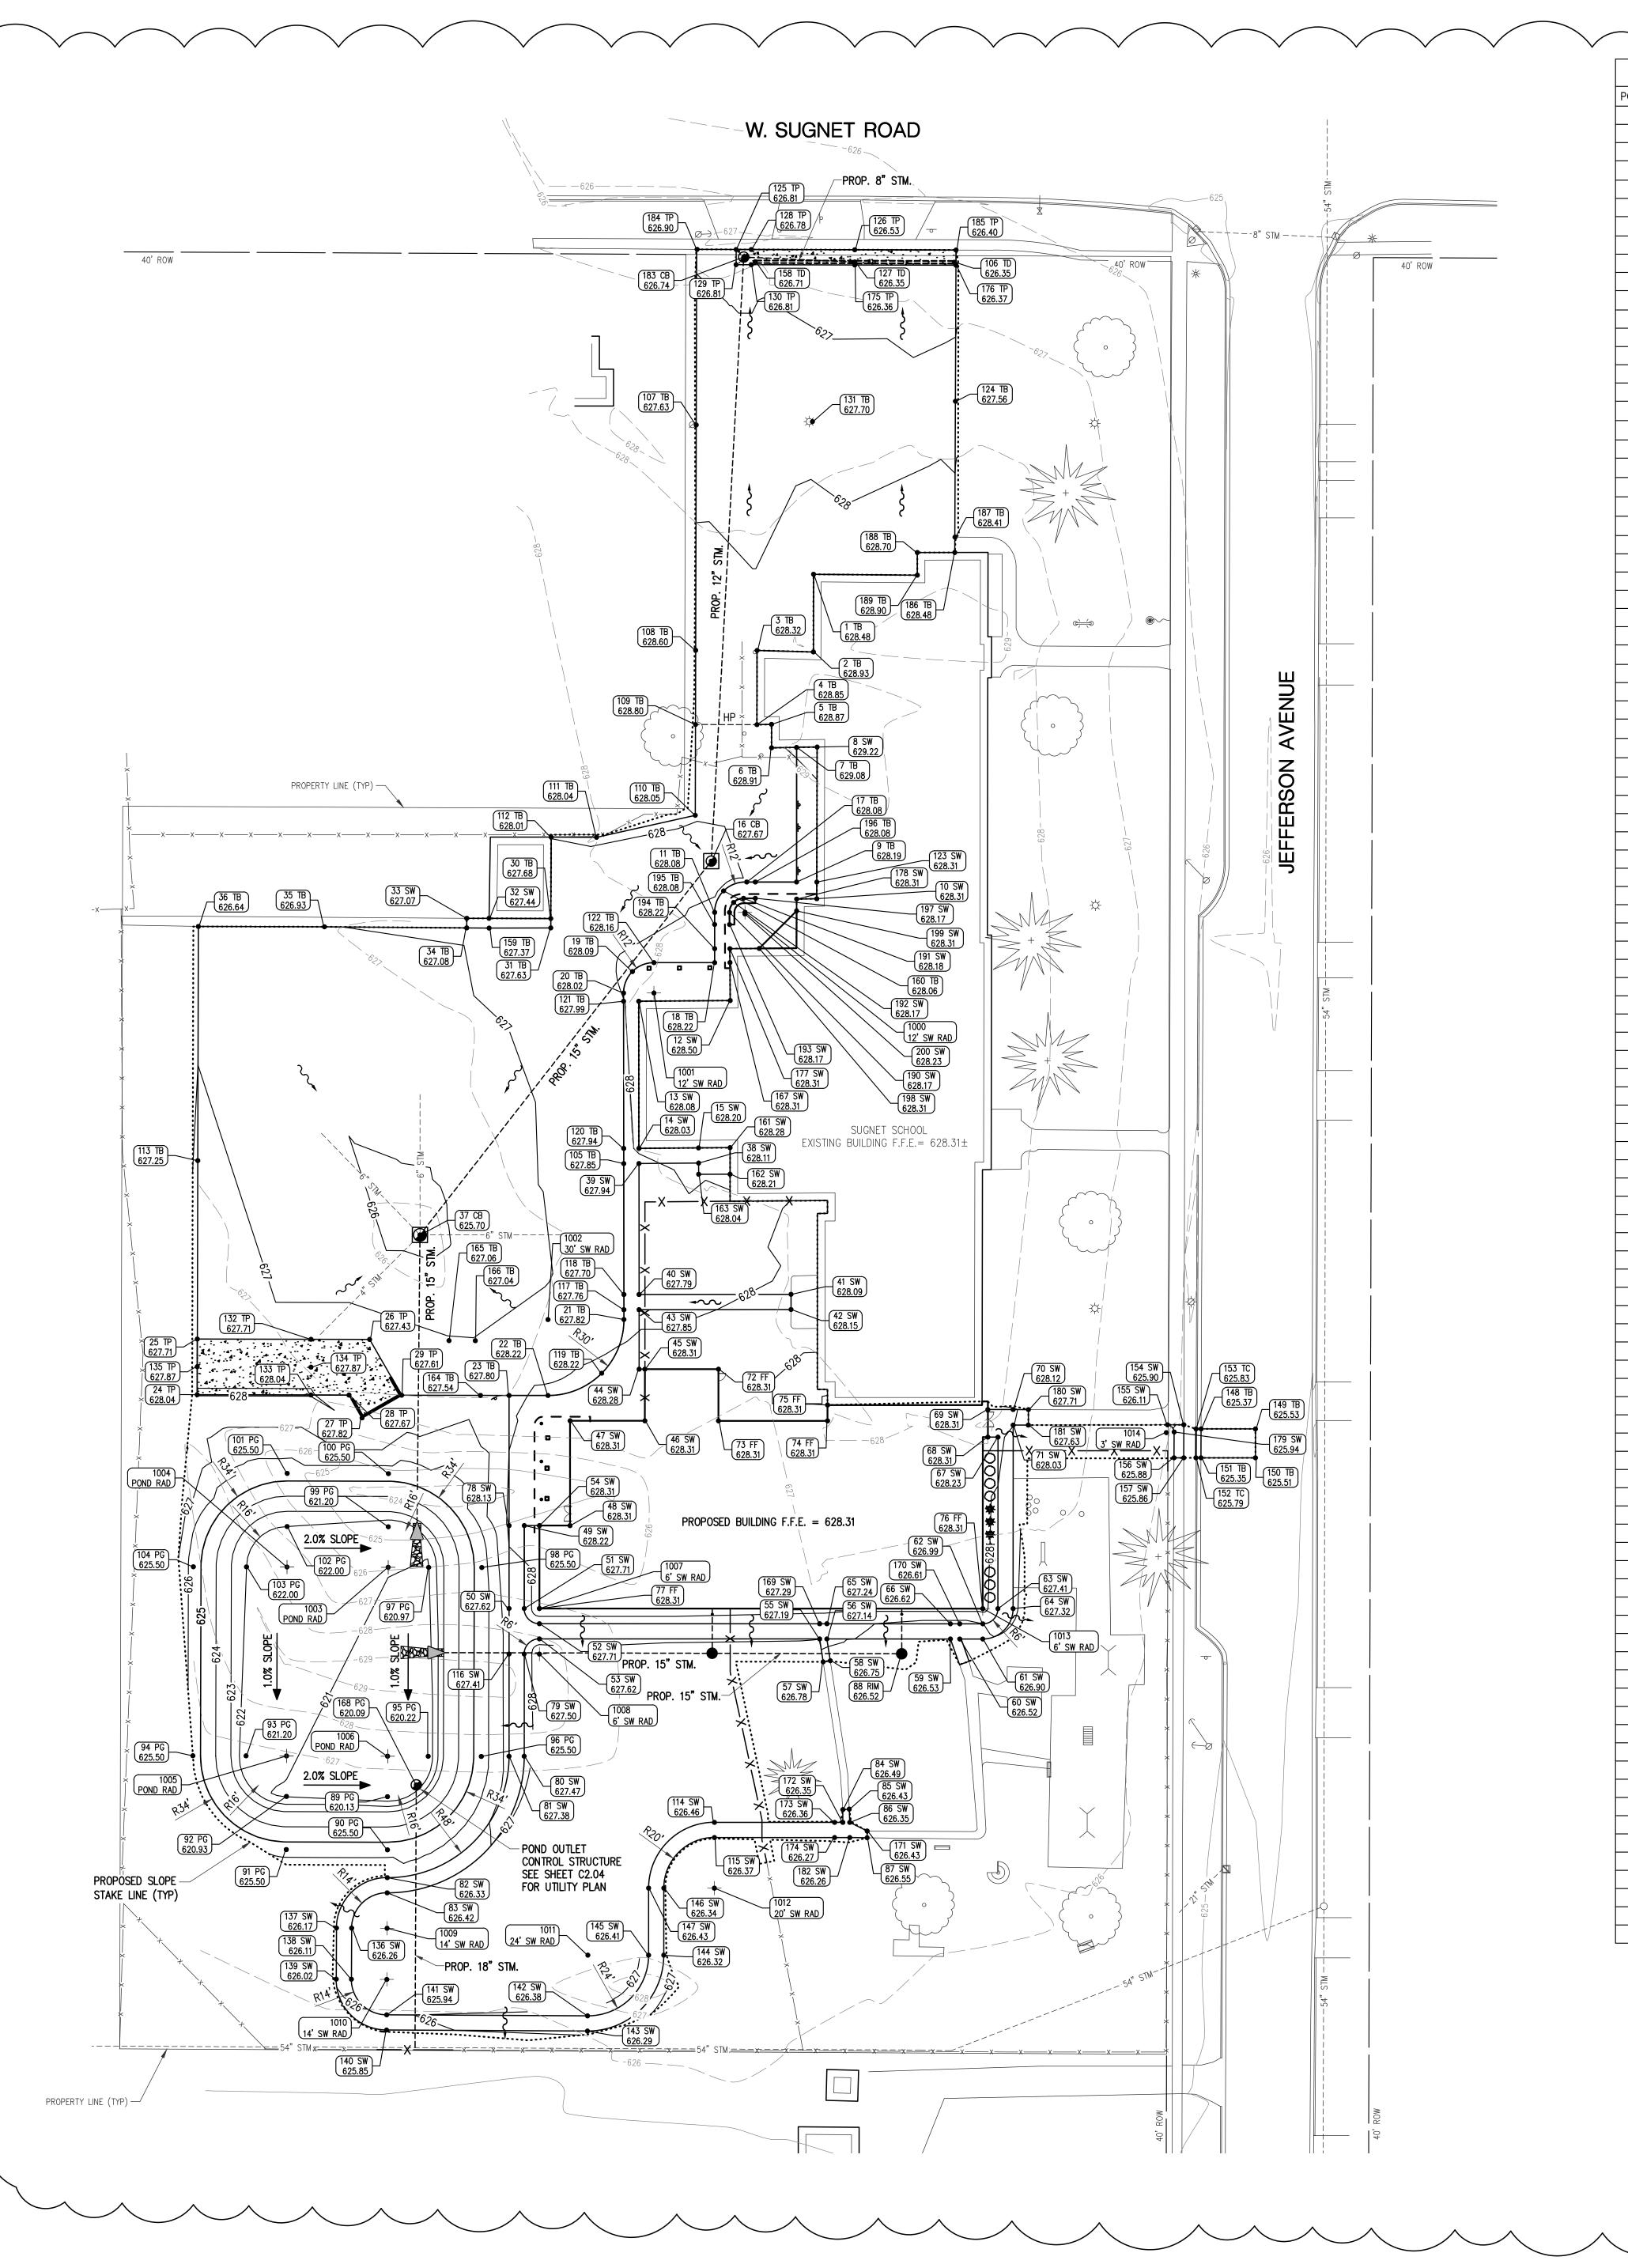

OINT 1	ELEVATION TB=628.48	GRADING TABLE  DESCRIPTION  EXISTING BUILDING	NORTHING 9834.67	EASTING 9818.66
2	TB=628.93	EXISTING BUILDING	9803.97	9818.59
3	TB=628.32	EXISTING BUILDING	9804.58	9796.34
4	TB=628.85	HP; EXISTING BUILDING	9775.24	9796.27
5 6	TB=628.87 TB=628.91	EXISTING BUILDING  EXISTING BUILDING	9775.38 9766.10	9802.05 9802.07
7	TB=629.08	SW; EXISTING BUILDING	9766.26	9811.95
8	SW=629.22	EXISTING BUILDING	9766.39	9820.07
9	TB=628.19	SW	9713.06	9811.95
10	SW=628.31	FINISHED FLOOR	9706.46	9819.93
11	TB=628.08 SW=628.50	SW; SPRING POINT  EXISTING BUILDING	9701.06 9666.23	9779.58 9785.73
13	SW=628.08	EXISTING BUILDING	9665.96	9749.58
14	SW=628.03	EXISTING BUILDING	9607.81	9749.64
15	SW=628.20	EXISTING BUILDING	9607.99	9773.21
16	CB=627.67		9721.31	9778.22
17	TB=628.08	SW; SPRING POINT	9713.06	9792.25
18 19	TB=628.22 TB=628.09	SW; SPRING POINT	9681.20 9677.68	9779.58 9747.09
20	TB=628.02	SW; SPRING POINT	9669.19	9743.58
21	TB=627.82	SW; SPRING POINT	9540.18	9743.70
22	TB=628.22	SW; SPRING POINT	9510.15	9713.69
23	TB=627.80	SW; ADA PARKING	9510.16	9698.33
24	TP=628.04		9510.46	9575.06
25 26	TP=627.71 TP=627.43	ТВ	9532.46 9532.29	9575.11 9643.20
26	TP=627.43	טו	9532.29 9501.30	9643.20
28	TP=627.67		9510.31	9635.07
29	TP=627.61	ТВ	9510.26	9655.85
30	TB=627.68	SW; EXISTING BUILDING	9698.64	9714.80
31	TB=627.63	SW	9694.94	9714.79
32 33	SW=627.44 SW=627.07	EXISTING BUILDING  MATCH EXISTING	9698.72 9698.72	9690.41 9681.59
34	TB=627.08	SW; MATCH EXISTING	9698.72	9681.59
35	TB=626.93	SW; MATCH EXISTING	9695.37	9625.35
36	TB=626.64	SW; MATCH EXISTING	9695.50	9575.52
37	CB=625.70		9573.59	9663.09
38	SW=628.11		9601.99	9773.22
39 40	SW=627.94 SW=627.79		9601.81 9550.07	9749.64
40	SW=627.79 SW=628.09	MATCH EXISTING	9550.07 9550.12	9749.69 9809.75
42	SW=628.15	MATCH EXISTING	9544.12	9809.76
43	SW=627.85		9544.07	9749.69
44	SW=628.28		9520.56	9749.72
45	SW=628.31	FINISHED FLOOR	9520.56	9751.99
46 47	SW=628.31 SW=628.31	FINISHED FLOOR FINISHED FLOOR	9500.14 9500.15	9751.99 9722.42
48	SW=628.31	FINISHED FLOOR	9458.75	9722.41
49	SW=628.22		9458.75	9704.32
50	SW=627.62		9425.98	9698.31
51	SW=627.71	SPRING POINT	9425.98	9704.31
52 53	SW=627.71 SW=627.62	SPRING POINT SPRING POINT	9419.98 9413.98	9710.31 9710.31
54	SW=628.31	FINISHED FLOOR	9458.75	9710.32
55	SW=627.19		9413.95	9821.06
56	SW=627.14		9413.95	9823.94
57	SW=626.78	MATCH EXISTING	9404.91	9822.45
58 59	SW=626.75 SW=626.53	MATCH EXISTING  MATCH EXISTING	9405.34 9413.95	9825.27 9872.75
60	SW=626.52	MATCH EXISTING	9413.92	9876.43
61	SW=626.90	SPRING POINT	9413.93	9885.52
62	SW=626.99	SPRING POINT	9419.93	9885.52
63	SW=627.41	SPRING POINT	9425.93	9891.52
65	SW=627.32 SW=627.24	SPRING POINT	9425.93 9419.95	9897.52 9823.94
66	SW=626.62		9419.94	9872.75
67	SW=628.23		9493.70	9891.54
68	SW=628.31	FINISHED FLOOR	9493.70	9887.54
69 70	SW=628.31	FINISHED FLOOR	9504.60	9887.54
70 71	SW=628.12 SW=628.03		9504.60 9498.44	9897.54 9897.54
72	FF=628.31		9520.55	9781.07
73	FF=628.31		9500.14	9781.07
74	FF=628.31		9500.13	9824.18
75 76	FF=628.31 FF=628.31		9506.39 9425.93	9824.19 9885.52
76 77	FF=628.31 FF=628.31		9425.93 9425.98	9885.52
78	SW=628.13		9458.75	9698.32
79	SW=627.50	SPRING POINT	9407.98	9704.31
80	SW=627.47	SPRING POINT	9367.60	9704.30
81	SW=627.38	SPRING POINT	9367.61	9698.30
82	SW=626.33 SW=626.42	SPRING POINT SPRING POINT	9319.62 9313.62	9650.18 9650.16
84	SW=626.49	MATCH EXISTING	9346.51	9830.23
85	SW=626.43	MATCH EXISTING	9346.69	9832.76
86	SW=626.35		9341.45	9832.98
87	SW=626.55	MATCH EXISTING	9335.39	9839.82
88	RIM=626.52 PG=620.13		9408.09 9351.62	9853.49 9650.26
90	PG=620.13 PG=625.50		9351.62 9330.62	9650.26
91	PG=625.50		9330.72	9610.27
92	PG=620.93		9351.72	9610.32
93	PG=621.20		9367.76	9594.36
94	PG=625.50		9367.81	9573.36
95	PG=620.22		9367.57	9666.34
96 97	PG=625.50 PG=620.97		9367.52 9442.24	9687.34 9666.54
	PG=620.97 PG=625.50		9442.24	9687.54
98		l		
98	PG=621.20		9458.28	9650.58

		GRADING TABL	Ε	
POINT 101	ELEVATION PG=625.50	DESCRIPTION	NORTHING 9479.38	9610.64
102	PG=622.00 PG=622.00		9458.38 9442.42	9610.58 9594.54
104	PG=625.50		9442.47	9573.54
105 106	TB=627.85 TD=626.35	SW	9601.81 9957.98	9743.64 9874.29
107	TB=627.63		9893.68	9772.29
108	TB=628.60	пр	9804.64	9772.07
109	TB=628.80 TB=628.05	HP	9775.30 9739.43	9771.99 9771.91
111	TB=628.04		9730.73	9732.89
112	TB=628.01 TB=627.25	EXISTING BUILDING	9730.81 9602.98	9714.95 9575.29
114	SW=626.46	SPRING POINT	9341.47	9779.47
115	SW=626.37	SPRING POINT	9335.47	9779.47
116 117	SW=627.41 TB=627.76	SW	9407.98 9544.06	9698.31 9743.69
118	TB=627.70	SW	9550.06	9743.69
119 120	TB=628.22 TB=627.94	SW	9518.95 9607.81	9734.92 9743.64
121	TB=627.99	SW	9665.95	9743.58
122	TB=628.16	SW; SPRING POINT	9681.20	9755.58
123 124	SW=628.31 TB=627.56	EXISTING BUILDING	9713.04 9903.05	9819.95 9874.73
125	TP=626.81	SW; MATCH EXISTING	9963.03	9788.05
126	TP=626.53	SW; MATCH EXISTING	9962.91	9834.94
127 128	TD=626.35 TP=626.78	SW; MATCH EXISTING	9958.08 9963.01	9834.93 9794.05
129	TP=626.81	TB	9957.03	9788.04
130	TP=626.81	TB EXISTING POLE	9957.01	9794.04
131	TB=627.70 TP=627.71	TB	9895.00 9532.35	9818.20 9620.05
133	TP=628.04		9510.35	9620.00
134	TP=627.87 TP=627.87		9521.35 9521.54	9620.03 9575.09
136	SW=626.26	SPRING POINT	9299.69	9636.11
137	SW=626.17	SPRING POINT	9299.72	9630.11
138 139	SW=626.11 SW=626.02	SPRING POINT SPRING POINT	9279.48 9279.52	9636.00 9630.00
140	SW=625.85	SPRING POINT	9259.41	9649.90
141	SW=625.94 SW=626.38	SPRING POINT SPRING POINT	9265.41 9265.00	9649.93
143	SW=626.29	SPRING POINT	9259.00	9729.30
144	SW=626.32	SPRING POINT	9288.99	9759.46
145 146	SW=626.41 SW=626.34	SPRING POINT SPRING POINT	9288.99 9315.47	9753.46 9759.46
147	SW=626.43	SPRING POINT	9315.47	9753.46
148 149	TB=625.37 TB=625.53	MATCH EXISTING  MATCH EXISTING	9496.95 9496.94	9971.82 9993.30
150	TB=625.51	MATCH EXISTING	9485.52	9993.30
151	TB=625.35	MATCH EXISTING	9485.53	9971.78
152 153	TC=625.79 TC=625.83	MATCH EXISTING  MATCH EXISTING	9485.53 9496.95	9969.78 9969.82
154	SW=625.90	MATCH EXISTING	9498.57	9964.98
155 156	SW=626.11 SW=625.88	MATCH EXISTING  MATCH EXISTING	9498.58 9485.53	9958.54 9961.12
157	SW=625.86	MATCH EXISTING	9485.53	9964.98
158	TD=626.71		9958.18	9795.57
159 160	TB=627.37 TB=628.06	SW	9694.86 9709.55	9690.42 9783.09
161	SW=628.28	EXISTING BUILDING	9608.09	9785.65
162 163	SW=628.21 SW=628.04	EXISTING BUILDING	9597.59 9597.58	9785.66 9773.26
164	TB=627.54	ADA PARKING	9510.19	9687.02
165	TB=627.06	ADA PARKING	9531.84	9674.59
166 167	TB=627.04 SW=628.31	ADA PARKING FINISHED FLOOR	9531.82 9681.24	9684.98 9785.62
168	PG=620.09		9356.28	9661.65
169 170	SW=627.29 SW=626.61		9419.95 9419.94	9821.06 9876.44
170	SW=626.43	MATCH EXISTING	9338.04	9839.85
172	SW=626.35		9341.45	9830.23
173 174	SW=626.36 SW=626.27		9341.45 9335.45	9826.98 9826.98
175	TP=626.36		9956.91	9834.93
176 177	TP=626.37 SW=628.31	FINISHED FLOOR	9956.81 9686.72	9874.95 9785.57
177	SW=628.31	FINISHED FLOOR	9706.33	9811.97
179	SW=625.94	SPRING POINT	9495.73	9961.18
180	SW=627.71 SW=627.63	MATCH EXISTING  MATCH EXISTING	9504.57 9498.46	9903.57 9903.54
182	SW=626.26		9335.45	9832.98
183	CB=626.74 TP=626.90	SW; MATCH EXISTING	9960.02 9963.06	9791.05 9772.64
185	TP=626.40	SW; MATCH EXISTING	9962.81	9874.98
186	TB=628.48	SW; EXISTING BUILDING	9843.28	9874.48
187	TB=628.41	SW; MATCH EXISTING	9849.36	9874.57
188 189	TB=628.70 TB=628.90	EXISTING BUILDING  EXISTING BUILDING	9843.27 9834.32	9859.66 9859.67
190	SW=628.17	SPRING POINT	9701.03	9785.43
191 192	SW=628.18 SW=628.17	SPRING POINT	9706.62 9704.98	9791.00 9787.06
193	SW=628.17		9696.28	9785.44
194	TB=628.22	SW	9686.72	9779.58
195 196	TB=628.08 TB=628.08	SW	9696.28 9713.06	9779.58 9795.64
197	SW=628.17		9706.63	9795.64
198	SW=628.31 SW=628.31	FINISHED FLOOR	9686.81 9701.65	9797.18
199	J 511-020.31	FINISHED FLOOR	9701.65	9811.96

		`		
		GRADING TABL	 E	
OINT	ELEVATION	DESCRIPTION	NORTHING	EASTING
101	PG=625.50		9479.38	9610.64
102	PG=622.00		9458.38	9610.58
103	PG=622.00		9442.42	9594.54
104	PG=625.50	CW	9442.47	9573.54
105 106	TB=627.85 TD=626.35	SW	9601.81 9957.98	9743.64
107	TB=627.63		9893.68	9772.29
108	TB=628.60		9804.64	9772.07
109	TB=628.80	HP	9775.30	9771.99
110	TB=628.05		9739.43	9771.91
111	TB=628.04		9730.73	9732.89
112	TB=628.01	EXISTING BUILDING	9730.81	9714.95
113	TB=627.25	CODING DOINT	9602.98	9575.29
114 115	SW=626.46 SW=626.37	SPRING POINT SPRING POINT	9341.47 9335.47	9779.47
116	SW=627.41	SI KING I GINI	9407.98	9698.31
117	TB=627.76	SW	9544.06	9743.69
118	TB=627.70	SW	9550.06	9743.69
119	TB=628.22	SW	9518.95	9734.92
120	TB=627.94	SW	9607.81	9743.64
121	TB=627.99	SW	9665.95	9743.58
122	TB=628.16	SW; SPRING POINT	9681.20	9755.58
123	SW=628.31	EXISTING BUILDING	9713.04	9819.95
124	TB=627.56	OW MATCH EMOTING	9903.05	9874.73
125	TP=626.81	SW; MATCH EXISTING	9963.03	9788.05
126	TP=626.53	SW; MATCH EXISTING	9962.91	9834.94
127	TD=626.35	SW- MATCH EVICTING	9958.08	9834.93
28	TP=626.78 TP=626.81	SW; MATCH EXISTING	9963.01 9957.03	9794.05 9788.04
30	TP=626.81	ТВ	9957.03	9788.04
131	TB=627.70	EXISTING POLE	9895.00	9818.20
132	TP=627.71	TB	9532.35	9620.05
33	TP=628.04		9510.35	9620.00
134	TP=627.87		9521.35	9620.03
35	TP=627.87		9521.54	9575.09
136	SW=626.26	SPRING POINT	9299.69	9636.11
37	SW=626.17	SPRING POINT	9299.72	9630.11
38	SW=626.11	SPRING POINT	9279.48	9636.00
39	SW=626.02	SPRING POINT	9279.52	9630.00
40	SW=625.85	SPRING POINT	9259.41	9649.90
141  42	SW=625.94 SW=626.38	SPRING POINT SPRING POINT	9265.41 9265.00	9649.93 9729.33
43	SW=626.29	SPRING POINT	9259.00	9729.30
44	SW=626.32	SPRING POINT	9288.99	9759.46
145	SW=626.41	SPRING POINT	9288.99	9753.46
146	SW=626.34	SPRING POINT	9315.47	9759.46
147	SW=626.43	SPRING POINT	9315.47	9753.46
148	TB=625.37	MATCH EXISTING	9496.95	9971.82
149	TB=625.53	MATCH EXISTING	9496.94	9993.30
150	TB=625.51	MATCH EXISTING	9485.52	9993.30
151	TB=625.35	MATCH EXISTING	9485.53	9971.78
152	TC=625.79	MATCH EXISTING	9485.53	9969.78
153 154	TC=625.83 SW=625.90	MATCH EXISTING  MATCH EXISTING	9496.95 9498.57	9969.82
55	SW=626.11	MATCH EXISTING	9498.58	9958.54
56	SW=625.88	MATCH EXISTING	9485.53	9961.12
57	SW=625.86	MATCH EXISTING	9485.53	9964.98
58	TD=626.71		9958.18	9795.57
59	TB=627.37	SW	9694.86	9690.42
60	TB=628.06	SW	9709.55	9783.09
161	SW=628.28	EXISTING BUILDING	9608.09	9785.65
62	SW=628.21	EXISTING BUILDING	9597.59	9785.66
63	SW=628.04	10.5.5	9597.58	9773.26
64	TB=627.54	ADA PARKING	9510.19	9687.02
65 66	TB=627.06 TB=627.04	ADA PARKING  ADA PARKING	9531.84 9531.82	9674.59
67	SW=628.31	FINISHED FLOOR	9531.82	9684.98
68	PG=620.09		9356.28	9661.65
69	SW=627.29		9419.95	9821.06
70	SW=626.61		9419.94	9876.44
171	SW=626.43	MATCH EXISTING	9338.04	9839.85
72	SW=626.35		9341.45	9830.23
73	SW=626.36		9341.45	9826.98
74	SW=626.27		9335.45	9826.98
75 76	TP=626.36		9956.91	9834.93
76 77	TP=626.37 SW=628.31	FINISHED ELOOP	9956.81 9686.72	9874.95
77 78	SW=628.31 SW=628.31	FINISHED FLOOR FINISHED FLOOR	9686.72 9706.33	9785.57 9811.97
79	SW=625.94	SPRING POINT	9495.73	9961.18
80	SW=627.71	MATCH EXISTING	9504.57	9903.57
181	SW=627.63	MATCH EXISTING	9498.46	9903.54
182	SW=626.26		9335.45	9832.98
183	CB=626.74		9960.02	9791.05
84	TP=626.90	SW; MATCH EXISTING	9963.06	9772.64
185	TP=626.40	SW; MATCH EXISTING	9962.81	9874.98
186	TB=628.48	SW; EXISTING BUILDING	9843.28	9874.48
187	TB=628.41	SW; MATCH EXISTING	9849.36	9874.57
188	TB=628.70	EXISTING BUILDING	9843.27	9859.66
189	TB=628.90	EXISTING BUILDING	9834.32	9859.67
190	SW=628.17	SPRING POINT	9701.03	9785.43
191	SW=628.18	SPRING POINT	9706.62	9791.00
192	SW=628.17		9704.98	9787.06
193 194	SW=628.17 TB=628.22	SW	9696.28 9686.72	9785.44 9779.58
195	TB=628.08	SW	9696.28	9779.58

RADIUS POINTS				
POINT	DESCRIPTION	NORTHING	EASTING	
1000	12' SIDEWALK RADIUS	9701.06	9791.58	
1001	12' SIDEWALK RADIUS	9669.20	9755.58	
1002	30' SIDEWALK RADIUS	9540.15	9713.70	
1003	16' & 34' POND RADII CENTER	9442.28	9650.54	
1004	16' & 34' POND RADII CENTER	9442.38	9610.54	
1005	16' & 34' POND RADII CENTER	9367.72	9610.36	
1006	16' & 34' POND RADII CENTER	9367.62	9650.30	
1007	6' SIDEWALK RADIUS	9425.98	9710.31	
1008	6' SIDEWALK RADIUS	9407.98	9710.31	
1009	14' SIDEWALK RADIUS	9299.62	9650.11	
1010	14' SIDEWALK RADIUS	9279.41	9650.00	
1011	24' SIDEWALK RADIUS	9289.00	9729.46	
1012	20' SIDEWALK RADIUS	9315.47	9779.46	
1013	6' SIDEWALK RADIUS	9425.93	9885.52	
1014	3' SIDEWALK RADIUS	9495.48	9958.07	

**GRADING TABLE** 

<u>LEGEND</u>

CB — CATCH BASIN RIM — MANHOLE RIM SW — TOP OF SIDEWALK

TC - TOP OF CURB

ES — END SECTION

PG - POND GRADE TD - TRENCH DRAIN

HP - HIGH POINT

FF - FINISHED FLOOR


### MISCELLANEOUS NOTES

200 SW=628.23

- PROPOSED MATCH EXISTING ELEVATIONS SHALL MATCH EXISTING GRADE WHERE ABUTTING EXISTING MATERIALS TO REMAIN.
- BARRIER FREE PARKING STALLS SHALL BE CONSTRUCTED USING THE LATEST ADA REQUIREMENTS.
- 3. SEE SHEETS C1.03 & C1.04 FOR DETAILS OF PROPOSED WORK 4. SEE EXISTING CONDITIONS SHEET FOR BENCHMARK INFORMATION AND EXISTING STRUCTURE INVENTORIES.

9700.49 9791.51

- SURVEY WAS PERFORMED ON A LOCAL HORIZONTAL COORDINATE SYSTEM
- 6. CONTRACTOR TO CONTACT D&M SITE, INC TO OBTAIN LOCAL HORIZONTAL COORDINATE SYSTEM INFORMATION.

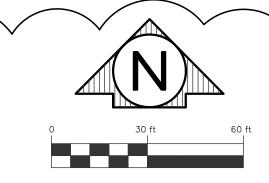

\		
	1	ADDENDUM 1
		ISSUED FOR BID
/	NO.	REVISIO
		REA ARE
\		В
	NOR	KEY PLAN NO SCALE
	W	TAARC

100 S Jefferson Ave, Suite 601 Saginaw, Michigan 48607

ROWE PROFESSIONAL SERVICES COMPANY

WTAARCH.COM

RENOVATION AND

ADDITION: MIDLAND COUNTY ESA

MIDLAND, MICHIGAN

SHEET TITLE CIVIL GRADING PLAN

SHEET NUMBER PROJECT NUMBER 2022006.1 TP - TOP OF CONCRETE PAVEMENT TB - TOP OF BITUMINOUS PAVEMENT PROJECT DATE AUGUST 31, 2023 CHECKED BY DRS

## RENOVATION AND ADDITION:

# MIDLAND COUNTY ESA

## MIDLAND, MICHIGAN



### **CONTACTS**:

#### **ARCHITECT:**



WTA ARCHITECTS
100 S. JEFFERSON AVENUE, SUITE 601 SAGINAW, MICHIGAN 48607 PHONE: (989) 752-8107 EMAIL: DESIGN@WTAARCH.COM

CIVIL ENGINEERS:



ROWE PROFESSIONAL SERVICES COMPANY 540 S. SAGINAW STREET, SUITE 200 FLINT, MI 48502 PHONE: (810) 341-7500

STRUCTURAL, MECHANICAL, ELECTRICAL **ENGINEERS:** 



MACMILLAN ASSOCIATES, INC. 714 E. MIDLAND STREET BAY CITY, MICHIGAN 48706 PHONE: (989) 894-4300

#### **CONSTRUCTION MANAGER:**



THREE RIVERS CORPORATION 3069 VANTAGE POINT DRIVE MIDLAND, MICHIGAN 48642 PHONE: (989) 631-7402

### **INDEX OF DRAWINGS:**

		AZ.5Z	SIGNAGE PLANS - AREA B - MAIN LEVEL
TS	TITLE SHEET	A2.53	SIGNAGE PLANS - AREA C - MAIN LEVEL
GENER/	AL.	A2.54	SIGNAGE PLANS - AREA A - UPPER LEVEL 2
G0.01	PROJECT INFORMATION	A2.55	SIGNAGE PLANS - AREA B - UPPER LEVEL 3
G0.02	LIFE SAFETY PLAN		
G0.03	LIFE SAFETY PLAN	A3.00	FINISH SCHEDULES AND LEGENDS
00.00		A3.01	ROOM FINISH PLANS - AREA A - LOWER
CIVIL		, (0101	LEVEL
C1.01	CIVIL NOTES	A3.02	ROOM FINISH PLANS - AREA B - MAIN LEVEL
C1.02	CIVIL LEGEND	A3.03	ROOM FINISH PLANS - AREA C - MAIN LEVEL
C1.03	CIVIL DETAIL	A3.04	ROOM FINISH PLANS - AREA A - UPPER
C1.03	CIVIL DETAIL		LEVEL 2
C1.04	CIVIL DETAIL	A3.05	ROOM FINISH PLANS - AREA B - UPPER
C2.01	EXISTING SITE CONDITIONS		LEVEL 3
C2.01	DEMOLITION PLAN	A3.10	DOOR AND FRAME SCHEDULE, DOOR
	CIVIL SITE PLAN		DETAILS
C2.03		A3.11	FRAME ELEVATIONS
C2.04	CIVIL CRADING DI ANI	A3.12	FRAME DETAILS
C2.05	CIVIL GRADING PLAN		
C7 O1		A4.01	STAIR 1 & STAIR 2 PLANS AND SECTIONS
C3.01	SESC KEY SHEET		
A DOLLIT	ECTUDAL DEMOLITICAL	A5.10	EXTERIOR ELEVATIONS
_	ECTURAL DEMOLITION	A5.11	EXTERIOR ELEVATIONS
	DEMOLITION PLAN - AREA A - LOWER LEVEL	A5.12	EXTERIOR PHOTO DETAILS
	DEMOLITION PLAN - AREA B - MAIN LEVEL	A5.13	EXTERIOR DETAILS
AD2.03	DEMOLITION PLAN - AREA A - UPPER LEVEL 2	A5.20	BUILDING SECTIONS
<b>AD204</b>		A5.21	BUILDING SECTIONS
	DEMOLITION PLAN - AREA B - UPPER LEVEL 3		
	DEMOLITION PEEL FOTED CELLING DLAN	A6.01	ROOF PLAN
AD2.11	DEMOLITION REFLECTED CEILING PLAN - AREA A - LOWER LEVEL	A6.10	ROOF DETAILS
AD2.12	DEMOLITION REFLECTED CEILING PLAN -	A6.11	ROOF DETAILS
ADZ.IZ	AREA B - MAIN LEVEL	A6.12	ROOF DETAILS
AD2.13	DEMOLITION REFLECTED CEILING PLAN -		
	AREA A - UPPER LEVEL 2	A7.01	WALL SECTIONS
AD2.14	DEMOLITION REFLECTED CEILING PLAN -	A7.02	WALL SECTIONS
	AREA B - UPPER LEVEL 3	A7.03	WALL SECTIONS
AD2.21	EXTERIOR DEMOLITION ELEVATIONS	A7.04	WALL SECTIONS
		A7.10	DETAILS
ARCHIT	ECTURAL		
A1.01	ARCHITECTURAL SITE PLAN	A8.01	INTERIOR ELEVATIONS
A1.10	ARCHITECTURAL SITE DETAILS	A8.02	INTERIOR ELEVATIONS
A1.11	ARCHITECTURAL SITE DETAILS	A8.03	INTERIOR ELEVATIONS
		A8.04	CASEWORK DETAILS
A2.01	MASTER PLAN	A8.05	ELEVATIONS
A2.11	FLOOR PLAN - AREA A - LOWER LEVEL	A8.06	CASEWORK DETAILS AND ELEVATIONS
A2.12	FLOOR PLAN - AREA B - MAIN LEVEL		
A2.13	FLOOR PLAN - AREA C - MAIN LEVEL	A9.10	REFLECTED CEILING PLAN - AREA A - LOWER
A2.14	FLOOR PLAN - AREA A - UPPER LEVEL 2		LEVEL
A2.15	FLOOR PLAN - AREA B - UPPER LEVEL 3	A9.11	REFLECTED CEILING PLAN - AREA B - MAIN
A2.31	ENLARGED PLANS		LEVEL
A2.32	ENLARGED PLANS	A9.12	REFLECTED CEILING PLAN - AREA C - MAIN
A2.41	PLAN DETAILS		LEVEL
A2.42	SECTION DETAILS	A9.13	REFLECTED CEILING PLAN - AREA A - UPPER
A2.50	SIGNAGE DETAILS		LEVEL 2
A2.51	SIGNAGE PLANS - AREA A - LOWER LEVEL	A9.14	REFLECTED CEILING PLAN - AREA B - UPPER LEVEL 3

LEVEL 3

A2.52 SIGNAGE PLANS - AREA B - MAIN LEVEL

A9.20	CEILING DETAILS	SE1.02	CALC. PLAN
STRUCT	TURAL		
S2.01 S2.02	FOUNDATION PLAN - AREA C ROOF FRAMING PLAN - AREA C	E1.01	DEMOLITION ELECTRICAL PLAN - LOWER LEVEL - AREA A
S2.03	MAIN LEVEL FRAMING PLAN - AREA A	E1.02	DEMOLITION ELECTRICAL PLAN - MIAN LEVEL SOUTH WING - AREA B
S2.04	UPPER LEVEL FLOOR AND LOW ROOF FRAMING PLAN - AREA B	E1.03	DEMOLITION ELECTRICAL PLAN - MAIN LEVEL NORTH WING - AREA A
S2.05 S2.06	ROOF FRAMING PLAN - AREA A UPPER LEVEL ROOF FRAMING PLAN - AREA B	E1.04	DEMOLITION ELECTRICAL PLAN - UPPER LEVEL - AREA B
S3.01	NOTES AND SCHEDULES	E2.01	LIGHTING PLAN - LOWER LEVEL - AREA A
S5.01	FOUDATION DETAILS	E2.02	LIGHTING PLAN - MAIN LEVEL SOUTH WING AREA B
S7.01	ROOF FRAMING DETAILS	E2.03	LIGHTING PLAN - MAIN LEVEL NORTH WING AREA A
		E2.04	LIGHTING PLAN - UPPER LEVEL - AREA B
MECHA	NICAL	E2.05	LIGHTING PLAN - ADDITION - AREA C
M1.01	DEMOLITION MECHANICAL PLAN - LOWER LEVEL	E2.06	POWER AND SYSTEMS PLAN - LOWER LEV - AREA A
M1.02	DEMOLITION MECHANICAL PLAN - MAIN LEVEL	E2.07	POWER AND SYSTEMS PLAN - MAIN LEVEL SOUTH WING - AREA B
M1.03	DEMOLITION MECHANICAL PLAN - MAIN LEVEL	E2.08	POWER AND SYSTEMS PLAN - MAIN LEVEL NORTH WING - AREA A
M1.04	DEMOLITION MECHANICAL PLAN - UPPER LEVEL	E2.09	POWER AND SYSTEMS PLAN - UPPER LEVE AREA B
M2.01	MECHANICAL PLAN - LOWER LEVEL	E2.10	POWER AND SYSTEMS PLAN - ADDITION - AREA C
M2.02	MECHANICAL PLAN - MAIN LEVEL SOUTH WING - AREA B	E2.11	POWER AND SYSTEMS ROOF PLAN
M2.03	MECHANICAL PLAN - MAIN LEVEL NORTH WING - AREA A	E3.01 E3.02	EXISTING ONE-LINE DIAGRAM REVISED ONE-LINE DIAGRAM
M2.04	MECHANICAL PLAN - UPPER LEVEL	L3.02	REVISED ONE-LINE DIAGRAM
M2.05	MECHANICAL PLAN - ADDITION	E4.01	SCHEDULES AND SYMBOLS
		E4.02	EXISTING PANEL SCHEDULES
M3.01	MECHANICAL PLAN - LOWER LEVEL	E4.03	EXISTING PANEL SCHEDULES
M3.02	MECHANICAL PLAN - MAIN LEVEL SOUTH	E4.04	NEW PANEL SCHEDULES
	WING - AREA B	E4.05	DATA RISER DIAGRAM AND SCHEDULES
M3.03	MECHANICAL PLAN - MAIN LEVEL NORTH WING - AREA A		
M3.04	MECHANICAL PLAN - UPPER LEVEL	E5.01	PT. BY PT. LIGHTING PLAN LOWER LEVEL AREA A
M3.05	MECHANICAL PLAN - ADDITION	E5.02	PT. BY PT. LIGHTING PLAN MAIN LEVEL ARE
M3.06	MECHANCIAL PLAN - OVERALL ROOF PLAN	LJ.UZ	B B
M3.07	OVERALL FIRE PROTECTION PLAN MECHANICAL REVISIONS	E5.03	PT. BY PT. LIGHTING PLAN UPPER LEVEL AREA A

M4.01 MECHANICAL SCHEDULES AND GENERAL

M4.02 MECHANICAL SCHEDULES AND GENERAL

M4.03 MECHANICAL DETAILS AND SYMBOLS LIST

M4.04 MECHANICAL DETAILS


SE1.01 ELECTRICAL SITE PLAN

ELECTRICAL

A9.20 CEILING DETAILS

E1.02	DEMOLITION ELECTRICAL PLAN - MIAN LEVEL SOUTH WING - AREA B
E1.03	DEMOLITION ELECTRICAL PLAN - MAIN LEVEL NORTH WING - AREA A
E1.04	DEMOLITION ELECTRICAL PLAN - UPPER LEVEL - AREA B
E2.01	LIGHTING PLAN - LOWER LEVEL - AREA A
E2.02	LIGHTING PLAN - MAIN LEVEL SOUTH WING - AREA B
E2.03	LIGHTING PLAN - MAIN LEVEL NORTH WING - AREA A
E2.04	LIGHTING PLAN - UPPER LEVEL - AREA B
E2.05	LIGHTING PLAN - ADDITION - AREA C
E2.06	POWER AND SYSTEMS PLAN - LOWER LEVEL - AREA A
E2.07	POWER AND SYSTEMS PLAN - MAIN LEVEL SOUTH WING - AREA B
E2.08	POWER AND SYSTEMS PLAN - MAIN LEVEL NORTH WING - AREA A
E2.09	POWER AND SYSTEMS PLAN - UPPER LEVEL - AREA B
E2.10	POWER AND SYSTEMS PLAN - ADDITION - AREA C
E2.11	POWER AND SYSTEMS ROOF PLAN
E3.01	EXISTING ONE-LINE DIAGRAM
E3.02	REVISED ONE-LINE DIAGRAM
E4.01	SCHEDULES AND SYMBOLS
E4.02	EXISTING PANEL SCHEDULES
E4.03	EXISTING PANEL SCHEDULES
E4.04	NEW PANEL SCHEDULES
E4.05	DATA RISER DIAGRAM AND SCHEDULES
E5.01	PT. BY PT. LIGHTING PLAN LOWER LEVEL AREA A
E5.02	PT. BY PT. LIGHTING PLAN MAIN LEVEL AREA B
E5.03	PT. BY PT. LIGHTING PLAN UPPER LEVEL AREA A
E5.04	
	PT. BY PT. LIGHTING PLAN UPPER LEVEL AREA B

SE1.02 ELECTRICAL SITE LIGHTING POINT BY POINT

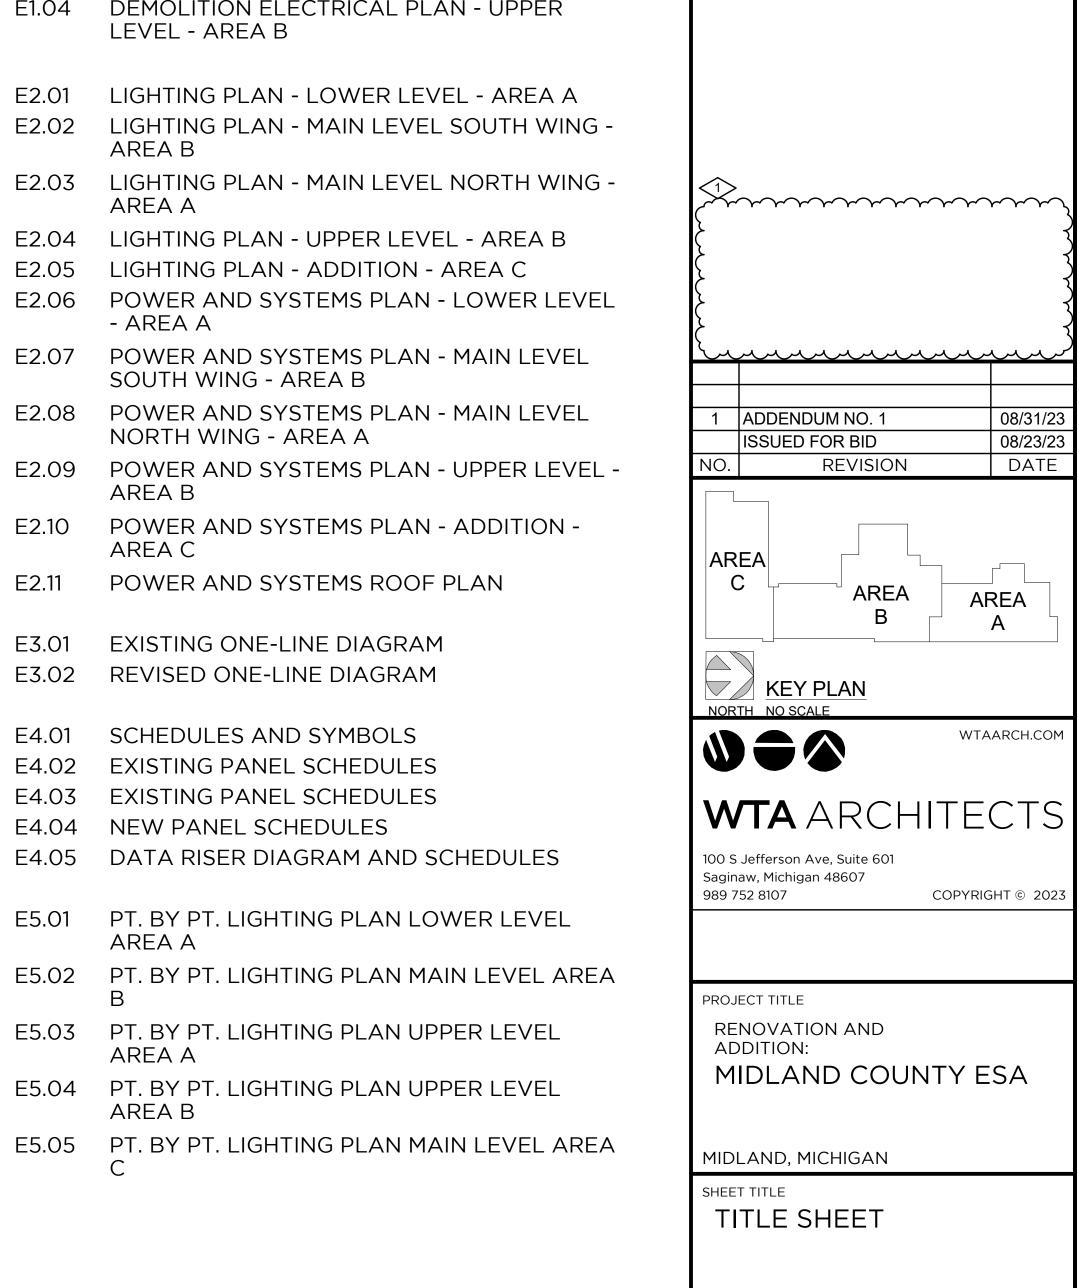

2022006.1 PROJECT DATE AUGUST 23, 2023 CHECKED BY JMJ

PROJECT NUMBER

SHEET NUMBER


08/23/23

DATE

WTAARCH.COM

COPYRIGHT © 2023

REVISION

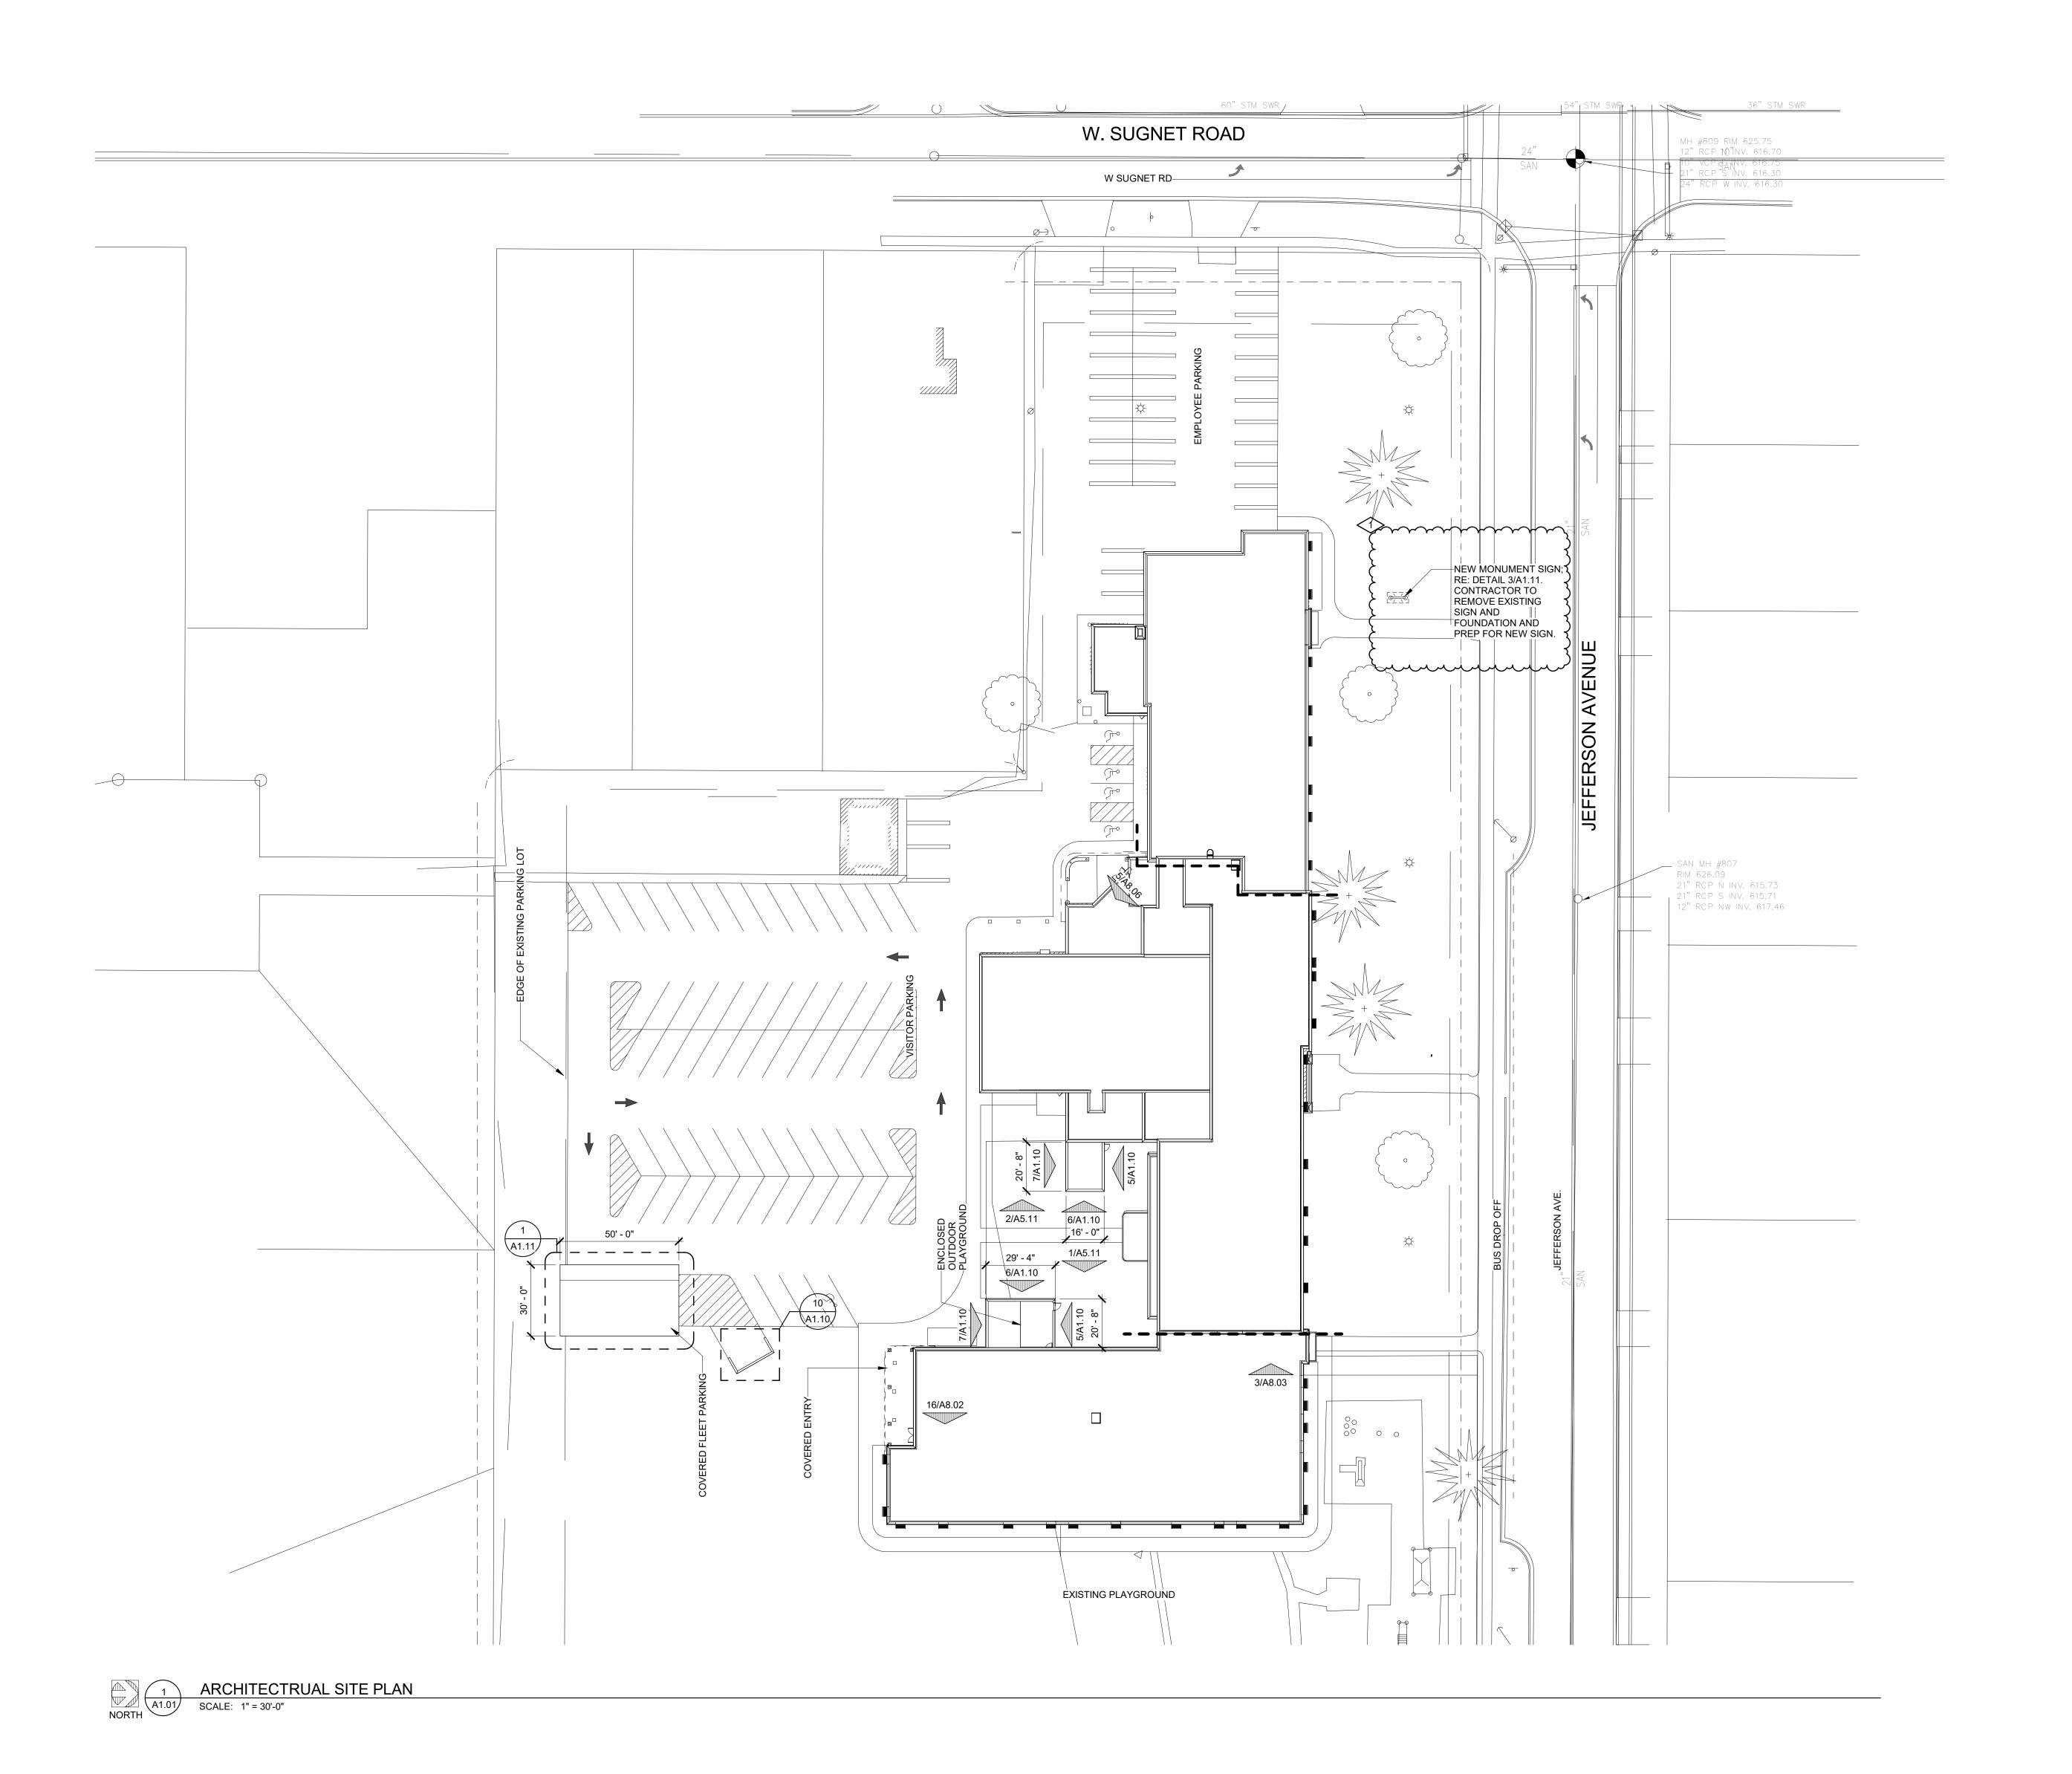

ADDENDUM NO. 1
ISSUED FOR BID

REVISION

08/23/23

GENERAL SITE NOTES:

RENOVATION AND ADDITION:

PROJECT TITLE

MIDLAND COUNTY ESA


MIDLAND, MICHIGAN


ARCHITECTURAL SITE PLAN


PROJECT NUMBER
2022006.1

PROJECT DATE
AUGUST 23, 2023


CHECKED BY
JMJ

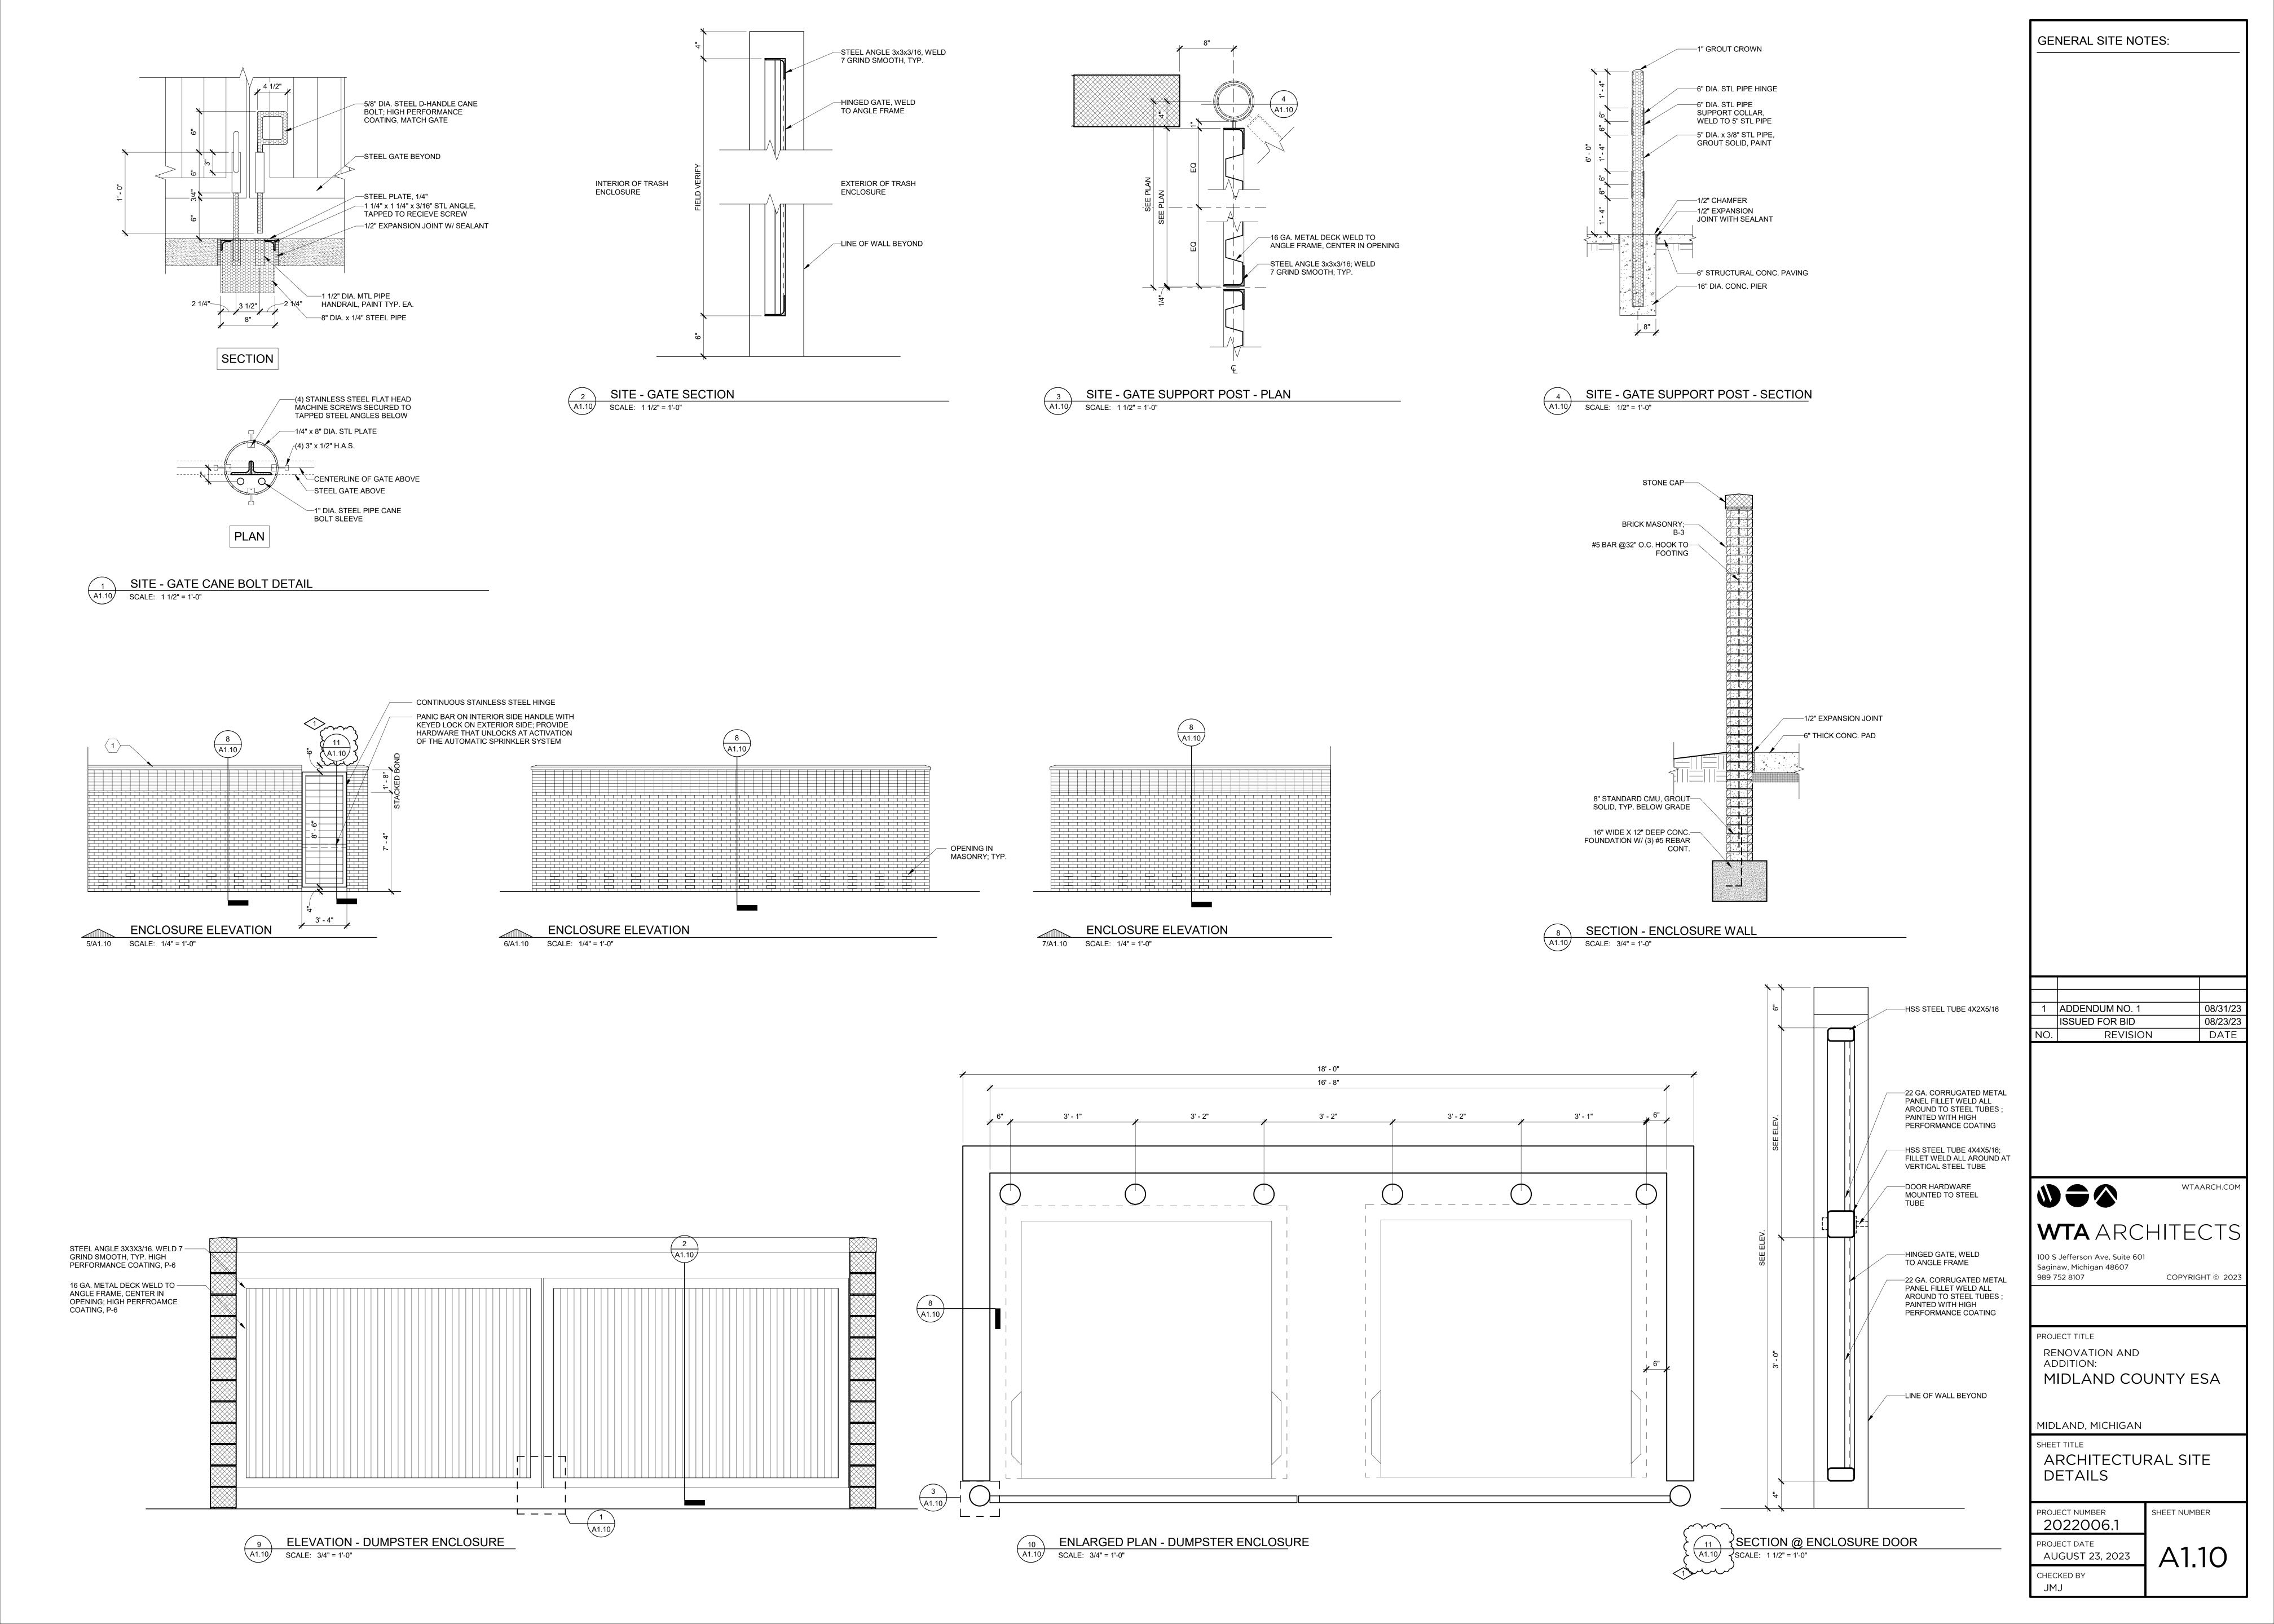


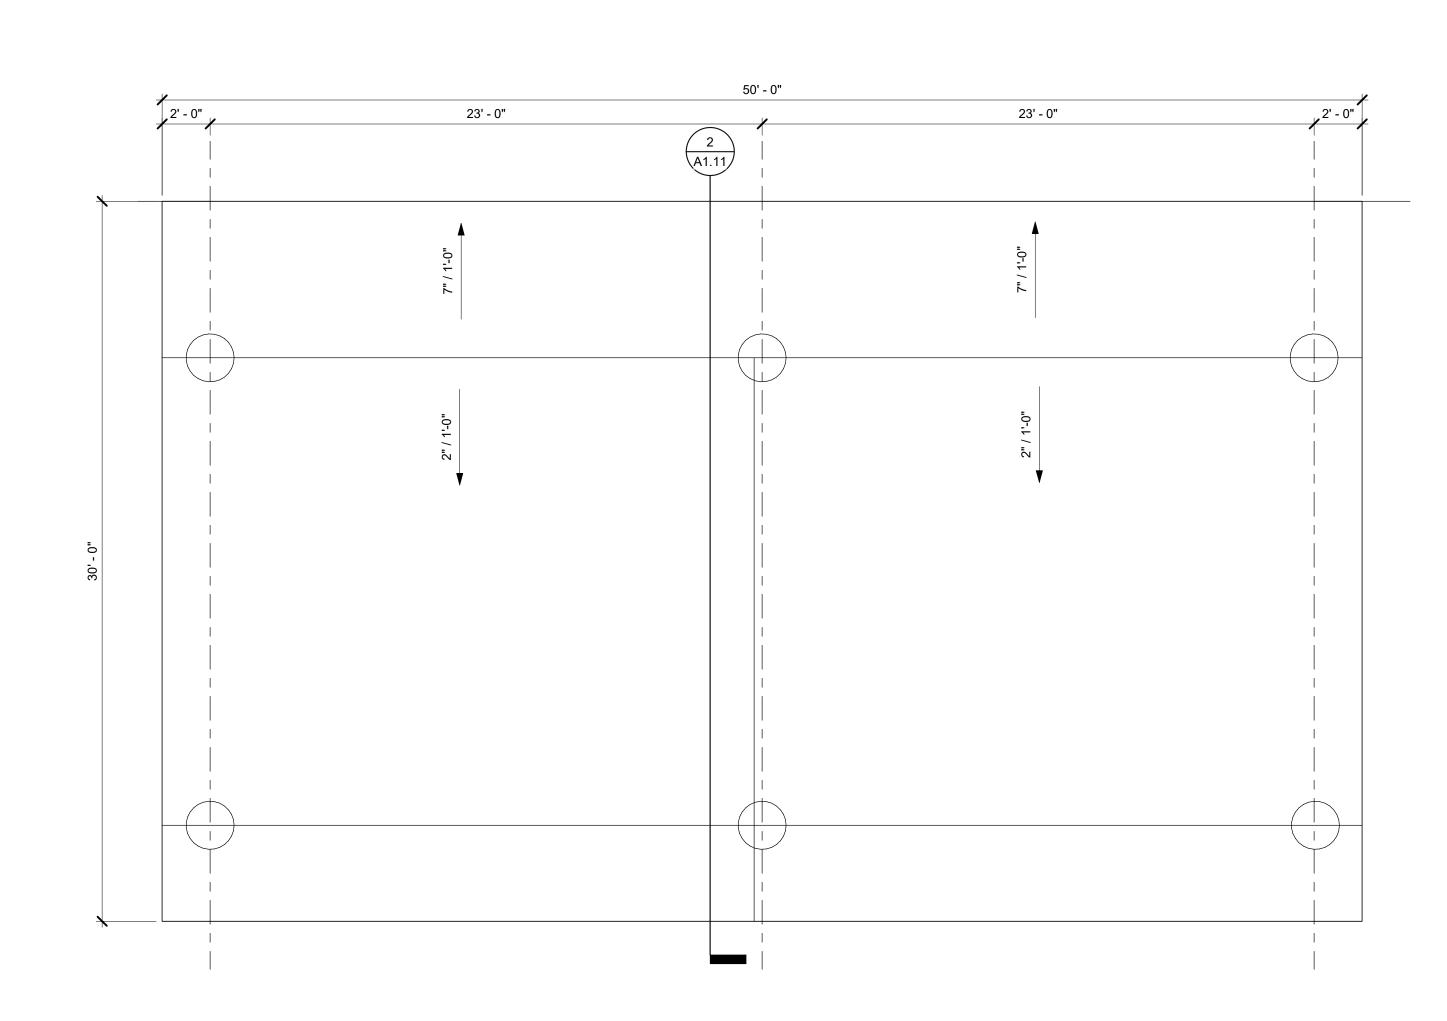

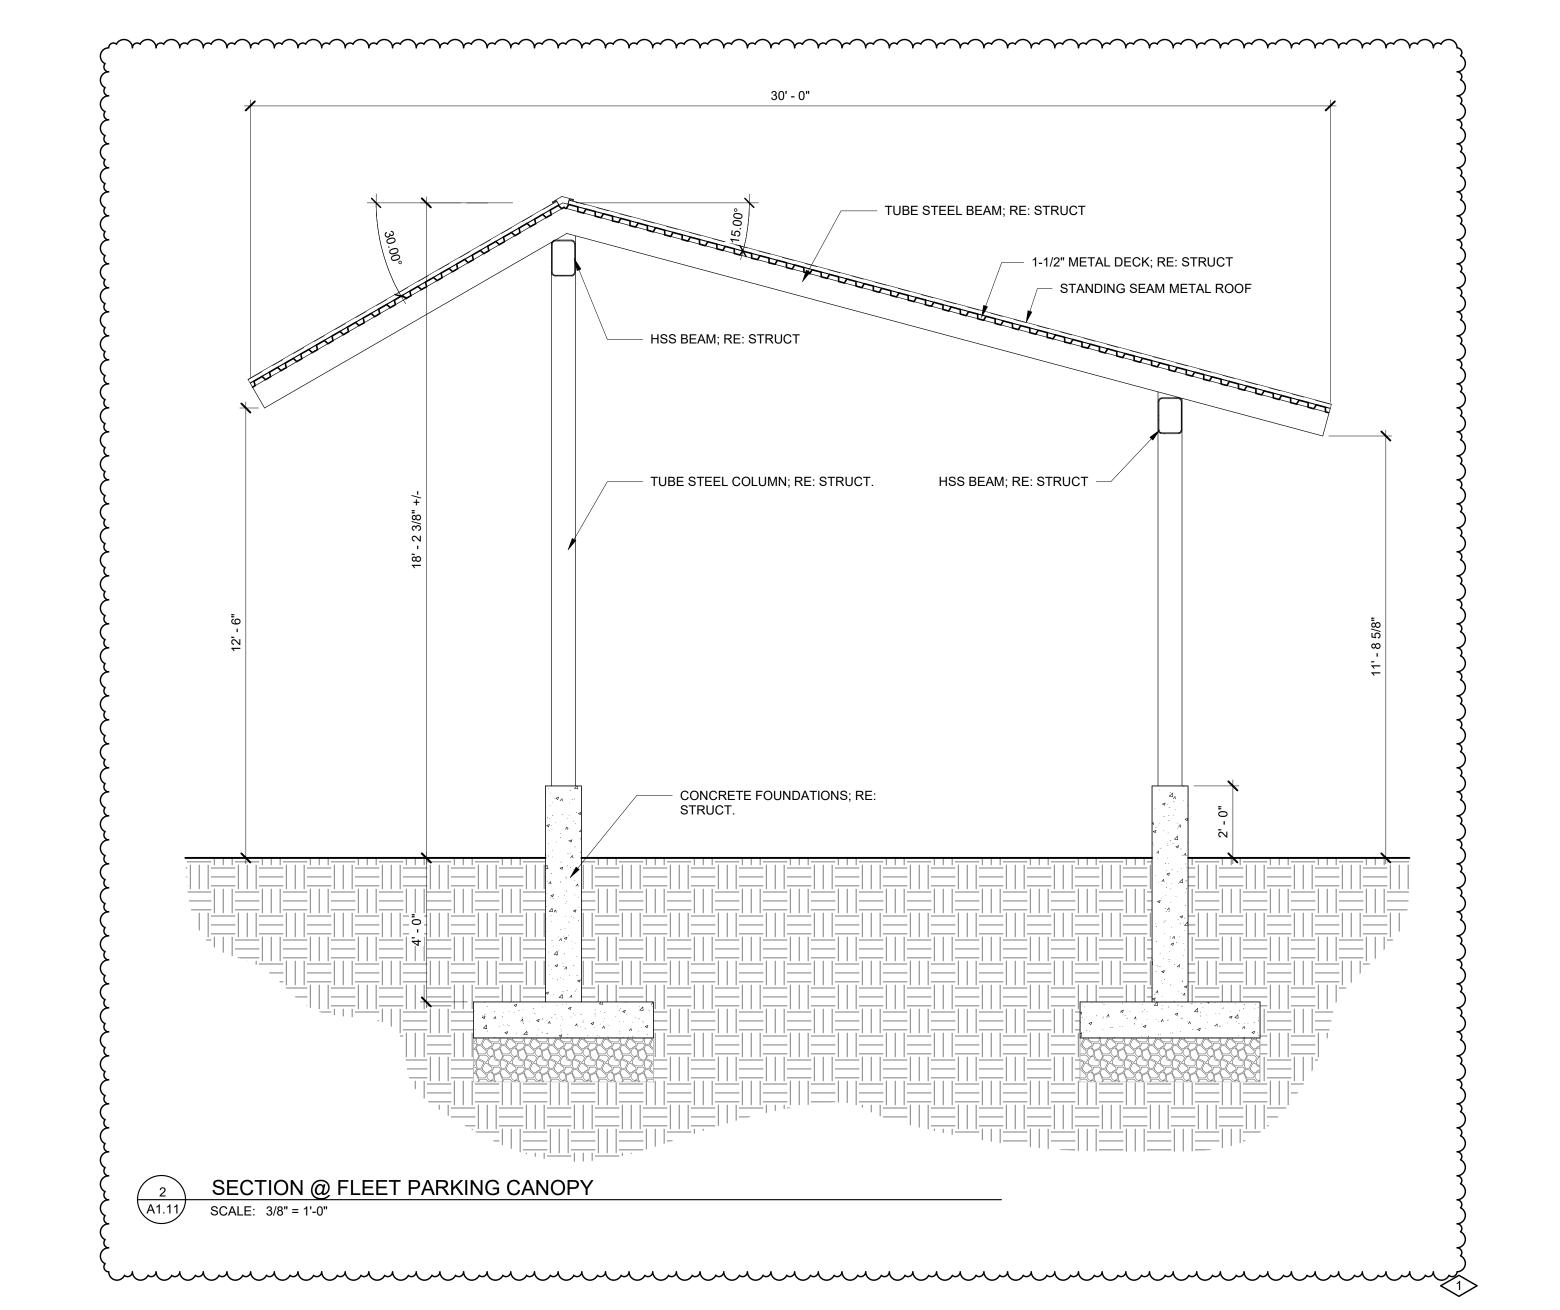





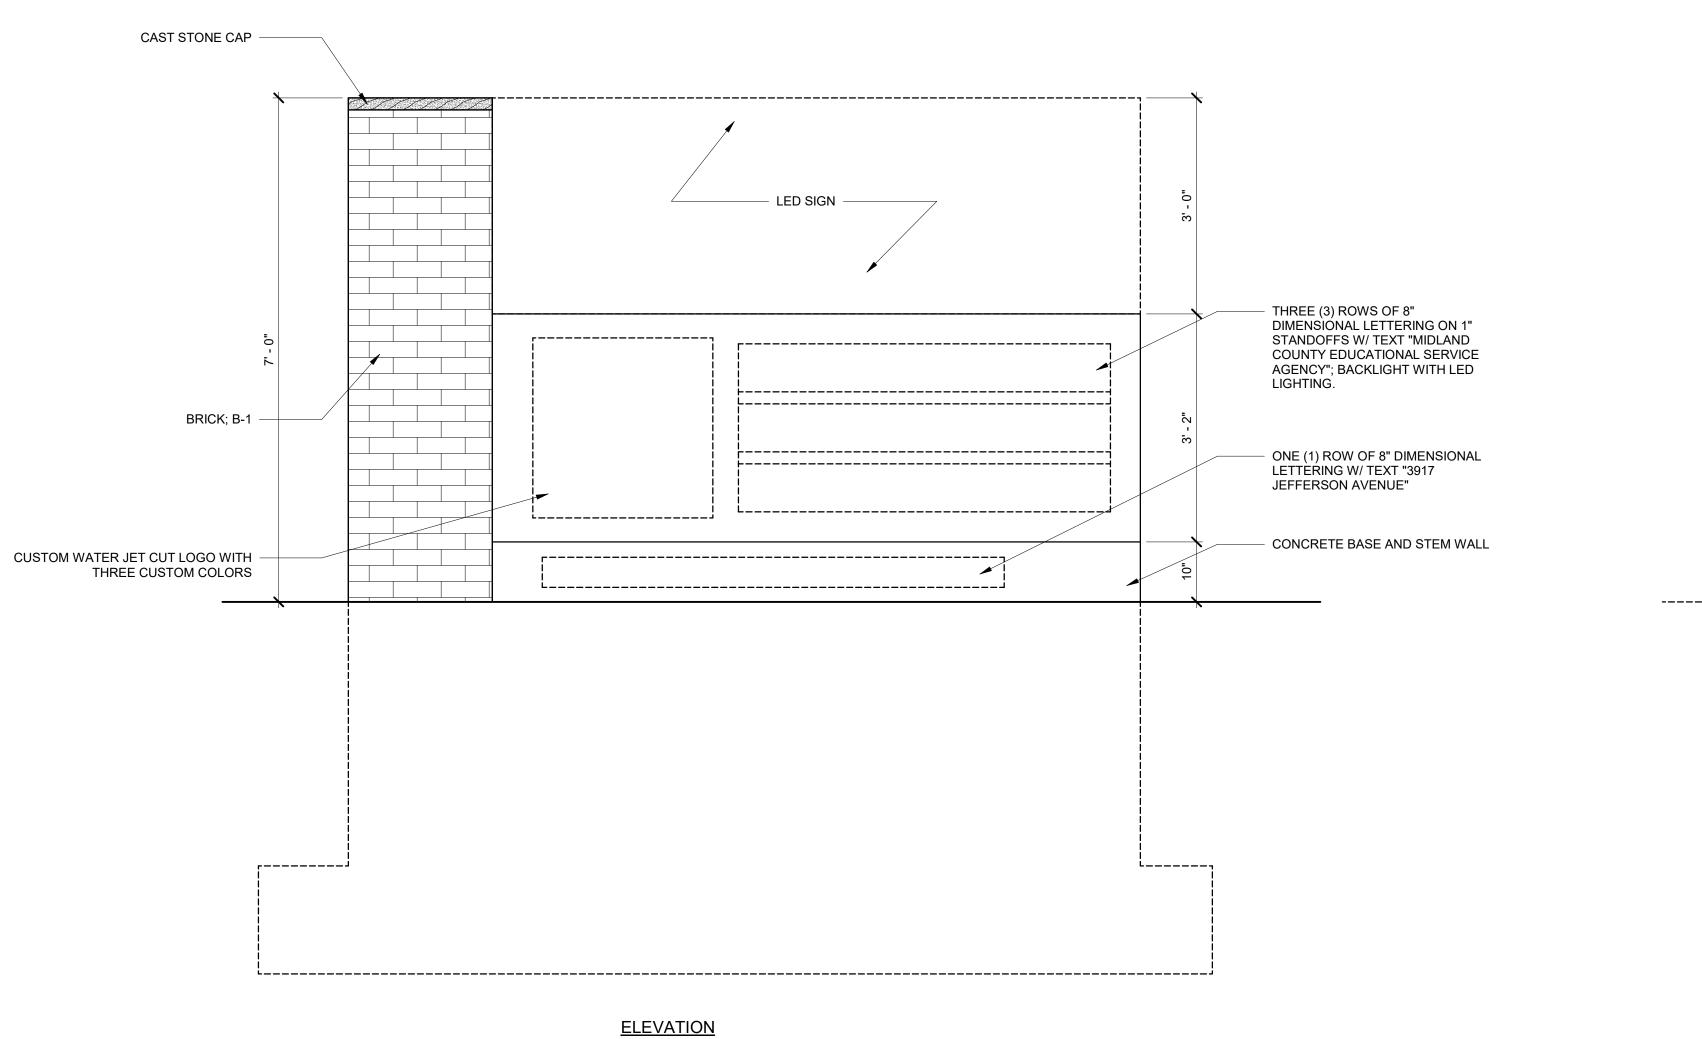

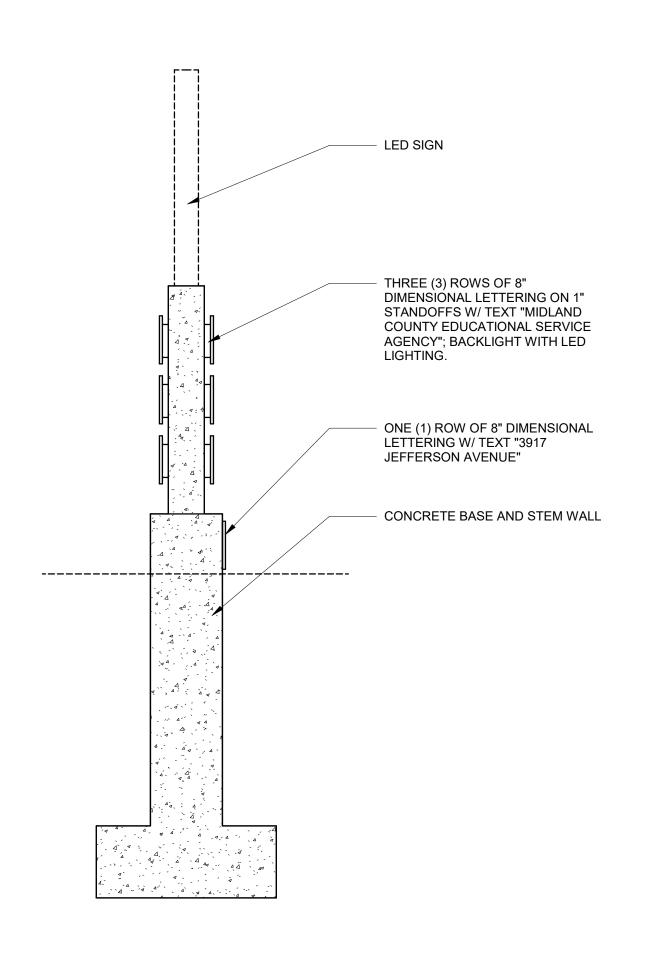

<u>SECTION</u>

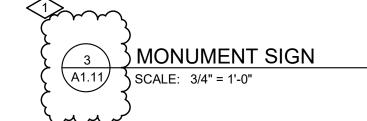

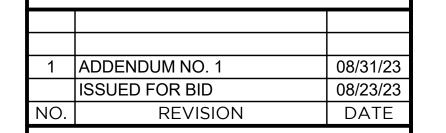

**WTA** ARCHITECTS

WTAARCH.COM

100 S Jefferson Ave, Suite 601

Saginaw, Michigan 48607 989 752 8107 COPYRIGHT © 2023

PROJECT TITLE

RENOVATION AND ADDITION: MIDLAND COUNTY ESA


MIDLAND, MICHIGAN

JMJ

ARCHITECTURAL SITE DETAILS

PROJECT NUMBER 2022006.1 SHEET NUMBER PROJECT DATE A1.11 AUGUST 23, 2023

CHECKED BY

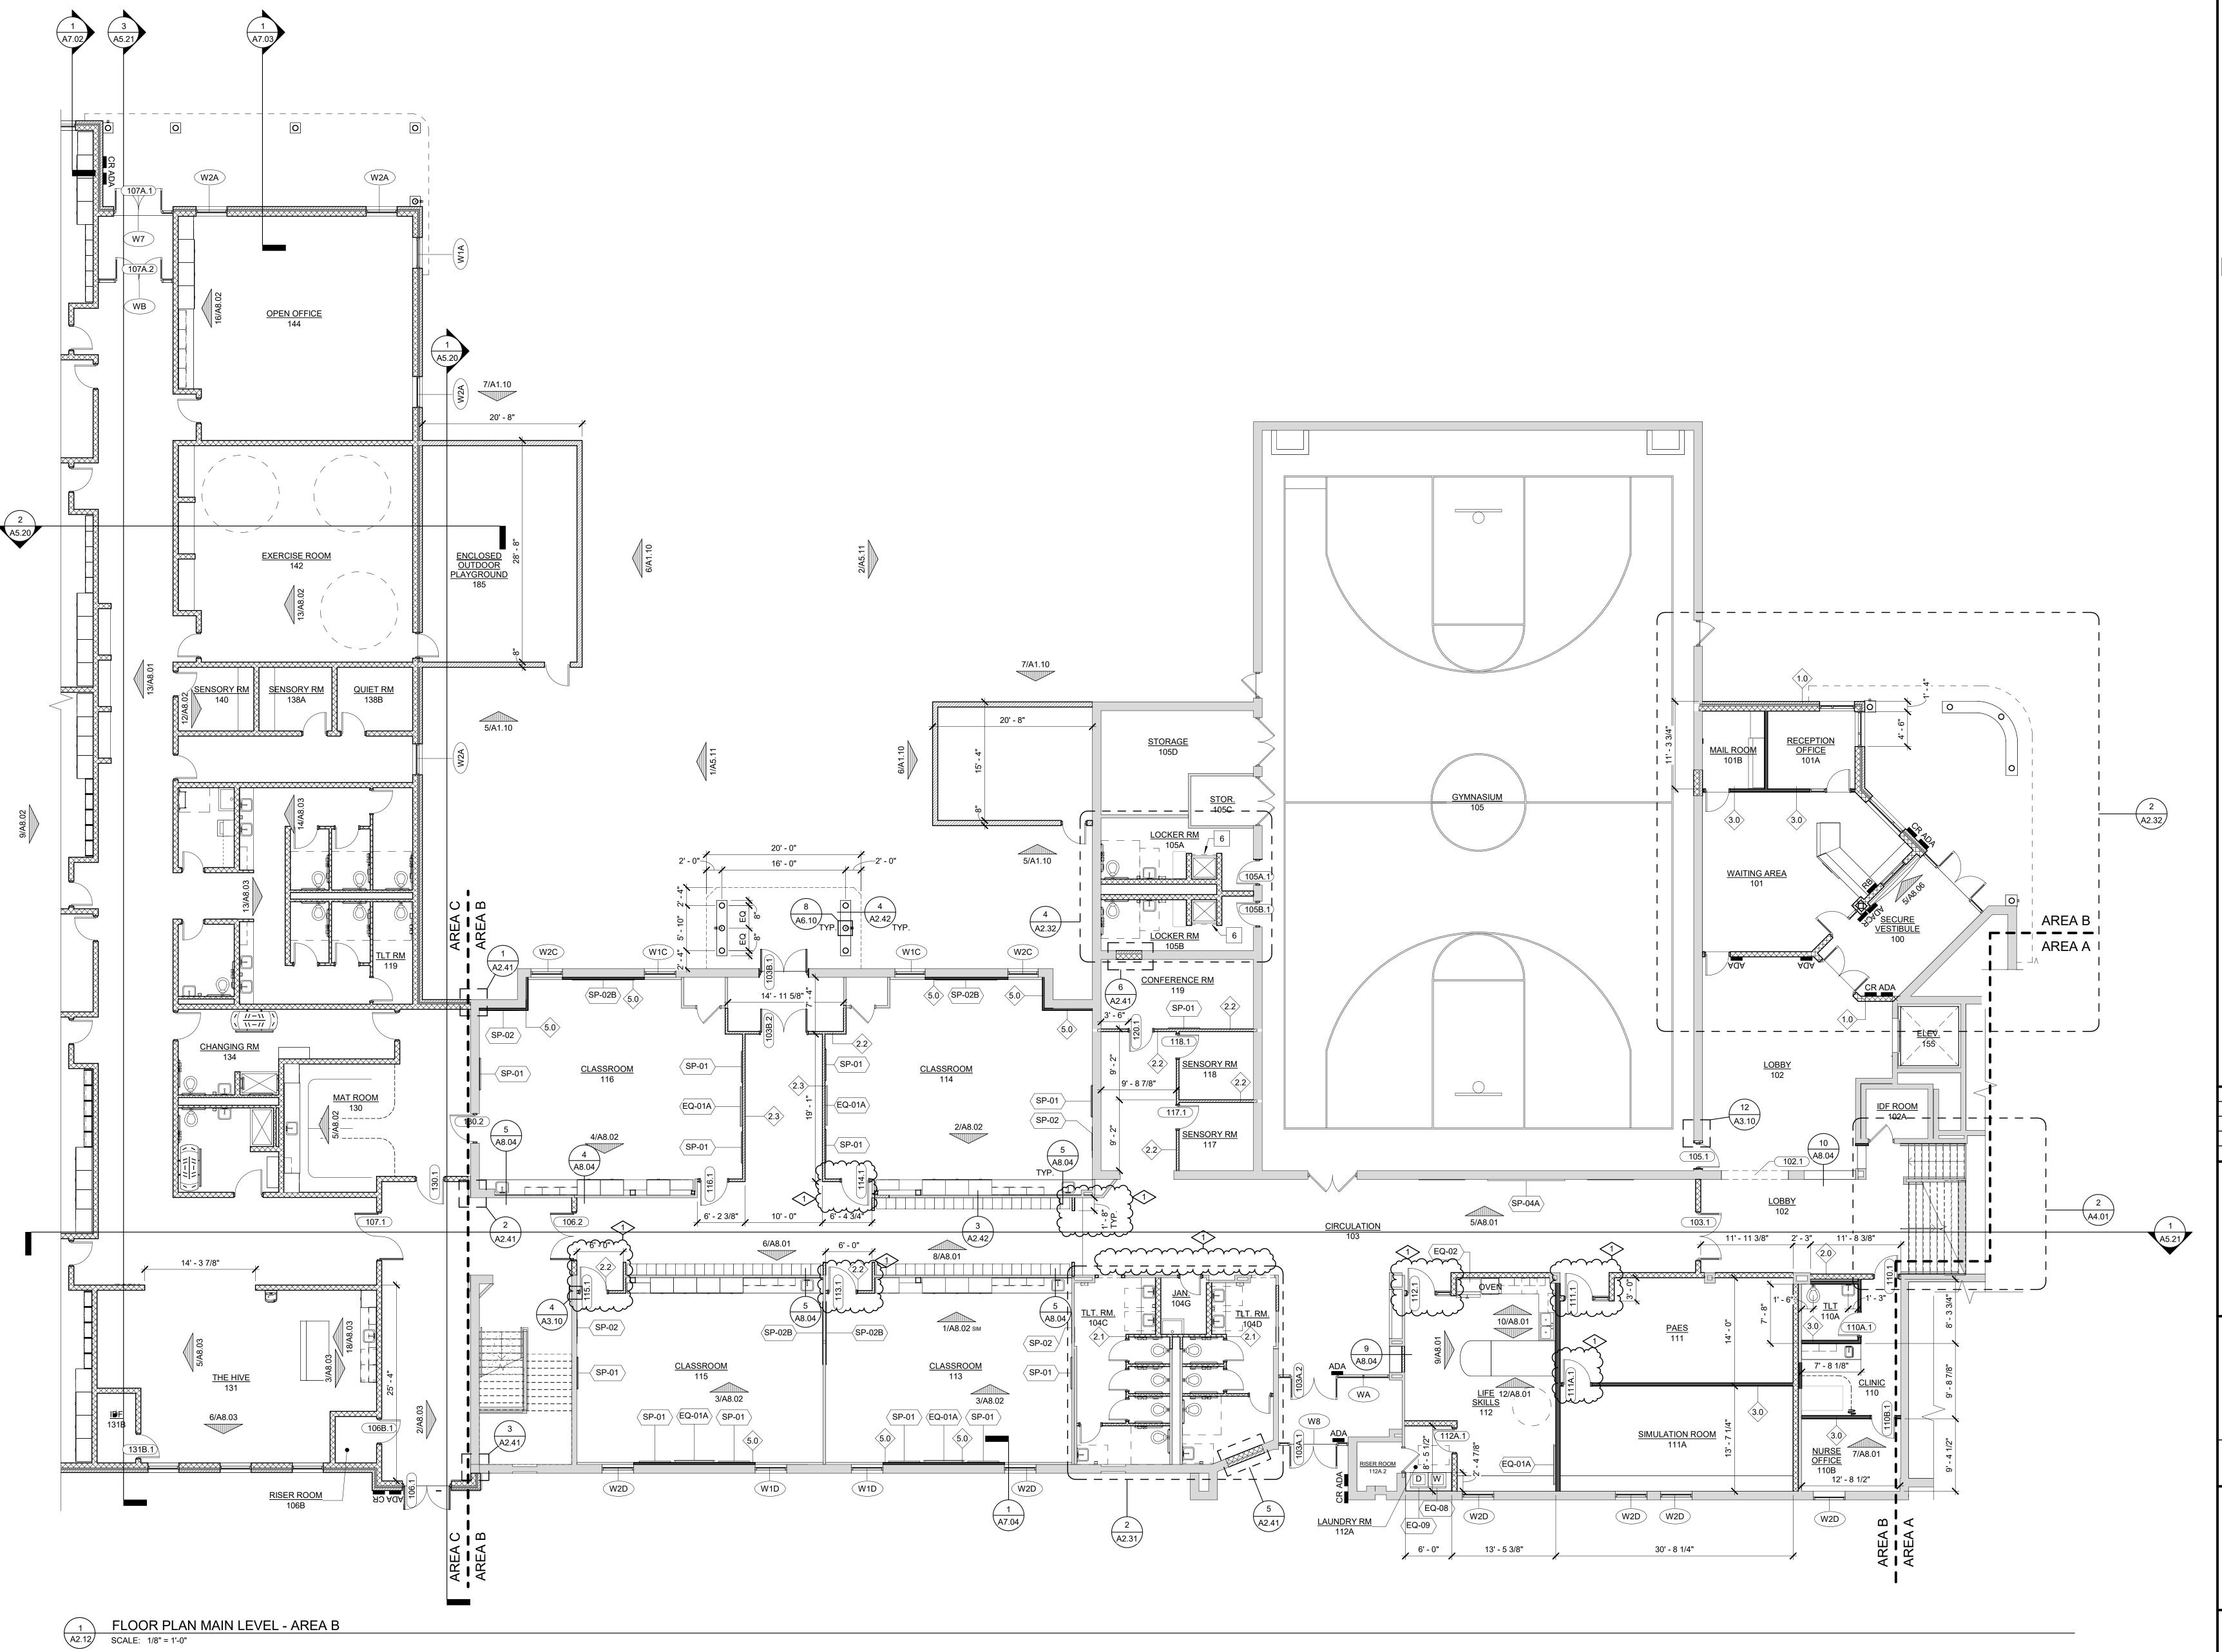


#### GENERAL PLAN NOTES:

- DIMENSIONS INDICATED ARE FROM THE FACE OF STUD AND FACE OF MASONRY UNLESS NOTED OTHERWISE. REFER TO ENLARGED PLANS FOR
- ADDITIONAL DIMENSIONS NOT INDICATED ON OVERALL PLANS. REFER TO FLOOR FINISHPLANS FOR FLOOR
- MATERIALS & PATTERNS. PLUMBING FIXTURES ARE SHOWN FOR REFERENCE & LOCATION ONLY, REFER TO MECHANICAL DRAWINGS FOR DETAILS &
- SPECIFICATIONS. CONTRACTOR TO COORDINATE LOCATIONS OF ADDITIONAL PENETRATIONS THROUGH WALLS AND FLOORS NOT INDICATED ON ARCHITECTURAL DRAWINGS. REFER TO MECHANICAL, PLUMBING, AND ELECTRICAL. REFER TO STRUCTURAL DRAWINGS FOR LINTEL OR FRAMING
- REQUIREMENTS. ALL INTERIOR WALLS ARE 8" CMU (2.0) UNLESS OTHERWISE NOTED.

#### # PLAN KEYNOTES

- 1 TOILET PARTITION 2 MOP SINK (REFER TO MECHANICAL DRAWINGS FOR
- DETAILS) 3 UTILITY SHELF W/ MOP HOLDER; RE: SPEC.
- 4 SENSORY SWING, RE: FURNISHED BY OWNER 5 COPY MACHINE BY OWNER, RE: ELECT.
- 6 SHOWER ROD
- 7 DOWNSPOUT NOZZEL
- 8 NEW COLUMN FOR EXISTING BEAM, CONTRACTOR TO CONDUCT ON SITE CONFERENCE WITH ARCHITECT AND ENGINEER TO VERIFY LOCATION AND DETERMINE IF WHAT IS SHOWN IS
- APPROPRIATE. 9 ADULT CHANGING TABLE
- 10 ADA BENCH

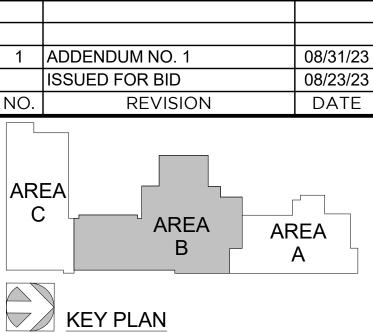



**WTA** ARCHITECTS

WTAARCH.COM

100 S Jefferson Ave, Suite 601 Saginaw, Michigan 48607 989 752 8107 COPYRIGHT © 2023

PROJECT TITLE


RENOVATION AND ADDITION:


MIDLAND COUNTY ESA


MIDLAND, MICHIGAN

FLOOR PLAN - AREA B -MAIN LEVEL

PROJECT NUMBER 2022006.1 SHEET NUMBER PROJECT DATE A2.12 AUGUST 23, 2023 CHECKED BY

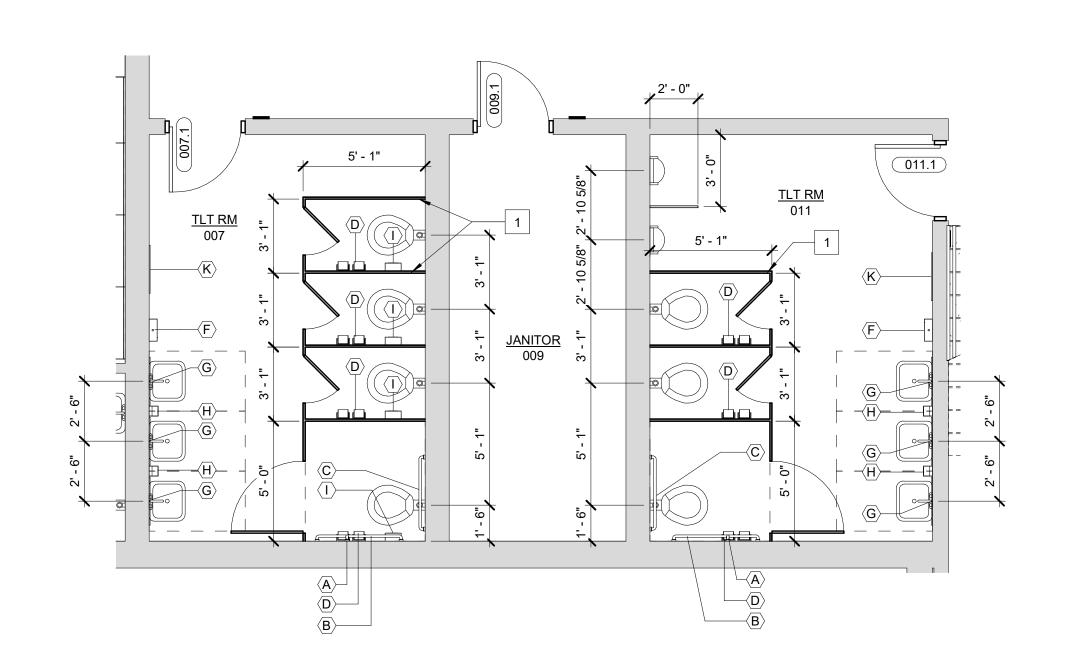

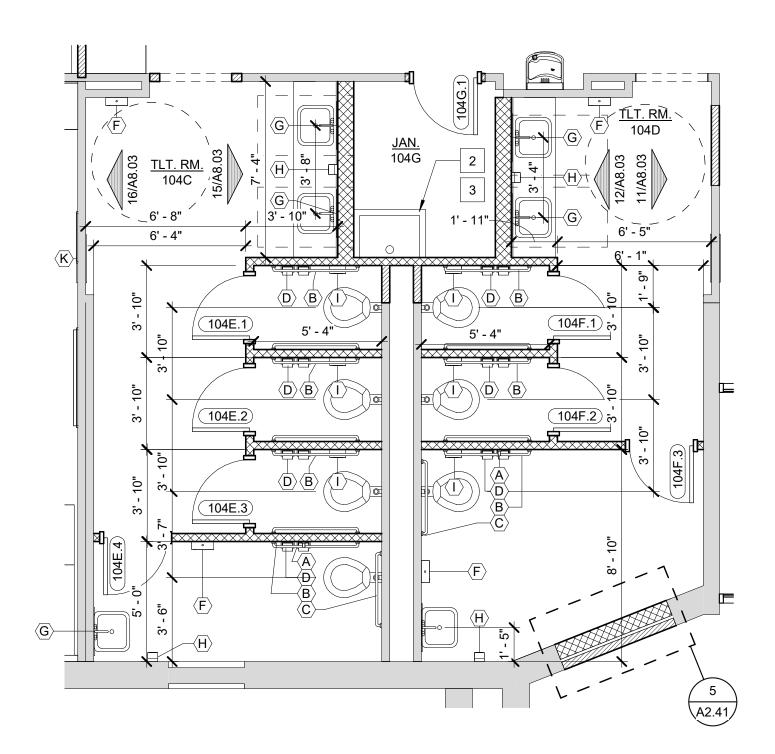

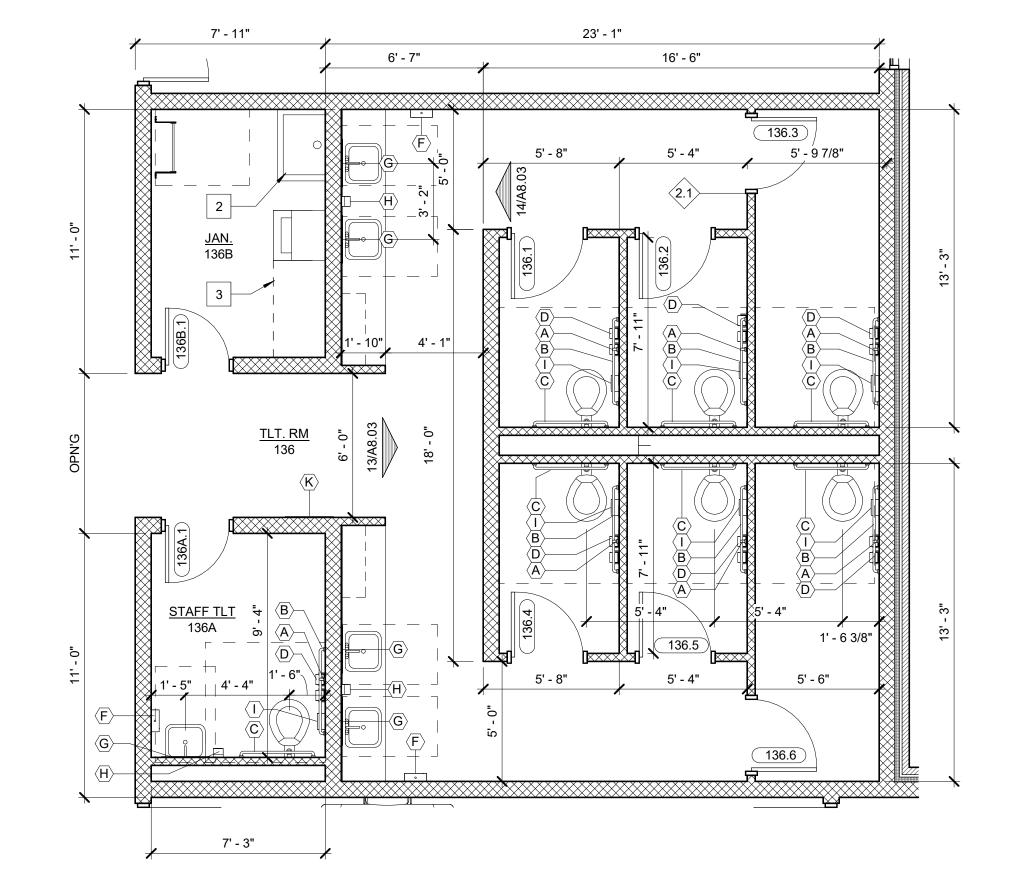

 TOILET PARTITION
 MOP SINK (REFER TO MECHANICAL DRAWINGS FOR DETAILS) 3 UTILITY SHELF W/ MOP HOLDER; RE: SPEC.4 SENSORY SWING, RE: FURNISHED BY OWNER 5 COPY MACHINE BY OWNER, RE: ELECT. 6 SHOWER ROD

GENERAL PLB. / EQUIP. NOTES:

ALL TOILET PARTITIONS SHALL BE BLACK CORE PHENOLIC

7 DOWNSPOUT NOZZEL
8 NEW COLUMN FOR EXISTING BEAM, CONTRACTOR
TO CONDUCT ON SITE CONFERENCE WITH
ARCHITECT AND ENGINEER TO VERIFY LOCATION
AND DETERMINE IF WHAT IS SHOWN IS
APPROPRIATE.

# PLAN KEYNOTES

9 ADULT CHANGING TABLE 10 ADA BENCH

ENLARGED PLAN - TOILET ROOMS 007 & 011

SCALE: 1/4" = 1'-0"

2 ENLARGED PLAN - TOILET ROOM 104E

A2.31 SCALE: 1/4" = 1'-0"

3' - 4" V.I.F. OPEN'G

10' - 0" V.I.F.

<u>TLT RM</u> 317



ADDENDUM NO. 1 08/31/23 ISSUED FOR BID 08/23/23 DATE REVISION

**WTA** ARCHITECTS

MIDLAND COUNTY ESA

WTAARCH.COM

COPYRIGHT © 2023

PROJECT TITLE

SHEET TITLE

CHECKED BY JMJ

100 S Jefferson Ave, Suite 601 Saginaw, Michigan 48607 989 752 8107

RENOVATION AND ADDITION:

MIDLAND, MICHIGAN

ENLARGED PLANS

4 ENLARGED PLAN - TOILET ROOM 203 & 206

SCALE: 1/4" = 1'-0"

8' - 6"

8' - 6"

5 ENLARGED PLAN - TOILET ROOM 317

SCALE: 1/4" = 1'-0"


6 ENLARGED PLAN - TOILET ROOM 316
A2.31 SCALE: 1/4" = 1'-0"

3 ENLARGED PLAN - TOILET ROOM 136
SCALE: 1/4" = 1'-0"

TOILET ACCESSORIES SCHEDULE


		FURNISHED	INSTALLED	
Type Mark	ITEM DESCRIPTION	BY	BY	COMMENTS
		$\sim$	~~~~	`
A	18" VERTICAL GRAB BAR	G.C.	G.C.	3
В	36" GRAB BAR (	G.C.	G.C.	ζ
С	42" GRAB BAR	G.C.	G.C.	{
D	TOILET PAPER DISPENSER	OWNER	G.C.	2
F	PAPER TOWEL DISPENSER	OWNER	G.C.	)
G	24 X 36 MIRROR	G.C.	G.C.	}
Н	SOAP DISPENSER	G.C.	G.C.	Κ
1	SANITARY DISPOSAL	G.C.	G.C.	K
<del>2~~~</del>	ADA SHOWER SBAT	G.C.	G.C.	ANARCIMONALIED ~
K	24 x 48 MIRROR	G.C.	G.C.	STAINLESS STEEL TRIM


SHEET NUMBER PROJECT NUMBER 2022006.1 PROJECT DATE A2.31 AUGUST 23, 2023

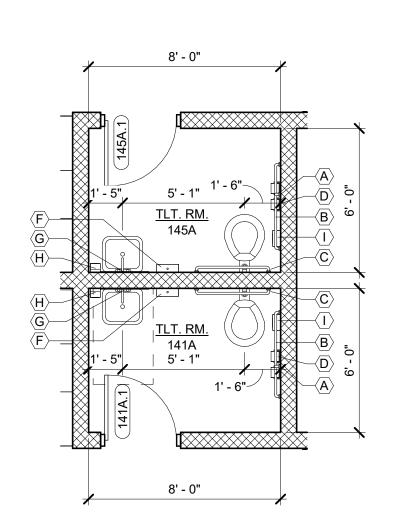


1 ENLARGED PLAN - TOILET ROOM 141A & 145A

SCALE: 1/4" = 1'-0"

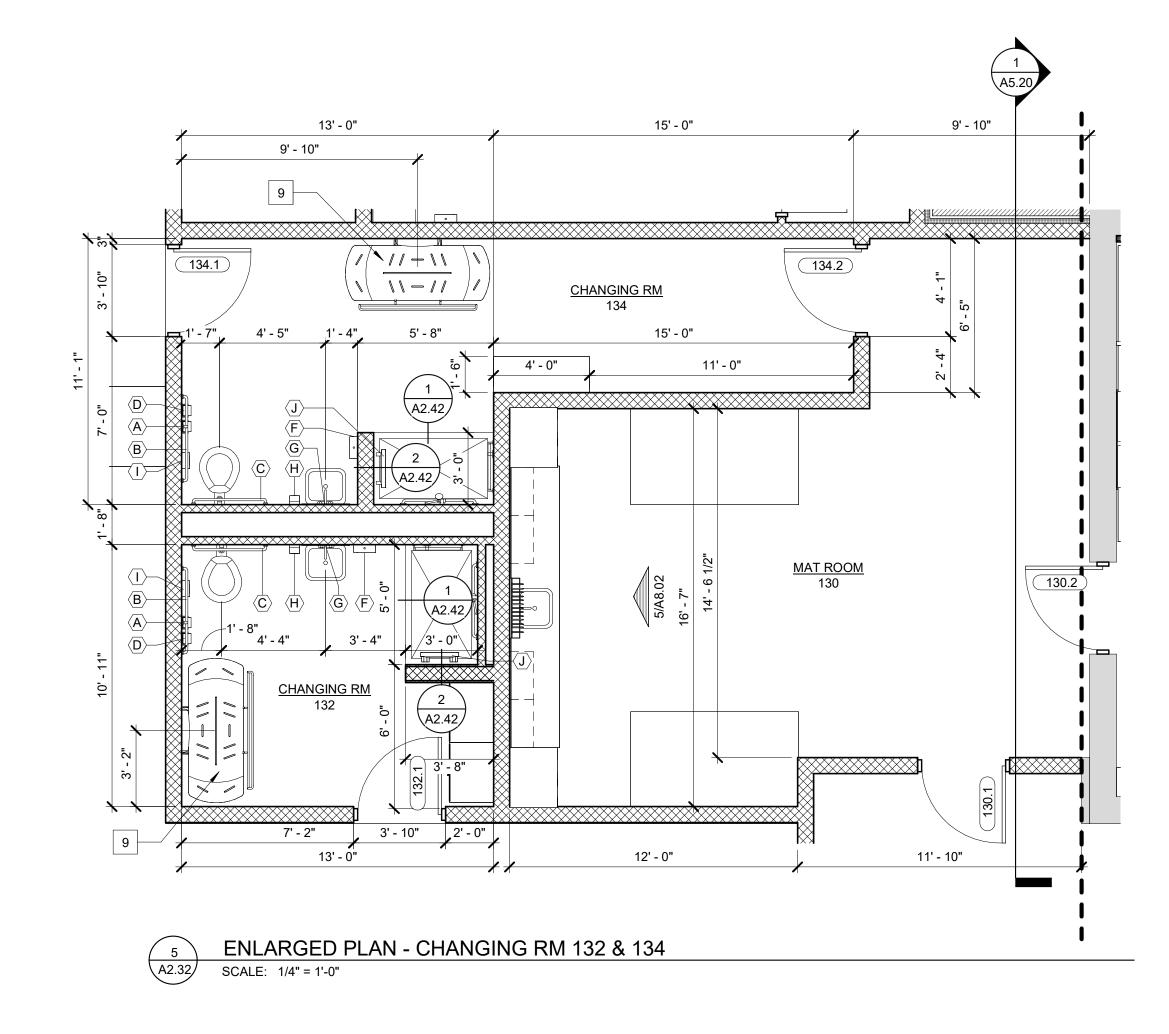

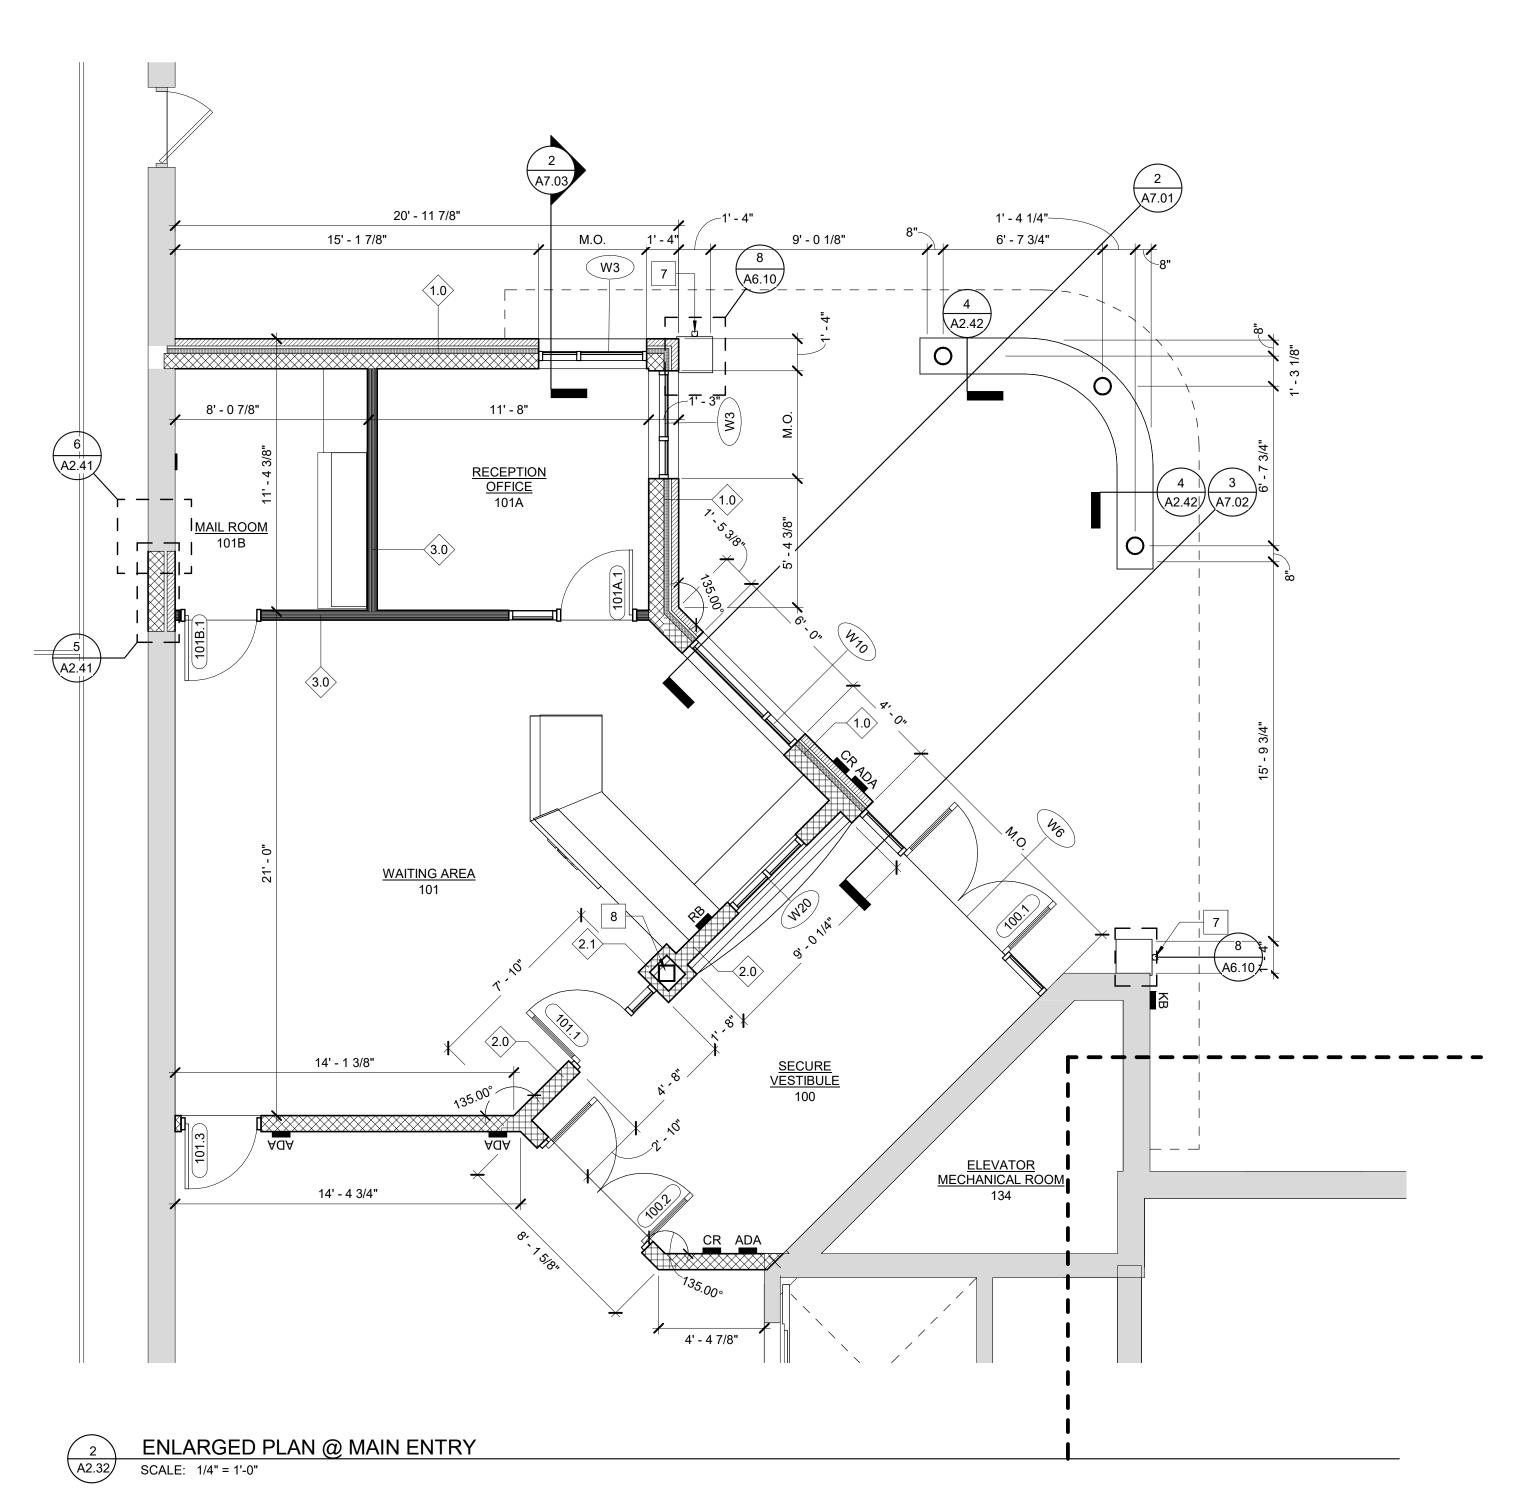

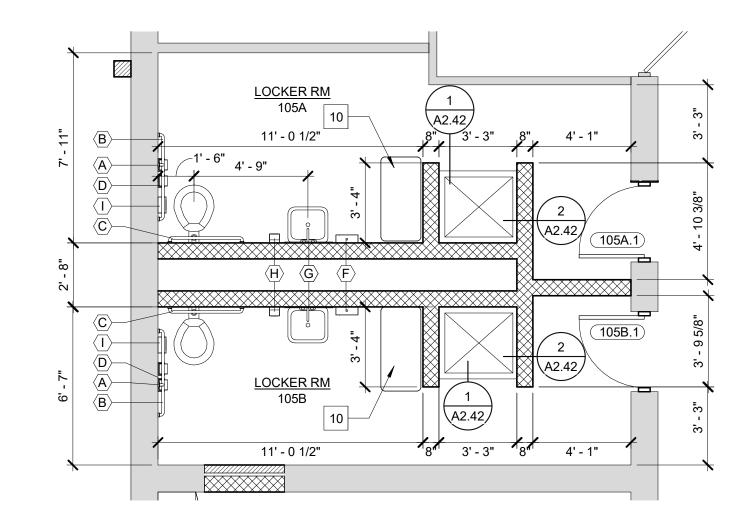

ENLARGED PLAN - LOCKER RM 105A & 105B SCALE: 1/4" = 1'-0"

# PLAN KEYNOTES

1 TOILET PARTITION 2 MOP SINK (REFER TO MECHANICAL DRAWINGS FOR DETAILS)

GENERAL PLB. / EQUIP. NOTES:

1. ALL TOILET PARTITIONS SHALL BE BLACK CORE PHENOLIC

- 3 UTILITY SHELF W/ MOP HOLDER; RE: SPEC.
- 4 SENSORY SWING, RE: FURNISHED BY OWNER 5 COPY MACHINE BY OWNER, RE: ELECT.
- 6 SHOWER ROD
- 7 DOWNSPOUT NOZZEL 8 NEW COLUMN FOR EXISTING BEAM, CONTRACTOR
  TO CONDUCT ON SITE CONFERENCE WITH
  ARCHITECT AND ENGINEER TO VERIFY LOCATION
  AND DETERMINE IF WHAT IS SHOWN IS
  APPROPRIATE.
- 9 ADULT CHANGING TABLE 10 ADA BENCH

1	ADDENDUM NO. 1	08/31/23
	ISSUED FOR BID	08/23/23
NO.	REVISION	DATE



WTA ARCHITECTS

WTAARCH.COM

100 S Jefferson Ave, Suite 601 Saginaw, Michigan 48607 989 752 8107

COPYRIGHT © 2023

PROJECT TITLE

RENOVATION AND ADDITION:

MIDLAND COUNTY ESA

MIDLAND, MICHIGAN

TOILET ACCESSORIES SCHEDULE

ADA SHOWER SEAT G.C. G.C. WALL-MOUNTED

1

ADA SHOWER SEAT G.C. G.C. STAINLESS STEEL TRIM

COMMENTS

Type Mark ITEM DESCRIPTION

36" GRAB BAR 42" GRAB BAR

24 X 36 MIRROR SOAP DISPENSER SANITARY DISPOSAL


18" VERTICAL GRAB BAR


TOILET PAPER DISPENSER DOWNER PAPER TOWEL DISPENSER \ OWNER SHEET TITLE ENLARGED PLANS


PROJECT NUMBER 2022006.1	SHEET NUMBER
PROJECT DATE AUGUST 23, 2023	A2.32
CHECKED BY	,


FINISH M	MATERIAL LE	GEND			
SN	MANUFACTURER	STYLE	COLOR	SIZE	REMARKS
COUSTIC CEI			[144 HT	Tour voi	
CT-1	USG	RADAR CLIMA PLUS HIGH NRC	WHITE	24 X 24	
CT-2	ARMSTRONG	METALWORKS SECURELOCK NO PERF.	WHITE	24 X 24	
COUSTIC PAI P-1	NEL ARMSTRONG	TECTUM SHAPES	FIELD PAINTED PT-5	46" X 40" X 2"	CEILING SUSPENDED IN HIVE
P-2	USG	HEXAGON COLORTEX - BARZ	WHITE OAK WOODGRAIN	4" X 8"	CEILING BAFFLES CORRIDOR
.P-3	USG	COLORTEX - BARZ	WHITE OAK WOODRAIN	2" x 10"	201 CEILING BAFFLES CORRIDOR
NP-4	ARMSTRONG	INVISACOUSTICS	FIELD PAINTED PT-10	24" X 48" X 3/4"	201 CEILING DECK IN HIVE
 ARTIFICAL TUF ГURF-1		COMMAND PLAY		15'x50'	CLIENTO DEGITATIVE
BRICK	1			1	
3-1	BELDEN BRICK	MODULAR 141-145 VERTICAL	22-44	3-5/8" X 2-1/4" X 7-5/8"	EXTERIOR
3-2	BELDEN BRICK	MODULAR 470-479	LIGHT A	3-5/8" X 2-1/4" X 7-5/8"	MATCH EXISTING INTERIOR
CARPET CPT-1	INTERFACE	BITRATE	DARK TEAL	10 X 40	ASHLAR INSTALL- ADMIN
CPT-2	INTERFACE	SOURCE MATERIAL	GRAPHITE	10 X 40	CORRIDORS  ASHLAR INSTALL-OFFICES
CPT-3	INTERFACE	UPLOAD	LIGHT TEAL	10 X 40	ACCENT
CPT-4 CPT-5	MANNINGTON MANNINGTON	EBB CURRENT	STREAM 15844 STREAM 15844	18" x 36" 18" x 36"	AHSLAR - SUPERINT. ASHLAR - SUPERINT.
CPT-6 CPT-7	SHAW PATCRAFT	OBSERVE COLOR TILE CONNECTING	CALM OCEANS 05405 STROLL 00540	9 X 36 24 X 24	ASHLAR - ADMIN CONF. MONOLITHIC
CPT-8 CPT-9	FORBO FORBO	FLOTEX EXPLORE PLANKS FLOTEX METRO TILE	065373 STEEL 546028 JADE	39.37" x 9.48" x .2" 20" x 20" x .2"	ASHLAR MONOLITHIC
CPT-10	FORBO	FLOTEX TRIAD PLANKS	131007 STEEL	39.37" x 9.48" x .2"	ASHLAR
CPT-11 CERAMIC TILE		FLOTEX MONTAGE PLANKS		39.37" x 9.48" x .2"	ASHLAR
CT-1 CT-2	CROSSVILLE CROSSVILLE	COLOR BLOX READY TO WEAR	CELESTIAL HORIZON HAND IN GLOVE	12" x 12" 12" x 24"	STAFF TOILET FLOOR FIELD WALL TILE
CT-3	AMERICAN OLEAN	CREEKWOOD	MAPLE LAKE	6" x 36"	
CT-4 CT-5	AMERICAN OLEAN AMERICAN OLEAN	COLOR STORY COLOR STORY	84 PEACOCK BLUE(TEAL) 68 GRACE (PURPLE)	4" x 12" 4" x 12"	VIBRANT GLOSS VIBRANT GLOSS
CT-6 CT-7	AMERICAN OLEAN AMERICAN OLEAN	COLOR STORY COLOR STORY	77 MANDARIN (ORANGE) 76 GREEN APPLE (GREEN)	4" x 12" 4" x 12"	VIBRANT GLOSS VIBRANT GLOSS
CT-8 CT-9	NOT USED  AMERICAN OLEAN	COLOR STORY	84 PEACOCK BLUE HEXAGON	1.5" HEXAGON	VIBRANT GLOSS
CT-10	OLYMPIA TILE	OCEANI	AEQUA	2 X 10	LIFE SKILLS SUBWAY
CT-11 CT-12	ONIX AMERICAN OLEAN	2003509 RODAS COLOR STORY	TESSERAE 77 MANDARIN	1" X 1" 4" x 4"	STAFF LOUNGE VIBRANT GLOSS
CT-13 CT-14	AMERICAN OLEAN AMERICAN OLEAN	COLOR STORY COLOR STORY	76 GREEN APPLE 68 GRACE	4" x 4" 4" x 4"	VIBRANT GLOSS VIBRANT GLOSS
CT-15	AMERICAN OLEAN	COLOR STORY	84 PEACOCK BLUE(TEAL)	4" x 4"	VIBRANT GLOSS
CONCRETE MA CMU-1	MFR	STANDARD	UNFINISHED (FIELD PAINTED)	VARIESx8"x16"	
DECORATIVE F DPS-1	PANEL SYSTEM MARLITE	SIEVA LARGE PANEL	HPL - WILSONART LANDMARK	16'W X 8'H OA	
	 REINFORCED PLASTION	? PANFI	WOOD		
FRP-1	MARLITE SYMMETRIX	SUBWAY HORIZONTAL	LOGGIA	4' X 4'	TILE SIZE = 6" X 3"
GLASS BLOCK					
GB-1 LOCKERS	BELDEN BRICK	CROSS RIBBED	CLEAR	8 X 8 X 4	MATCH EXISTING
_KR-1 METAL PANEL	ASI	BLACK CORE PHENOLIC	DESERT ZEPHYR 4583		
MP-1 MP-2	PAC-CLAD PAC-CLAD		CUSTOM COLOR GRANITE		EXTERIOR CANOPY EXTERIOR CANOPY CEILING
PAINT					
PT-1	SHERWIN WILLIAMS		LOGGIA SW7506		OVERALL PAINT
PT-2	SHERWIN WILLIAMS		REALLY TEAL SW6489		TEAL ACCENT
PT-3	SHERWIN WILLIAMS		RIVULET SW6760		LIGHT TEAL
PT-4	SHERWIN WILLIAMS		WOOD VIOLET SW6557		PURPLE ACCENT
PT-5	SHERWIN WILLIAMS		ADVENTURE ORANGE SW6655		ORANGE ACCENT
PT-6	SHERWIN		PARAKEET SW6711		GREEN ACCENT
PT-7	WILLIAMS SHERWIN		OVERJOY SW6689		YELLOW ACCENT
PT-8	WILLIAMS SHERWIN		PAVESTONE SW7642		DOORS AND EXISTING TRIM
PT-9	WILLIAMS SHERWIN		GAUNTLET GRAY SW7019		EXISTING ENTRY ACCENT
PT-10	WILLIAMS		IRON ORE SW7069		HIVE EXPOSED CLNG
PT-11	WILLIAMS SHERWIN		HIGH REFLECTIVE WHITE		J.
	WILLIAMS		SW7757		
PLASTIC LAMII	NATE WILSONART	SOFTGRAIN FINISH	LANDMARK WOOD 7981K-12		CASEWORK & RECEPTION
PLAM-2	WILSONART	FINE LINE TEXTURE	BLACK HILLS OAK 8248K-79		DESKY 1 1 1 1 1 1 1 1 1 1 1 1 1 1 1 1 1 1 1
POLISHED GOI	5-0-0-0-0	POLISHED CONCRETE	NATURAL UNCOLORED		CLASS 3 GRIND
QUARTZ COUN QC-1	NTERTOP SILESTONE	OCEAN JASPER	THE PERSON PROPERTY OF	<u> </u>	POLISHED
KESTLYENT-BA	SECULIA DE LA COMPANSION DE LA COMPANSIO				
RWB-1 RWB-2	ROPPE ROPPE	PINNACLE 4-1/2" COVE PINNACLE 6" COVE	123 CHARCOAL 123 CHARCOAL		
RWB-2 RESILIENT STA	TARKETT AIR TREAD	4" VENTED RUBBER BASE	BLACK		
RST-1	ROPPE	MARBLE FIESTA WITH RUBBER STRIP	MARENGO M410		WITH RUBBER STRIP
RESILIENT TIL			loov:	1	longer course
RTF-1 RTF-2	PATCRAFT PATCRAFT	GRAPH PLANAR	GRAVEL TEAL PLANAR	24 X 24 24 X 24	STAFF LOUNGE FIELD STAFF LOUNGE ACCENT
RTF-3 RESINOUS BAS	ROPPE	MARBLE FIESTA	MARENGO M410		~~~~~~~~~~~~~~~~~~~~~~~~~~~~~~~~~~~~~~
RB-1	SHERWIN WILLIAMS	1/4" RESUFLOR DECO FLAKE	RIVER ROCK		1
RESIMOUS FLO	DORING	······································			Lummy (1)
RF-1	SHERWIN WILLIAMS	1/4" RESUFLOR DECO FLAKE	RIVER ROCK		
SOLID SURFAC SS-1	CORIAN		LINEN		
SS-2 SS-3	CORAN	***************************************	ARTISTA GRAY	· · · · · · · · · · · · · · · · · · ·	~~~~ <u>~</u>
	CÖRIÁN	<del> </del>	LAVA RÖCK	<del></del>	1
STONE ST-1			SEPIA		EXTERIOR




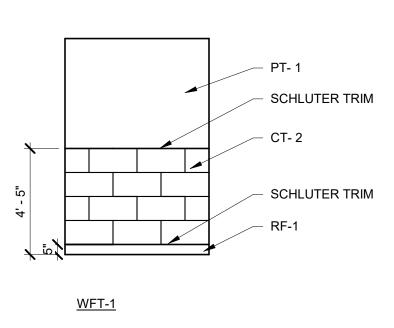


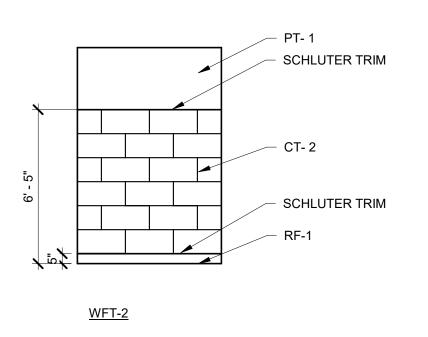


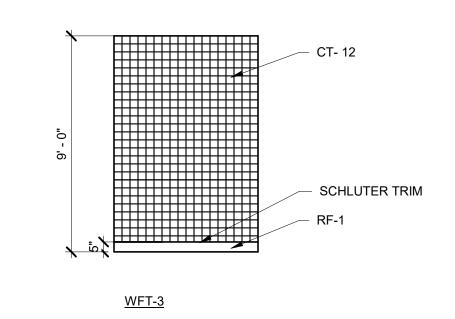


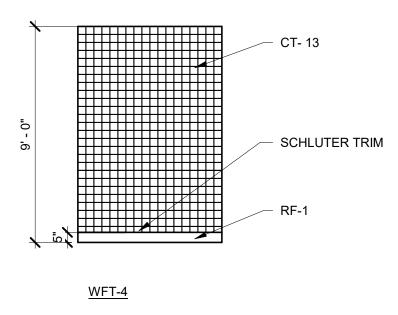


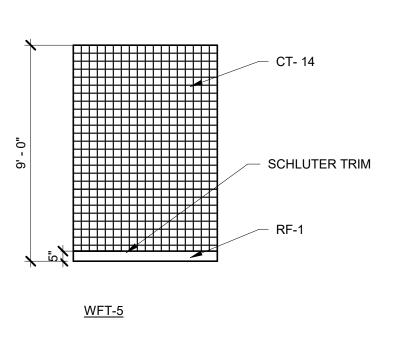


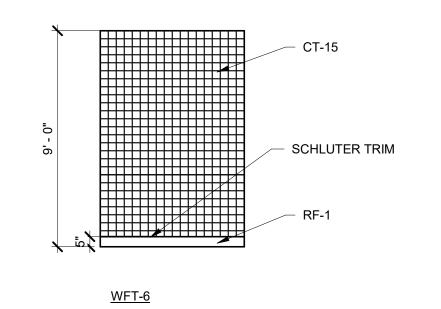


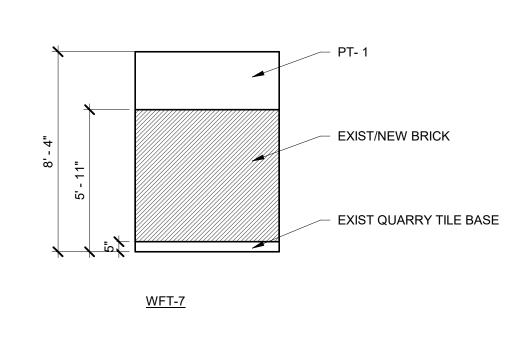


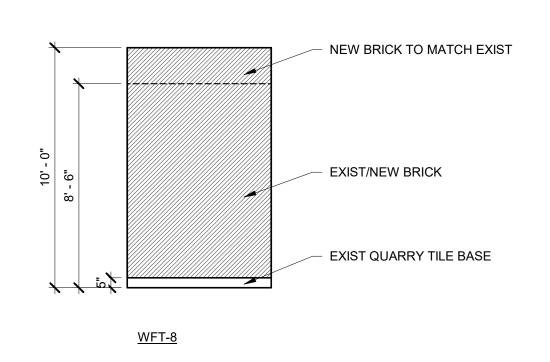


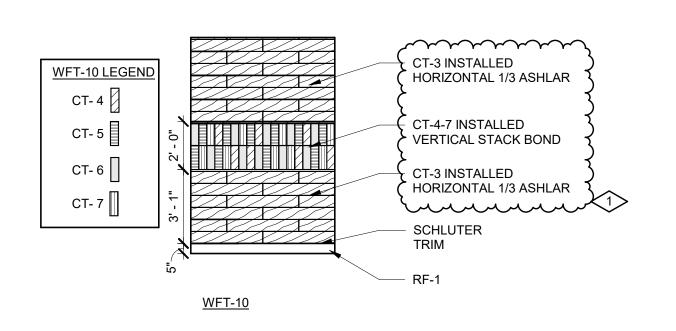

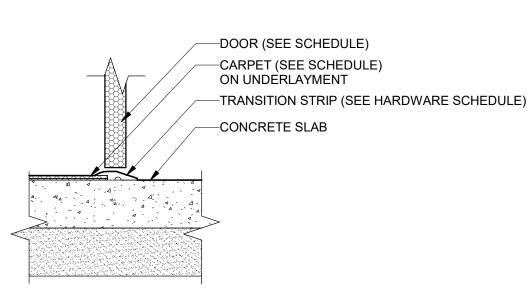


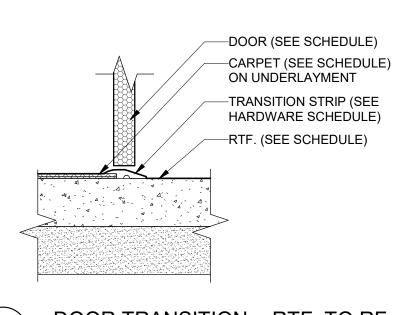

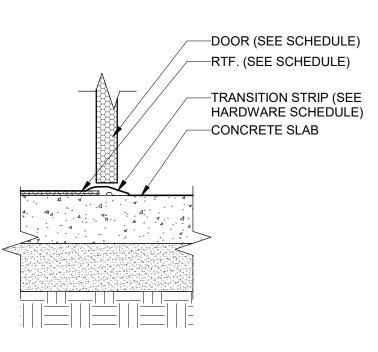

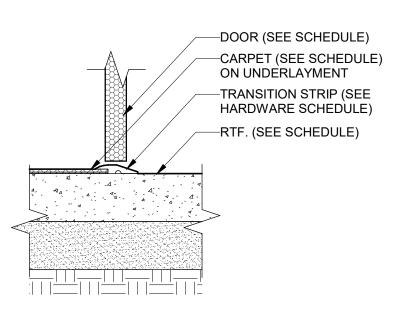





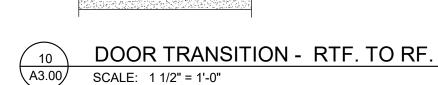





DOOR TRANISTION - RTF. TO CPT. 12 DOOR TRANIS A3.00 SCALE: 1 1/2" = 1'-0"

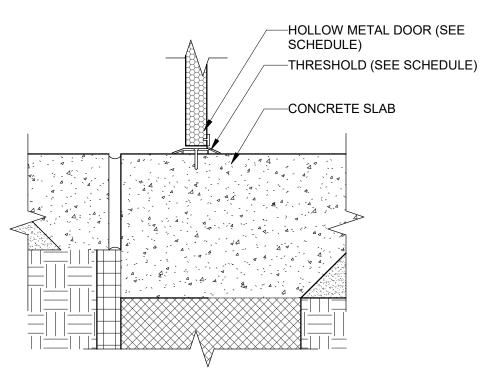

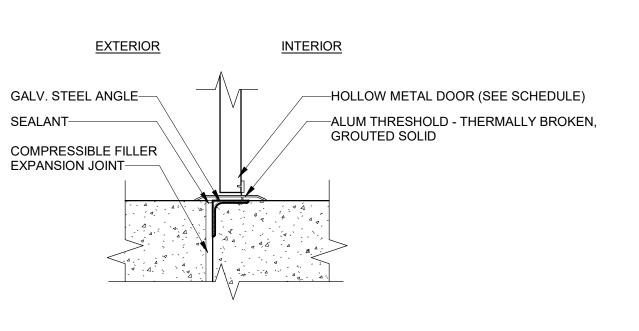

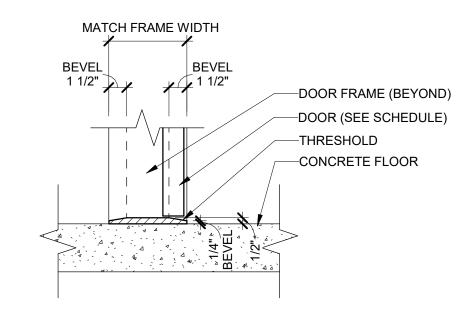

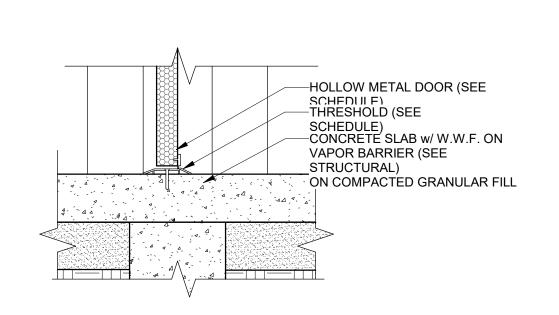

13 H.M. DOOR EXT. SILL
A3.00 SCALE: 1 1/2" = 1'-0" EXTERIOR DOOR THRESHOLD DETAIL SCALE: 1 1/2" = 1'-0"

DOOR THRESHOLD DETAIL SCALE: 1 1/2" = 1'-0"

16 HM DOOR DETAIL @ 106
A3.00 SCALE: 1 1/2" = 1'-0"

#### RECOMMENDATIONS. ALL NEW CASEWORK TO HAVE HIGH PRESSURE LAMINATE EXTERIOR AND MELAMINE LAMINATE INTERIOR. UNLESS OTHERWISE NOTED. ALL FURNITURE THAT IS NOT BUILT-IN IS NOT PART OF THE SCOPE OF THIS PROJECT.

REFER TO FINISH MATERIAL SCHEDULE FOR SPECIFIC MANUFACTURER, STYLE, COLOR & SIZE INFORMATION

AT STUD WALL LOCATIONS PROVIDE BLOCKING AS

REQUIRED FOR ALL WALL MOUNTED ITEMS, INCLUDING BUT NOT LIMITED TO: GRAB BARS, MIRRORS, DISPENSERS, ETC. (REFER TO MFR.

INTERIOR GENERAL NOTES:

REFER TO REFLECTED CEILING PLANS FOR CEILING TYPES, HEIGHTS AND FINISH INFORMATION . AT CERAMIC TILE LOCATIONS, INSTALLER TO USE APPROPRIATE TROWEL TO ACCOMMODATE DIFFERENT TILE THICKNESSES

PROVIDE RESILIENT BASE AT TOE KICK OF ALL CASEWORK AND BEHIND ALL MOVABLE EQUIPMENT/APPLIANCES, WHEN SCHEDULED WITHIN A ROOM.

. TYPICAL CASE WORK NOTATION EXAMPLE

—A.W.S. DESIGNATION 10. ALL CASEWORK LOCKABLE UNLESS

OTHERWISENOTED (DOORS AND DRAWERS). 1. ALL WALL MOUNTED MECHANICAL EQUIPMENT (DIFFUSERS, GRILLES, ETC) AND ELECTRICAL EQUIPMENT (PANELS, ETC) SHALL BE PAINTED TO MATCH THE ADJACENT WALL COLOR. REFER TO MECHANICAL AND ELECTRICAL DRAWINGS FOR QUANTITIES AND LOCATIONS.


2. WHERE REMOVAL OR MODIFICATION TO A FINISH MATERIAL IS SHOWN, BUT NEW FINISHES ARE NOT SCHEDULED, PATCH AND REPAIR TO MATCH EXISTING FINISH CONDITION AS REQUIRED.


13. PROVIDE APPROPRIATE TRANSITION STRIPS BETWEEN DISSIMILAR FLOORING MATERIALS AT

VERTICAL AND/OR HORIZONTAL APPLICATIONS. 14. CARPET EDGES SHALL BE CAPTURED BY NOSING, NOSING SHALL BE MITERED AT ALL OUTSIDE AND

INSIDE CORNER CONDITIONS. ALL EDGES OF CARPET SHALL BE SEALED WITH A SEAM SEALER.

15. FLOORING CONTRACTOR SHALL INSTALL INSERTS TO MATCH ADJACENT FLOORING MATERIAL AT ALL ELECTRICAL FLOOR BOX COVERS AS REQUIRED.

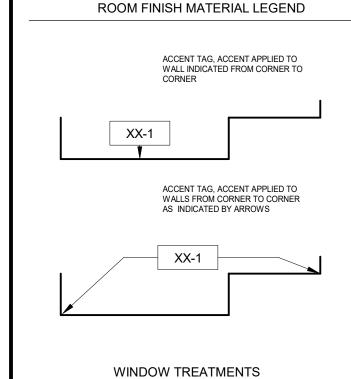

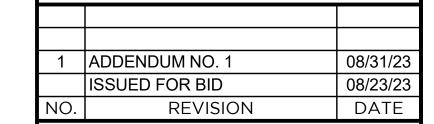



WTAARCH.COM

**WTA** ARCHITECTS

100 S Jefferson Ave, Suite 601 Saginaw, Michigan 48607 989 752 8107 COPYRIGHT © 2023

PROJECT TITLE


RENOVATION AND ADDITION: MIDLAND COUNTY ESA

MIDLAND, MICHIGAN

FINISH SCHEDULES AND LEGENDS

SHEET NUMBER PROJECT NUMBER 2022006.1 PROJECT DATE AUGUST 23, 2023 CHECKED BY

A3.00 JMJ

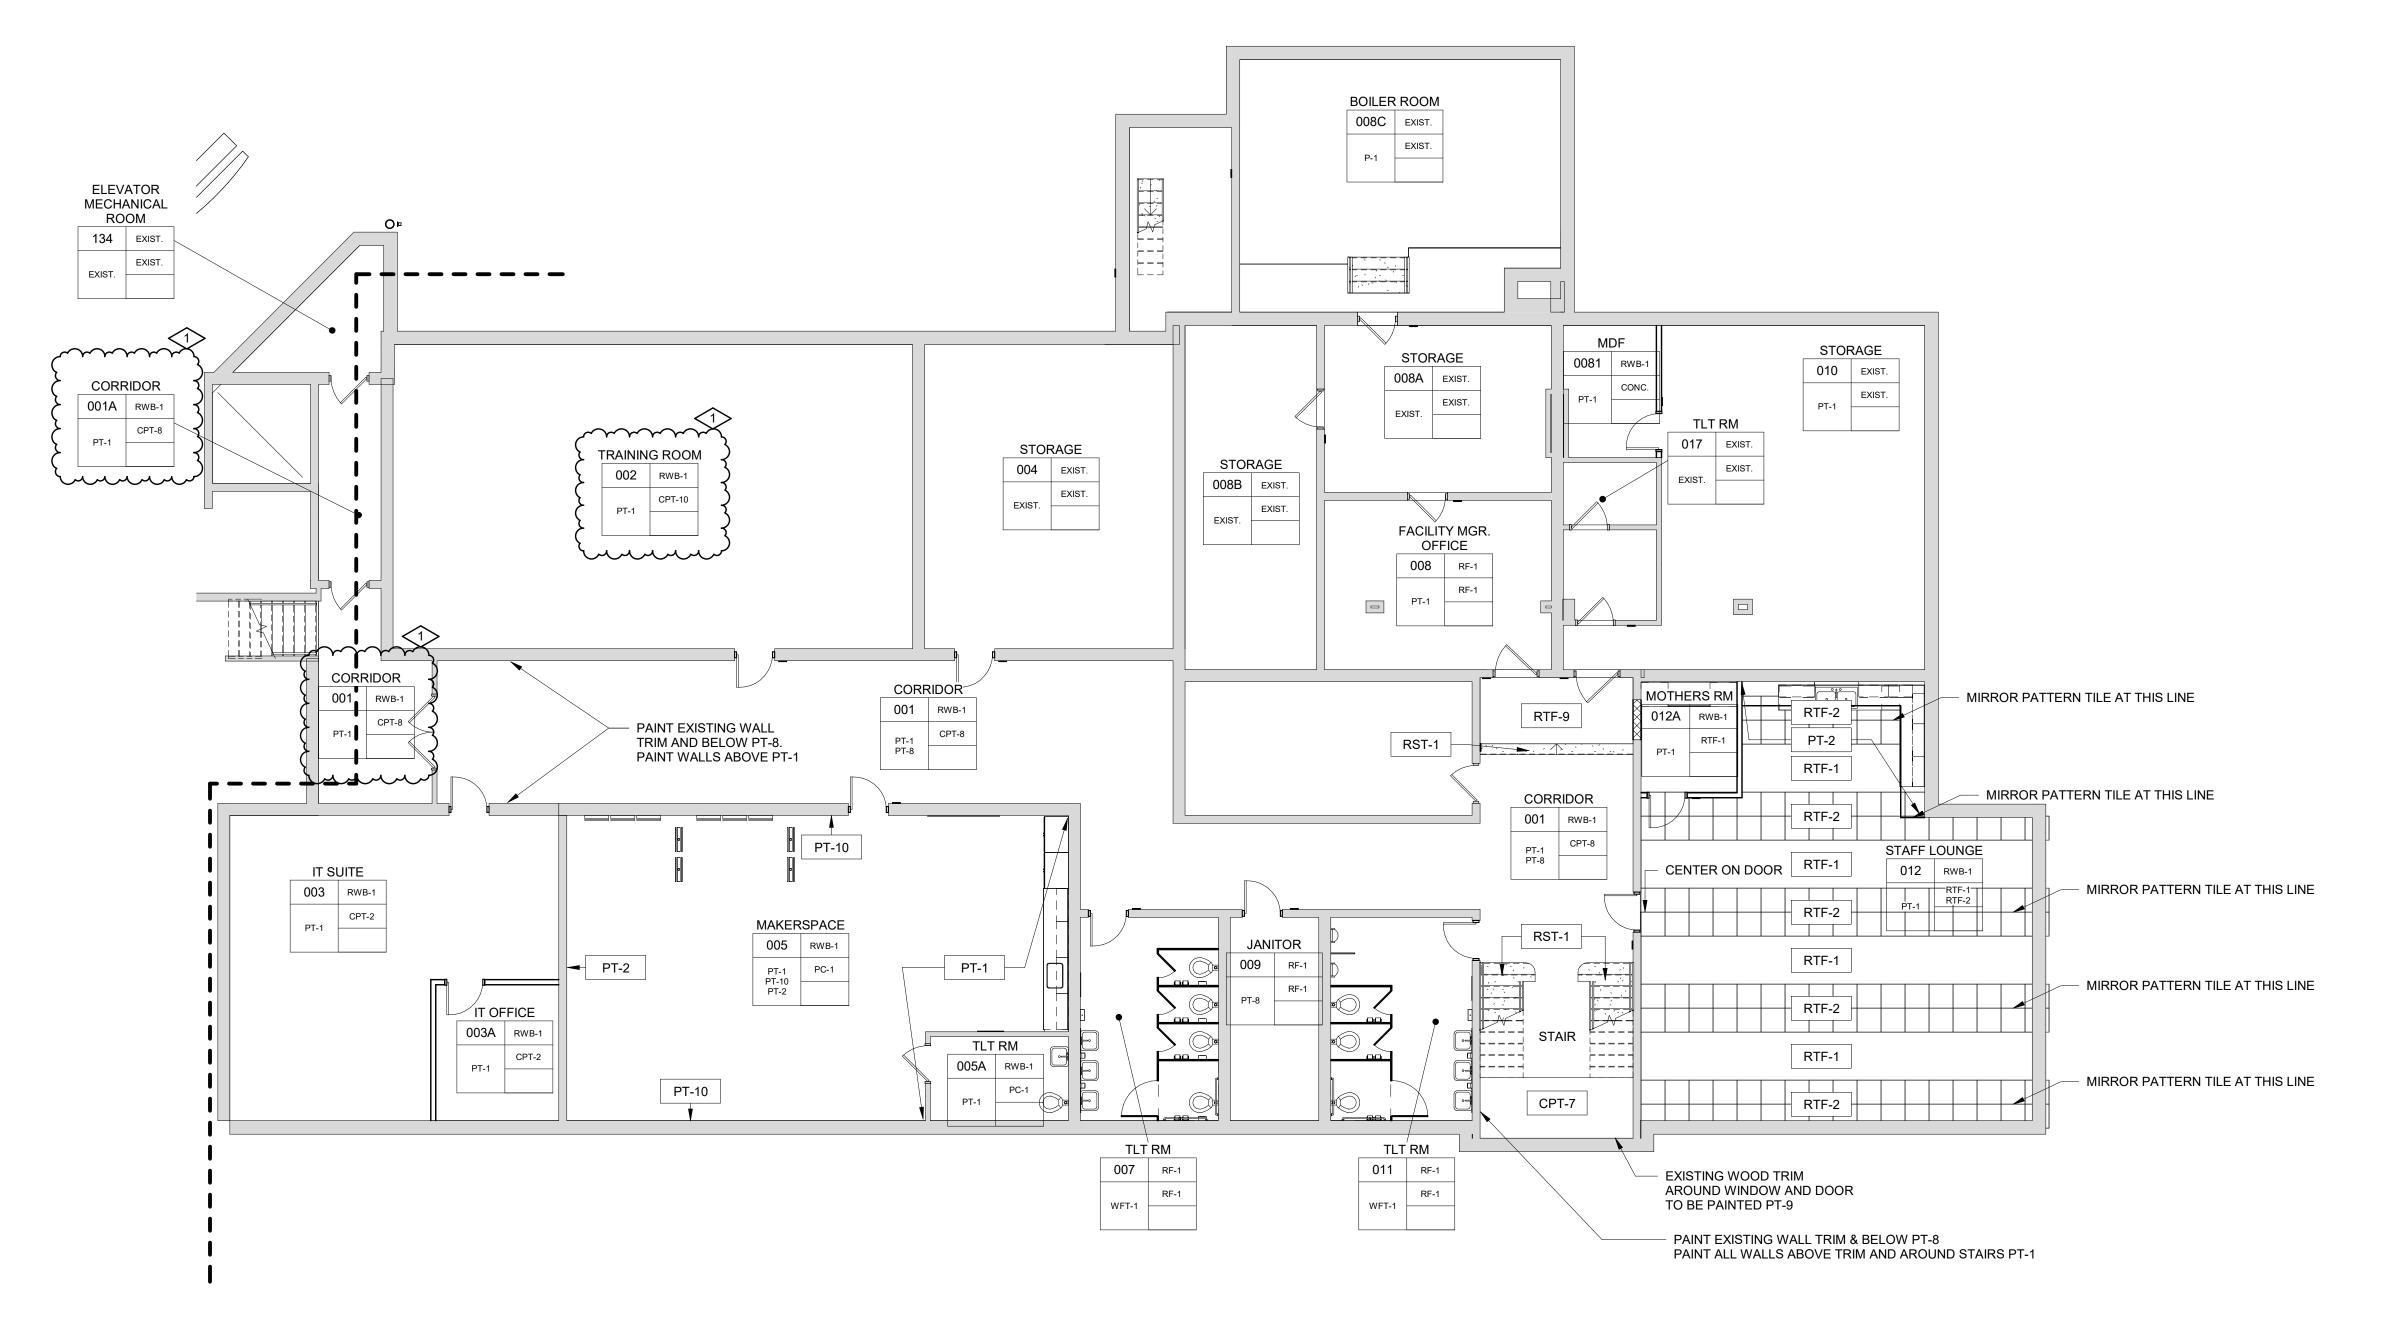


LOWER LEVEL - AREA A SCALE: 1/8" = 1'-0"

#### **INTERIOR GENERAL NOTES:**

- AT STUD WALL LOCATIONS PROVIDE BLOCKING AS REQUIRED FOR ALL WALL MOUNTED ITEMS, INCLUDING BUT NOT LIMITED TO: GRAB BARS, MIRRORS, DISPENSERS, ETC. (REFER TO MFR. RECOMMENDATIONS.
- 2. ALL NEW CASEWORK TO HAVE HIGH PRESSURE LAMINATE EXTERIOR AND MELAMINE LAMINATE INTERIOR. UNLESS OTHERWISE NOTED.
- ALL FURNITURE THAT IS NOT BUILT-IN IS NOT PART OF THE SCOPE OF THIS PROJECT.
- REFER TO FINISH MATERIAL SCHEDULE FOR SPECIFIC MANUFACTURER, STYLE, COLOR & SIZE INFORMATION
- . REFER TO REFLECTED CEILING PLANS FOR CEILING TYPES, HEIGHTS AND FINISH INFORMATION AT CERAMIC TILE LOCATIONS, INSTALLER TO USE APPROPRIATE TROWEL TO ACCOMMODATE
- DIFFERENT TILE THICKNESSES PROVIDE RESILIENT BASE AT TOE KICK OF ALL CASEWORK AND BEHIND ALL MOVABLE
- EQUIPMENT/APPLIANCES, WHEN SCHEDULED WITHIN A ROOM.


9. TYPICAL CASE WORK NOTATION EXAMPLE

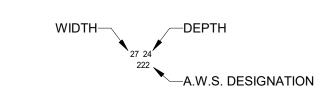


- 10. ALL CASEWORK LOCKABLE UNLESS OTHERWISENOTED (DOORS AND DRAWERS).
- 1. ALL WALL MOUNTED MECHANICAL EQUIPMENT (DIFFUSERS, GRILLES, ETC) AND ELECTRICAL **EQUIPMENT (PANELS, ETC) SHALL BE PAINTED TO** MATCH THE ADJACENT WALL COLOR. REFER TO MECHANICAL AND ELECTRICAL DRAWINGS FOR QUANTITIES AND LOCATIONS.
- 12. WHERE REMOVAL OR MODIFICATION TO A FINISH MATERIAL IS SHOWN, BUT NEW FINISHES ARE NOT SCHEDULED, PATCH AND REPAIR TO MATCH EXISTING FINISH CONDITION AS REQUIRED.
- 13. PROVIDE APPROPRIATE TRANSITION STRIPS BETWEEN DISSIMILAR FLOORING MATERIALS AT VERTICAL AND/OR HORIZONTAL APPLICATIONS.
- 14. CARPET EDGES SHALL BE CAPTURED BY NOSING, NOSING SHALL BE MITERED AT ALL OUTSIDE AND INSIDE CORNER CONDITIONS. ALL EDGES OF CARPET SHALL BE SEALED WITH A SEAM SEALER.

ROOM FINISH MATERIAL LEGEND

15. FLOORING CONTRACTOR SHALL INSTALL INSERTS TO MATCH ADJACENT FLOORING MATERIAL AT ALL ELECTRICAL FLOOR BOX COVERS AS REQUIRED.

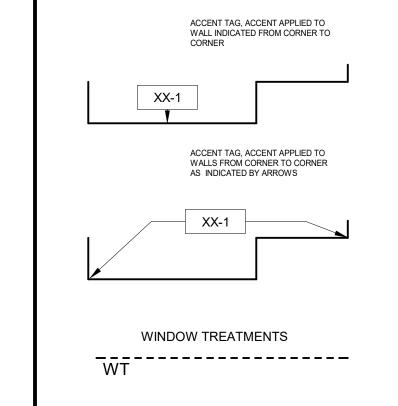

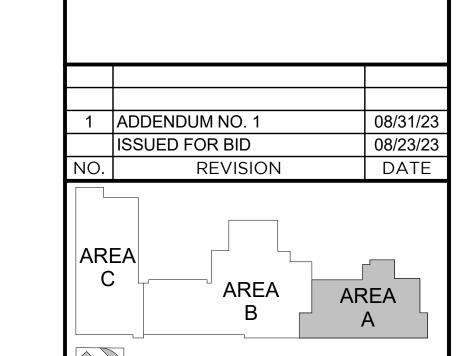





### WTA ARCHITECTS

100 S Jefferson Ave, Suite 601 Saginaw, Michigan 48607

COPYRIGHT © 2023 989 752 8107

PROJECT TITLE

RENOVATION AND ADDITION:


MIDLAND COUNTY ESA

MIDLAND, MICHIGAN

ROOM FINISH PLANS -AREA A - LOWER LEVEL

PROJECT NUMBER SHEET NUMBER 2022006.1 PROJECT DATE

A3.01 AUGUST 23, 2023 CHECKED BY JMJ

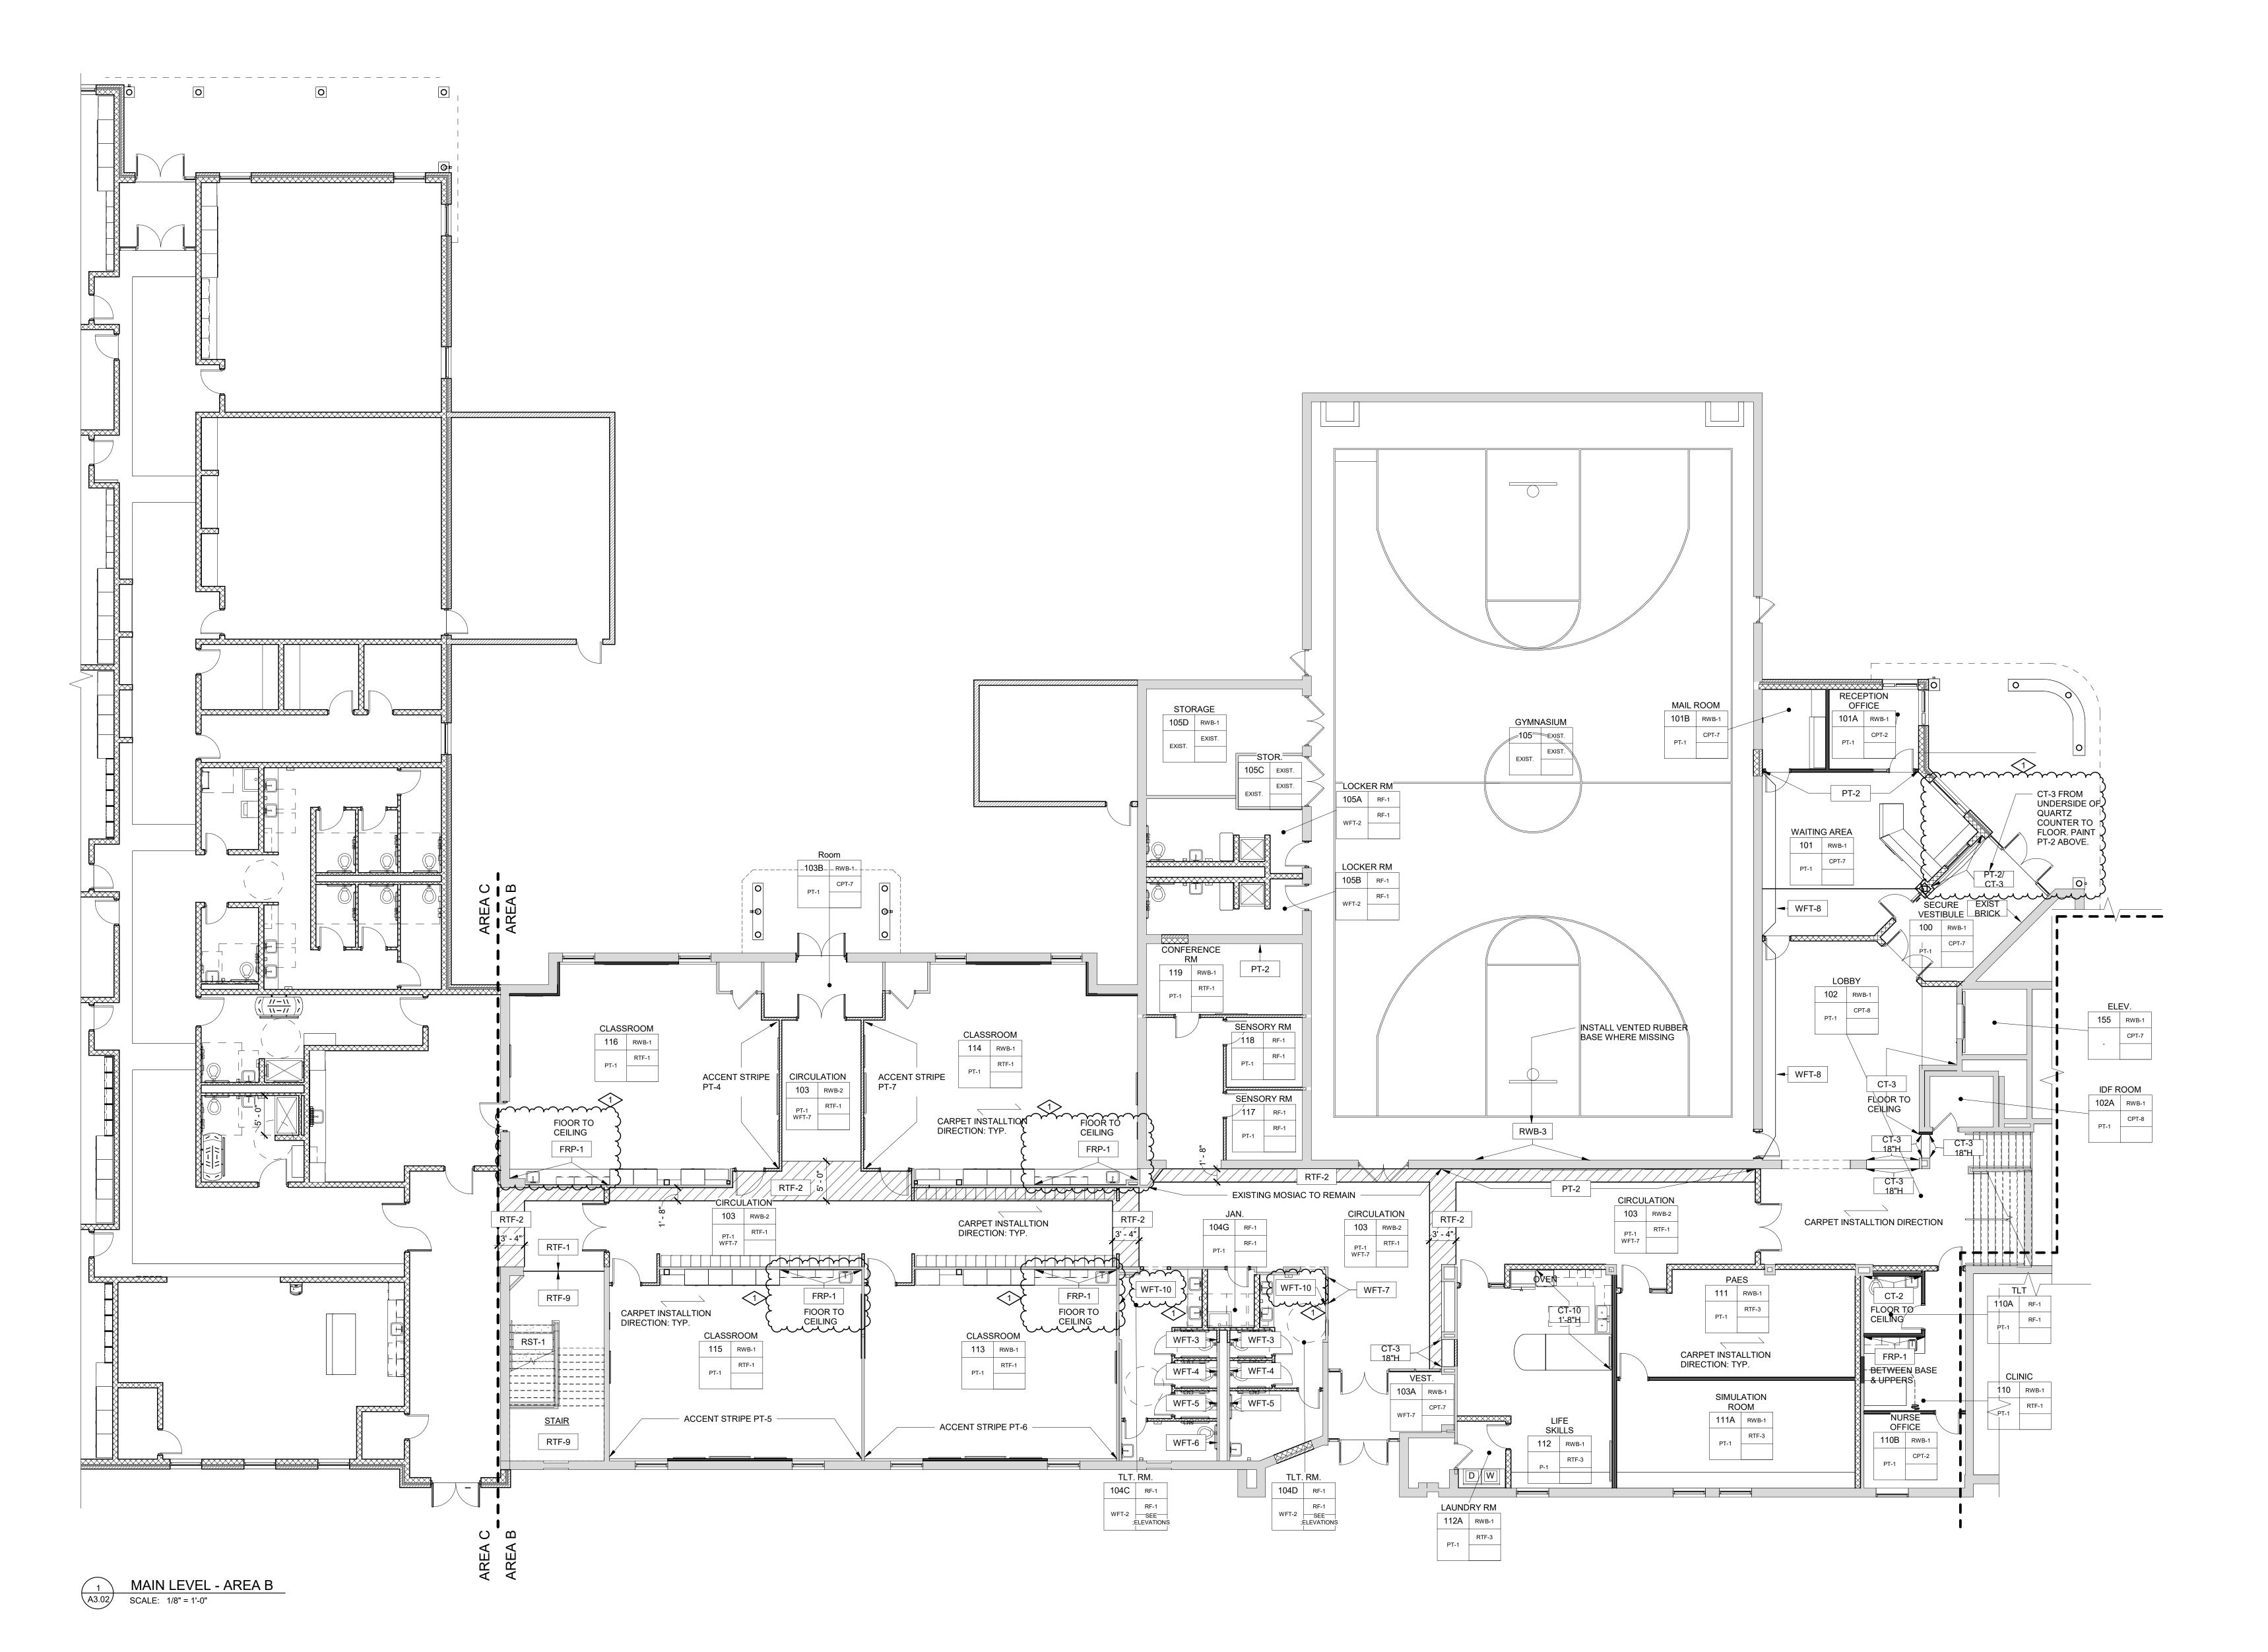


#### **INTERIOR GENERAL NOTES:**

- AT STUD WALL LOCATIONS PROVIDE BLOCKING AS REQUIRED FOR ALL WALL MOUNTED ITEMS, INCLUDING BUT NOT LIMITED TO: GRAB BARS, MIRRORS, DISPENSERS, ETC. (REFER TO MFR. RECOMMENDATIONS.
- . ALL NEW CASEWORK TO HAVE HIGH PRESSURE LAMINATE EXTERIOR AND MELAMINE LAMINATE
- INTERIOR. UNLESS OTHERWISE NOTED. ALL FURNITURE THAT IS NOT BUILT-IN IS NOT PART
- OF THE SCOPE OF THIS PROJECT. REFER TO FINISH MATERIAL SCHEDULE FOR SPECIFIC MANUFACTURER, STYLE, COLOR & SIZE
- INFORMATION 5. REFER TO REFLECTED CEILING PLANS FOR CEILING TYPES, HEIGHTS AND FINISH INFORMATION . AT CERAMIC TILE LOCATIONS, INSTALLER TO USE
- APPROPRIATE TROWEL TO ACCOMMODATE DIFFERENT TILE THICKNESSES PROVIDE RESILIENT BASE AT TOE KICK OF ALL
- EQUIPMENT/APPLIANCES, WHEN SCHEDULED WITHIN A ROOM.

9. TYPICAL CASE WORK NOTATION EXAMPLE

CASEWORK AND BEHIND ALL MOVABLE

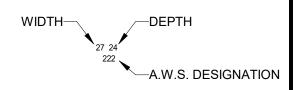



10. ALL CASEWORK LOCKABLE UNLESS OTHERWISENOTED (DOORS AND DRAWERS).

QUANTITIES AND LOCATIONS.

- 1. ALL WALL MOUNTED MECHANICAL EQUIPMENT (DIFFUSERS, GRILLES, ETC) AND ELECTRICAL EQUIPMENT (PANELS, ETC) SHALL BE PAINTED TO MATCH THE ADJACENT WALL COLOR. REFER TO MECHANICAL AND ELECTRICAL DRAWINGS FOR
- 12. WHERE REMOVAL OR MODIFICATION TO A FINISH MATERIAL IS SHOWN, BUT NEW FINISHES ARE NOT SCHEDULED, PATCH AND REPAIR TO MATCH EXISTING FINISH CONDITION AS REQUIRED.
- 13. PROVIDE APPROPRIATE TRANSITION STRIPS BETWEEN DISSIMILAR FLOORING MATERIALS AT VERTICAL AND/OR HORIZONTAL APPLICATIONS.
- 14. CARPET EDGES SHALL BE CAPTURED BY NOSING, NOSING SHALL BE MITERED AT ALL OUTSIDE AND INSIDE CORNER CONDITIONS. ALL EDGES OF CARPET SHALL BE SEALED WITH A SEAM SEALER.
- 15. FLOORING CONTRACTOR SHALL INSTALL INSERTS TO MATCH ADJACENT FLOORING MATERIAL AT ALL ELECTRICAL FLOOR BOX COVERS AS REQUIRED.

ROOM FINISH MATERIAL LEGEND

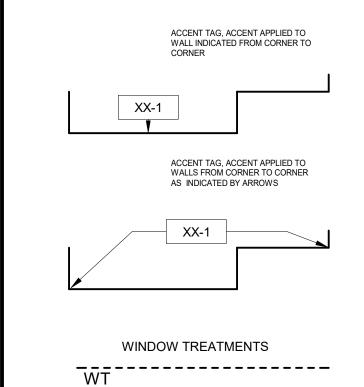

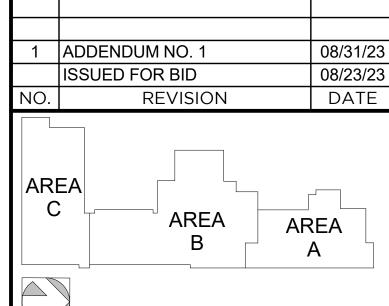





**WTA** ARCHITECTS

WTAARCH.COM

100 S Jefferson Ave, Suite 601 Saginaw, Michigan 48607 989 752 8107

COPYRIGHT © 2023

PROJECT TITLE

RENOVATION AND ADDITION:

MIDLAND COUNTY ESA


MIDLAND, MICHIGAN

JMJ

ROOM FINISH PLANS -AREA B - MAIN LEVEL

SHEET NUMBER PROJECT NUMBER 2022006.1 PROJECT DATE AUGUST 23, 2023

A3.02 CHECKED BY

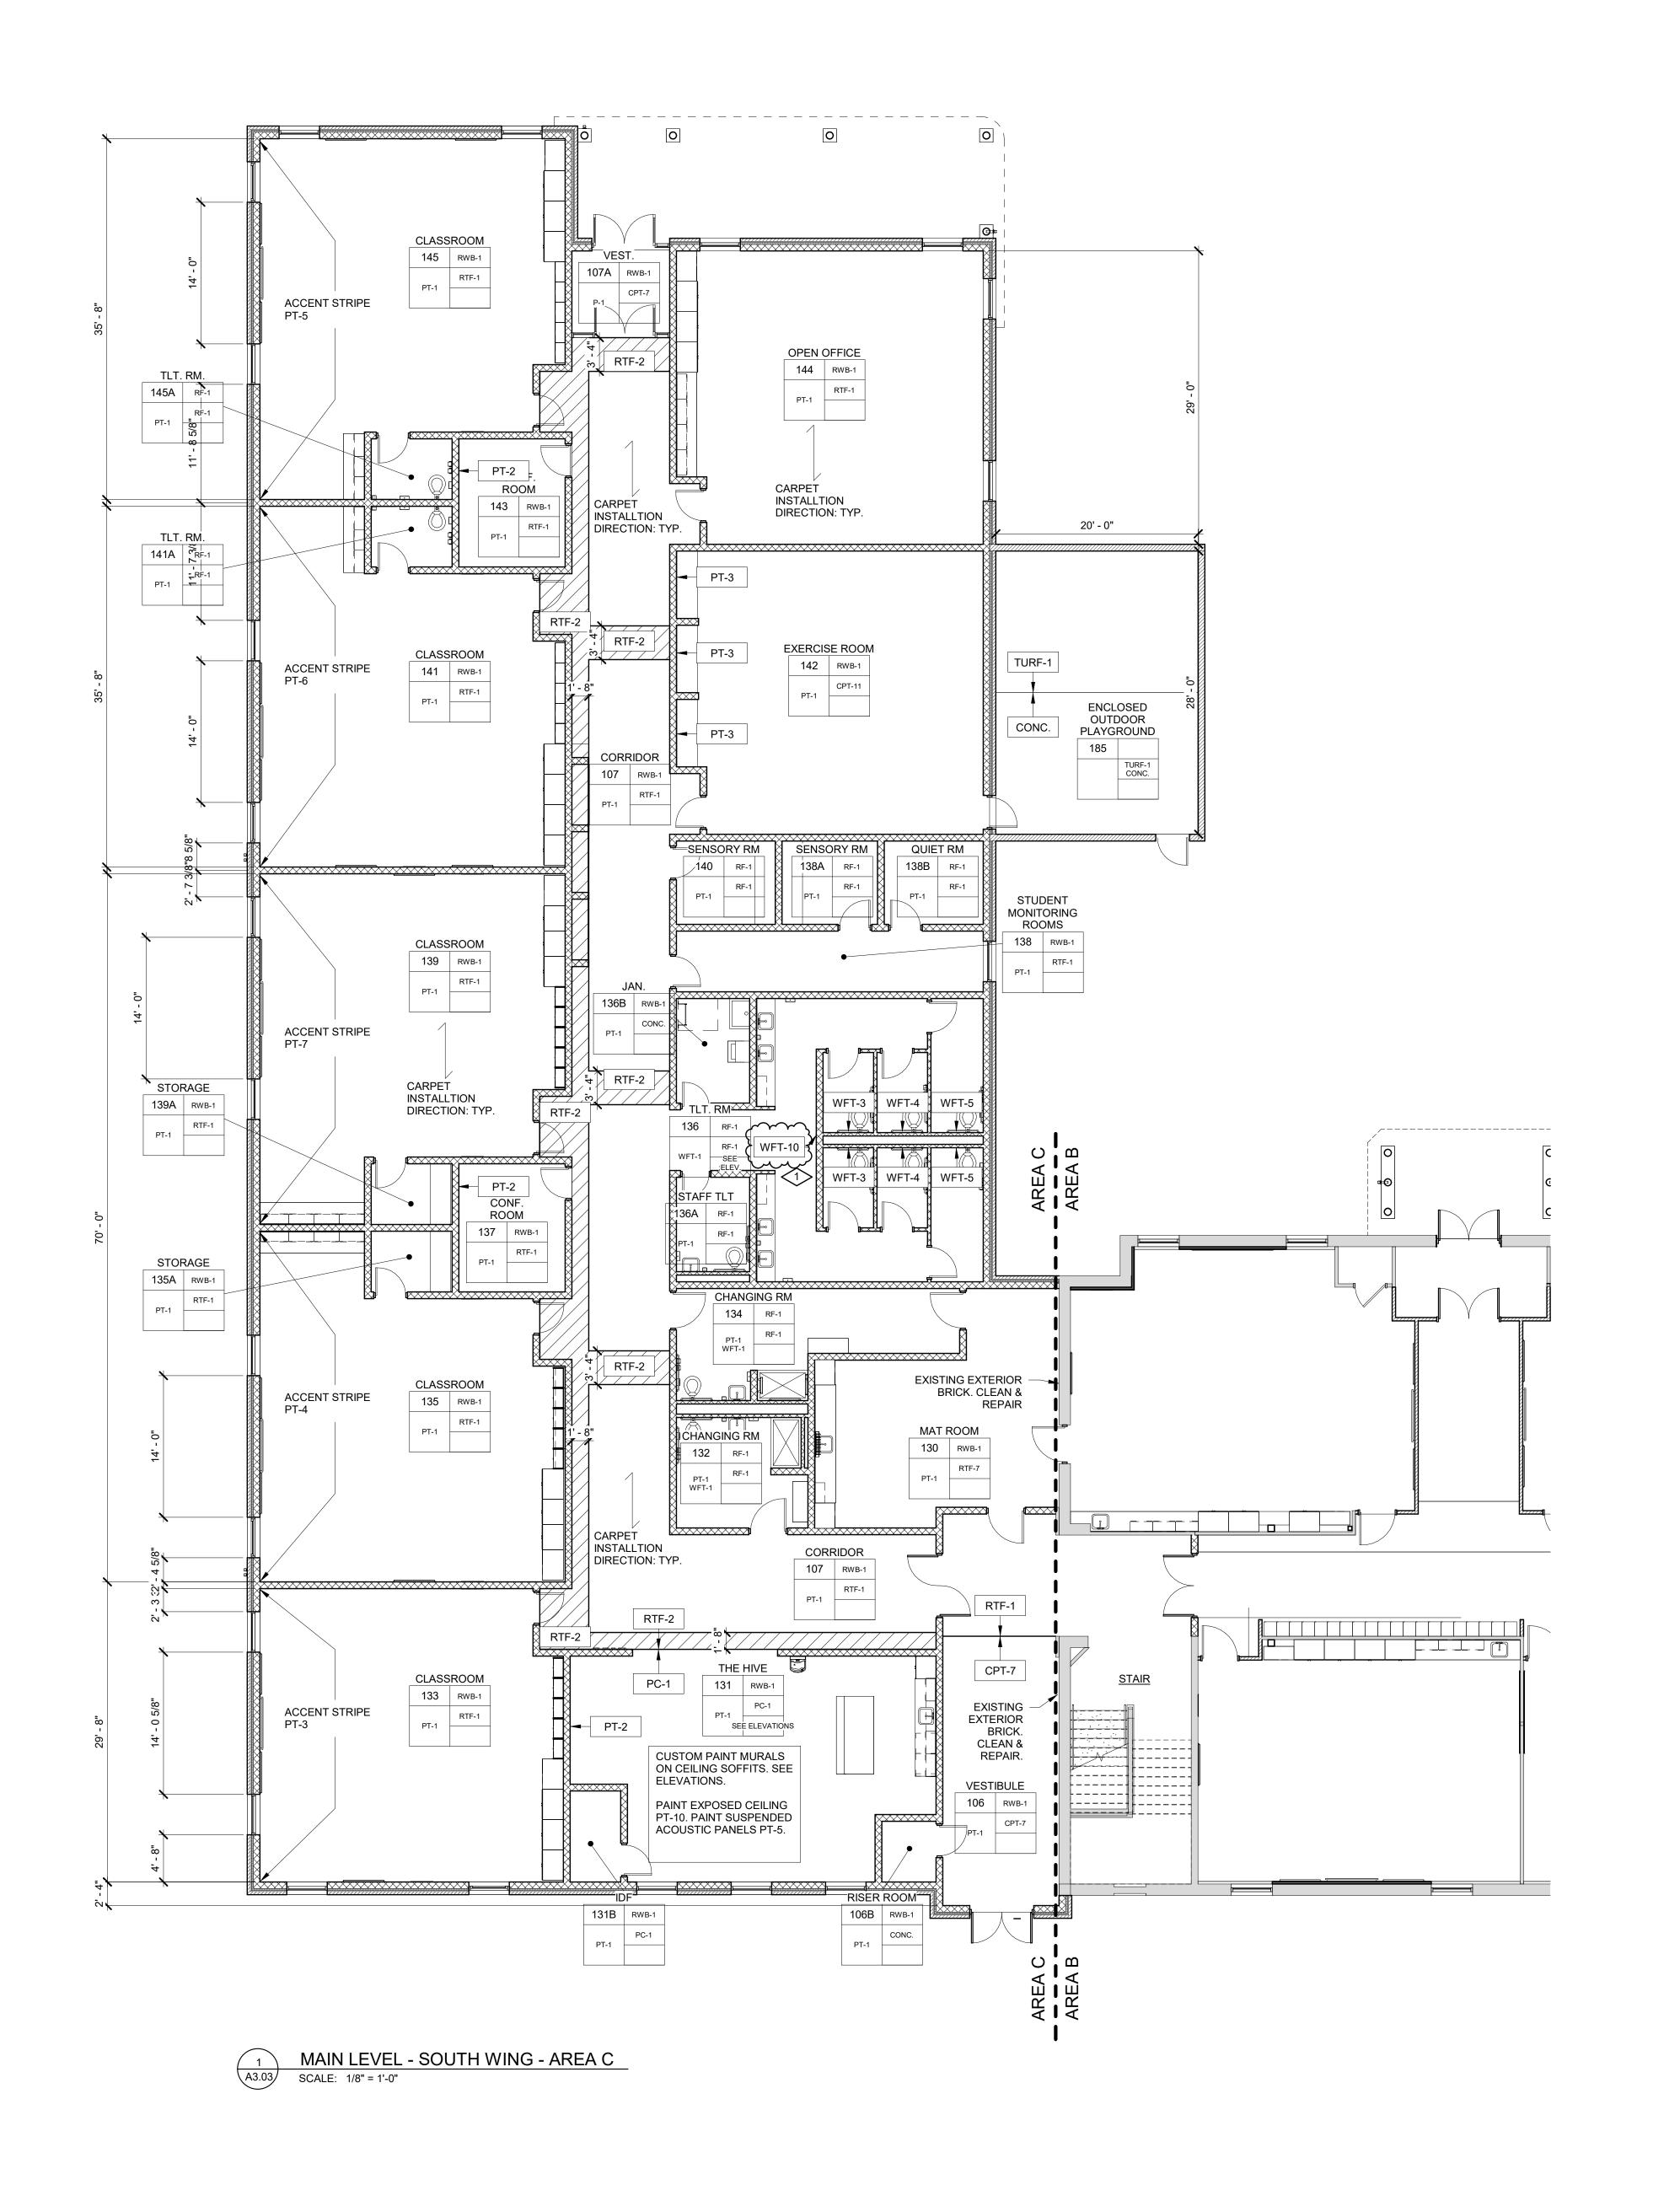


#### INTERIOR GENERAL NOTES:

- . AT STUD WALL LOCATIONS PROVIDE BLOCKING AS REQUIRED FOR ALL WALL MOUNTED ITEMS, INCLUDING BUT NOT LIMITED TO: GRAB BARS, MIRRORS, DISPENSERS, ETC. (REFER TO MFR. RECOMMENDATIONS.
- ALL NEW CASEWORK TO HAVE HIGH PRESSURE LAMINATE EXTERIOR AND MELAMINE LAMINATE
- INTERIOR. UNLESS OTHERWISE NOTED. ALL FURNITURE THAT IS NOT BUILT-IN IS NOT PART
- OF THE SCOPE OF THIS PROJECT. REFER TO FINISH MATERIAL SCHEDULE FOR SPECIFIC MANUFACTURER, STYLE, COLOR & SIZE

INFORMATION


- . REFER TO REFLECTED CEILING PLANS FOR CEILING TYPES, HEIGHTS AND FINISH INFORMATION AT CERAMIC TILE LOCATIONS, INSTALLER TO USE APPROPRIATE TROWEL TO ACCOMMODATE
- DIFFERENT TILE THICKNESSES PROVIDE RESILIENT BASE AT TOE KICK OF ALL CASEWORK AND BEHIND ALL MOVABLE
- EQUIPMENT/APPLIANCES, WHEN SCHEDULED WITHIN A ROOM.

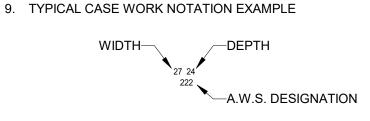


- 10. ALL CASEWORK LOCKABLE UNLESS OTHERWISENOTED (DOORS AND DRAWERS).
- 1. ALL WALL MOUNTED MECHANICAL EQUIPMENT (DIFFUSERS, GRILLES, ETC) AND ELECTRICAL EQUIPMENT (PANELS, ETC) SHALL BE PAINTED TO MATCH THE ADJACENT WALL COLOR, REFER TO MECHANICAL AND ELECTRICAL DRAWINGS FOR QUANTITIES AND LOCATIONS.
- 12. WHERE REMOVAL OR MODIFICATION TO A FINISH MATERIAL IS SHOWN, BUT NEW FINISHES ARE NOT SCHEDULED, PATCH AND REPAIR TO MATCH EXISTING FINISH CONDITION AS REQUIRED.
- 13. PROVIDE APPROPRIATE TRANSITION STRIPS BETWEEN DISSIMILAR FLOORING MATERIALS AT VERTICAL AND/OR HORIZONTAL APPLICATIONS.
- 14. CARPET EDGES SHALL BE CAPTURED BY NOSING, NOSING SHALL BE MITERED AT ALL OUTSIDE AND INSIDE CORNER CONDITIONS. ALL EDGES OF CARPET SHALL BE SEALED WITH A SEAM SEALER.

ROOM FINISH MATERIAL LEGEND

15. FLOORING CONTRACTOR SHALL INSTALL INSERTS TO MATCH ADJACENT FLOORING MATERIAL AT ALL ELECTRICAL FLOOR BOX COVERS AS REQUIRED.

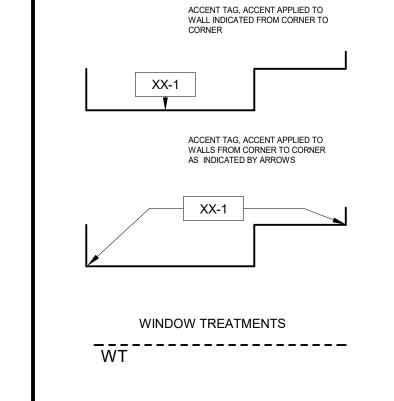

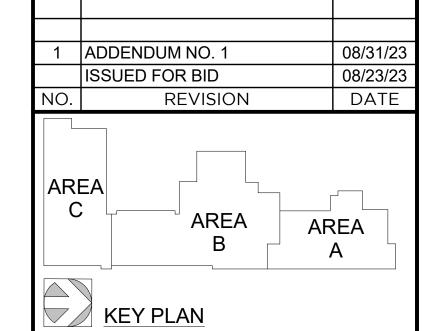





### **WTA** ARCHITECTS

WTAARCH.COM

100 S Jefferson Ave, Suite 601

Saginaw, Michigan 48607 989 752 8107 COPYRIGHT © 2023

PROJECT TITLE

RENOVATION AND ADDITION:


MIDLAND COUNTY ESA

MIDLAND, MICHIGAN

**ROOM FINISH PLANS -**AREA C - MAIN LEVEL


SHEET NUMBER PROJECT NUMBER 2022006.1 PROJECT DATE AUGUST 23, 2023

A3.03 CHECKED BY

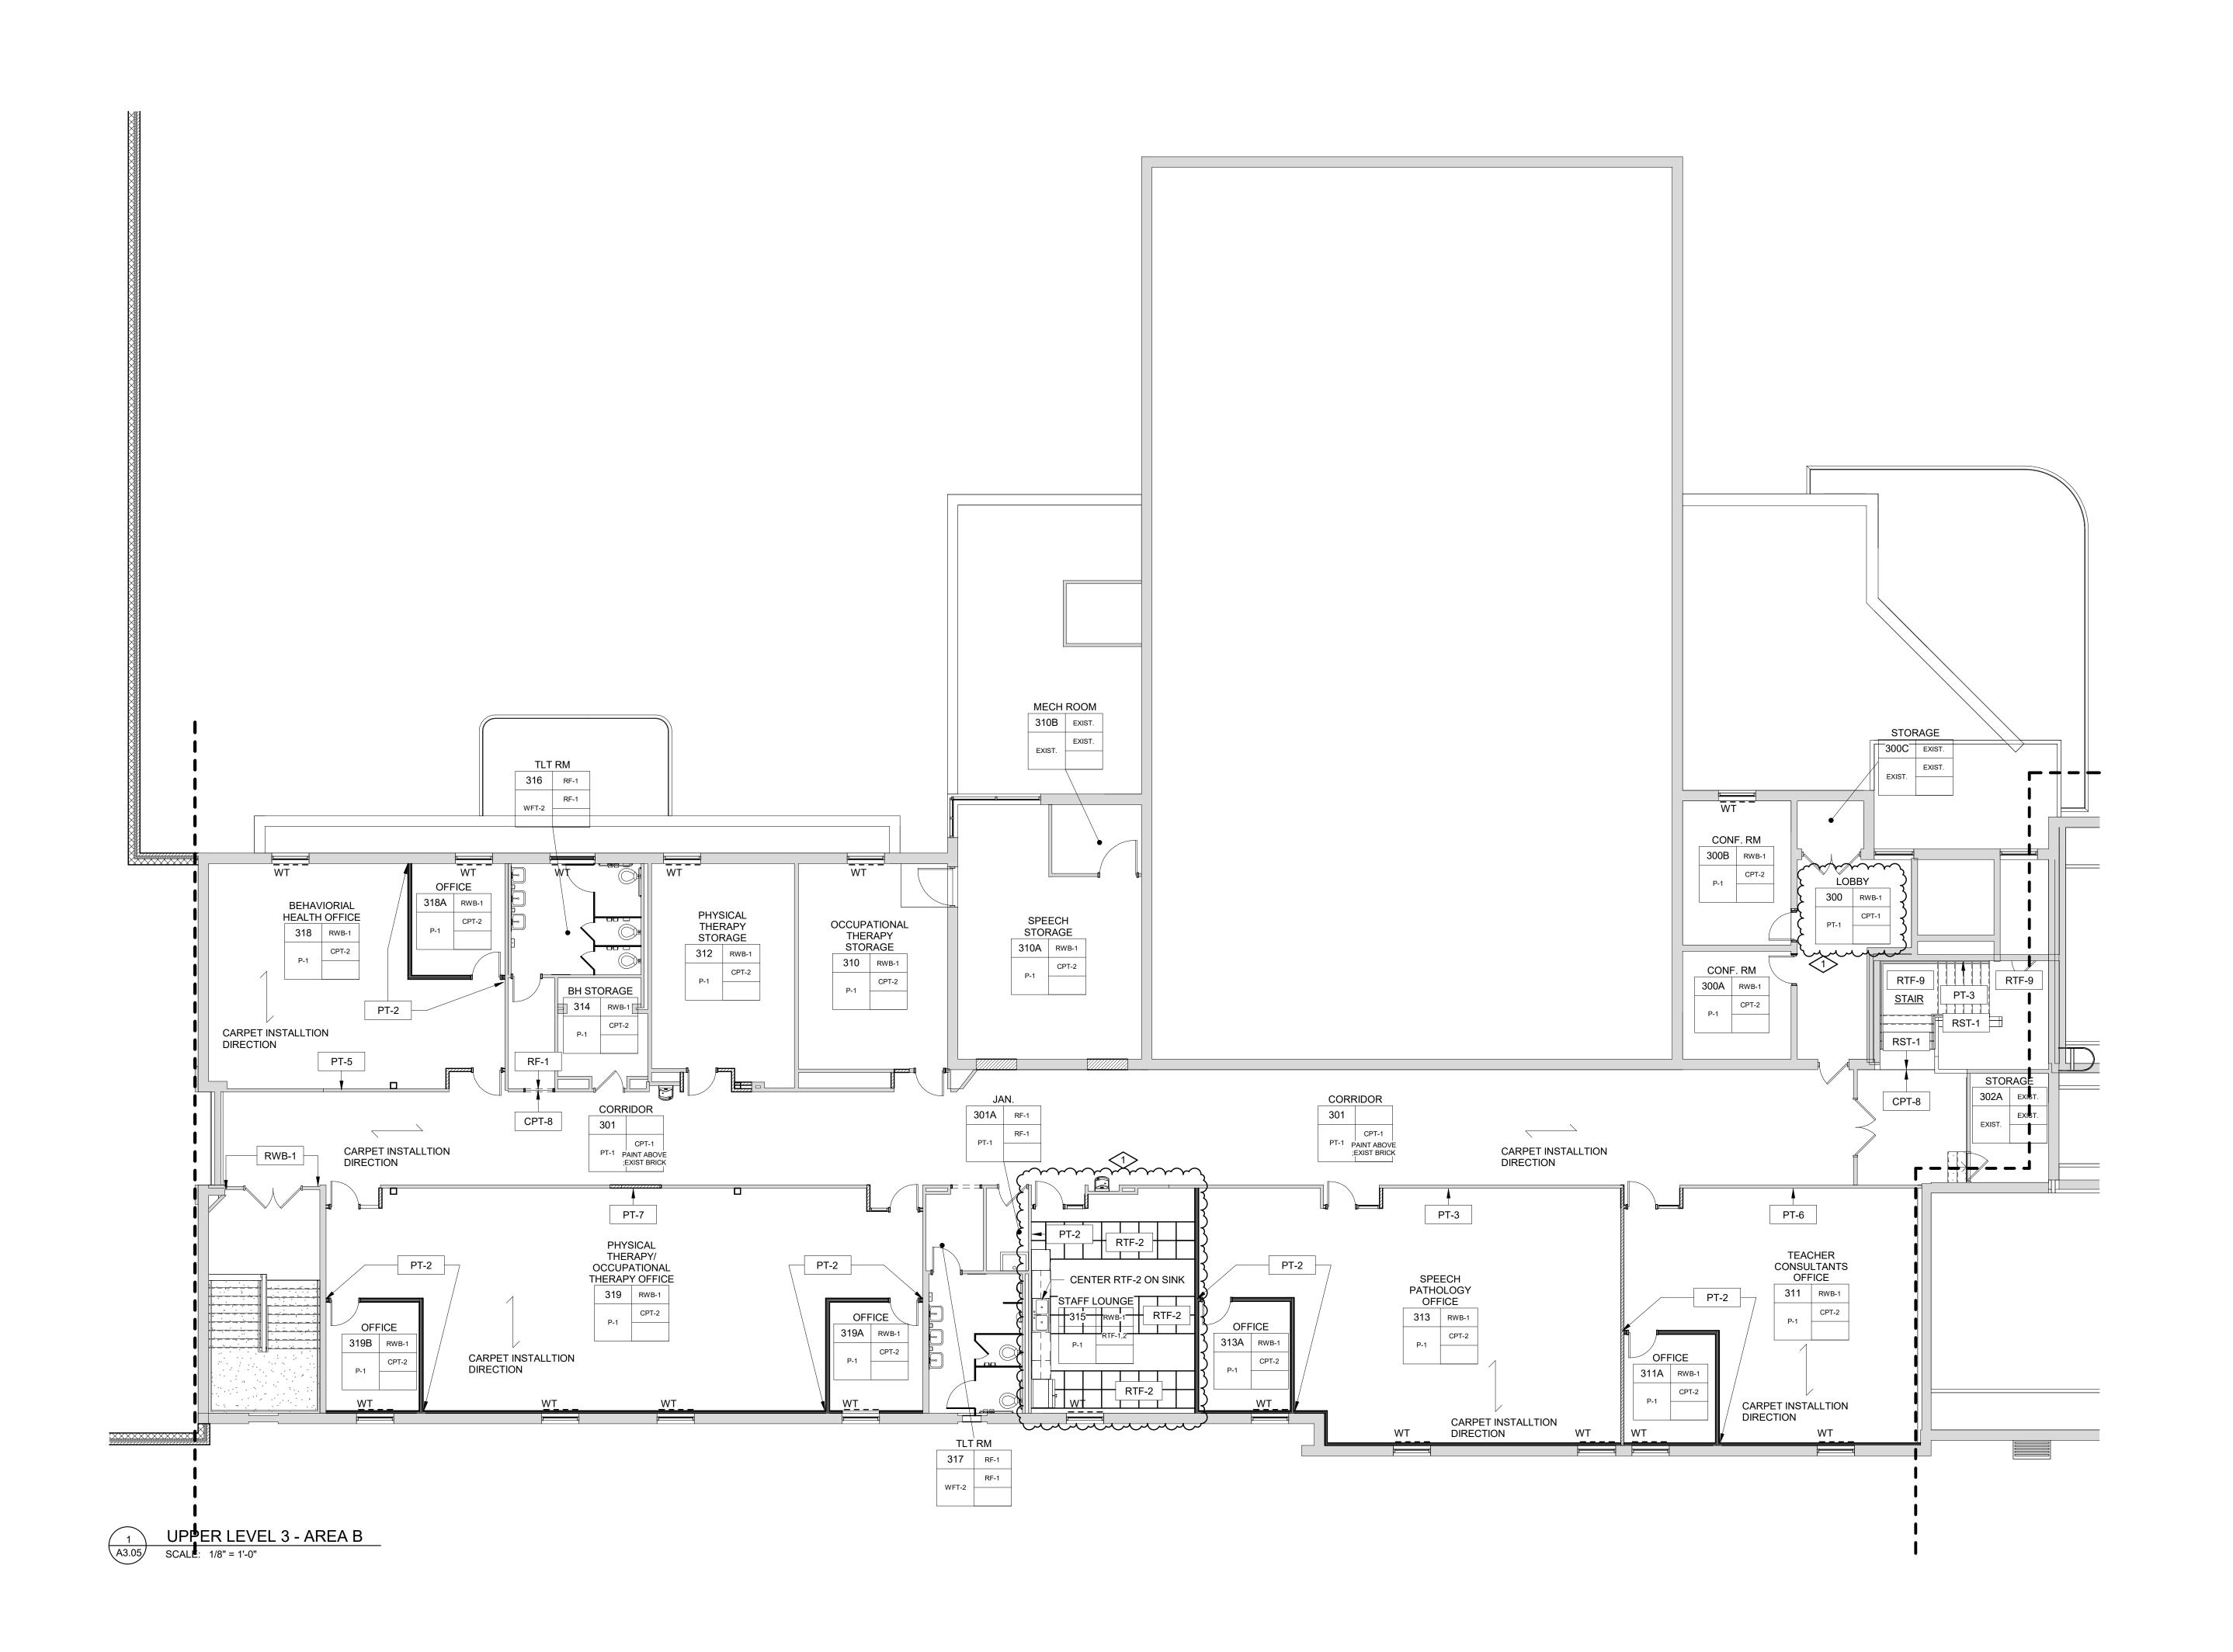



#### **INTERIOR GENERAL NOTES:**

- . AT STUD WALL LOCATIONS PROVIDE BLOCKING AS REQUIRED FOR ALL WALL MOUNTED ITEMS, INCLUDING BUT NOT LIMITED TO: GRAB BARS, MIRRORS, DISPENSERS, ETC. (REFER TO MFR. RECOMMENDATIONS.
- 2. ALL NEW CASEWORK TO HAVE HIGH PRESSURE LAMINATE EXTERIOR AND MELAMINE LAMINATE INTERIOR. UNLESS OTHERWISE NOTED.
- 8. ALL FURNITURE THAT IS NOT BUILT-IN IS NOT PART OF THE SCOPE OF THIS PROJECT.
- . REFER TO FINISH MATERIAL SCHEDULE FOR SPECIFIC MANUFACTURER, STYLE, COLOR & SIZE INFORMATION
- 5. REFER TO REFLECTED CEILING PLANS FOR CEILING TYPES, HEIGHTS AND FINISH INFORMATION AT CERAMIC TILE LOCATIONS, INSTALLER TO USE APPROPRIATE TROWEL TO ACCOMMODATE DIFFERENT TILE THICKNESSES
- 8. PROVIDE RESILIENT BASE AT TOE KICK OF ALL CASEWORK AND BEHIND ALL MOVABLE EQUIPMENT/APPLIANCES, WHEN SCHEDULED
- WITHIN A ROOM.

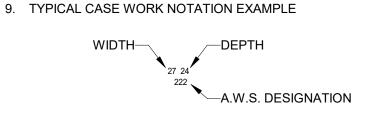

- 10. ALL CASEWORK LOCKABLE UNLESS OTHERWISENOTED (DOORS AND DRAWERS).
- 11. ALL WALL MOUNTED MECHANICAL EQUIPMENT (DIFFUSERS, GRILLES, ETC) AND ELECTRICAL EQUIPMENT (PANELS, ETC) SHALL BE PAINTED TO MATCH THE ADJACENT WALL COLOR. REFER TO MECHANICAL AND ELECTRICAL DRAWINGS FOR QUANTITIROOM FINISH MATERIAL LEGEND
- 12. WHERE REMOVAL OR MODIFICATION TO A FINISH MATERIAL IS SHOWN, BUT NEW FINISHES ARE NOT SCHEDULED, PATCH AND REPAIR TO MATCH EXISTING FINISH CONDITION AS REQUIRED.
- 13. PROVIDE APPROPRIATE TRANSITION STRIPS BETWEEN DISSIMILAR FLOORING MATERIALS AT VERTICAL AND/OR HORIZONTAL APPLICATIONS.
- 14. CARPET EDGES SHALL BE CAPTURED BY NOSING, NOSING SHALL BE MITERED AT ALL OUTSIDE AND INSIDE CORNER CONDITIONS. ALL EDGES OF CARPET SHALL BE SEALED WITH A SEAM SEALER.
- 15. FLOORING CONTRACTOR SHALL INSTALL INSERTS TO MATCH ADJACENT FLOORING MATERIAL AT ALL ELECTRICAL FLOOR BOX COVERS AS REQUIRED.

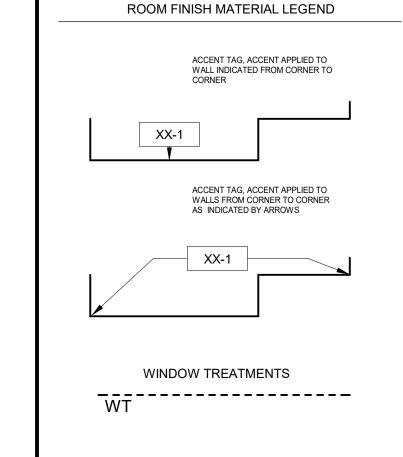

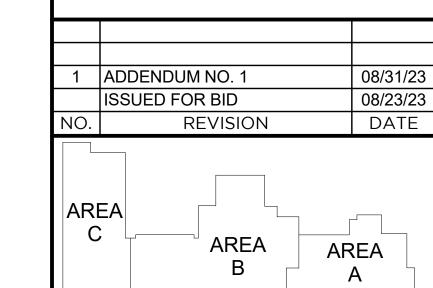





WTAARCH.COM

## **WTA** ARCHITECTS

100 S Jefferson Ave, Suite 601 Saginaw, Michigan 48607 989 752 8107

COPYRIGHT © 2023

PROJECT TITLE

RENOVATION AND ADDITION:


MIDLAND COUNTY ESA

MIDLAND, MICHIGAN

**ROOM FINISH PLANS -**AREA B - UPPER LEVEL 3


SHEET NUMBER PROJECT NUMBER 2022006.1 PROJECT DATE A3.05 AUGUST 23, 2023 CHECKED BY

JMJ

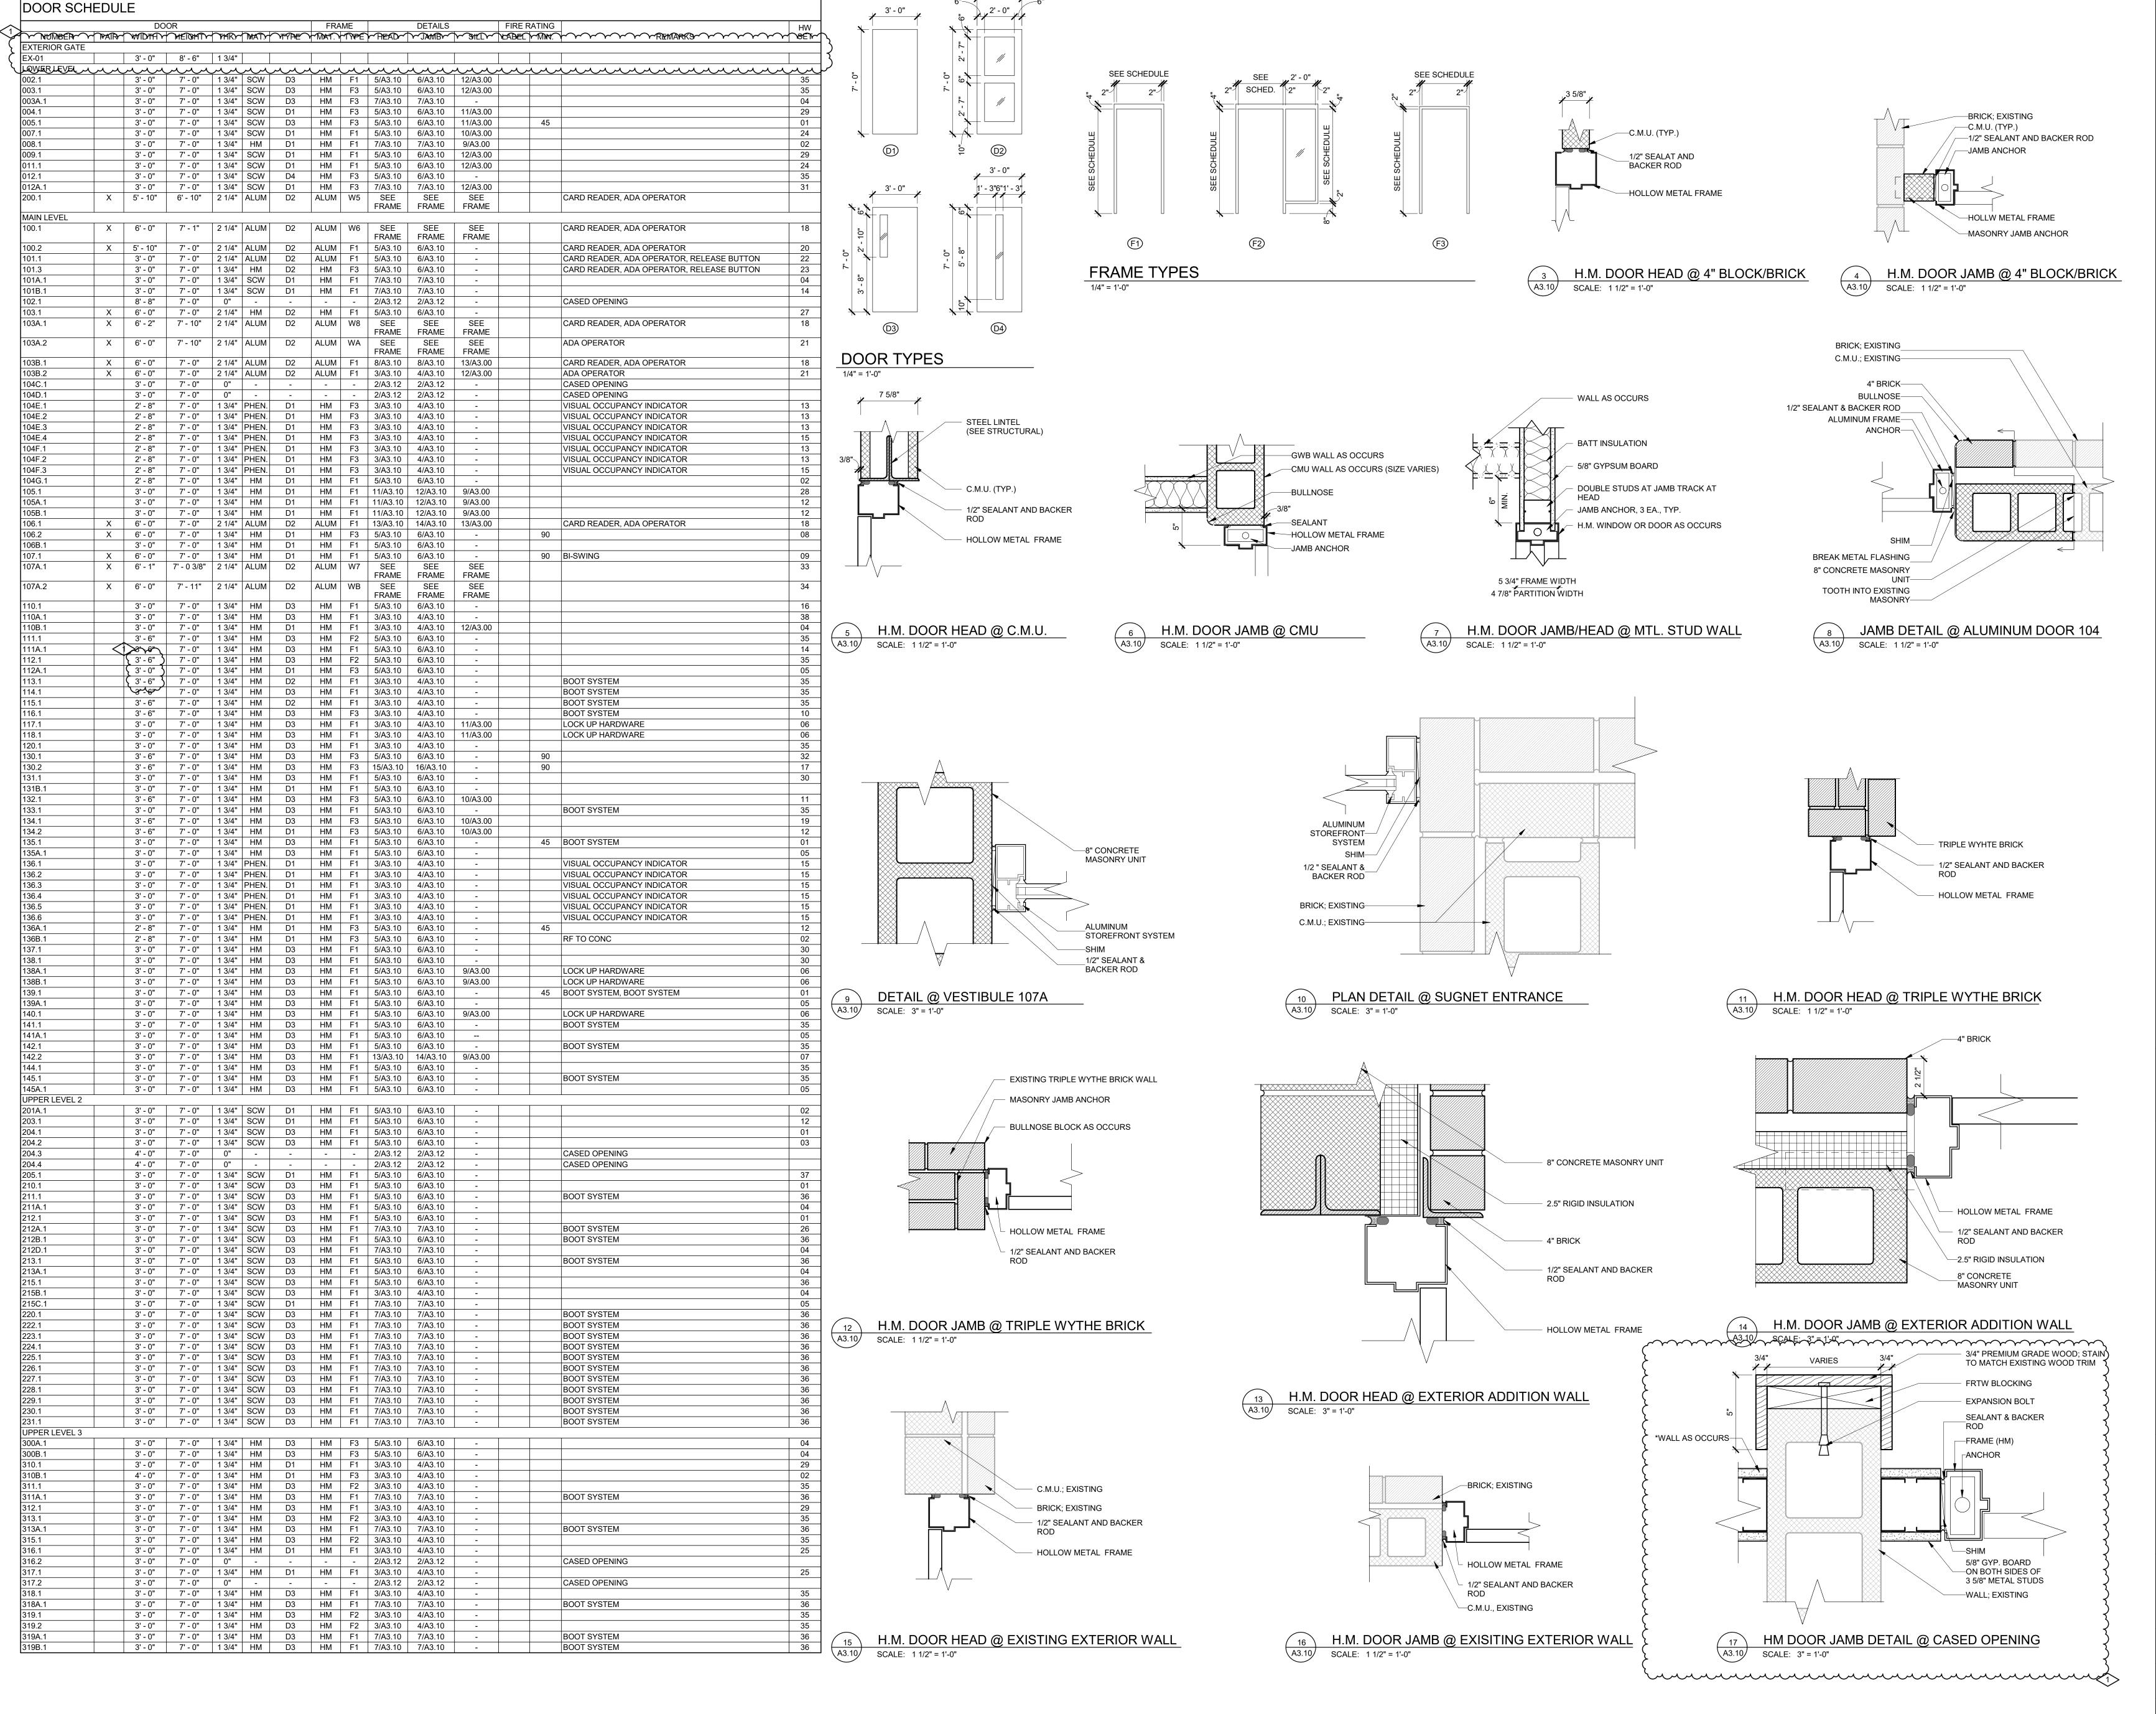

DOOR AND FRAME GENERAL

- GENERAL CONTRACTOR SHALL COORDINATE AND FIELD VERIFY ALL HOLLOW METAL FRAME
- DIMENSIONS PRIOR TO FABRICATION. ALL DIMENSIONS INDICATE ROUGH OPENING
- DIMENSIONS REFER TO SPECIFICATIONS FOR GLASS TYPE
- DESCRIPTIONS. ALL HOLLOW METAL FRAMES SHALL HAVE A 6"
- NOMINAL JAMB DEPTION UON. ALL FACE WIDTHS SHALL BE 2" UON.
- SEE DETAILS 7/A3.10 FOR TYPICAL HEAD, JAMB, AND SILL DETAILS THAT OCCUR AT INTERIOR STUD
- SEE DETAILS 5/3.10 AND 6/A3.10 FOR TYPICAL HEAD AND JAMB DETAILS THAT OCCUR AT INTERIOR
- MASONRY WALLS. LOCATE FRAMES AS FOLLOWS A. CORRIDORS - JUSTIFY FRAMES 3/8" BEYOND THE SAME SIDE OF WALL AS DOOR. B. ROOM TO ROOM - JUSTIFY FRAMES 3/8"
- BEYOND THE SAME SIDE OF WALL AS DOOR. INSTALL GLAZING ON THE CORRIDOR SIDE OF FRAMES AT CORRIDOR WINDOWS. INSTALL
- GLAZING ON THE SIDE OF THE LARGER ROOM AT GLAZING BETWEEN ROOMS. FOR ALL OTHER FRAMES VERIFY WITH ARCHITECT.
- PROVIDE SEALANT AT JOINTS BETWEEN ALL DOOR AND WINDOW FRAMES AND ADJACENT MATERIALS (FIRE RATED SEALANT AT RATED FRAMES).
- 9. AT ALL DOORS AND FRAMES COORIDNATE SECURITY DEVICES SPECIFICATIONS AND ELECTRICAL DRAWINGS. PREP FRAMES FOR CONDUIT AND DEVICES AS REQUIRED.
- 10. PAINT ALL HOLLOW METAL DOORS & FRAMES PT-9

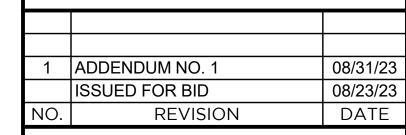



WTAARCH.COM

**WTA** ARCHITECTS

100 S Jefferson Ave, Suite 601

Saginaw, Michigan 48607 COPYRIGHT © 2023 989 752 8107

PROJECT TITLE

RENOVATION AND ADDITION:

MIDLAND COUNTY ESA


MIDLAND, MICHIGAN


SHEET TITLE DOOR AND FRAME

JMJ


SCHEDULE, DOOR **DETAILS** PROJECT NUMBER SHEET NUMBER

2022006.1 PROJECT DATE A3.10 AUGUST 23, 2023 CHECKED BY

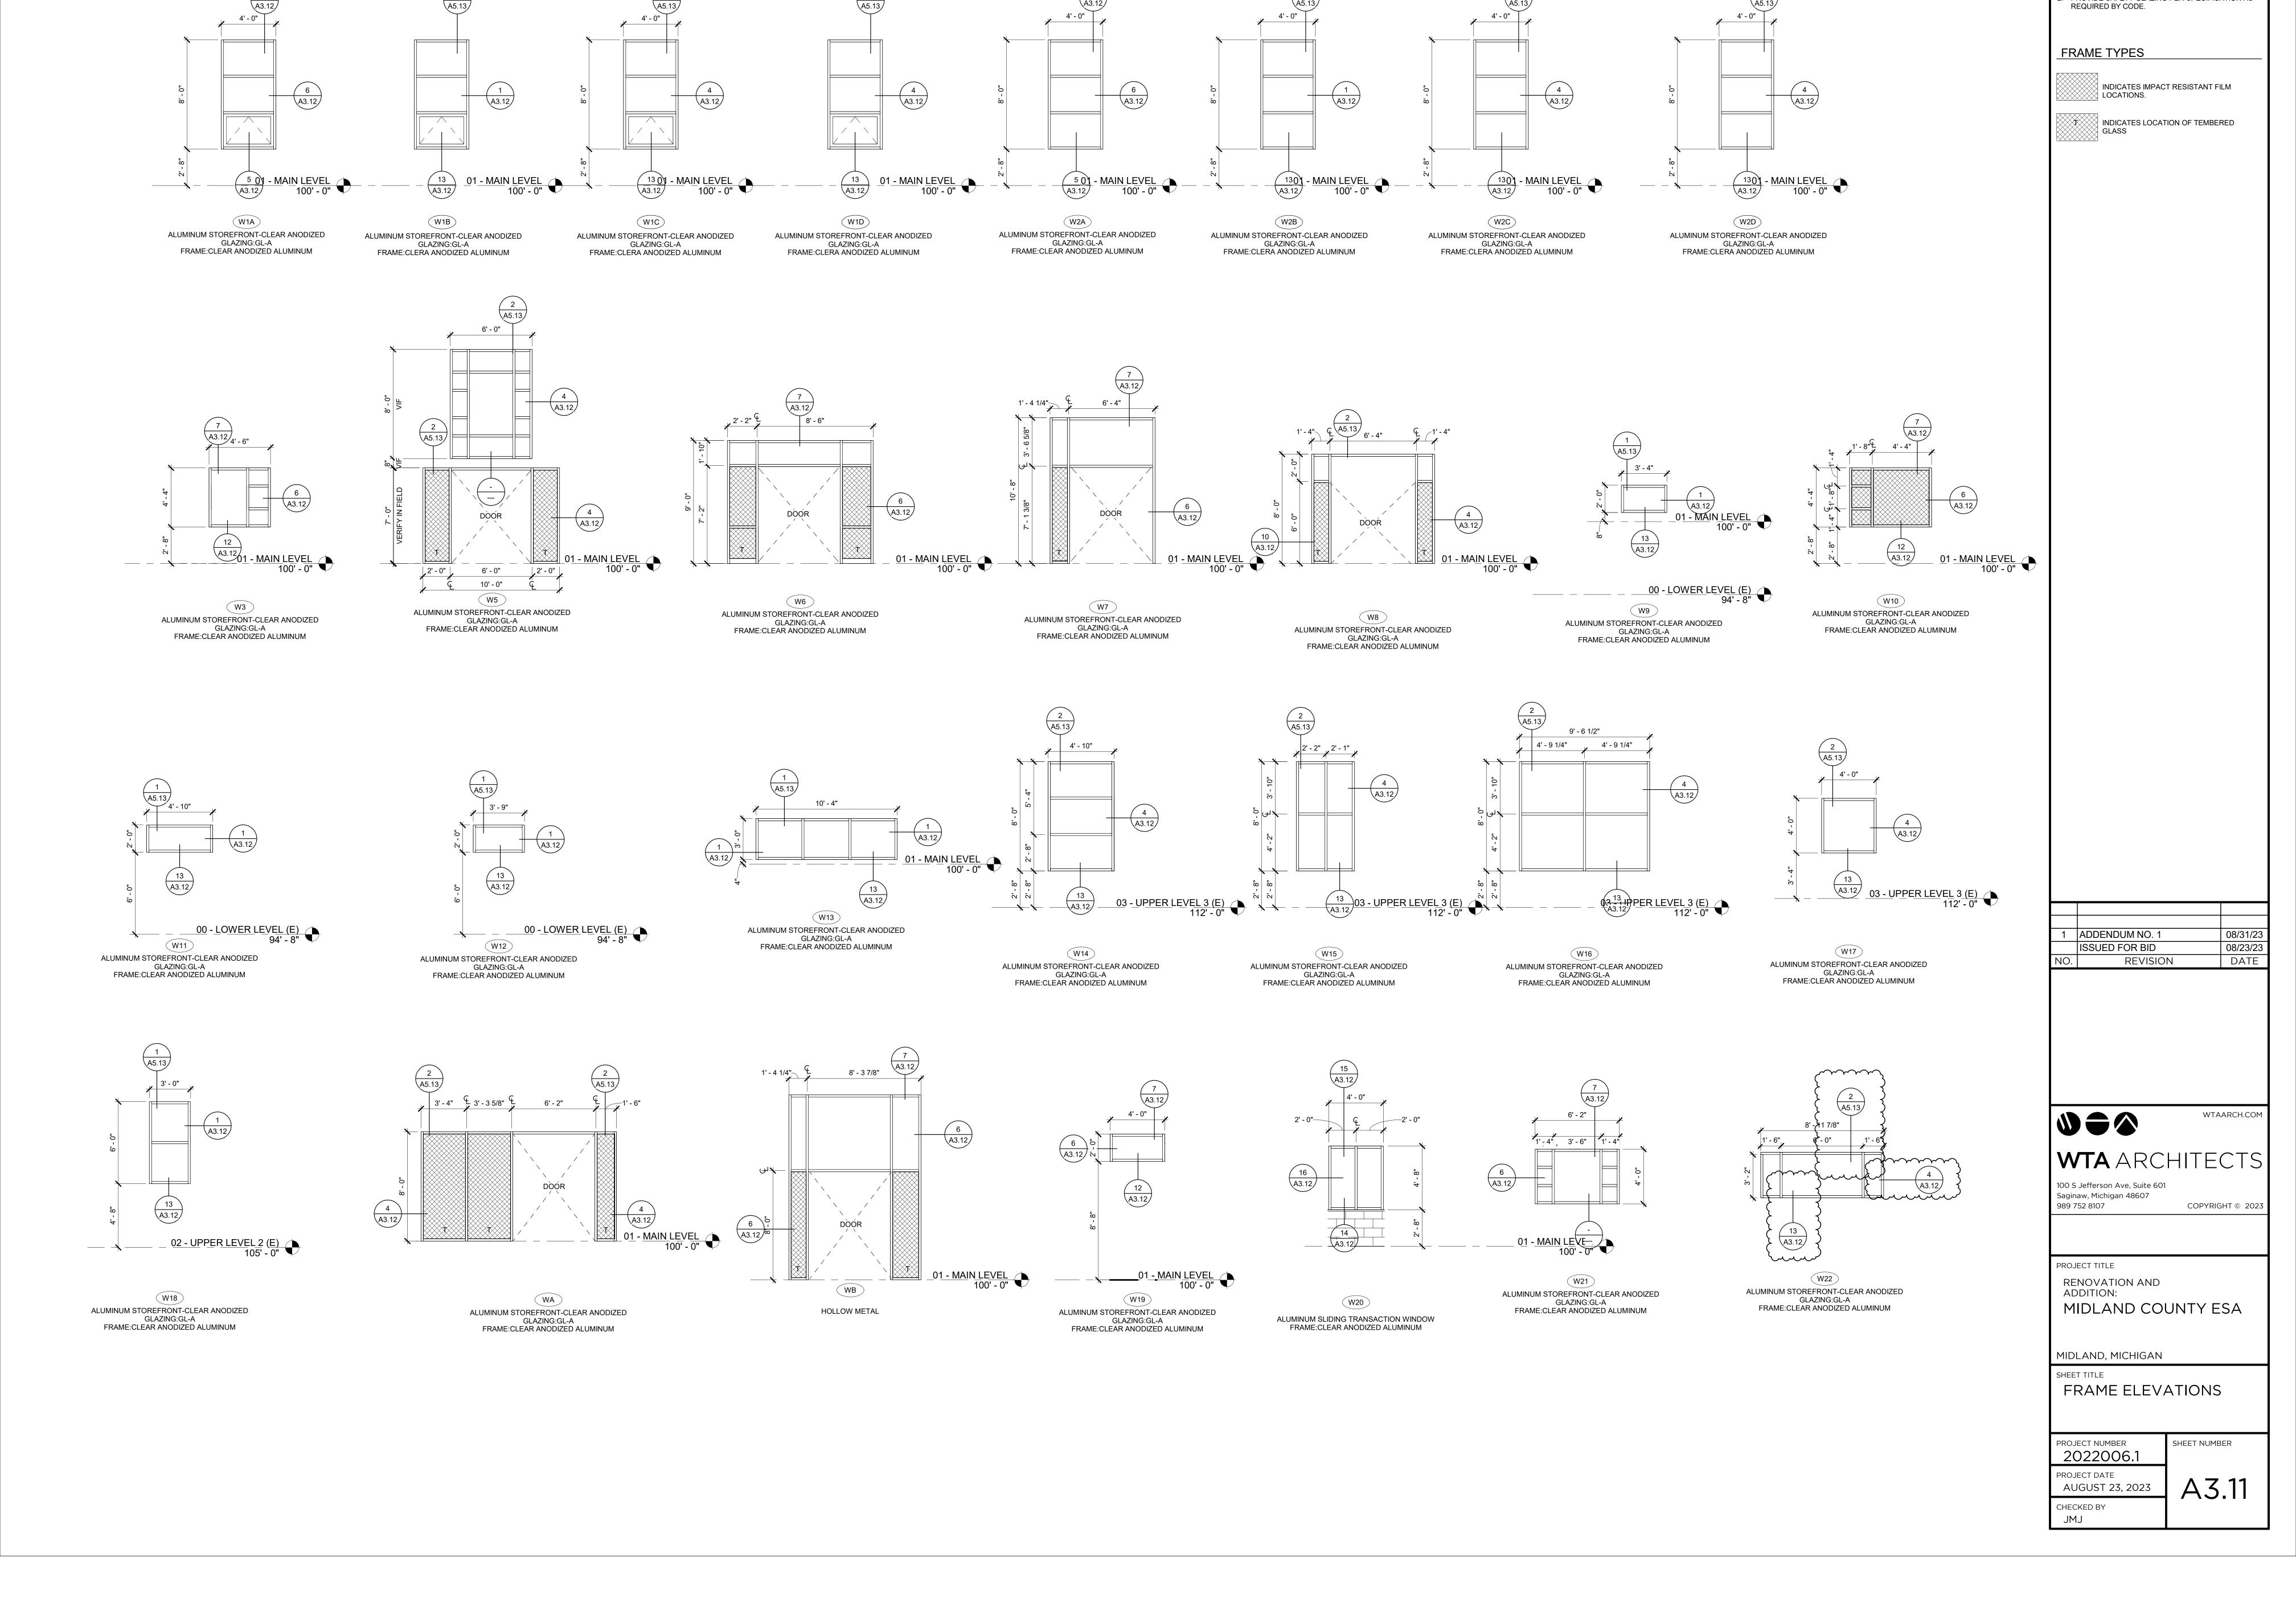

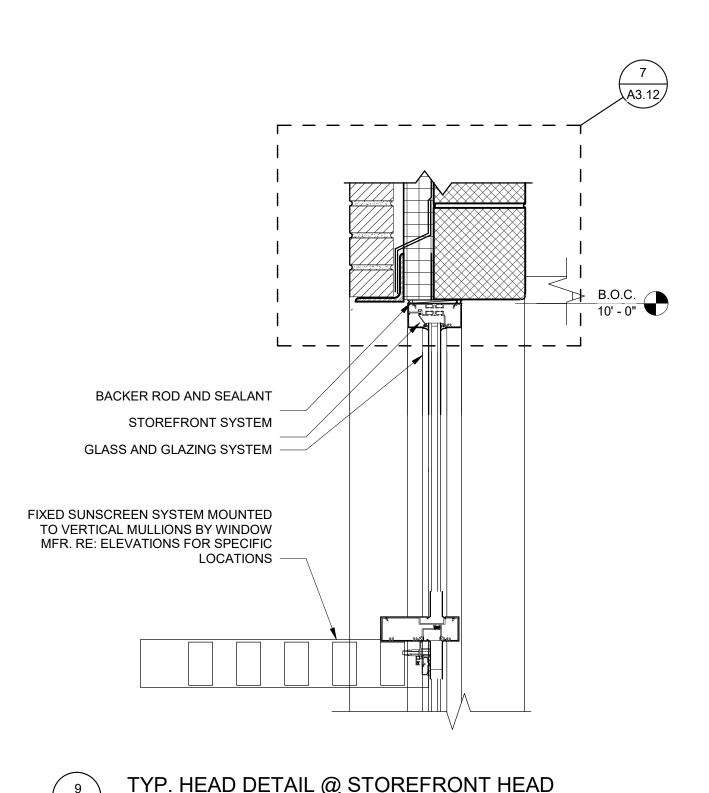




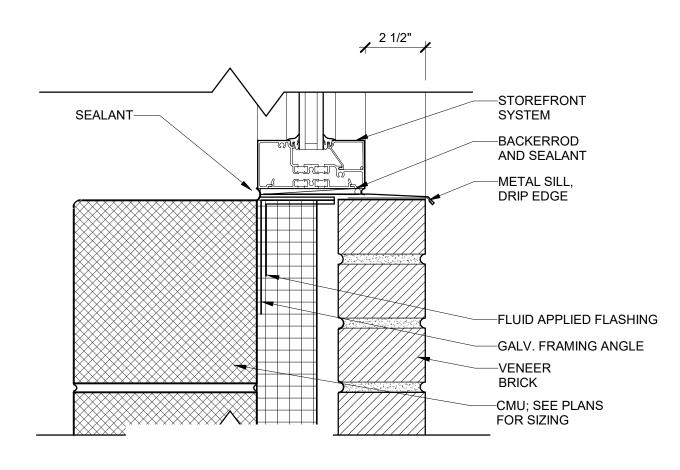


TYP. SILL DETAIL @ NEW CMU


SCALE: 3" = 1'-0"

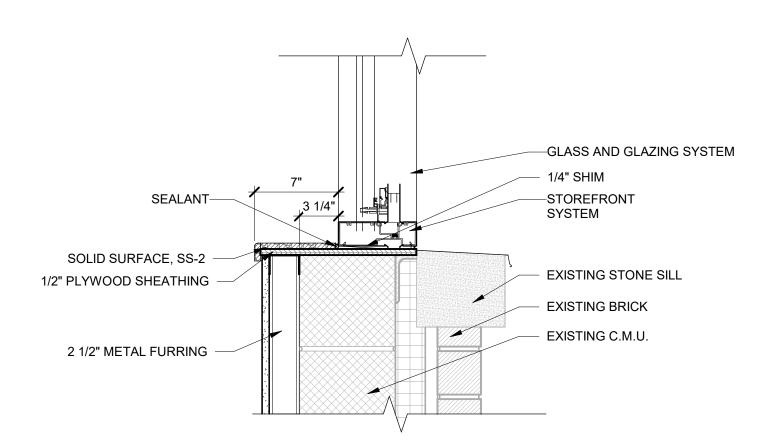


SOLID SURFACE SILL DETAIL
SCALE: 1 1/2" = 1'-0"

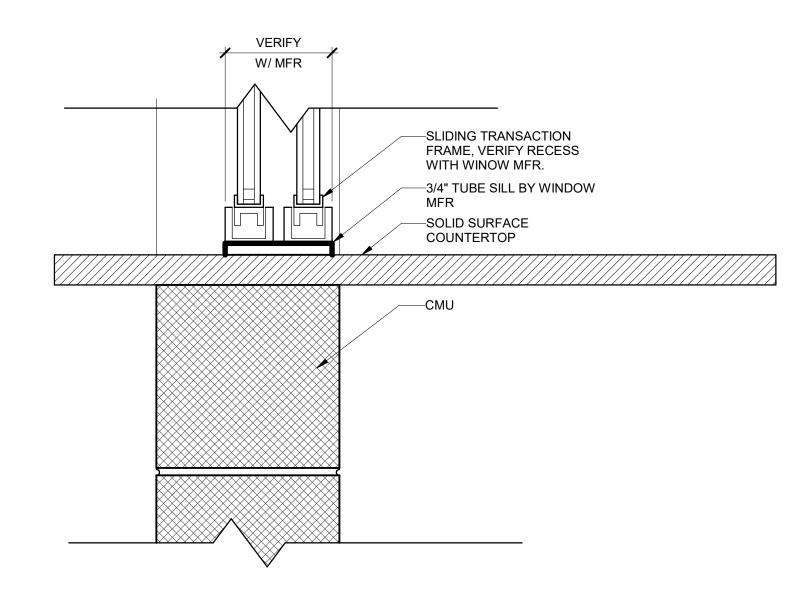

SLIDING WINDOW SILL @ LOBBY A3.12 SCALE: 3" = 1'-0"

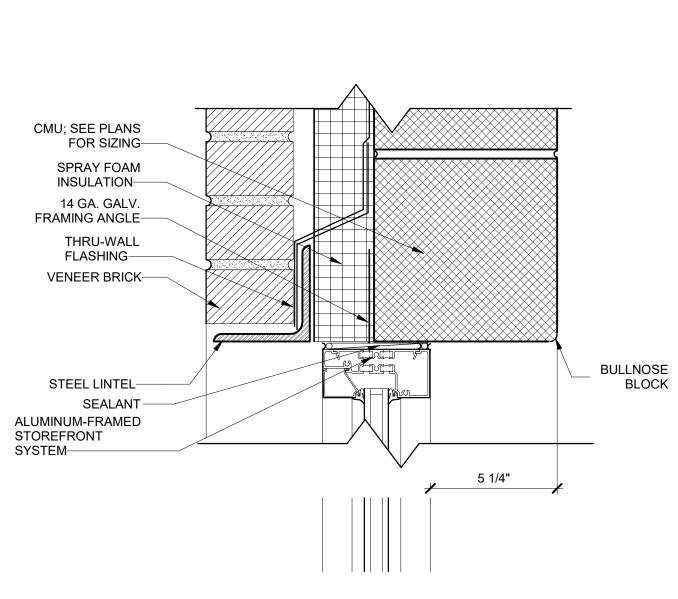


TYP. HEAD DETAIL @ NEW CMU 7 TYP. HEAD
A3.12 SCALE: 3" = 1'-0"

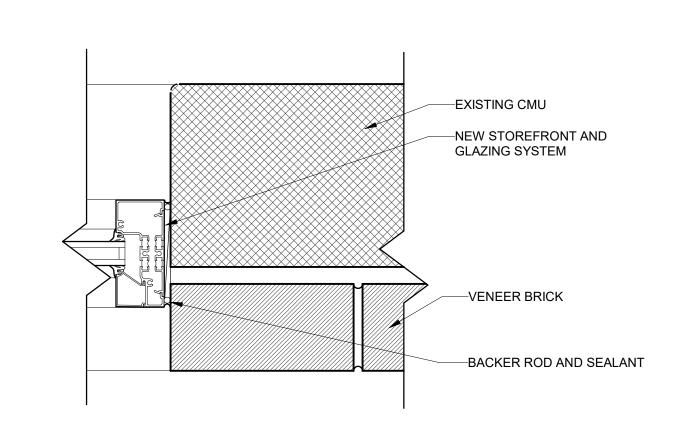


1 TYP. JAMB DETAIL @ EXISTING BRICK-BLOCK

SCALE: 3" = 1'-0"

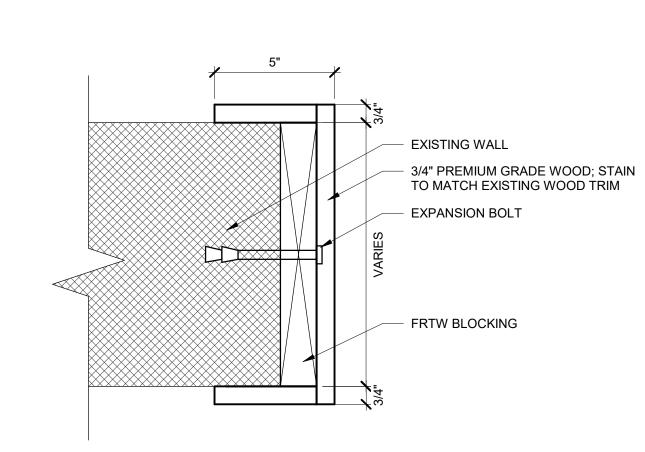

JAMB DETAIL - WOOD CAP


SCALE: 3" = 1'-0"

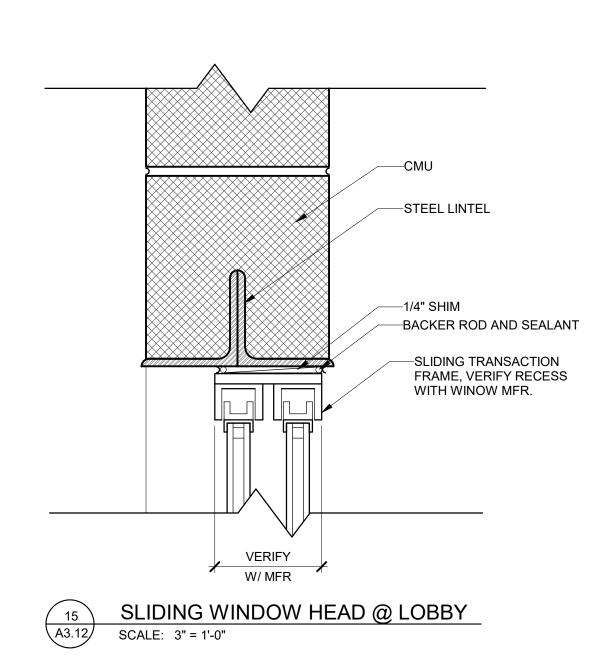

GLASS AND GLAZING SYSTEM-STOREFRONT SYSTEM-BACKER ROD AND SEALANT-MTL. FRAMING ANGLE-CONCRETE MASONRY UNIT-DECORATIVE MASONRY UNIT-RIGID INSULATION—


TYP. STONE SILL DETAIL @ NEW CMU

SCALE: 3" = 1'-0"

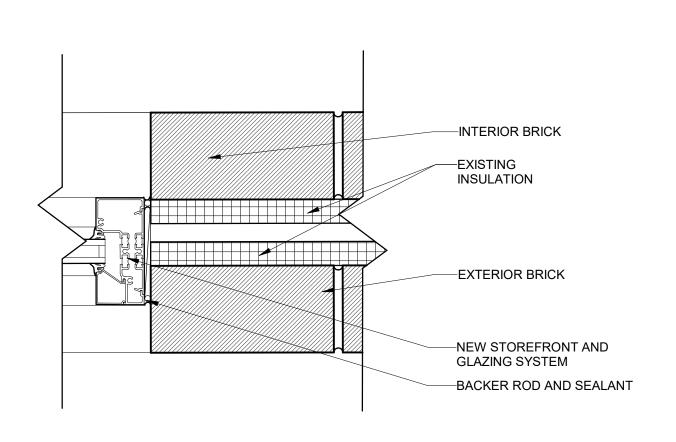


TYP. JAMB DETAIL @ EXISTING BRICK

SCALE: 3" = 1'-0"

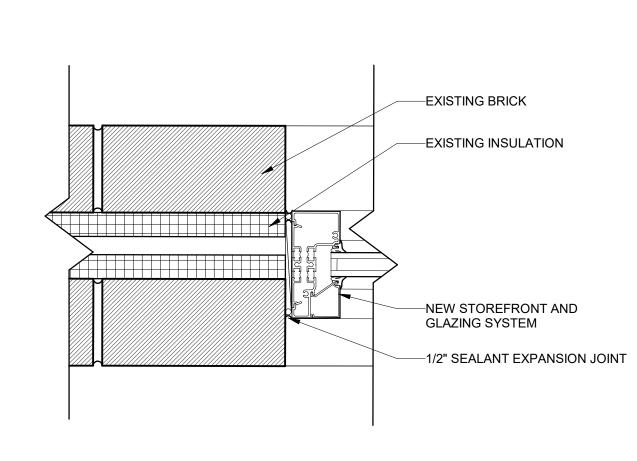


JAMB @ W8 W/ 1/2" EXPANSION JOINT


SCALE: 3" = 1'-0"

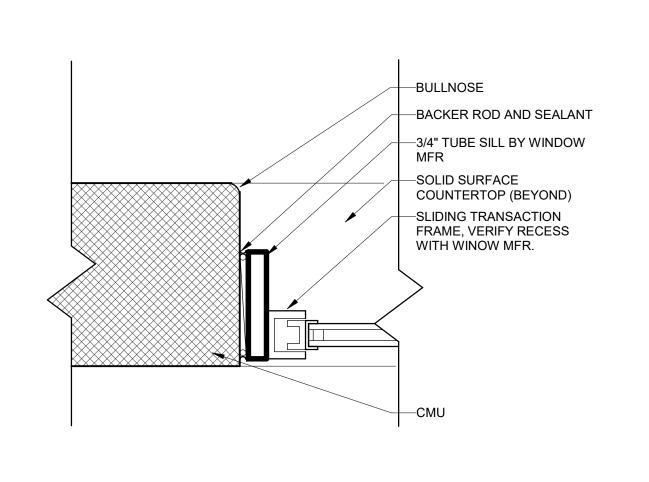



SLIDING WINDOW JAMB @ LOBBY SCALE: 3" = 1'-0"

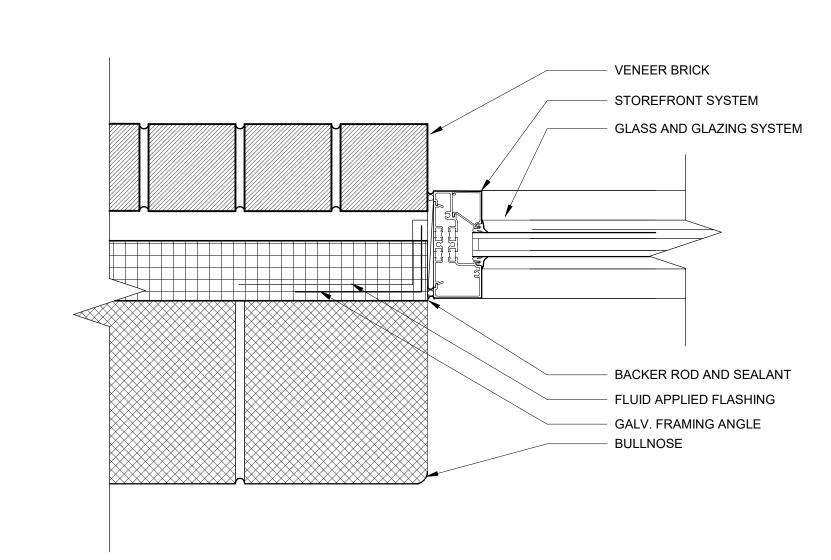


TYP. JAMB DETAIL @ NEW CMU 6 TYP. JAMB | SCALE: 3" = 1'-0"

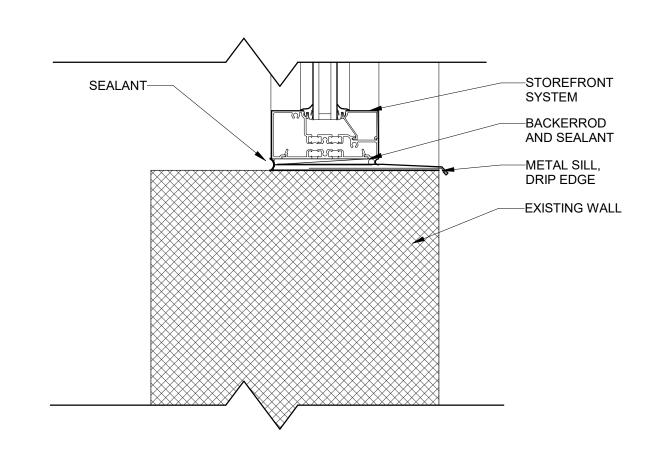

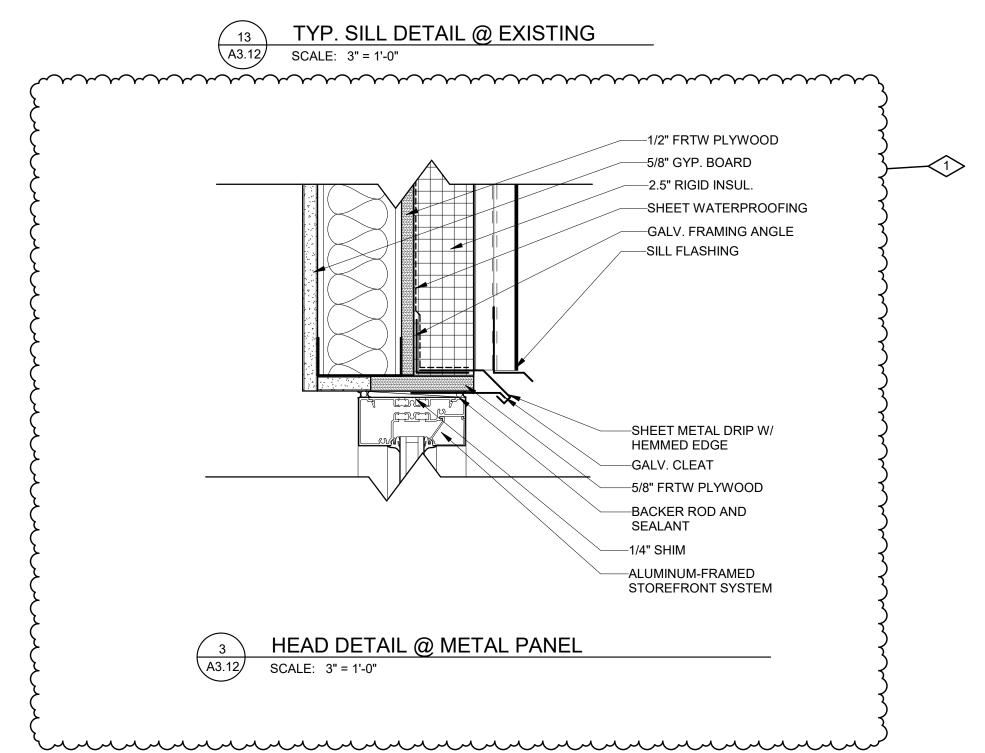

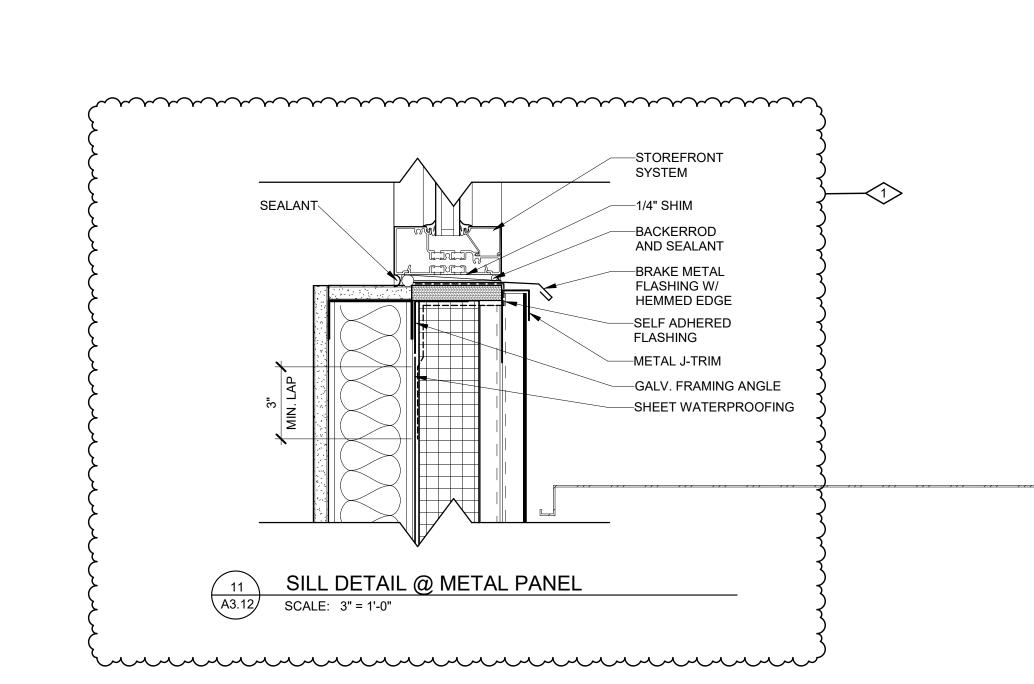

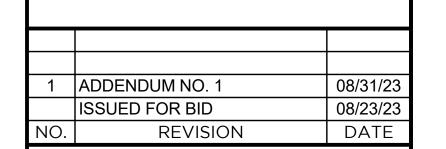



**WTA** ARCHITECTS

100 S Jefferson Ave, Suite 601 Saginaw, Michigan 48607 989 752 8107

COPYRIGHT © 2023

PROJECT TITLE


SHEET TITLE


RENOVATION AND ADDITION: MIDLAND COUNTY ESA


MIDLAND, MICHIGAN


FRAME DETAILS

ROJECT NUMBER 2022006.1	SHEET NUMBER
ROJECT DATE AUGUST 23, 2023	A3.12
HECKED BY	, (0112

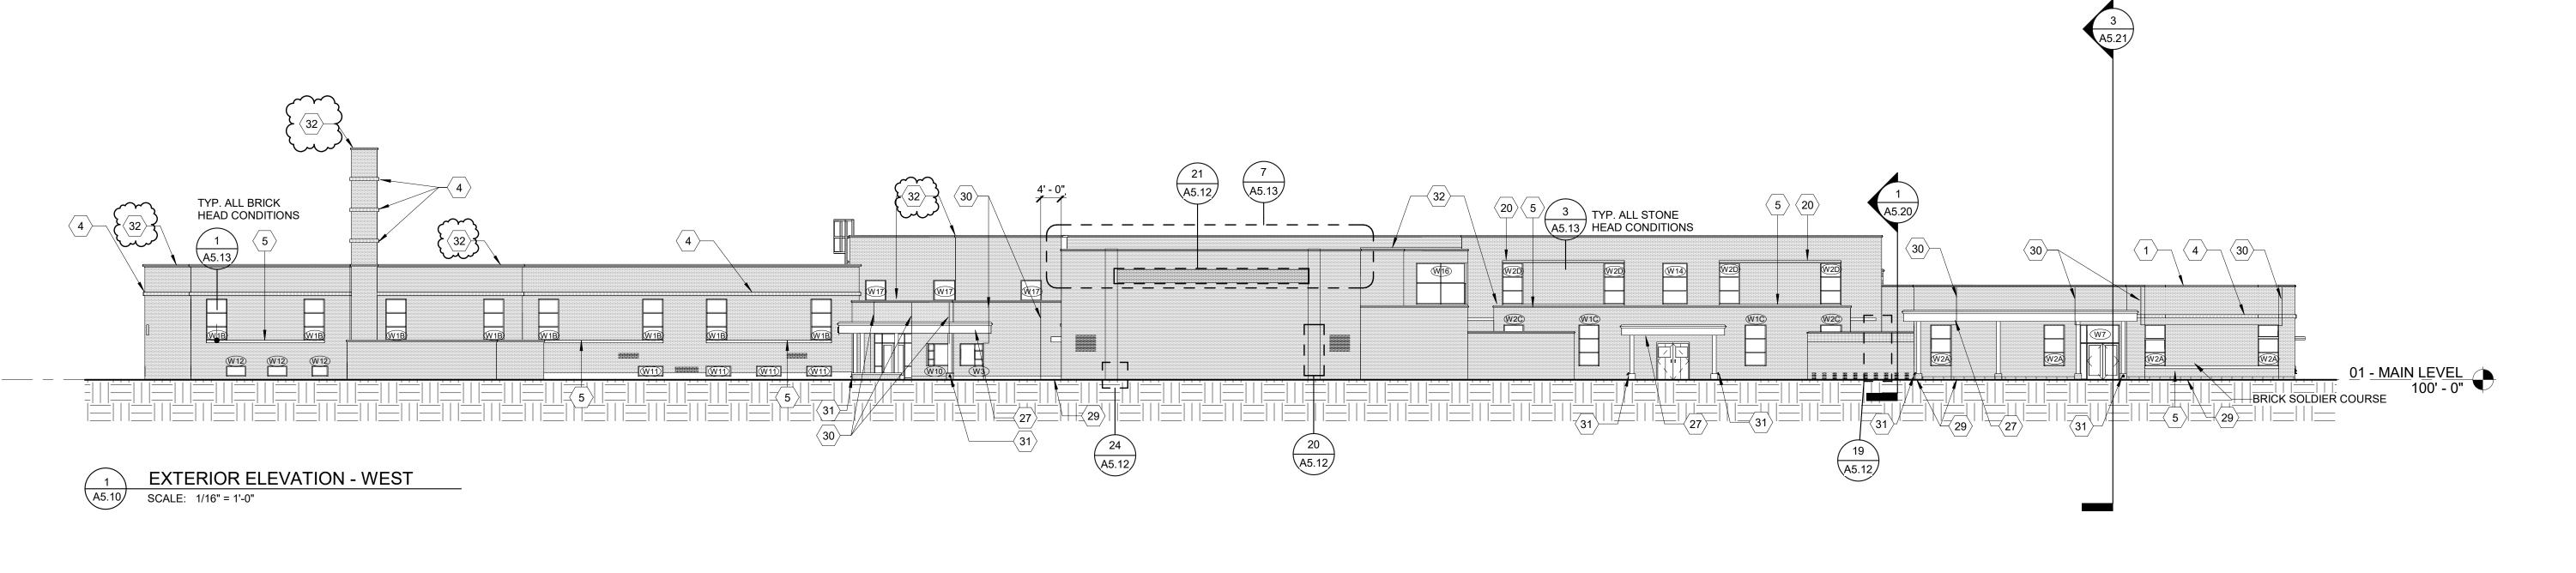

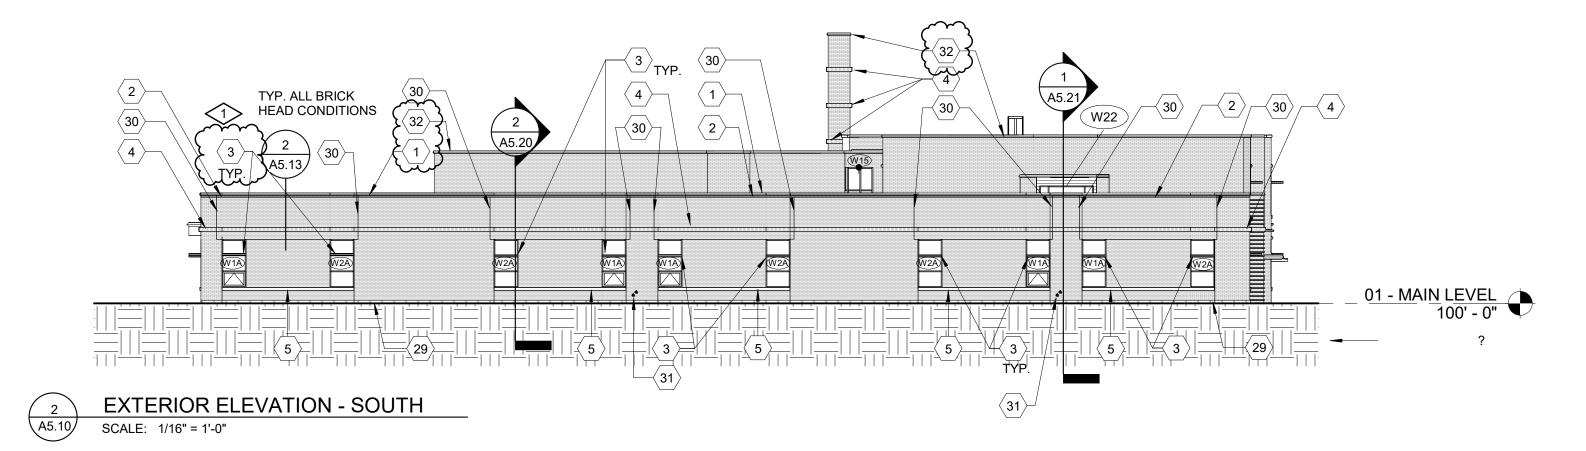

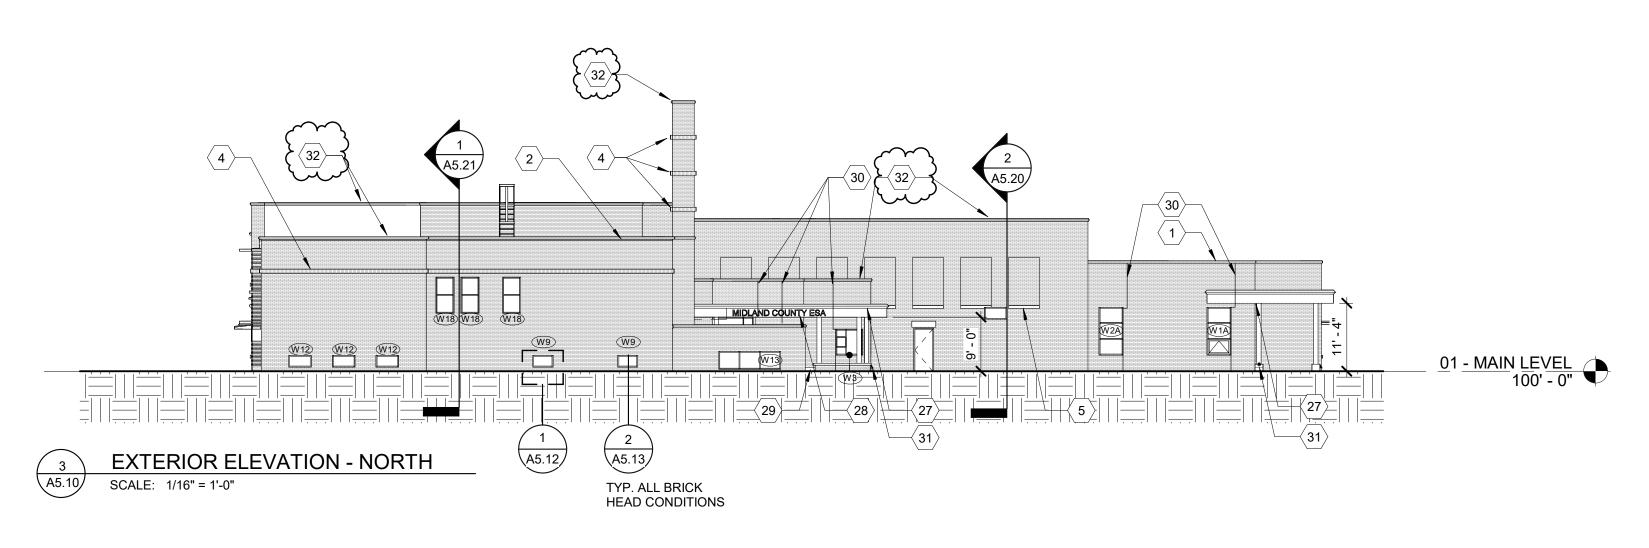

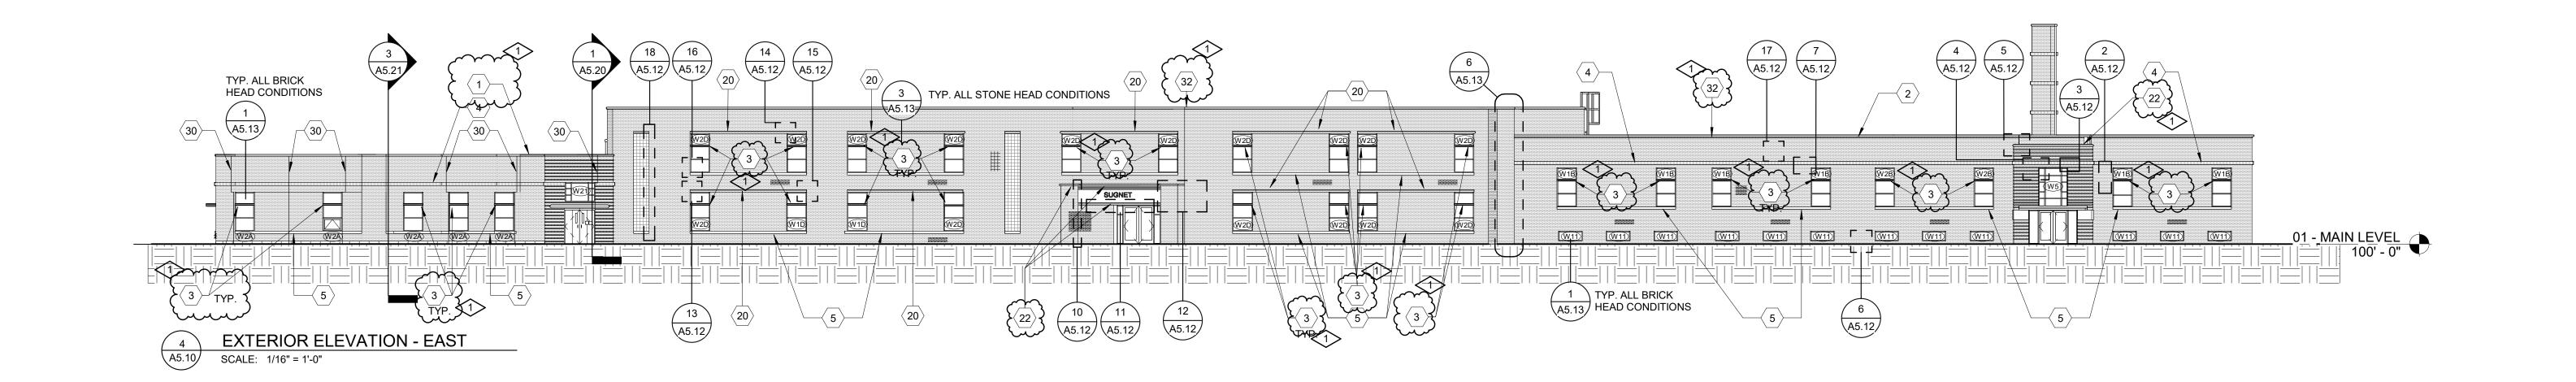

### (#) MATERIAL KEYNOTES

### 1 CAST STONE PARAPHET CAP 2 1.5" BRICK PROTRUSION

- 3 FIXED SUNSCREEN SYSTEM MOUNTED TO VERTICAL MULLIONSBY WINDOW MFR. RE: ELVATIONS FOR SPECIFIC LOCATIONS
- 4 1.5" BRICK PROTRUSION; SOLDIER COURSE 5 CAST STONE SILL
- 6 FOOTING AND FOUNDATION (SEE STRUCTURAL)
- 7 CONCRETE SLAB (SEE STRUCTURAL) 8 COMPACTED GRAINULAR FILL
- 9 DOOR (SEE SCHEDULE) 10 GLASS AND GLAZING SYSTEM
- 11 ALUMINUM FRAMING SYSTEM
- 12 FIXTURE AS OCCUR; RE: ELECTRICAL 14 REMOVE AND REPLACE ALL CRACKED OR
- SPALLED BRICK WITHIN THIS AREA WITH NEW. SEE GENERAL NOTE 1 FOR ALLOWANCE. 15 EXISTING MORTAR JOINS WITHIN AREA ARE
- CRACKED, LOOSE, MISSING, OPEN, OR GENERALLY DETERIORATED. REMOVE ALL IDENTIFIED MORTAR TO MINIMUM DEPTH OF 1" AND REPOINT WITH NEW MORTAR. SEE GENERAL NOTE 3 FOR ALLOWANCE.
- 16 OPEN CRACK IN STONE. INJECT THE CRACK FULL WITH EPOXY AND PATCH/FINISH THE EXTERIOR SURFACE OF THE STONE WITH A COLORED CEMENTITIOUS COMPOUND IN ORDER TO BLEND THE REPAIR INTO THE ADJACENT SURFACES OF THE EXISTING STONE. SEE
- GENERAL NOTE 5 FOR ALLOWANCE. 17 REMOVED EXISTING SEALANT AND BACKER ROD (IF PRESENT) BETWEEN WINDOW OR FRAME, ÀND ADJACENT MASONRY. INSTALL NEW
- BACKER ROD AND SEALANT. 18 MASONRY CONTRACTOR SHALL OPEN AREAS INDICATED SIMILAR TO CONDITION [SEE DETAILS]. CONTRACTOR SHALL THEN PROVIDE ACCESS FOR ARCHITECT/ENGINEER TO REVIEW. ONCE REVIEW IS COMPLETE THEN CONTRACTOR SHALL INFILL WITH EXISTING KIND
- MATERIALS. 19 SALVAGE A MINIMUM OF THREE COURSES OF BRICK ABOVE TOP OF WINDOW TO EXPOSE EXISTING LINTEL. REMOVE EXISTING LINTEL AND FLASHING AND INSTALL NEW LINTEL AND THRU WALL FLASHING AND REPLACE BRICK. SEE
- GENERAL NOTE TO 3, 4-FOR ALLOWNACES. SEE DETAIL 1/A5.13 2/A5.13. 20 SALVAGE STONE HEADER AND ONE COURSE OF BRICK ABOVE HEADER TO EXPOSE EXISTING LINTEL. REMOVE EXISTING LINTEL AND
- FLASHING AND INSTALL NEW LINTEL AND THRU WALL FLASHING. REINSTALL HEADER AND BRICK. SEE GENERAL NOTE 1,3,4,4,0R ALLOWANCES. SEE DETAIL 3/A5.13.
- 21 SAW CUT BRICK, INSTALL A NEW 1/2" VERTICAL EXPANSION JOINT FREE OF MASONRY AND MORTAR FULL DEPTH. FILL JOINT WITH NEW BACKER ROD AND SEALANT. SEE DETAIL 4/A5.13.
- 22 EXISTING LIMESTONE COPING PIECE TO BE 1 REMOVED AND SALVAGED FOR REINSTALLATION. ALL EXPOSED SURFACES SHALL BE CHEMICALLY CLEANED TO REMOVE DIRT AND STAINS. ALL EXISTING MORTAR AND FLASHING SHALL BE REMOVED FROM HEAD AND
- BED JOINT SURFACES. INSTALL NEW COPING FLASHING ALONG THE ENTIRE LENGTH-OR REPLACED COPING. SEE DETAIL 7/A6.11. 1
  23 HATCHING INDICATES AREA OF BRICK WALL TO
- BE SALVAGED IN ORDER TO REPAIR AND FLASH
- 24 REMOVE EXISTING ABANDONED ANCHOR. INFILL CAVITY WITH MORTAR AND RESEAL.
- 25 RESEAL GAP WITH SILICONE AROUND EXISTING
- 26 INJECT CONCRETE CRACK FULL WITH EPOXY AND PATCH/FINISH THE EXTERIOR SURFACE WITH CEMENTITIOUS COMPOUND IN ORDER TO BLEND THE REPAIR INTO ADJACENT EXISTING SURFACE. SEE GENERAL NOTE 6 FOR
- 27 CANOPY 28 CAST ALUMINUM LETTERING 18" HIGH
- CENTERED IN FACIA. 29 LIMESTONE BASE COURSE
- 30 MASONRY CONTROL JOINT 31 LIMESTONE BASE COURSE

REINSTALLED.

ALLOWANCE.

- REMOVE DIRT & STAINS. ALL MISALIGNED COPING TO BE REMOVED AND REINSTALLED TO MATCH EXISTING. ALL DETERIORATED MORTAR JOINTS AND SEALANT TO BE CLEANED AND

1	ADDENDUM NO. 1	08/31/23
	ISSUED FOR BID	08/23/23
NO.	REVISION	DATE



WTAARCH.COM

### **WTA** ARCHITECTS

100 S Jefferson Ave, Suite 601 Saginaw, Michigan 48607

989 752 8107 COPYRIGHT © 2023

PROJECT TITLE

RENOVATION AND ADDITION:

MIDLAND COUNTY ESA

MIDLAND, MICHIGAN

**EXTERIOR ELEVATIONS** 

SHEET NUMBER PROJECT NUMBER 2022006.1 PROJECT DATE AUGUST 23, 2023

A5.10 CHECKED BY JMJ



#### **EXTERIOR RESTORATION GENERAL NOTES:**

- 1. INCLUDE AN ALLOWANCE FOR THE REMOVAL AND REPLACEMENT OF ONE HUNDRED (100) INDIVIDUALLY DAMAGED BRICK UNITS. NEW BRICK SHALL MATCH EXISTING EXPOSED BRICK COURSING, COLOR, COLOR VARIATION WITHIN UNITS, SURFACE TEXTURE, SIZE, AND SHAPE. LOCATIONS SHALL BE FIELD REVIEWED WITH CONSTRUCTION MANAGER AND ARCHITECT PRIOR TO ANY WORK BEING PERFORMED. SEE EXTERIOR RESTORATION MATERIAL KEYNOTE NO. 14.
- 2. INCLUDE ALLOWANCE FOR THE REMOVAL AND REPLACEMENT OF ONE HUNDRED SQUARE FEET (100 SF) OF DAMAGED BRICK UNITS. NEW BRICK SHALL MATCH EXISTING EXPOSED BRICK COURSING, COLOR, COLOR VARIATION WITHIN UNITS, SURFACE TEXTURE, SIZE, AND SHAPE. LOCATIONS SHALL BE FIELD REVIEWED, VERIFIED, AND DOCUMENTED WITH CONSTRUCTION MANAGER AND ARCHITECT PRIOR TO ANY WORK BEING PERFORMED. SEE EXTERIOR RESTORATION MATERIAL KEYNOTE NO. 14.
- 3. INCLUDE AN ALLOWANCE FOR THE REMOVAL AND REPOINTING OF ONE THOUSAND FIVE HUNDRED LINEAR FEET (1500') OF DAMAGED MORTAR JOINTS. DEPTH OF NEW MORTAR SHALL BE 1 INCH MINIMUM. LOCATIONS SHALL BE FIELD REVIEWED, VERIFIED AND DOCUMENTED WITH CONSTRUCTION MANAGER AND ARCHITECT PRIOR TO ANY WORK BEING PERFORMED. SEE EXTERIOR RESTORATION MATERIAL KEYNOTE NO. 15.
- 4. INCLUDE AN ALLOWANCE FOR THE REMOVAL AND REPLACEMENT OF SEVEN HUNDRED SEVENTY-FIVE FEET (775') OF STEEL ANGLE LINTEL. SEE EXTERIOR RESTORATION MATERIAL KEYNOTE NO. 19, NO. 20.
- 5. INCLUDE AN ALLOWANCE FOR TEN (10) INJECTED EPOXY AND CEMENTITIOUS COMPOUND. AND STAINLESS-STEEL DOWEL, FOR STONE CRACK REPAIRS. LOCATIONS SHALL BE FIELD REVIEWED, VERIFIED AND DOCUMENTED WITH CONSTRUCTION MANAGER AND ARCHITECT PRIOR TO ANY WORK BEING PERFORMED. SEE EXTERIOR RESTORATION MATERIAL KEYNOTE NO. 16.
- 6. INCLUDE AN ALLOWANCE FOR TEN (10) INJECTED EPOXY AND CEMENTITIOUS COMPOUND CONCRETE FOUNDATION REPAIRS. LOCATIONS SHALL BE FIELD REVIEWED, VERIFIED AND DOCUMENTED WITH CONSTRUCTION MANAGER AND ARCHITECT PRIOR TO ANY WORK BEING PERFORMED. SEE EXTERIOR RESTORATION MATERIAL KEYNOTE NO. 26.
- 7. CONTRACTOR TO COORDINATE LOCATIONS OF ADDITIONAL PENETRATIONS THROUGH WALLS AND FLOORS NOT INDICATED ON ARCHITECTURAL DRAWINGS. REFER TO MECHANICAL, PLUMBING, AND ELECTRICAL. REFER TO STRUCTURAL DRAWINGS FOR LINTEL OR FRAMING REQUIREMENTS.
- 8. AFTER COMPLETION OF WORK, CONTRACTOR SHALL CLEAN ALL WINDOW UNITS WHERE CONSTRUCTION DUST, DIRT, AND MATERIAL RESIDUE, ETC. MAY BE PRESENT.
- 9. AT ALL LOCATIONS OF MASONRY REMOVAL AND REPLACEMENT, CONTRACTOR SHALL PROPERLY INSTALL SHORING TO SUPPORT EXISTING MASONRY TO REMAIN ABOVE OPENED AREA. FAILURE TO INSTALL ADEQUATE SHORING THAT RESULTS IN DAMAGE TO THE MASONRY TO REMAIN SHALL BE THE RESPONSIBILITY OF THE CONTRACTOR TO REPAIR AND/OR REPLACE DAMAGED MASONRY AND/OR ADJACENT SURFACES, WALLS, ETC.
- 10. ALL ROOF AREAS AFFECTED BY CONSTRUCTION ACTIVITY SHALL BE PROTECTED WITH 3/4" PLYWOOD ON 2" RIGID SLOTTED INSULATION ON 6 MIL. PLASTIC SHEETING OVER THE EXISTING ROOFING. THIS SHALL INCLUDE ROOFS BOTH ABOVE AND BELOW THE AREAS UNDER CONSTRUCTION. DO NOT BLOCK EXISTING ROOF DRAINS, MAINTAIN POSITIVE DRAINAGE TO THEM, PROTECT DRAINS FROM DAMAGE.
- 11. COLOR SCHEDULE FOR NEW SEALANTS SHALL BE AS FOLLOWS:
  - 1. VERTICAL BRICK TO BRICK = RED TO MATCH BRICK
  - 2. HORIZONTAL BRICK OR STONE = LIMESTONE (U.N.O) 3. BRICK TO STONE OR STONE TO STONE
- = LIMESTONE 12. PROVIDE ACTUAL IN WALL SEALANT MOCKUPS OF EACH TYPE AND COLOR FOR OWNER AND ARCHITECT'S REVIEW. MOCKUPS MAY BECOME PART OF THE PERMANENT WORK IF APPROVED.
- 13. AT LOCATIONS WHERE MORE THAN 2.67 SQ.FT. OF BRICK IS REMOVED AND REPLACED WITH NEW BRICK, OR UNLESS NOTED OTHERWISE, INSTALL NEW ADJUSTABLE STAINLESS STEEL BRICK TIES AT 24" O.C. HORIZONTALLY AND 16" O.C. VERTICALLY. SEE SPECIFICATIONS FOR TIES.
- 14. ALONG WITH CLEANING ALL AREAS OF THE NEW MASONRY INSTALLATIONS AND WHERE SPECIFIC STAINING IS NOTED TO BE CLEANED, CONTRACTOR SHALL CLEAN ALL AREAS OF EXISTING MASONRY BELOW AND ADJACENT TO THE WORK AREA THAT MAY BE AFFECTED BY RUN-OFF OR OVER-SPRAY AT NO ADDITIONAL COST TO OWNER.
- 15. ALL WELDING ON THIS PROJECT IS TO BE PERFORMED BY CERTIFIED WELDERS (NO EXCEPTIONS). INDIVIDUAL WELDERS' CERTIFICATES TO BE INCLUDED IN SUBMITTALS.
- 16. ALL WELDING WORK AND FLASHING PANS TO BE INSPECTED BY ARCHITECT, STRUCTURAL ENGINEER, AND/OR TESTING COMPANY HIRED BY OWNER PRIOR TO COVERING WITH NEW MASONRY.
- 17. WHERE ALL NEW FLASHINGS TERMINATE AGAINST A VERTICAL SURFACE - PROVIDE PROPER WATERTIGHT END DAMS THAT DIRECT WATER TO DRAINAGE WEEPS. STAINLESS STEEL PAN FLASHINGS SHALL HAVE EDGE TURNED UP WITH CORNERS SOLDERED WATERTIGHT. TYPICAL ALL LOCATIONS.
- 18. ALL PENETRATIONS SHALL BE SEALED WITH SEALANT AND BACKER ROD ON NEW AND EXISTING FACE BRICK.
- 19. ALL ABANDONED ANCHORS ON FACE BRICK SHALL BE REMOVED AND THE CAVITY INFILLED WITH MORTAR.
- 20. ALL WORK INDICATED ON DRAWINGS DOES NOT NECESSARILY HAVE A CORRESPONDING "EXTERIOR RESTORATION KEYNOTE" ASSIGNED TO IT AND MAY BE INDICATED BY "GENERAL NOTES" OR DETAILS.
- 21. CLEAN ALL EXISTING STONE SURFACES SALVAGED OR TO REMAIN.
- 22. CLEAN ALL EXISTING AND NEW BRICK.

#### $\langle \# angle$ MATERIAL KEYNOTES

- 1 CAST STONE PARAPHET CAP 1 FIXED SUNSCREEN SYSTEM MOUNTED TO
  - VERTICAL MULLIONSBY WINDOW MFR. RE: ELVATIONS FOR SPECIFIC LOCATIONS
- 4 1.5" BRICK PROTRUSION; SOLDIER COURSE 5 CAST STONE SILL
- 6 FOOTING AND FOUNDATION (SEE STRUCTURAL)
- 7 CONCRETE SLAB (SEE STRUCTURAL) 8 COMPACTED GRAINULAR FILL
- 9 DOOR (SEE SCHEDULE) 10 GLASS AND GLAZING SYSTEM
- 11 ALUMINUM FRAMING SYSTEM
- 12 FIXTURE AS OCCUR; RE: ELECTRICAL 14 REMOVE AND REPLACE ALL CRACKED OR
- SPALLED BRICK WITHIN THIS AREA WITH NEW SEE GENERAL NOTE 1 FOR ALLOWANCE.
- 15 EXISTING MORTAR JOINS WITHIN AREA ARE CRACKED, LOOSE, MISSING, OPEN, OR GENERALLY DETERIORATED. REMOVE ALL IDENTIFIED MORTAR TO MINIMUM DEPTH OF 1
- AND REPOINT WITH NEW MORTAR. SEE GENERAL NOTE 3 FOR ALLOWANCE. 16 OPEN CRACK IN STONE. INJECT THE CRACK FULL WITH EPOXY AND PATCH/FINISH THE EXTERIOR SURFACE OF THE STONE WITH A COLORED CEMENTITIOUS COMPOUND IN ORDER
- TO BLEND THE REPAIR INTO THE ADJACENT SURFACES OF THE EXISTING STONE. SEE GENERAL NOTE 5 FOR ALLOWANCE. 17 REMOVED EXISTING SEALANT AND BACKER ROD (IF PRESENT) BETWEEN WINDOW OR FRAME,
- AND ADJACENT MASONRY. INSTALL NEW BACKER ROD AND SEALANT. 18 MASONRY CONTRACTOR SHALL OPEN AREAS INDICATED SIMILAR TO CONDITION [SEE DETAILS]. CONTRACTOR SHALL THEN PROVIDE ACCESS FOR ARCHITECT/ENGINEER TO REVIEW. ONCE REVIEW IS COMPLETE THEN
- MATERIALS. 19 SALVAGE A MINIMUM OF THREE COURSES OF BRICK ABOVE TOP OF WINDOW TO EXPOSE EXISTING LINTEL. REMOVE EXISTING LINTEL AND FLASHING AND INSTALL NEW LINTEL AND THRU WALL FLASHING AND REPLACE BRICK. SEE
- GENERAL NOTE 1, 2, 4 FOR ALLOWNACES. SEE DETAIL 1/A5.13. 2/A5.13. 20 SALVAGE STONE HEADER AND ONE COURSE OF

CONTRACTOR SHALL INFILL WITH EXISTING KIND

- BRICK ABOVE HEADER TO EXPOSE EXISTING LINTEL. REMOVE EXISTING LINTEL AND FLASHING AND INSTALL NEW LINTEL AND THRU WALL FLASHING. REINSTALL HEADER AND BRICK. SEE GENERAL NOTE 1, 3, 4, FOR ALLOWANCES. SEE DETAIL 3/A5 13.2 1
- 21 SAW CUT BRICK, INSTALL A NEW 1/2" VERTICAL EXPANSION JOINT FREE OF MASONRY AND MORTAR FULL DEPTH. FILL JOINT WITH NEW-BACKER ROD AND SEALANT. SEE DETAIL 4/A5.13.

  22 EXISTING LIMESTONE COPING PIECE TO BE 1
- REMOVED AND SALVAGED FOR REINSTALLATION. ALL EXPOSED SURFACES SHALL BE CHEMICALLY CLEANED TO REMOVE DIRT AND STAINS. ALL EXISTING MORTAR AND FLASHING SHALL BE REMOVED FROM HEAD AND BED JOINT SURFACES. INSTALL NEW COPING FLASHING ALONG THE ENTIRE LEMGTH-OF
- REPLACED COPING. SEE DETAIL 7/A6.11. 23 HATCHING INDICATES AREA OF BRICK WALL TO BE SALVAGED IN ORDER TO REPAIR AND FLASH
- EMBEDDED STEEL CONDITIONS. 24 REMOVE EXISTING ABANDONED ANCHOR. INFILL CAVITY WITH MORTAR AND RESEAL.
- 25 RESEAL GAP WITH SILICONE AROUND EXISTING 26 INJECT CONCRETE CRACK FULL WITH EPOXY
- AND PATCH/FINISH THE EXTERIOR SURFACE WITH CEMENTITIOUS COMPOUND IN ORDER TO BLEND THE REPAIR INTO ADJACENT EXISTING SURFACE. SEE GENERAL NOTE 6 FOR ALLOWANCE.
- 27 CANOPY 28 CAST ALUMINUM LETTERING 18" HIGH
- CENTERED IN FACIA.
- 29 LIMESTONE BASE COURSE 30 MASONRY CONTROL JOINT

REINSTALLED.

31 LIMESTONE BASE COURSE 32 EXISTING LIMESTONE COPING. ALL EXPOSED SURFACES TO BE CHEMICALLY CLEANED TO REMOVE DIRT & STAINS. ALL MISALIGNED COPING TO BE REMOVED AND REINSTALLED TO MATCH EXISTING. ALL DETERIORATED MORTAR JOINTS AND SEALANT TO BE CLEANED AND

1	ADDENDUM NO. 1	08/31/23
	ISSUED FOR BID	08/23/23
NO.	REVISION	DATE



COPYRIGHT © 2023

### WTA ARCHITECTS

100 S Jefferson Ave, Suite 601 Saginaw, Michigan 48607

989 752 8107

PROJECT TITLE

JMJ

RENOVATION AND ADDITION:


MIDLAND COUNTY ESA

MIDLAND, MICHIGAN


**EXTERIOR PHOTO** DETAILS


PROJECT NUMBER SHEET NUMBER 2022006.1 PROJECT DATE AUGUST 23, 2023

A5.12 CHECKED BY

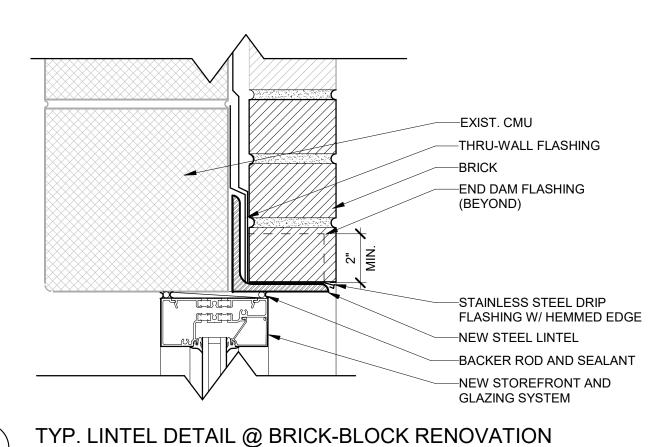



SCALE: 3" = 1'-0"

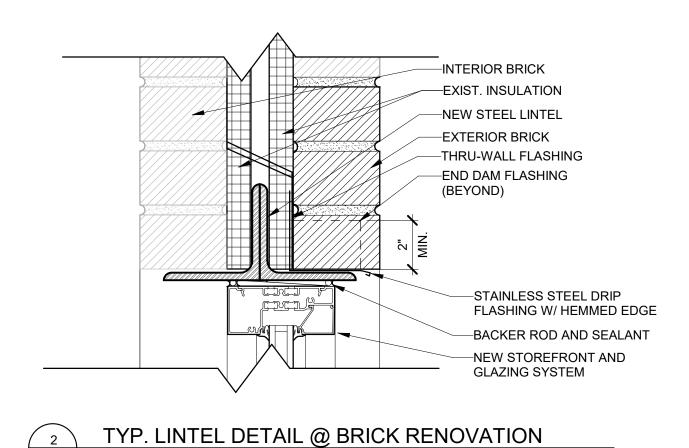


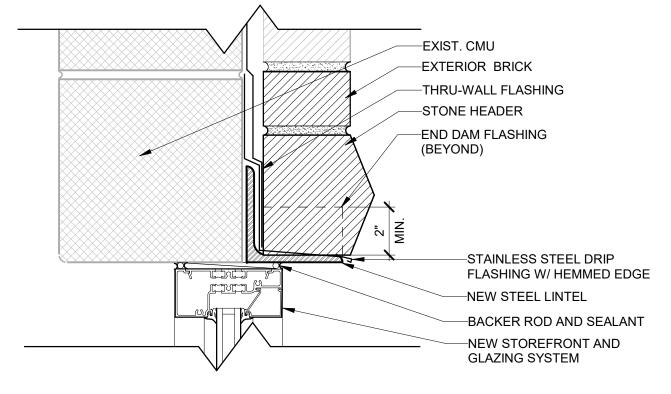


TYP. LINTEL DETAIL @ STONE HEADER RENOVATION SCALE: 3" = 1'-0"

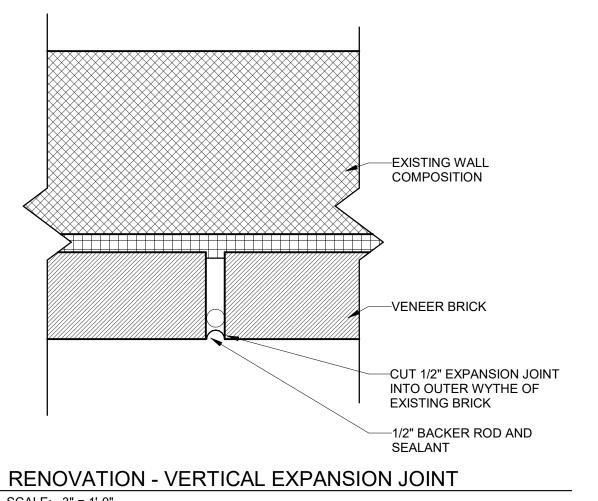


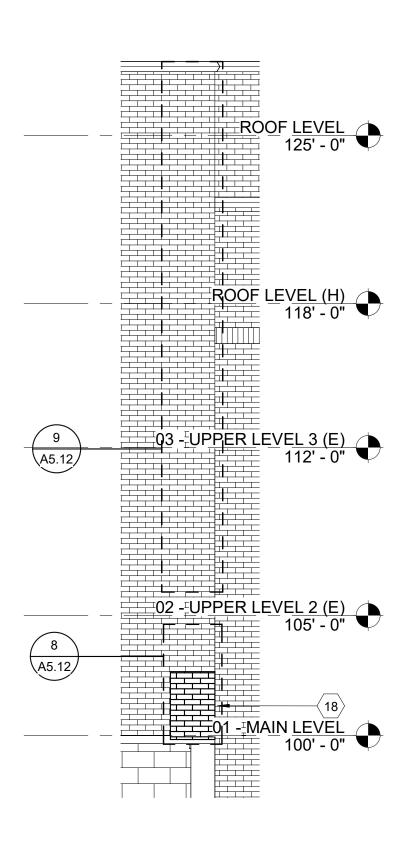

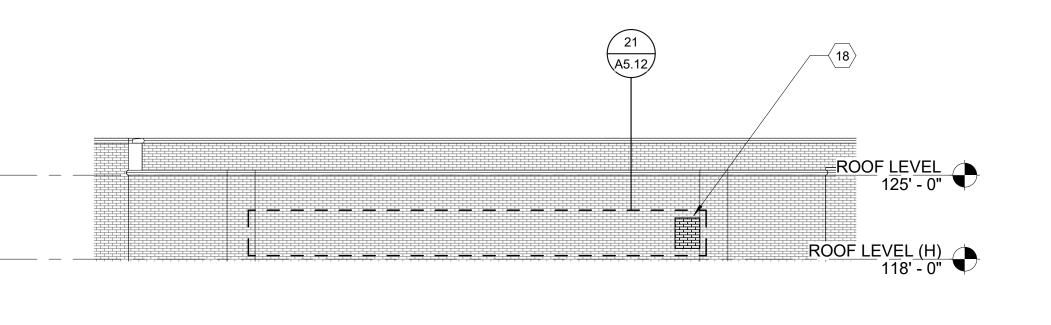

EXPLORATORY DEMO DETAIL - WEST GYM WALL SCALE: 1/8" = 1'-0"

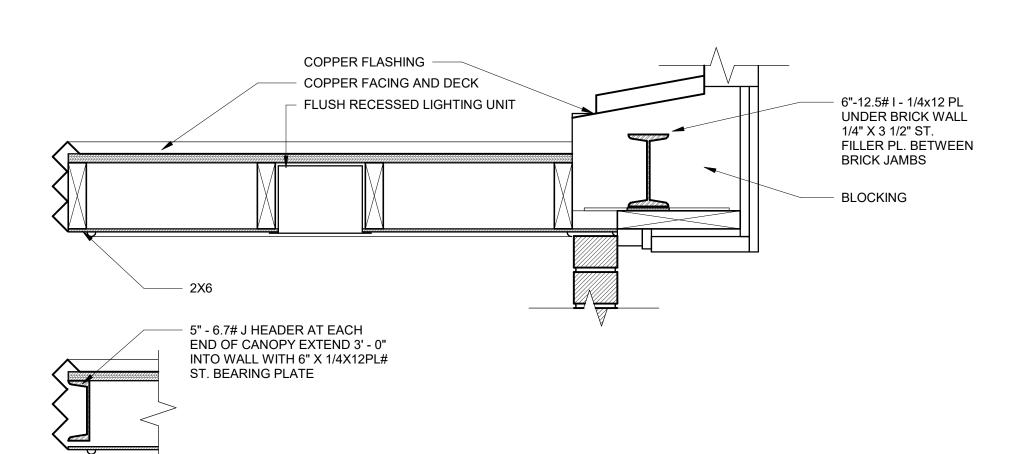

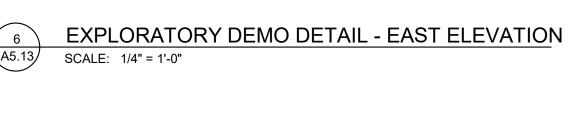

#### **EXTERIOR RESTORATION GENERAL NOTES:**

- 1. INCLUDE AN ALLOWANCE FOR THE REMOVAL AND REPLACEMENT OF ONE HUNDRED (100) INDIVIDUALLY DAMAGED BRICK UNITS. NEW BRICK SHALL MATCH EXISTING EXPOSED BRICK COURSING, COLOR, COLOR VARIATION WITHIN UNITS, SURFACE TEXTURE, SIZE, AND SHAPE. LOCATIONS SHALL BE FIELD REVIEWED WITH CONSTRUCTION MANAGER AND ARCHITECT PRIOR TO ANY WORK BEING PERFORMED. SEE EXTERIOR RESTORATION MATERIAL KEYNOTE NO. 14.
- 2. INCLUDE ALLOWANCE FOR THE REMOVAL AND REPLACEMENT OF ONE HUNDRED SQUARE FEET (100 SF) OF DAMAGED BRICK UNITS. NEW BRICK SHALL MATCH EXISTING EXPOSED BRICK COURSING, COLOR, COLOR VARIATION WITHIN UNITS, SURFACE TEXTURE, SIZE, AND SHAPE. LOCATIONS SHALL BE FIELD REVIEWED, VERIFIED, AND DOCUMENTED WITH CONSTRUCTION MANAGER AND ARCHITECT PRIOR TO ANY WORK BEING PERFORMED. SEE EXTERIOR RESTORATION MATERIAL KEYNOTE NO. 14.
- 3. INCLUDE AN ALLOWANCE FOR THE REMOVAL AND REPOINTING OF ONE THOUSAND FIVE HUNDRED LINEAR FEET (1500') OF DAMAGED MORTAR JOINTS. DEPTH OF NEW MORTAR SHALL BE 1 INCH MINIMUM. LOCATIONS SHALL BE FIELD REVIEWED, VERIFIED AND DOCUMENTED WITH CONSTRUCTION MANAGER AND ARCHITECT PRIOR TO ANY WORK BEING PERFORMED. SEE EXTERIOR RESTORATION MATERIAL KEYNOTE NO. 15.
- 4. INCLUDE AN ALLOWANCE FOR THE REMOVAL AND REPLACEMENT OF SEVEN HUNDRED SEVENTY-FIVE FEET (775') OF STEEL ANGLE LINTEL. SEE EXTERIOR RESTORATION MATERIAL KEYNOTE NO. 19, NO. 20.
- 5. INCLUDE AN ALLOWANCE FOR TEN (10) INJECTED EPOXY AND CEMENTITIOUS COMPOUND, AND STAINLESS-STEEL DOWEL, FOR STONE CRACK REPAIRS. LOCATIONS SHALL BE FIELD REVIEWED, VERIFIED AND DOCUMENTED WITH CONSTRUCTION MANAGER AND ARCHITECT PRIOR TO ANY WORK BEING PERFORMED. SEE EXTERIOR RESTORATION MATERIAL KEYNOTE NO. 16.
- 6. INCLUDE AN ALLOWANCE FOR TEN (10) INJECTED EPOXY AND CEMENTITIOUS COMPOUND CONCRETE FOUNDATION REPAIRS. LOCATIONS SHALL BE FIELD REVIEWED, VERIFIED AND DOCUMENTED WITH CONSTRUCTION MANAGER AND ARCHITECT PRIOR TO ANY WORK BEING PERFORMED. SEE EXTERIOR RESTORATION MATERIAL KEYNOTE NO. 26.
- 7. CONTRACTOR TO COORDINATE LOCATIONS OF ADDITIONAL PENETRATIONS THROUGH WALLS AND FLOORS NOT INDICATED ON ARCHITECTURAL DRAWINGS. REFER TO MECHANICAL, PLUMBING, AND ELECTRICAL. REFER TO STRUCTURAL DRAWINGS FOR LINTEL OR FRAMING REQUIREMENTS.
- 8. AFTER COMPLETION OF WORK, CONTRACTOR SHALL CLEAN ALL WINDOW UNITS WHERE CONSTRUCTION DUST, DIRT, AND MATERIAL RESIDUE, ETC. MAY BE PRESENT.
- 9. AT ALL LOCATIONS OF MASONRY REMOVAL AND REPLACEMENT, CONTRACTOR SHALL PROPERLY INSTALL SHORING TO SUPPORT EXISTING MASONRY TO REMAIN ABOVE OPENED AREA. FAILURE TO INSTALL ADEQUATE SHORING THAT RESULTS IN DAMAGE TO THE MASONRY TO REMAIN SHALL BE THE RESPONSIBILITY OF THE CONTRACTOR TO REPAIR AND/OR REPLACE DAMAGED MASONRY AND/OR ADJACENT SURFACES, WALLS, ETC.
- 10. ALL ROOF AREAS AFFECTED BY CONSTRUCTION ACTIVITY SHALL BE PROTECTED WITH 3/4" PLYWOOD ON 2" RIGID SLOTTED INSULATION ON 6 MIL. PLASTIC SHEETING OVER THE EXISTING ROOFING. THIS SHALL INCLUDE ROOFS BOTH ABOVE AND BELOW THE AREAS UNDER CONSTRUCTION. DO NOT BLOCK EXISTING ROOF DRAINS, MAINTAIN POSITIVE DRAINAGE TO THEM, PROTECT DRAINS FROM DAMAGE.
- 11. COLOR SCHEDULE FOR NEW SEALANTS SHALL BE AS FOLLOWS:
  - VERTICAL BRICK TO BRICK = RED TO MATCH BRICK
  - LIMESTONE (U.N.O) 3. BRICK TO STONE OR STONE TO STONE = LIMESTONE

2. HORIZONTAL BRICK OR STONE =

- 12. PROVIDE ACTUAL IN WALL SEALANT MOCKUPS OF EACH TYPE AND COLOR FOR OWNER AND ARCHITECT'S REVIEW. MOCKUPS MAY BECOME PART OF THE PERMANENT WORK IF APPROVED.
- 13. AT LOCATIONS WHERE MORE THAN 2.67 SQ.FT. OF BRICK IS REMOVED AND REPLACED WITH NEW BRICK, OR UNLESS NOTED OTHERWISE, INSTALL NEW ADJUSTABLE STAINLESS STEEL BRICK TIES AT 24" O.C. HORIZONTALLY AND 16" O.C. VERTICALLY. SEE SPECIFICATIONS FOR TIES.
- 14. ALONG WITH CLEANING ALL AREAS OF THE NEW MASONRY INSTALLATIONS AND WHERE SPECIFIC STAINING IS NOTED TO BE CLEANED, CONTRACTOR SHALL CLEAN ALL AREAS OF EXISTING MASONRY BELOW AND ADJACENT TO THE WORK AREA THAT MAY BE AFFECTED BY RUN-OFF OR OVER-SPRAY AT NO ADDITIONAL COST TO OWNER.
- 15. ALL WELDING ON THIS PROJECT IS TO BE PERFORMED BY CERTIFIED WELDERS (NO EXCEPTIONS). INDIVIDUAL WELDERS' CERTIFICATES TO BE INCLUDED IN SUBMITTALS.
- 16. ALL WELDING WORK AND FLASHING PANS TO BE INSPECTED BY ARCHITECT, STRUCTURAL ENGINEER, AND/OR TESTING COMPANY HIRED BY OWNER PRIOR TO COVERING WITH NEW MASONRY.
- 17. WHERE ALL NEW FLASHINGS TERMINATE AGAINST A VERTICAL SURFACE - PROVIDE PROPER WATERTIGHT END DAMS THAT DIRECT WATER TO DRAINAGE WEEPS. STAINLESS STEEL PAN FLASHINGS SHALL HAVE EDGE TURNED UP WITH CORNERS SOLDERED WATERTIGHT. TYPICAL ALL LOCATIONS.
- 18. ALL PENETRATIONS SHALL BE SEALED WITH SEALANT AND BACKER ROD ON NEW AND EXISTING FACE BRICK.
- 19. ALL ABANDONED ANCHORS ON FACE BRICK SHALL BE REMOVED AND THE CAVITY INFILLED WITH
- 20. ALL WORK INDICATED ON DRAWINGS DOES NOT NECESSARILY HAVE A CORRESPONDING "EXTERIOR RESTORATION KEYNOTE" ASSIGNED TO IT AND MAY BE INDICATED BY "GENERAL NOTES"
- OR DETAILS. 21. CLEAN ALL EXISTING STONE SURFACES SALVAGED OR TO REMAIN.
- 22. CLEAN ALL EXISTING AND NEW BRICK.

#### (#) MATERIAL KEYNOTES

- $\overline{\mathcal{A}}$ 1 CAST STONE PARAPHET CAP 24.5 BRICK PROTRUSION
- FIXED SUNSCREEN SYSTEM MOUNTED TO VERTICAL MULLIONSBY WINDOW MFR. RE:
- ELVATIONS FOR SPECIFIC LOCATIONS 4 1.5" BRICK PROTRUSION; SOLDIER COURSE
- 5 CAST STONE SILL 6 FOOTING AND FOUNDATION (SEE STRUCTURAL)
- 7 CONCRETE SLAB (SEE STRUCTURAL)
- 8 COMPACTED GRAINULAR FILL 9 DOOR (SEE SCHEDULE)
- 10 GLASS AND GLAZING SYSTEM
- 11 ALUMINUM FRAMING SYSTEM
- 12 FIXTURE AS OCCUR; RE: ELECTRICAL 14 REMOVE AND REPLACE ALL CRACKED OR
- SPALLED BRICK WITHIN THIS AREA WITH NEW. SEE GENERAL NOTE 1 FOR ALLOWANCE. 15 EXISTING MORTAR JOINS WITHIN AREA ARE
- CRACKED, LOOSE, MISSING, OPEN, OR GENERALLY DETERIORATED. REMOVE ALL
- IDENTIFIED MORTAR TO MINIMUM DEPTH OF 1' AND REPOINT WITH NEW MORTAR. SEE GENERAL NOTE 3 FOR ALLOWANCE. 16 OPEN CRACK IN STONE. INJECT THE CRACK FULL WITH EPOXY AND PATCH/FINISH THE EXTERIOR SURFACE OF THE STONE WITH A COLORED CEMENTITIOUS COMPOUND IN ORDER
- SURFACES OF THE EXISTING STONE. SEE GENERAL NOTE 5 FOR ALLOWANCE. 17 REMOVED EXISTING SEALANT AND BACKER ROD (IF PRESENT) BETWEEN WINDOW OR FRAME.

TO BLEND THE REPAIR INTO THE ADJACENT

- AND ADJACENT MASONRY. INSTALL NEW BACKER ROD AND SEALANT. 18 MASONRY CONTRACTOR SHALL OPEN AREAS INDICATED SIMILAR TO CONDITION [SEE DETAILS]. CONTRACTOR SHALL THEN PROVIDE ACCESS FOR ARCHITECT/ENGINEER TO REVIEW. ONCE REVIEW IS COMPLETE THEN CONTRACTOR SHALL INFILL WITH EXISTING KIND
- MATERIALS. 19 SALVAGE A MINIMUM OF THREE COURSES OF BRICK ABOVE TOP OF WINDOW TO EXPOSE EXISTING LINTEL. REMOVE EXISTING LINTEL AND FLASHING AND INSTALL NEW LINTEL AND THRU WALL FLASHING AND REPLACE BRICK. SEE
- GENERAL NOTE 1, 3,4 FOR ALLOWNACES. SEE DETAIL 1/A5.13. 2/A5.13. 1
- BRICK ABOVE HEADER TO EXPOSE EXISTING LINTEL. REMOVE EXISTING LINTEL AND FLASHING AND INSTALL NEW LINTEL AND THRU WALL FLASHING. REINSTALL HEADER AND
- BRICK. SEE GENERAL NOTE 1, 3, 4, FOR ALLOWANCES. SEE DETAIL 3/A5.13. 1

  21 SAW CUT BRICK, INSTALL A NEW 1/2" VERTICAL EXPANSION JOINT FREE OF MASONRY AND MORTAR FULL DEPTH. FILL JOINT WITH NEW BACKER ROD AND SEALANT. SEE DETAIL 4/A5.13. 22 EXISTING LIMESTONE COPING PIECE TO BE
- REMOVED AND SALVAGED FOR REINSTALLATION. ALL EXPOSED SURFACES SHALL BE CHEMICALLY CLEANED TO REMOVE DIRT AND STAINS. ALL EXISTING MORTAR AND FLASHING SHALL BE REMOVED FROM HEAD AND BED JOINT SURFACES. INSTALL NEW COPING FLASHING ALONG THE ENTIRE LENGTH OF REPLACED COPING. SEE DETA 7/A6.11.
- 23 HATCHING INDICATES AREA OF BRICK WALL TO BE SALVAGED IN ORDER TO REPAIR AND FLASH EMBEDDED STEEL CONDITIONS. 24 REMOVE EXISTING ABANDONED ANCHOR, INFILL
- CAVITY WITH MORTAR AND RESEAL. 25 RESEAL GAP WITH SILICONE AROUND EXISTING

26 INJECT CONCRETE CRACK FULL WITH EPOXY

- AND PATCH/FINISH THE EXTERIOR SURFACE WITH CEMENTITIOUS COMPOUND IN ORDER TO BLEND THE REPAIR INTO ADJACENT EXISTING SURFACE. SEE GENERAL NOTE 6 FOR ALLOWANCE.
- 27 CANOPY 28 CAST ALUMINUM LETTERING 18" HIGH CENTERED IN FACIA.
- 29 LIMESTONE BASE COURSE
- 30 MASONRY CONTROL JOINT

REINSTALLED.

31 LIMESTONE BASE COURSE 32 EXISTING LIMESTONE COPING. ALL EXPOSED SURFACES TO BE CHEMICALLY CLEANED TO REMOVE DIRT & STAINS. ALL MISALIGNED COPING TO BE REMOVED AND REINSTALLED TO MATCH EXISTING. ALL DETERIORATED MORTAR

JOINTS AND SEALANT TO BE CLEANED AND

1	ADDENDUM NO. 1	08/31/23
	ISSUED FOR BID	08/23/23
NO.	REVISION	DATE



WTA ARCHITECTS

WTAARCH.COM

100 S Jefferson Ave, Suite 601

Saginaw, Michigan 48607 989 752 8107 COPYRIGHT © 2023

PROJECT TITLE

RENOVATION AND ADDITION:


MIDLAND COUNTY ESA

MIDLAND, MICHIGAN


SHEET TITLE **EXTERIOR DETAILS** 

PROJECT NUMBER SHEET NUMBER 2022006.1 PROJECT DATE

AUGUST 23, 2023 CHECKED BY JMJ

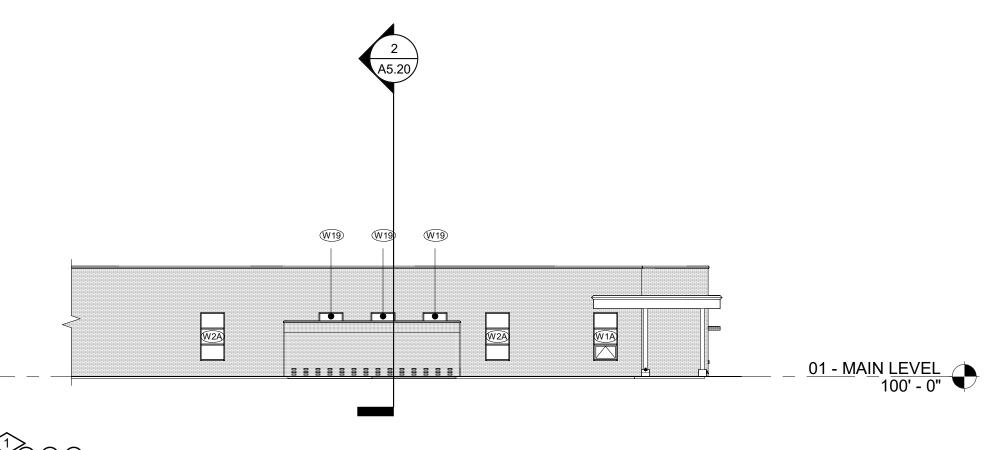



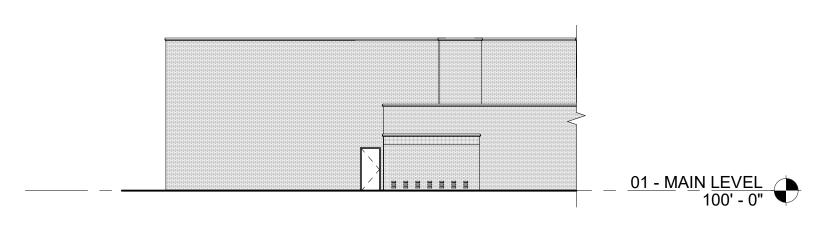

PARTIAL ELEVATION @ COURTYARD - NORTH

SCALE: 1/16" = 1'-0"

# MATERIAL KEYNOTES

1 CAST STONE PARAPHET CAP
2 1.5 BRICK PROTRUSION

- 3 FIXED SUNSCREEN SYSTEM MOUNTED TO VERTICAL MULLIONSBY WINDOW MFR. RE:
- ELVATIONS FOR SPECIFIC LOCATIONS
  4 1.5" BRICK PROTRUSION; SOLDIER COURSE
  5 CAST STONE SILL
- FOOTING AND FOUNDATION (SEE STRUCTURAL)
   CONCRETE SLAB (SEE STRUCTURAL)
   COMPACTED GRAINULAR FILL
- 9 DOOR (SEE SCHEDULE)
  10 GLASS AND GLAZING SYSTEM
- 10 GLASS AND GLAZING SYSTEM
  11 ALUMINUM FRAMING SYSTEM
  12 FIXTURE AS OCCUR; RE: ELECTRICAL
- 12 FIXTURE AS OCCUR; RE: ELECTRICAL
   14 REMOVE AND REPLACE ALL CRACKED OR SPALLED BRICK WITHIN THIS AREA WITH NEW.
- SEE GENERAL NOTE 1 FOR ALLOWANCE.

  15 EXISTING MORTAR JOINS WITHIN AREA ARE CRACKED, LOOSE, MISSING, OPEN, OR GENERALLY DETERIORATED. REMOVE ALL IDENTIFIED MORTAR TO MINIM IM DEPTH OF
- IDENTIFIED MORTAR TO MINIMUM DEPTH OF 1"
  AND REPOINT WITH NEW MORTAR. SEE
  GENERAL NOTE 3 FOR ALLOWANCE.

  16 OPEN CRACK IN STONE. INJECT THE CRACK
  FULL WITH EPOXY AND PATCH/FINISH THE
  EXTERIOR SURFACE OF THE STONE WITH A
- EXTERIOR SURFACE OF THE STONE WITH A COLORED CEMENTITIOUS COMPOUND IN ORDER TO BLEND THE REPAIR INTO THE ADJACENT SURFACES OF THE EXISTING STONE. SEE GENERAL NOTE 5 FOR ALLOWANCE.
- 17 REMOVED EXISTING SEALANT AND BACKER ROD
   (IF PRESENT) BETWEEN WINDOW OR FRAME,
   AND ADJACENT MASONRY. INSTALL NEW
   BACKER ROD AND SEALANT.
   18 MASONRY CONTRACTOR SHALL OPEN AREAS
- INDICATED SIMILAR TO CONDITION [SEE DETAILS]. CONTRACTOR SHALL THEN PROVIDE ACCESS FOR ARCHITECT/ENGINEER TO REVIEW. ONCE REVIEW IS COMPLETE THEN CONTRACTOR SHALL INFILL WITH EXISTING KIND MATERIALS.
- 19 SALVAGE A MINIMUM OF THREE COURSES OF BRICK ABOVE TOP OF WINDOW TO EXPOSE EXISTING LINTEL. REMOVE EXISTING LINTEL AND FLASHING AND INSTALL NEW LINTEL AND THRU WALL FLASHING AND REPLACE BRICK. SEE GENERAL NOTE 1, 3, 4 FOR ALLOWNACES. SEE
- DETAIL 1/A5.13. 2/A5.13.

  20 SALVAGE STONE HEADER AND ONE COURSE OF BRICK ABOVE HEADER TO EXPOSE EXISTING LINTEL. REMOVE EXISTING LINTEL AND FLASHING AND INSTALL NEW LINTEL AND THRU WALL FLASHING. REINSTALL HEADER AND BRICK. SEE GENERAL NOTE 1, 3, 4, FOR
- ALLOWANCES. SEE DETAIL 3/A5.13.

  21 SAW CUT BRICK, INSTALL A NEW 1/2" VERTICAL EXPANSION JOINT FREE OF MASONRY AND MORTAR FULL DEPTH. FILL JOINT WITH NEW BACKER ROD AND SEALANT. SEE DETAIL 4/A5.13.
- 22 EXISTING LIMESTONE COPING PIECE TO BE REMOVED AND SALVAGED FOR REINSTALLATION. ALL EXPOSED SURFACES SHALL BE CHEMICALLY CLEANED TO REMOVE DIRT AND STAINS. ALL EXISTING MORTAR AND FLASHING SHALL BE REMOVED FROM HEAD AND
- BED JOINT SURFACES. INSTALL NEW COPING FLASHING ALONG THE ENTIRE LENGTH OF REPLACED COPING. SEE DETAIL 7/A6.11.

  23 HATCHING INDICATES AREA OF BRICK WALL TO
- BE SALVAGED IN ORDER TO REPAIR AND FLASH EMBEDDED STEEL CONDITIONS.

  24 REMOVE EXISTING ABANDONED ANCHOR. INFILL
- CAVITY WITH MORTAR AND RESEAL.

  25 RESEAL GAP WITH SILICONE AROUND EXISTING
- PIPE.

  26 INJECT CONCRETE CRACK FULL WITH EPOXY
  AND PATCH/FINISH THE EXTERIOR SURFACE
  WITH CEMENTITIOUS COMPOUND IN ORDER TO
  BLEND THE REPAIR INTO ADJACENT EXISTING
- SURFACE. SEE GENERAL NOTE 6 FOR ALLOWANCE.

  27 CANOPY
- 28 CAST ALUMINUM LETTERING 18" HIGH CENTERED IN FACIA.
- 29 LIMESTONE BASE COURSE30 MASONRY CONTROL JOINT
- 30 MASONRY CONTROL JOINT
  31 LIMESTONE BASE COURSE
- T SURFACES TO BE CHÉMICALLY CLEANED TO REMOVE DIRT & STAINS. ALL MISALIGNED COPING TO BE REMOVED AND REINSTALLED TO MATCH EXISTING. ALL DETERIORATED MORTAR JOINTS AND SEALANT TO BE CLEANED AND REINSTALLED.

1 ADDENDUM NO. 1 08/31/23
ISSUED FOR BID 08/23/23
NO. REVISION DATE



WTAARCH.COM

WTA ARCHITECTS

100 S Jefferson Ave, Suite 601 Saginaw, Michigan 48607

989 752 8107 COPYRIGHT © 2023

PROJECT TITLE

RENOVATION AND ADDITION:

MIDLAND COUNTY ESA

MIDLAND, MICHIGAN

SHEET TITL

EXTERIOR ELEVATIONS

PROJECT NUMBER
2022006.1

PROJECT DATE


AUGUST 23, 2023


CHECKED BY

JMJ


A5.11

SHEET NUMBER

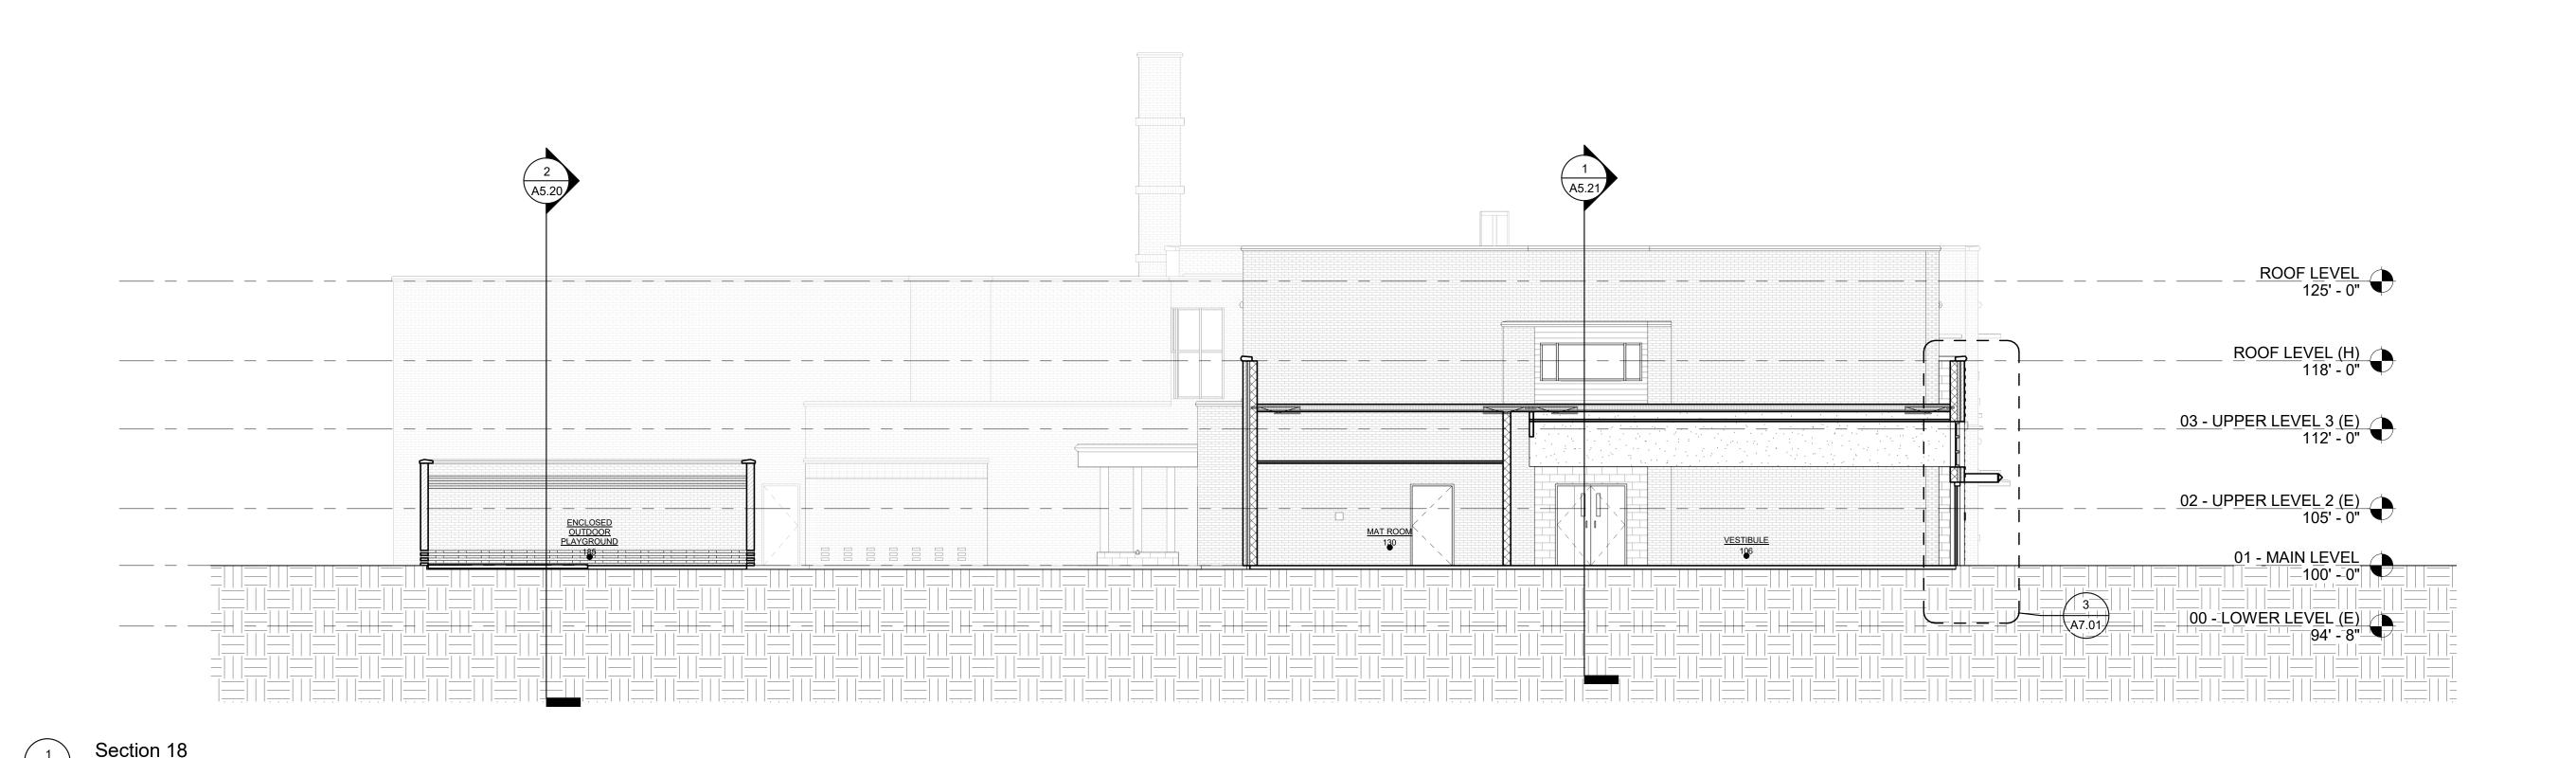

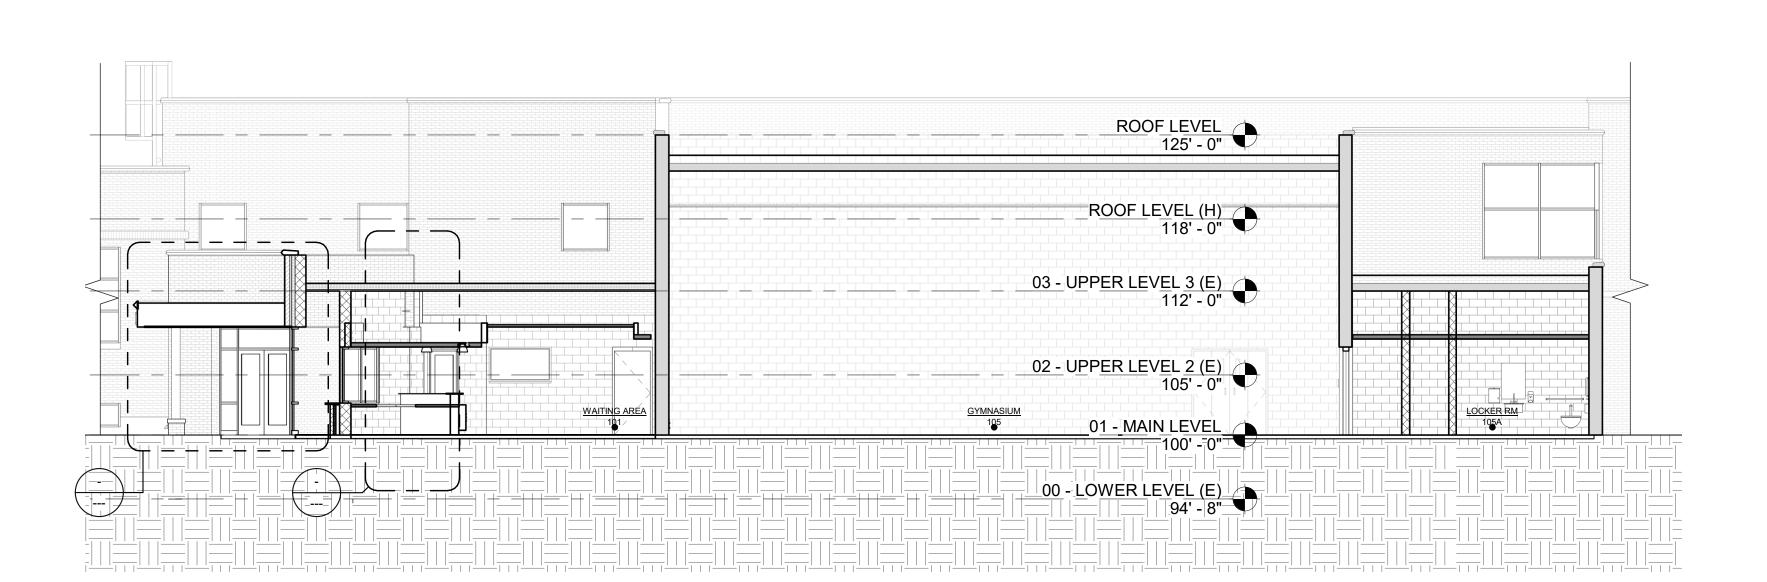

A5.20 SCALE: 1/8" = 1'-0"

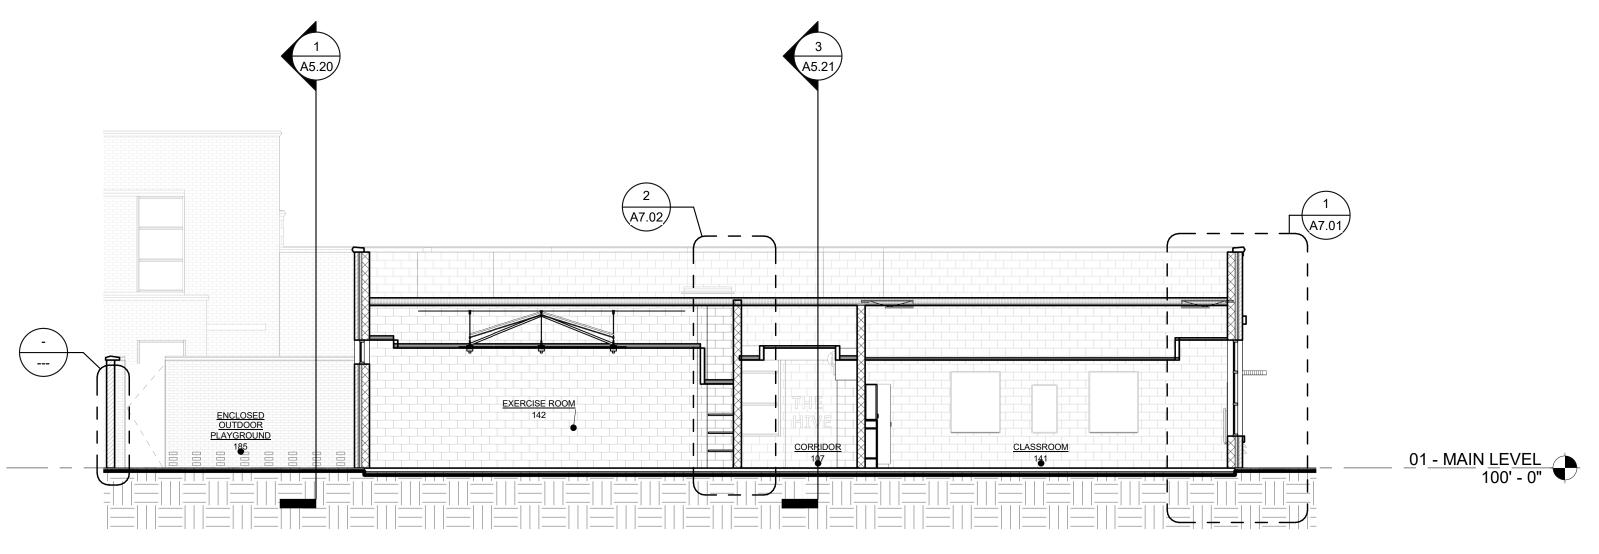





#### (#) MATERIAL KEYNOTES

 $\sqrt{1}$ 

1 CAST STONE PARAPHET CAP ~2~1.5"BRICKPROTRUSION~~

VERTICAL MULLIONSBY WINDOW MFR. RE: ELVATIONS FOR SPECIFIC LOCATIONS 4 1.5" BRICK PROTRUSION; SOLDIER COURSE

5 CAST STONE SILL

3 FIXED SUNSCREEN SYSTEM MOUNTED TO

6 FOOTING AND FOUNDATION (SEE STRUCTURAL) 7 CONCRETE SLAB (SEE STRUCTURAL)

8 COMPACTED GRAINULAR FILL 9 DOOR (SEE SCHEDULE) 10 GLASS AND GLAZING SYSTEM

11 ALUMINUM FRAMING SYSTEM 12 FIXTURE AS OCCUR; RE: ELECTRICAL 14 REMOVE AND REPLACE ALL CRACKED OR

SPALLED BRICK WITHIN THIS AREA WITH NEW. SEE GENERAL NOTE 1 FOR ALLOWANCE. 15 EXISTING MORTAR JOINS WITHIN AREA ARE CRACKED, LOOSE, MISSING, OPEN, OR GENERALLY DETERIORATED. REMOVE ALL

IDENTIFIED MORTAR TO MINIMUM DEPTH OF 1" AND REPOINT WITH NEW MORTAR. SEE GENERAL NOTE 3 FOR ALLOWANCE. 16 OPEN CRACK IN STONE. INJECT THE CRACK FULL WITH EPOXY AND PATCH/FINISH THE EXTERIOR SURFACE OF THE STONE WITH A

COLORED CEMENTITIOUS COMPOUND IN ORDER TO BLEND THE REPAIR INTO THE ADJACENT SURFACES OF THE EXISTING STONE. SEE GENERAL NOTE 5 FOR ALLOWANCE. 17 REMOVED EXISTING SEALANT AND BACKER ROD (IF PRESENT) BETWEEN WINDOW OR FRAME,

AND ADJACENT MASONRY. INSTALL NEW

BACKER ROD AND SEALANT. 18 MASONRY CONTRACTOR SHALL OPEN AREAS INDICATED SIMILAR TO CONDITION [SEE DETAILS]. CONTRACTOR SHALL THEN PROVIDE ACCESS FOR ARCHITECT/ENGINEER TO REVIEW. ONCE REVIEW IS COMPLETE THEN CONTRACTOR SHALL INFILL WITH EXISTING KIND

MATERIALS. 19 SALVAGE A MINIMUM OF THREE COURSES OF BRICK ABOVE TOP OF WINDOW TO EXPOSE EXISTING LINTEL. REMOVE EXISTING LINTEL AND FLASHING AND INSTALL NEW LINTEL AND THRU WALL FLASHING AND REPLACE BRICK. SEE GENERAL NOTE 1, 3, 4 FOR ALLOWNACES. SEE

DETAIL 1/A5.13. 2/A5.13. 20 SALVAGE STONE HEADER AND ONE COURSE OF BRICK ABOVE HEADER TO EXPOSE EXISTING LINTEL. REMOVE EXISTING LINTEL AND FLASHING AND INSTALL NEW LINTEL AND THRU WALL FLASHING. REINSTALL HEADER AND BRICK. SEE GENERAL NOTE 1, 3, 4, FOR ALLOWANCES. SEE DETAIL 3/A5.13.

21 SAW CUT BRICK, INSTALL A NEW 1/2" VERTICAL EXPANSION JOINT FREE OF MASONRY AND MORTAR FULL DEPTH. FILL JOINT WITH NEW BACKER ROD AND SEALANT. SEE DETAIL 4/A5.13.

22 EXISTING LIMESTONE COPING PIECE TO BE REMOVED AND SALVAGED FOR REINSTALLATION. ALL EXPOSED SURFACES SHALL BE CHEMICALLY CLEANED TO REMOVE DIRT AND STAINS. ALL EXISTING MORTAR AND FLASHING SHALL BE REMOVED FROM HEAD AND BED JOINT SURFACES. INSTALL NEW COPING

FLASHING ALONG THE ENTIRE LENGTH OF REPLACED COPING. SEE DETAIL 7/A6.11. 23 HATCHING INDICATES AREA OF BRICK WALL TO BE SALVAGED IN ORDER TO REPAIR AND FLASH

24 REMOVE EXISTING ABANDONED ANCHOR. INFILL CAVITY WITH MORTAR AND RESEAL.

25 RESEAL GAP WITH SILICONE AROUND EXISTING 26 INJECT CONCRETE CRACK FULL WITH EPOXY AND PATCH/FINISH THE EXTERIOR SURFACE WITH CEMENTITIOUS COMPOUND IN ORDER TO BLEND THE REPAIR INTO ADJACENT EXISTING

ALLOWANCE. 27 CANOPY

SURFACE. SEE GENERAL NOTE 6 FOR

28 CAST ALUMINUM LETTERING 18" HIGH CENTERED IN FACIA.

REINSTALLED.

29 LIMESTONE BASE COURSE 30 MASONRY CONTROL JOINT

31 LIMESTONE BASE COURSE 32 EXISTING LINESTONE COPING: ALL EXPOSED SURFACES TO BE CHEMICALLY CLEANED TO REMOVE DIRT & STAINS. ALL MISALIGNED COPING TO BE REMOVED AND REINSTALLED TO MATCH EXISTING. ALL DETERIORATED MORTAR JOINTS AND SEALANT TO BE CLEANED AND

ADDENDUM NO. 1 ISSUED FOR BID 08/23/23 REVISION DATE



WTAARCH.COM

**WTA** ARCHITECTS

100 S Jefferson Ave, Suite 601 Saginaw, Michigan 48607 989 752 8107

COPYRIGHT © 2023

PROJECT TITLE

RENOVATION AND ADDITION:


MIDLAND COUNTY ESA


MIDLAND, MICHIGAN


JMJ

**BUILDING SECTIONS** 

SHEET NUMBER PROJECT NUMBER 2022006.1 PROJECT DATE A5.20 AUGUST 23, 2023 CHECKED BY

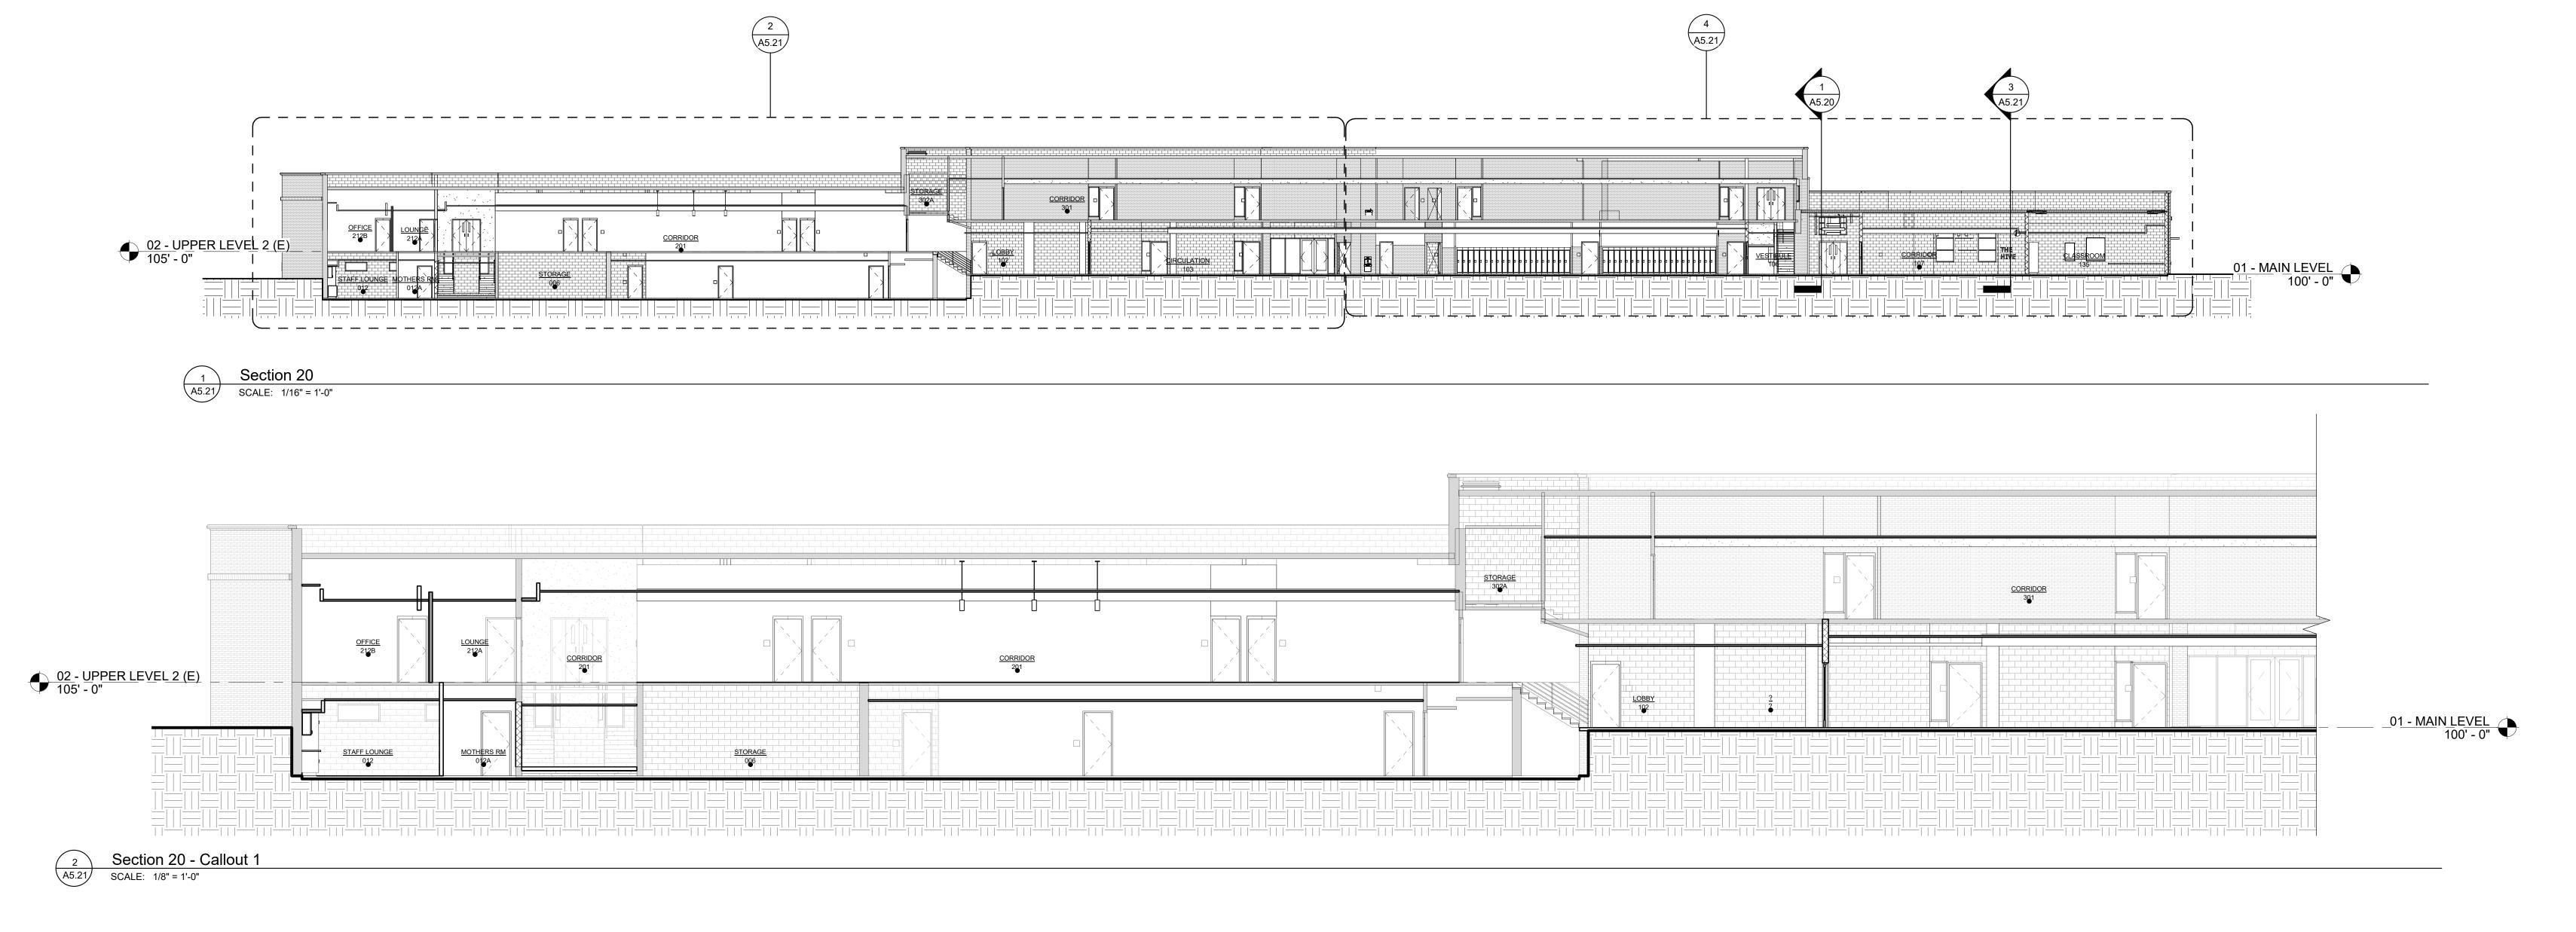

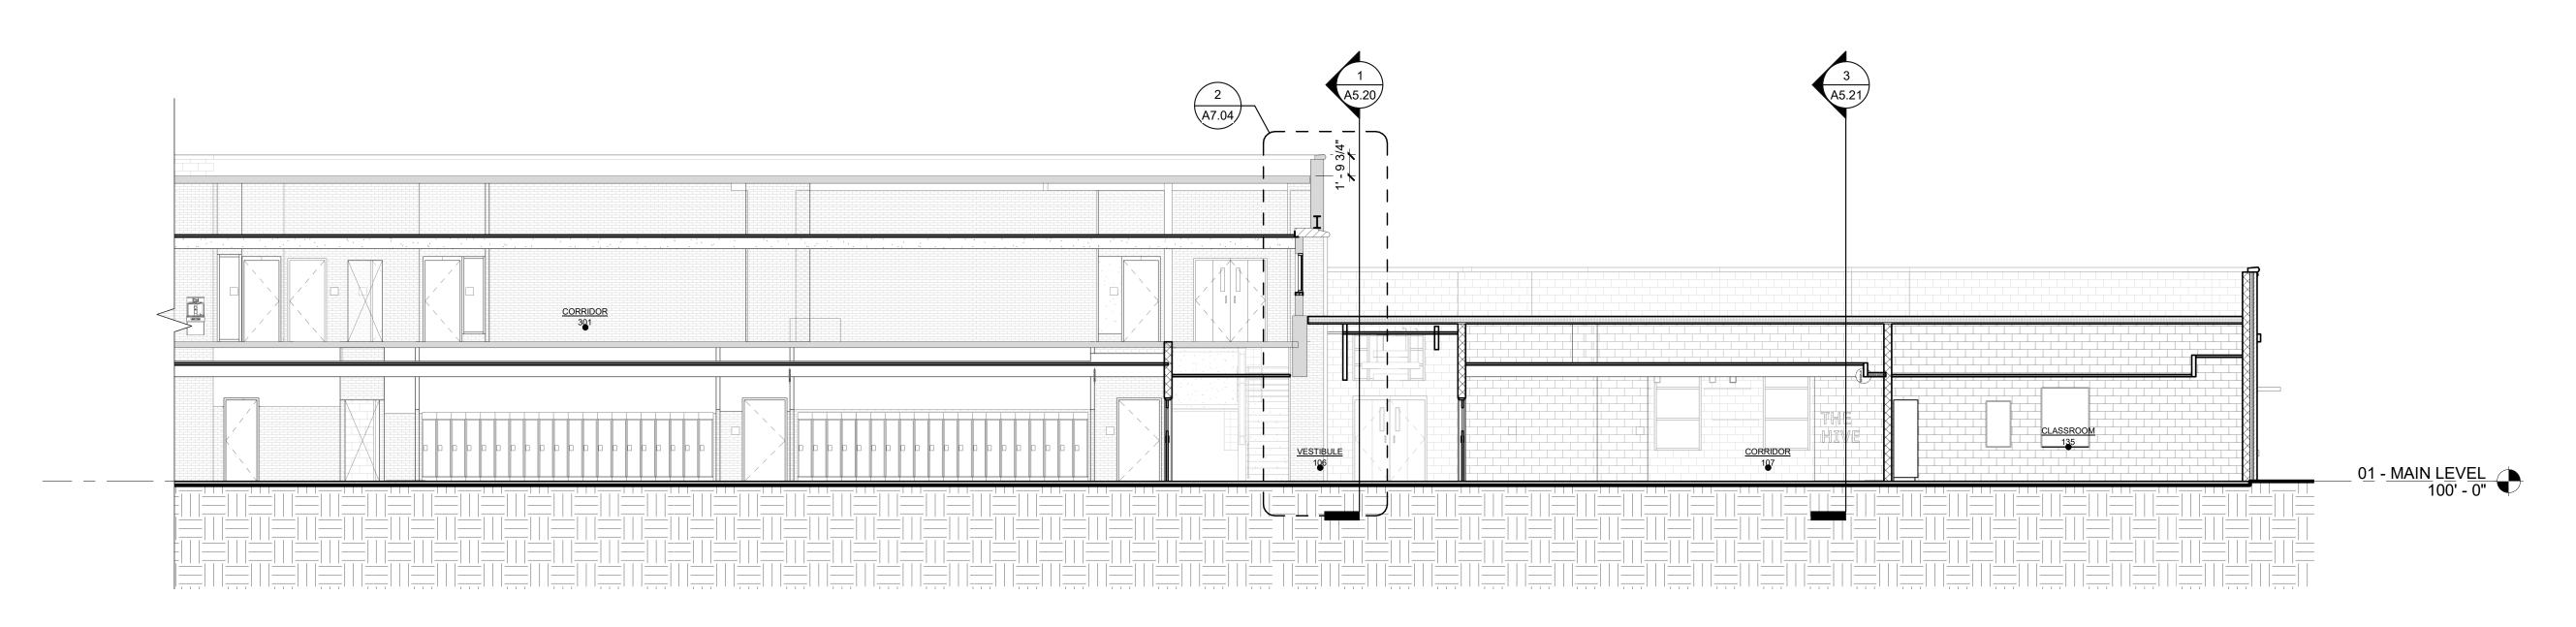

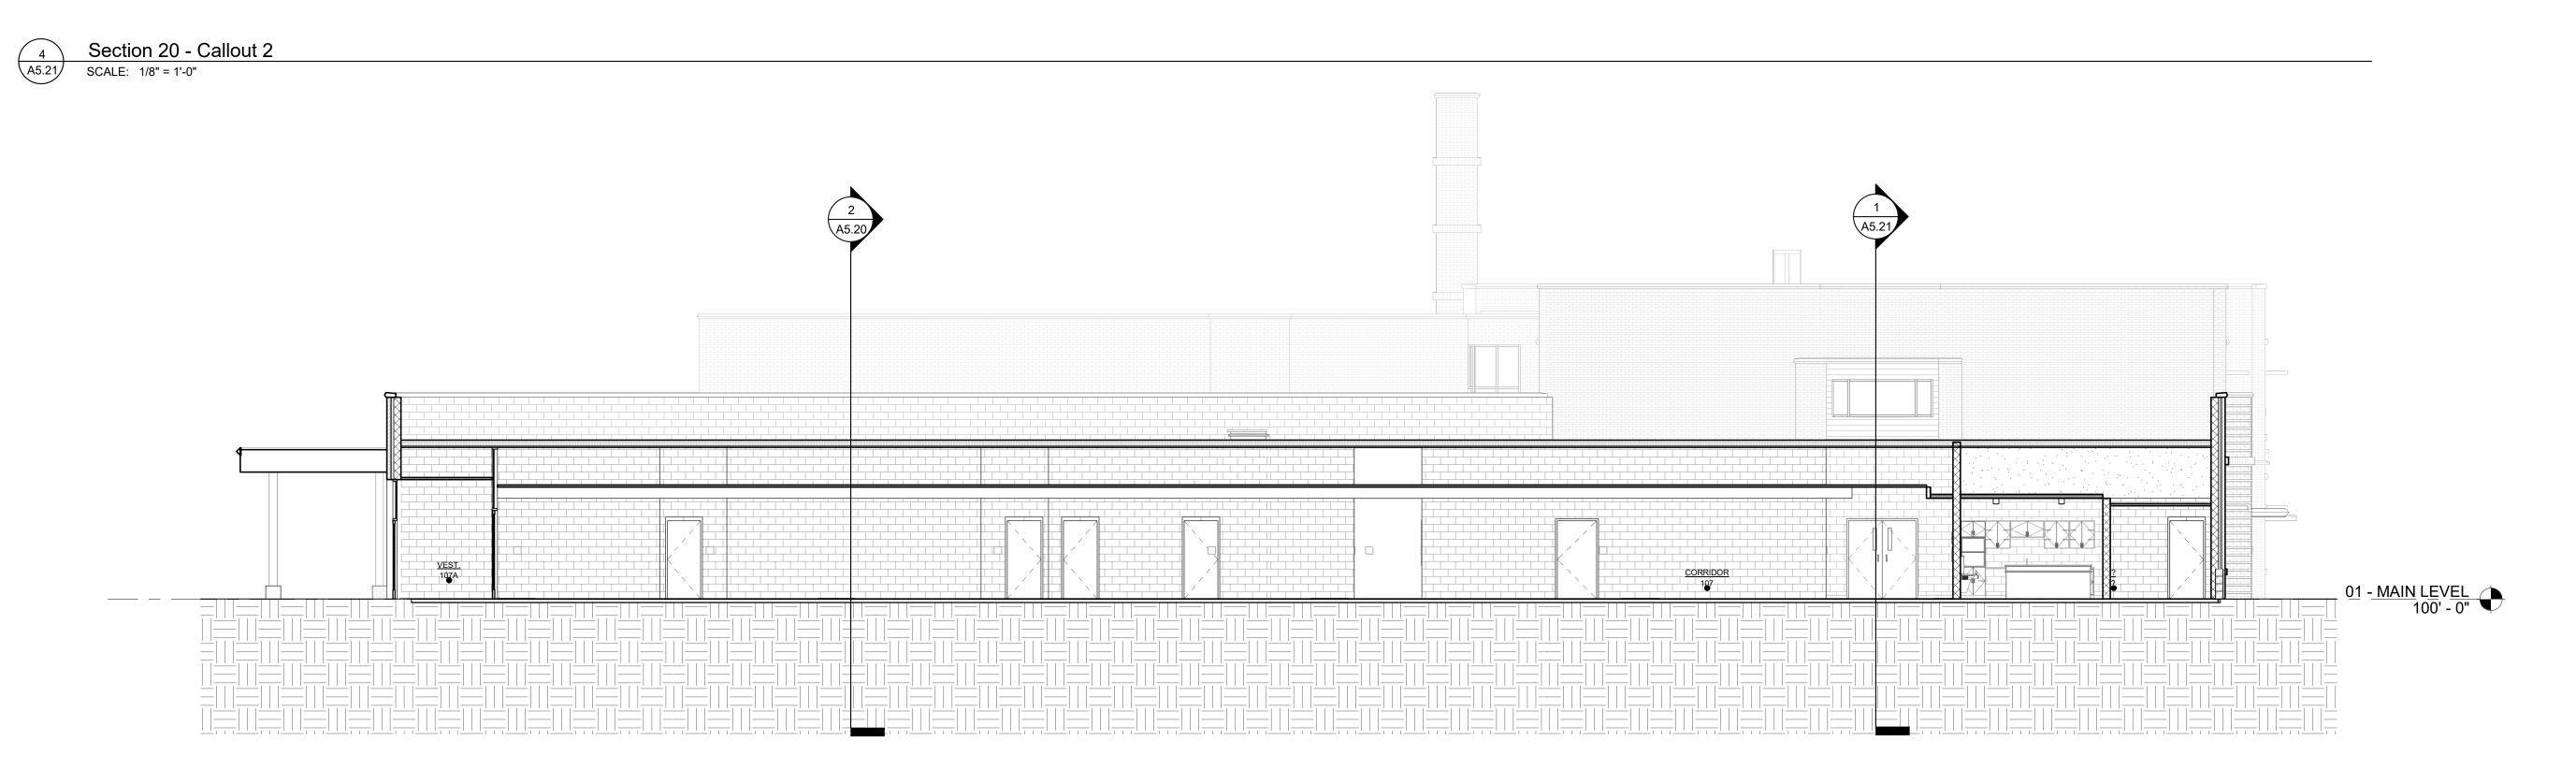



# MATERIAL KEYNOTES

1 CAST STONE PARAPHET CAP
2 1.5 BRICK PROTRUSION 1

- FIXED SUNSCREEN SYSTEM MOUNTED TO VERTICAL MULLIONSBY WINDOW MFR. RE: ELVATIONS FOR SPECIFIC LOCATIONS
   1.5" BRICK PROTRUSION; SOLDIER COURSE
   CAST STONE SILL
- 4 1.5" BRICK PROTRUSION; SOLDIER COURSE
   5 CAST STONE SILL
   6 FOOTING AND FOUNDATION (SEE STRUCTURAL)
   7 CONCRETE SLAB (SEE STRUCTURAL)
- 8 COMPACTED GRAINULAR FILL
  9 DOOR (SEE SCHEDULE)
- 10 GLASS AND GLAZING SYSTEM
  11 ALUMINUM FRAMING SYSTEM
  12 FIXTURE AS OCCUR: BE: ELECTRIC
- 12 FIXTURE AS OCCUR; RE: ELECTRICAL
   14 REMOVE AND REPLACE ALL CRACKED OR SPALLED BRICK WITHIN THIS AREA WITH NEW.
- SEE GENERAL NOTE 1 FOR ALLOWANCE.

  15 EXISTING MORTAR JOINS WITHIN AREA ARE CRACKED, LOOSE, MISSING, OPEN, OR GENERALLY DETERIORATED. REMOVE ALL IDENTIFIED MORTAR TO MINIMUM DEPTH OF
- GENERALLY DETERIORATED. REMOVE ALL IDENTIFIED MORTAR TO MINIMUM DEPTH OF 1" AND REPOINT WITH NEW MORTAR. SEE GENERAL NOTE 3 FOR ALLOWANCE.

  16 OPEN CRACK IN STONE. INJECT THE CRACK
- FULL WITH EPOXY AND PATCH/FINISH THE EXTERIOR SURFACE OF THE STONE WITH A COLORED CEMENTITIOUS COMPOUND IN ORDER TO BLEND THE REPAIR INTO THE ADJACENT SURFACES OF THE EXISTING STONE. SEE GENERAL NOTE 5 FOR ALLOWANCE.
- 17 REMOVED EXISTING SEALANT AND BACKER ROD (IF PRESENT) BETWEEN WINDOW OR FRAME, AND ADJACENT MASONRY. INSTALL NEW BACKER ROD AND SEALANT.
- 18 MASONRY CONTRACTOR SHALL OPEN AREAS INDICATED SIMILAR TO CONDITION [SEE DETAILS]. CONTRACTOR SHALL THEN PROVIDE ACCESS FOR ARCHITECT/ENGINEER TO REVIEW. ONCE REVIEW IS COMPLETE THEN CONTRACTOR SHALL INFILL WITH EXISTING KIND
- MATERIALS.

  19 SALVAGE A MINIMUM OF THREE COURSES OF BRICK ABOVE TOP OF WINDOW TO EXPOSE EXISTING LINTEL AND FLASHING AND INSTALL NEW LINTEL AND THRU
- WALL FLASHING AND INSTALL NEW LINTEL AND THRU
  WALL FLASHING AND REPLACE BRICK. SEE
  GENERAL NOTE 1, 3, 4 FOR ALLOWNACES. SEE
  DETAIL 1/A5.13. 2/A5.13. 1

  20 SALVAGE STONE HEADER AND ONE COURSE OF
  BRICK ABOVE HEADER TO EXPOSE EXISTING
- BRICK ABOVE HEADER TO EXPOSE EXISTING LINTEL. REMOVE EXISTING LINTEL AND FLASHING AND INSTALL NEW LINTEL AND THRU WALL FLASHING. REINSTALL HEADER AND BRICK. SEE GENERAL NOTE 1, 3, 4, FOR ALLOWANCES. SEE DETAIL 3/A5.13.
- 21 SAW CUT BRICK, INSTALL A NEW 1/2" VERTICAL EXPANSION JOINT FREE OF MASONRY AND MORTAR FULL DEPTH. FILL JOINT WITH NEW BACKER ROD AND SEALANT. SEE DETAIL 4/A5.13.
- 22 EXISTING LIMESTONE COPING PIECE TO BE 1
  REMOVED AND SALVAGED FOR
  REINSTALLATION. ALL EXPOSED SURFACES
  SHALL BE CHEMICALLY CLEANED TO REMOVE
  DIRT AND STAINS. ALL EXISTING MORTAR AND
  FLASHING SHALL BE REMOVED FROM HEAD AND
- BED JOINT SURFACES. INSTALL NEW COPING FLASHING ALONG THE ENTIRE LENGTH OF REPLACED COPING. SEE DETAIL 7/A6.11.
- BE SALVAGED IN ORDER TO REPAIR AND FLASH EMBEDDED STEEL CONDITIONS.
- 24 REMOVE EXISTING ABANDONED ANCHOR. INFILL CAVITY WITH MORTAR AND RESEAL.

  25 RESEAL CAR WITH SILICONE ABOUND EXISTING
- 25 RESEAL GAP WITH SILICONE AROUND EXISTING PIPE.
   26 INJECT CONCRETE CRACK FULL WITH EPOXY AND PATCH/FINISH THE EXTERIOR SURFACE
  - WITH CEMENTITIOUS COMPOUND IN ORDER TO BLEND THE REPAIR INTO ADJACENT EXISTING SURFACE. SEE GENERAL NOTE 6 FOR ALLOWANCE.
- 27 CANOPY28 CAST ALUMINUM LETTERING 18" HIGH CENTERED IN FACIA.
- 29 LIMESTONE BASE COURSE30 MASONRY CONTROL JOINT
- 31 LIMESTONE BASE COURSE

  22 EXISTING LIMESTONE COPING: ALL EXPOSED

  SURFACES TO BE CHEMICALLY CLEANED TO

  REMOVE DIRT & STAINS ALL MISALIGNED
- SURFACES TO BE CHEMICALLY CLEANED TO REMOVE DIRT & STAINS. ALL MISALIGNED COPING TO BE REMOVED AND REINSTALLED TO MATCH EXISTING. ALL DETERIORATED MORTAR JOINTS AND SEALANT TO BE CLEANED AND REINSTALLED.

1	ADDENDUM NO. 1	08/31/23
	ISSUED FOR BID	08/23/23
NO.	REVISION	DATE



WTAARCH.COM

**WTA** ARCHITECTS

100 S Jefferson Ave, Suite 601 Saginaw, Michigan 48607

989 752 8107 COPYRIGHT © 2023

PROJECT TITLE

RENOVATION AND ADDITION:

MIDLAND COUNTY ESA

MIDLAND, MICHIGAN

BUILDING SECTIONS

PROJECT NUMBER
2022006.1


PROJECT DATE
AUGUST 23, 2023

A 5 2

AUGUST 23, 2023

CHECKED BY

JMJ

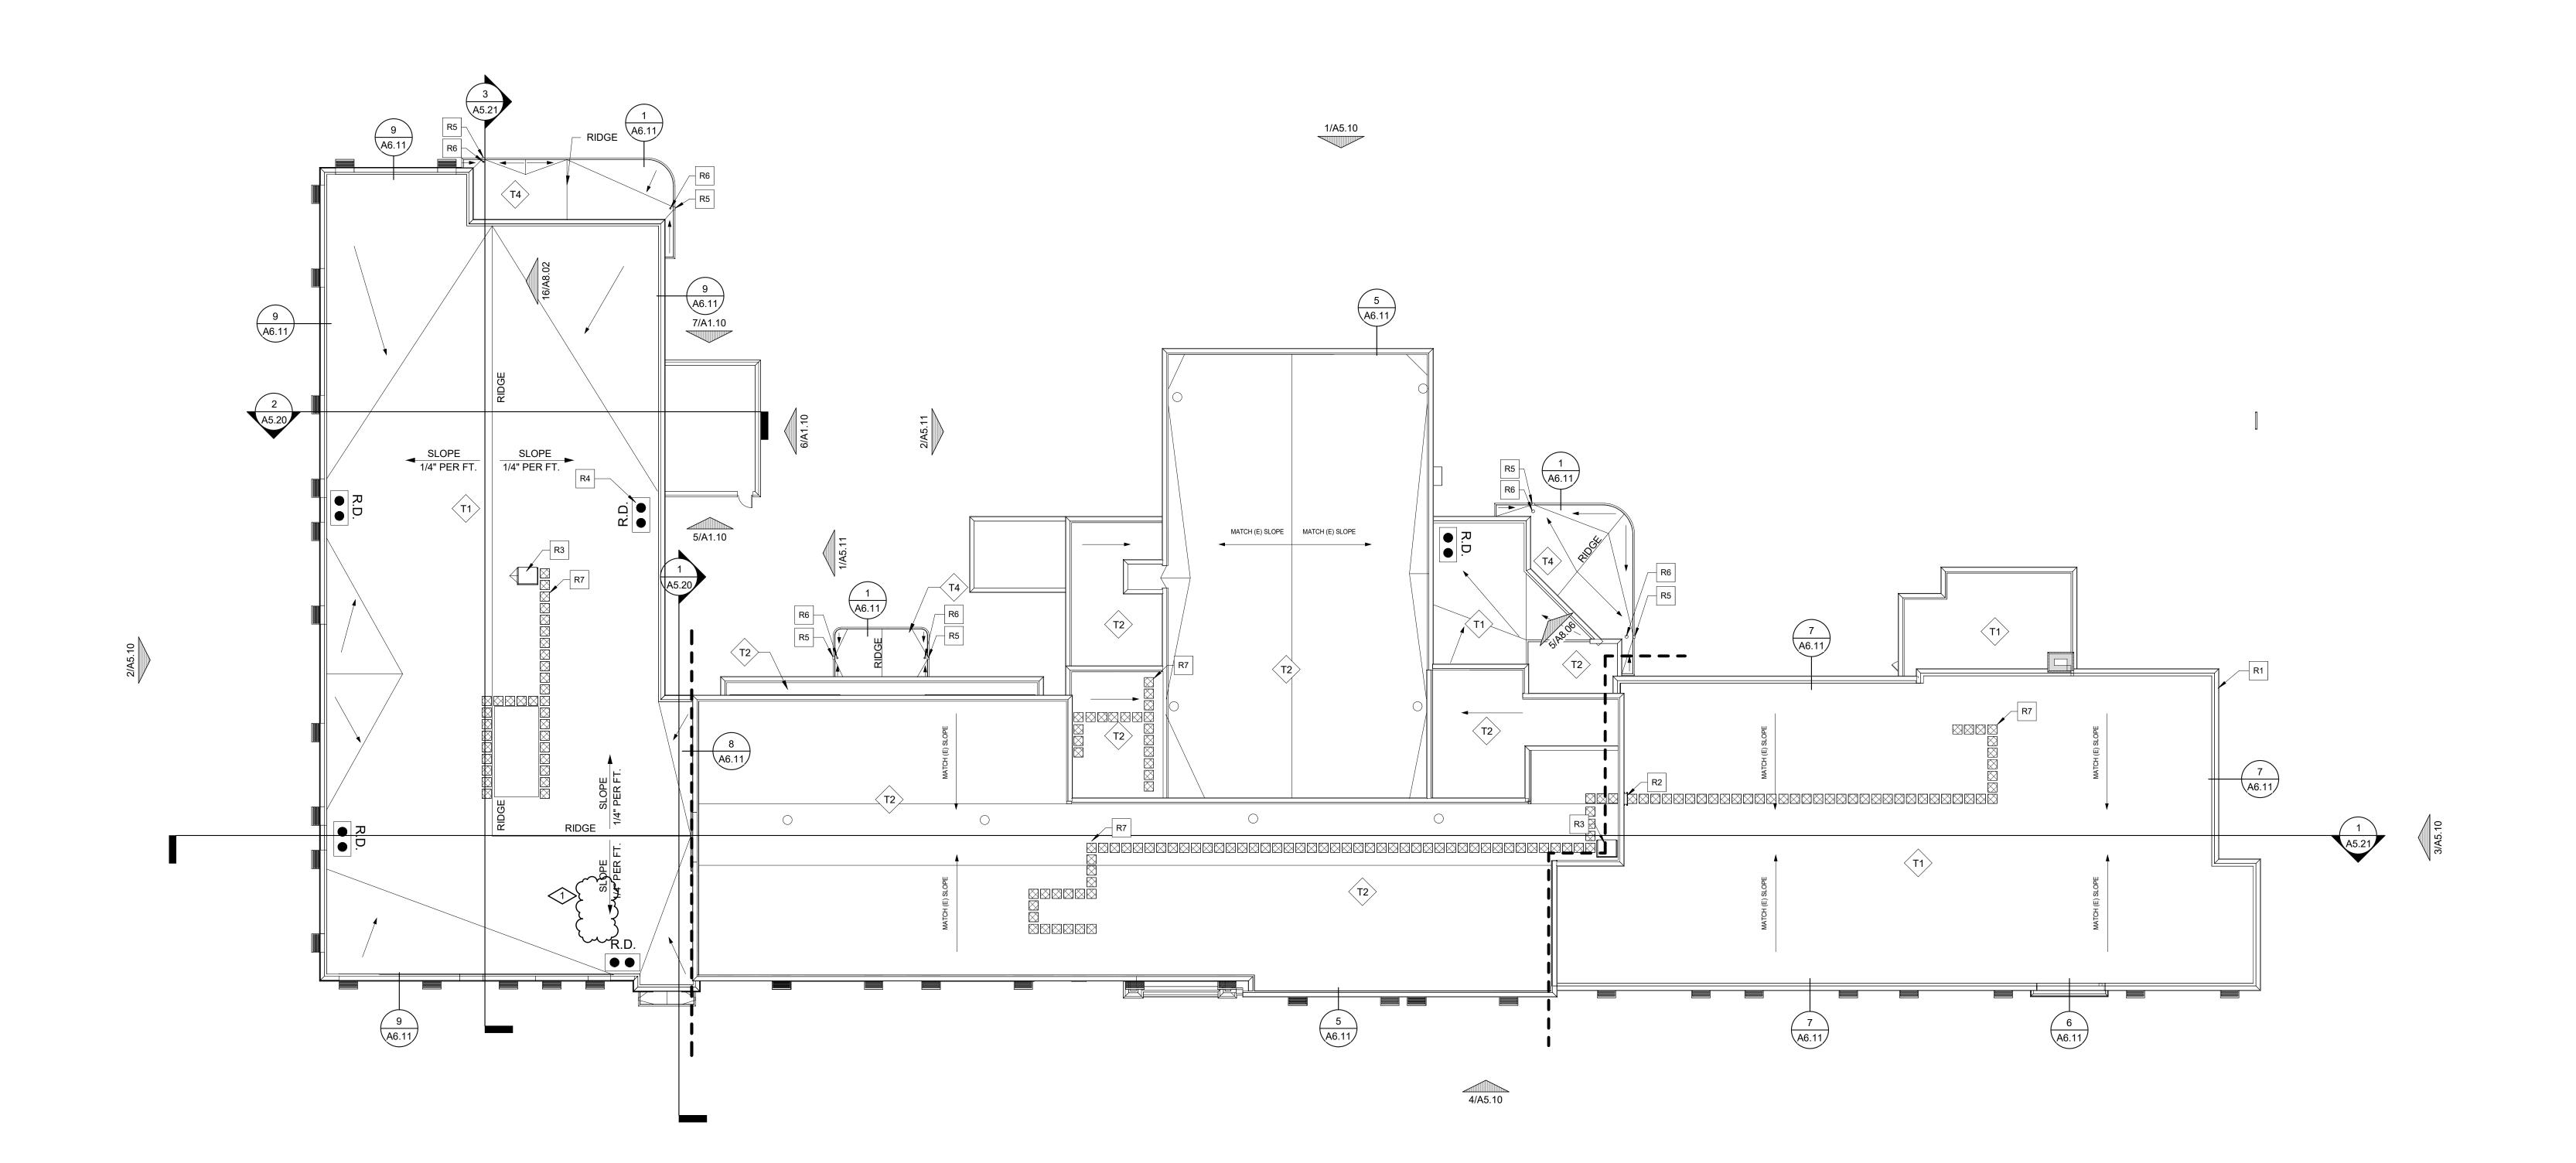




#### GENERAL ROOF PLAN NOTES:

- PROVIDE ROOFING MANUFACTURER'S STANDARD FLASHING DETAILS FOR ALL ROOF PENETRATIONS. COORDINATE WITH ALL TRADES REFER TO MECHANICAL AND PLUMBING PLANS FOR
- LOCATIONS AND EXTENTS OF EXPOSED PIPING ON 3. REFER TO PLUMBING, MECHANICAL, AND ELECTRICAL DRAWINGS FOR MOUNTED EQUIPMENT AND PENETRATIONS. ALL EQUIPMENT
- PENETRATIONS MAY NOT BE SHOWN ON THIS ROOF PLAN.

  4. MAINTAIN ALL ROOF DRAINS CLEAN AND FREE-FLOWING DURING AND UPON COMPLETION OF CONSTRUCTION.

#### .R# ROOF PLAN KEYNOTE

- 1 REPAIR EXISTING STONE PARAPHET AS REQUIRED; RE-SEAL ALL JOINTS AS NEEDED
- 2 NEW HIGH ROOF ACCESS LADDER; MATCH EXISTING LOCATION
- 3 ROOF HATCH 4 ROOF DRAIN
- 5 OVERFLOW SCUPPER 6 CANOPY ROOF DRAIN ROUTE PER DETAIL 8/A6.10
- 7 ROOF WALKWAY PADS

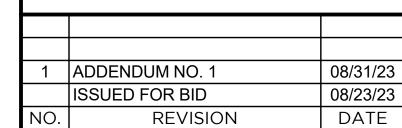



WTAARCH.COM

### WTA ARCHITECTS

100 S Jefferson Ave, Suite 601 Saginaw, Michigan 48607 989 752 8107

COPYRIGHT © 2023

PROJECT TITLE


RENOVATION AND ADDITION: MIDLAND COUNTY ESA

MIDLAND, MICHIGAN SHEET TITLE


**ROOF PLAN** 


PROJECT NUMBER 2022006.1 SHEET NUMBER PROJECT DATE


A6.01 AUGUST 23, 2023 CHECKED BY JMJ

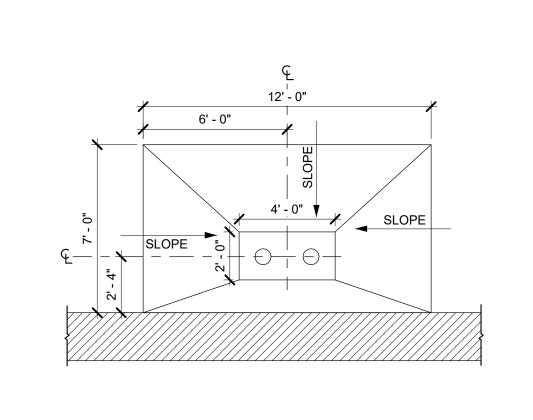




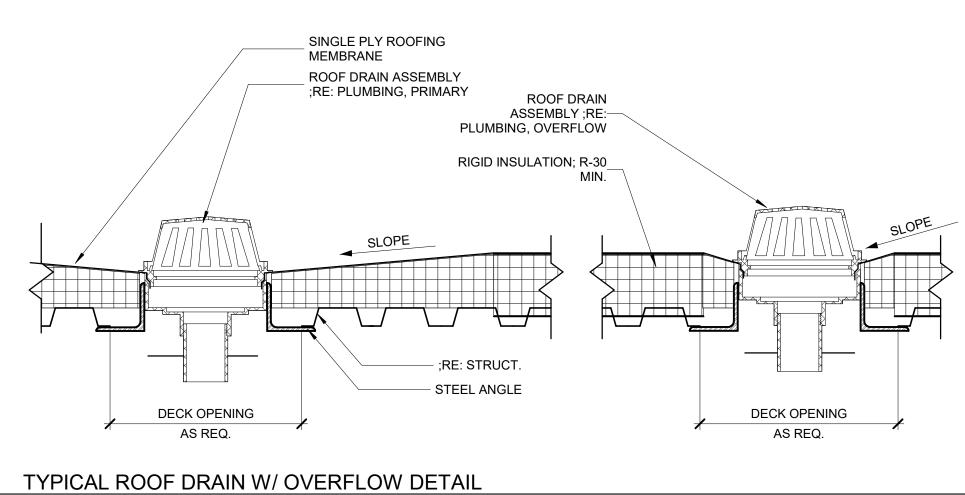


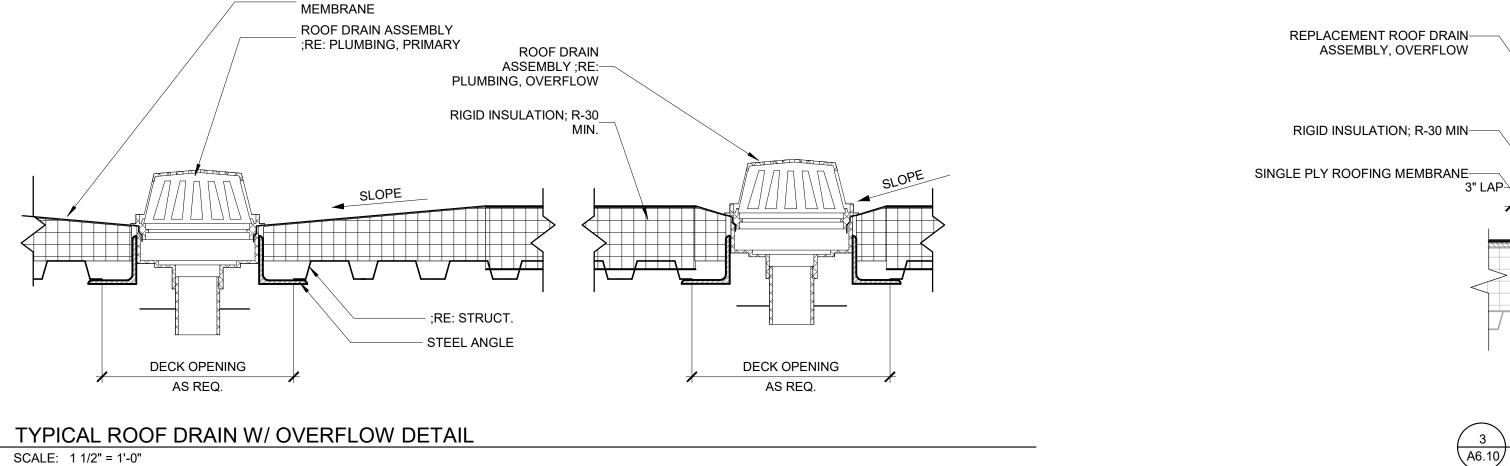


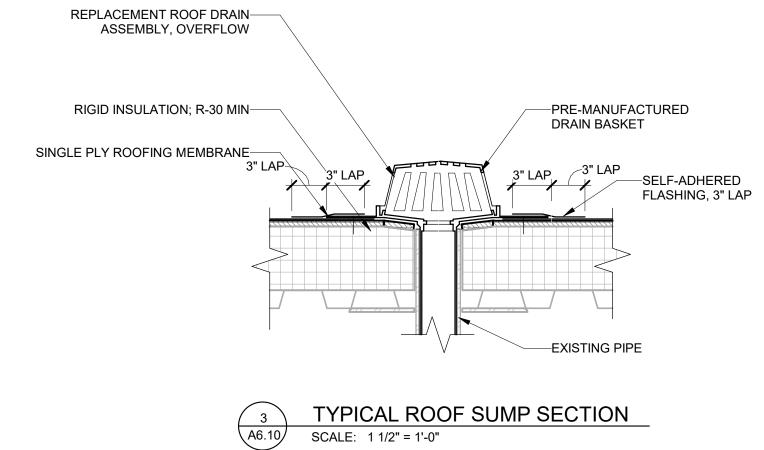





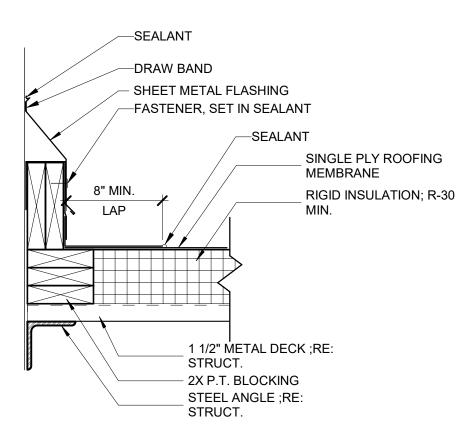


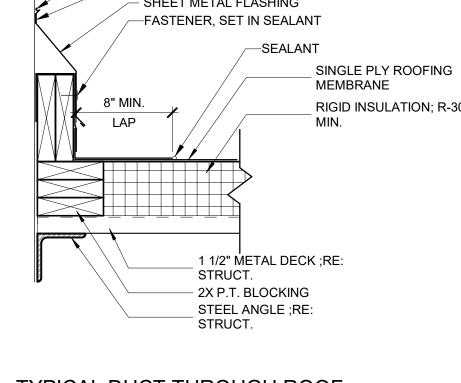


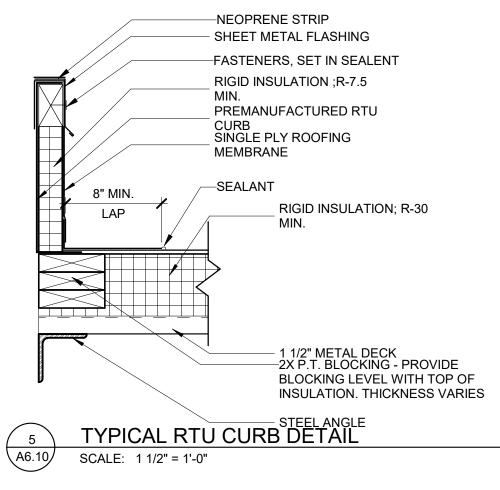

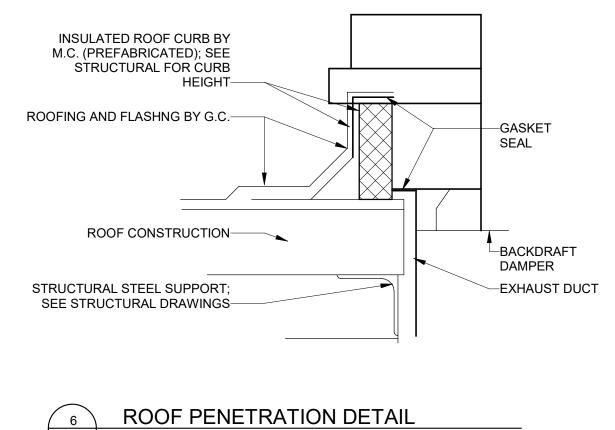


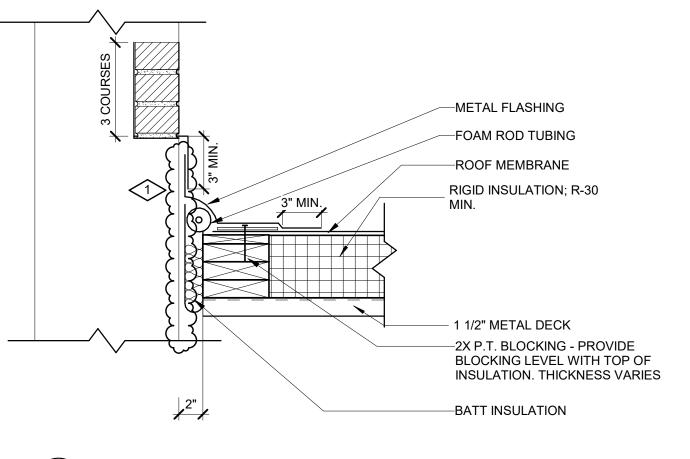


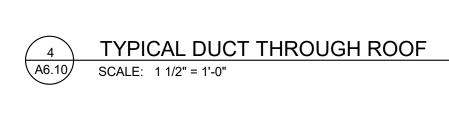


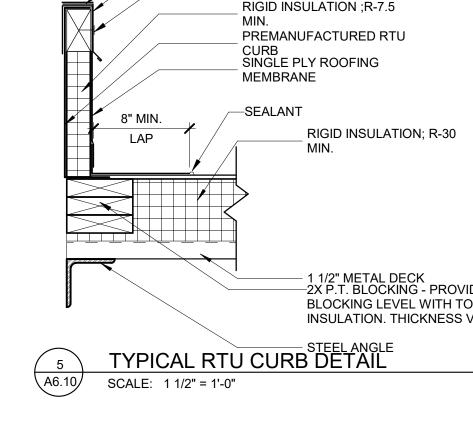




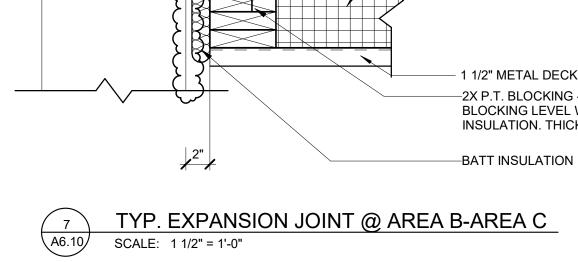

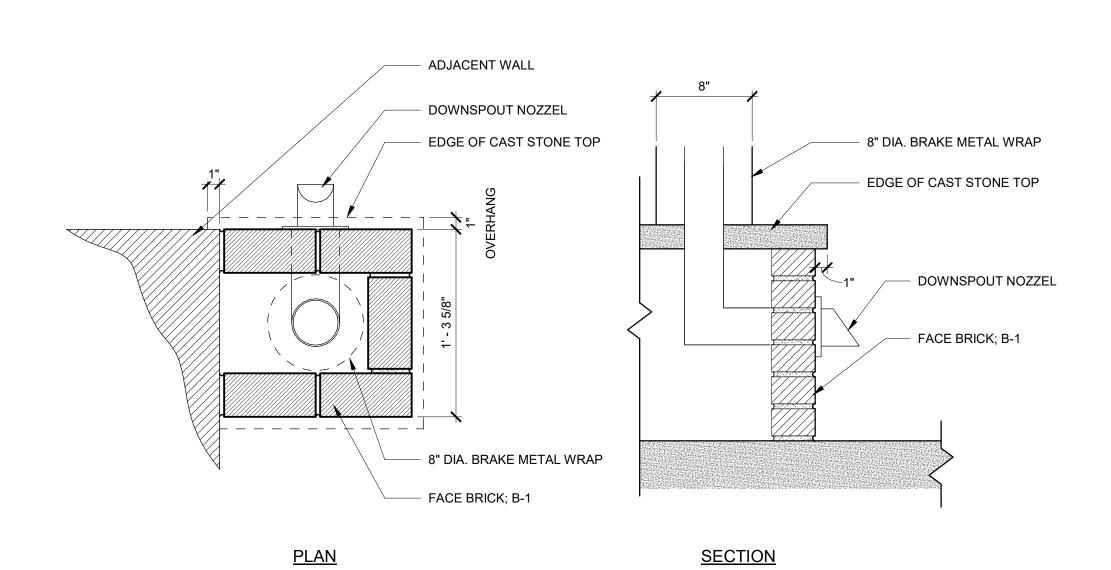

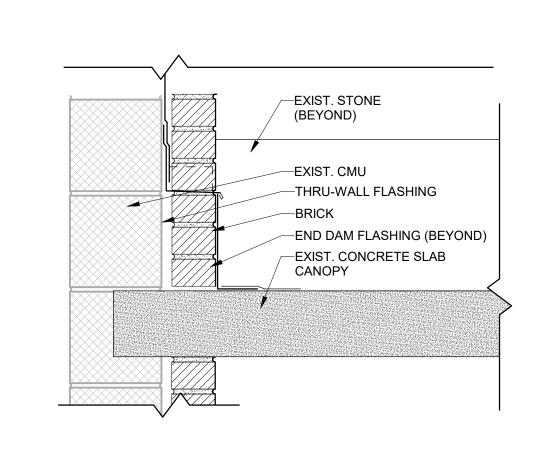

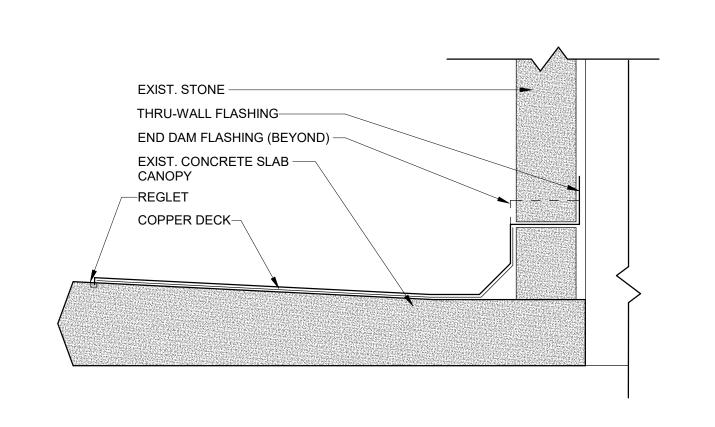





STONE CANOPY DETAIL @ MAIN ENTRANCE SUGNET 10 STONE CANO A6.10 SCALE: 1 1/2" = 1'-0"

1	ADDENDUM NO. 1	08/31/23
	ISSUED FOR BID	08/23/23
NO.	REVISION	DATE

WTAARCH.COM

**WTA** ARCHITECTS

100 S Jefferson Ave, Suite 601

Saginaw, Michigan 48607 989 752 8107 COPYRIGHT © 2023

PROJECT TITLE


RENOVATION AND ADDITION: MIDLAND COUNTY ESA


MIDLAND, MICHIGAN

SHEET TITLE ROOF DETAILS

SHEET NUMBER PROJECT NUMBER 2022006.1 PROJECT DATE

A6.10 AUGUST 23, 2023 CHECKED BY JMJ

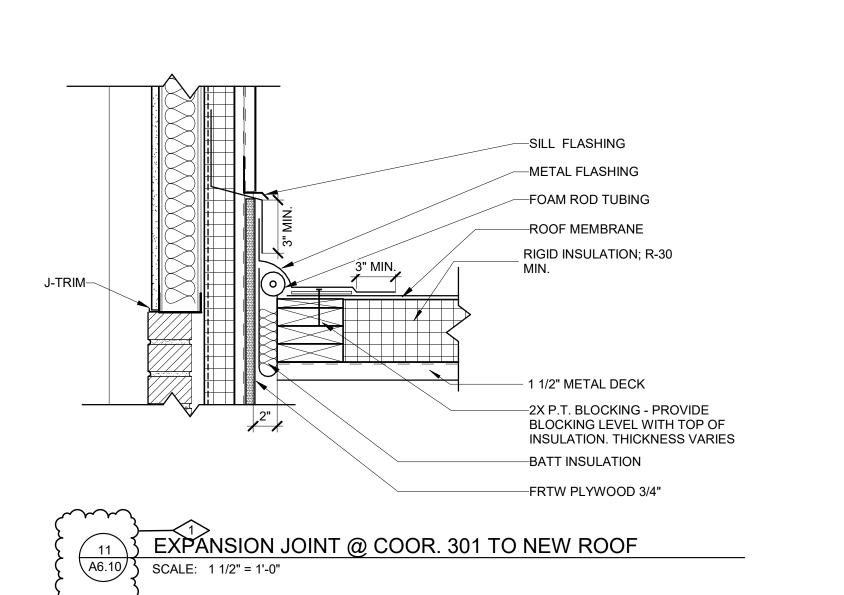

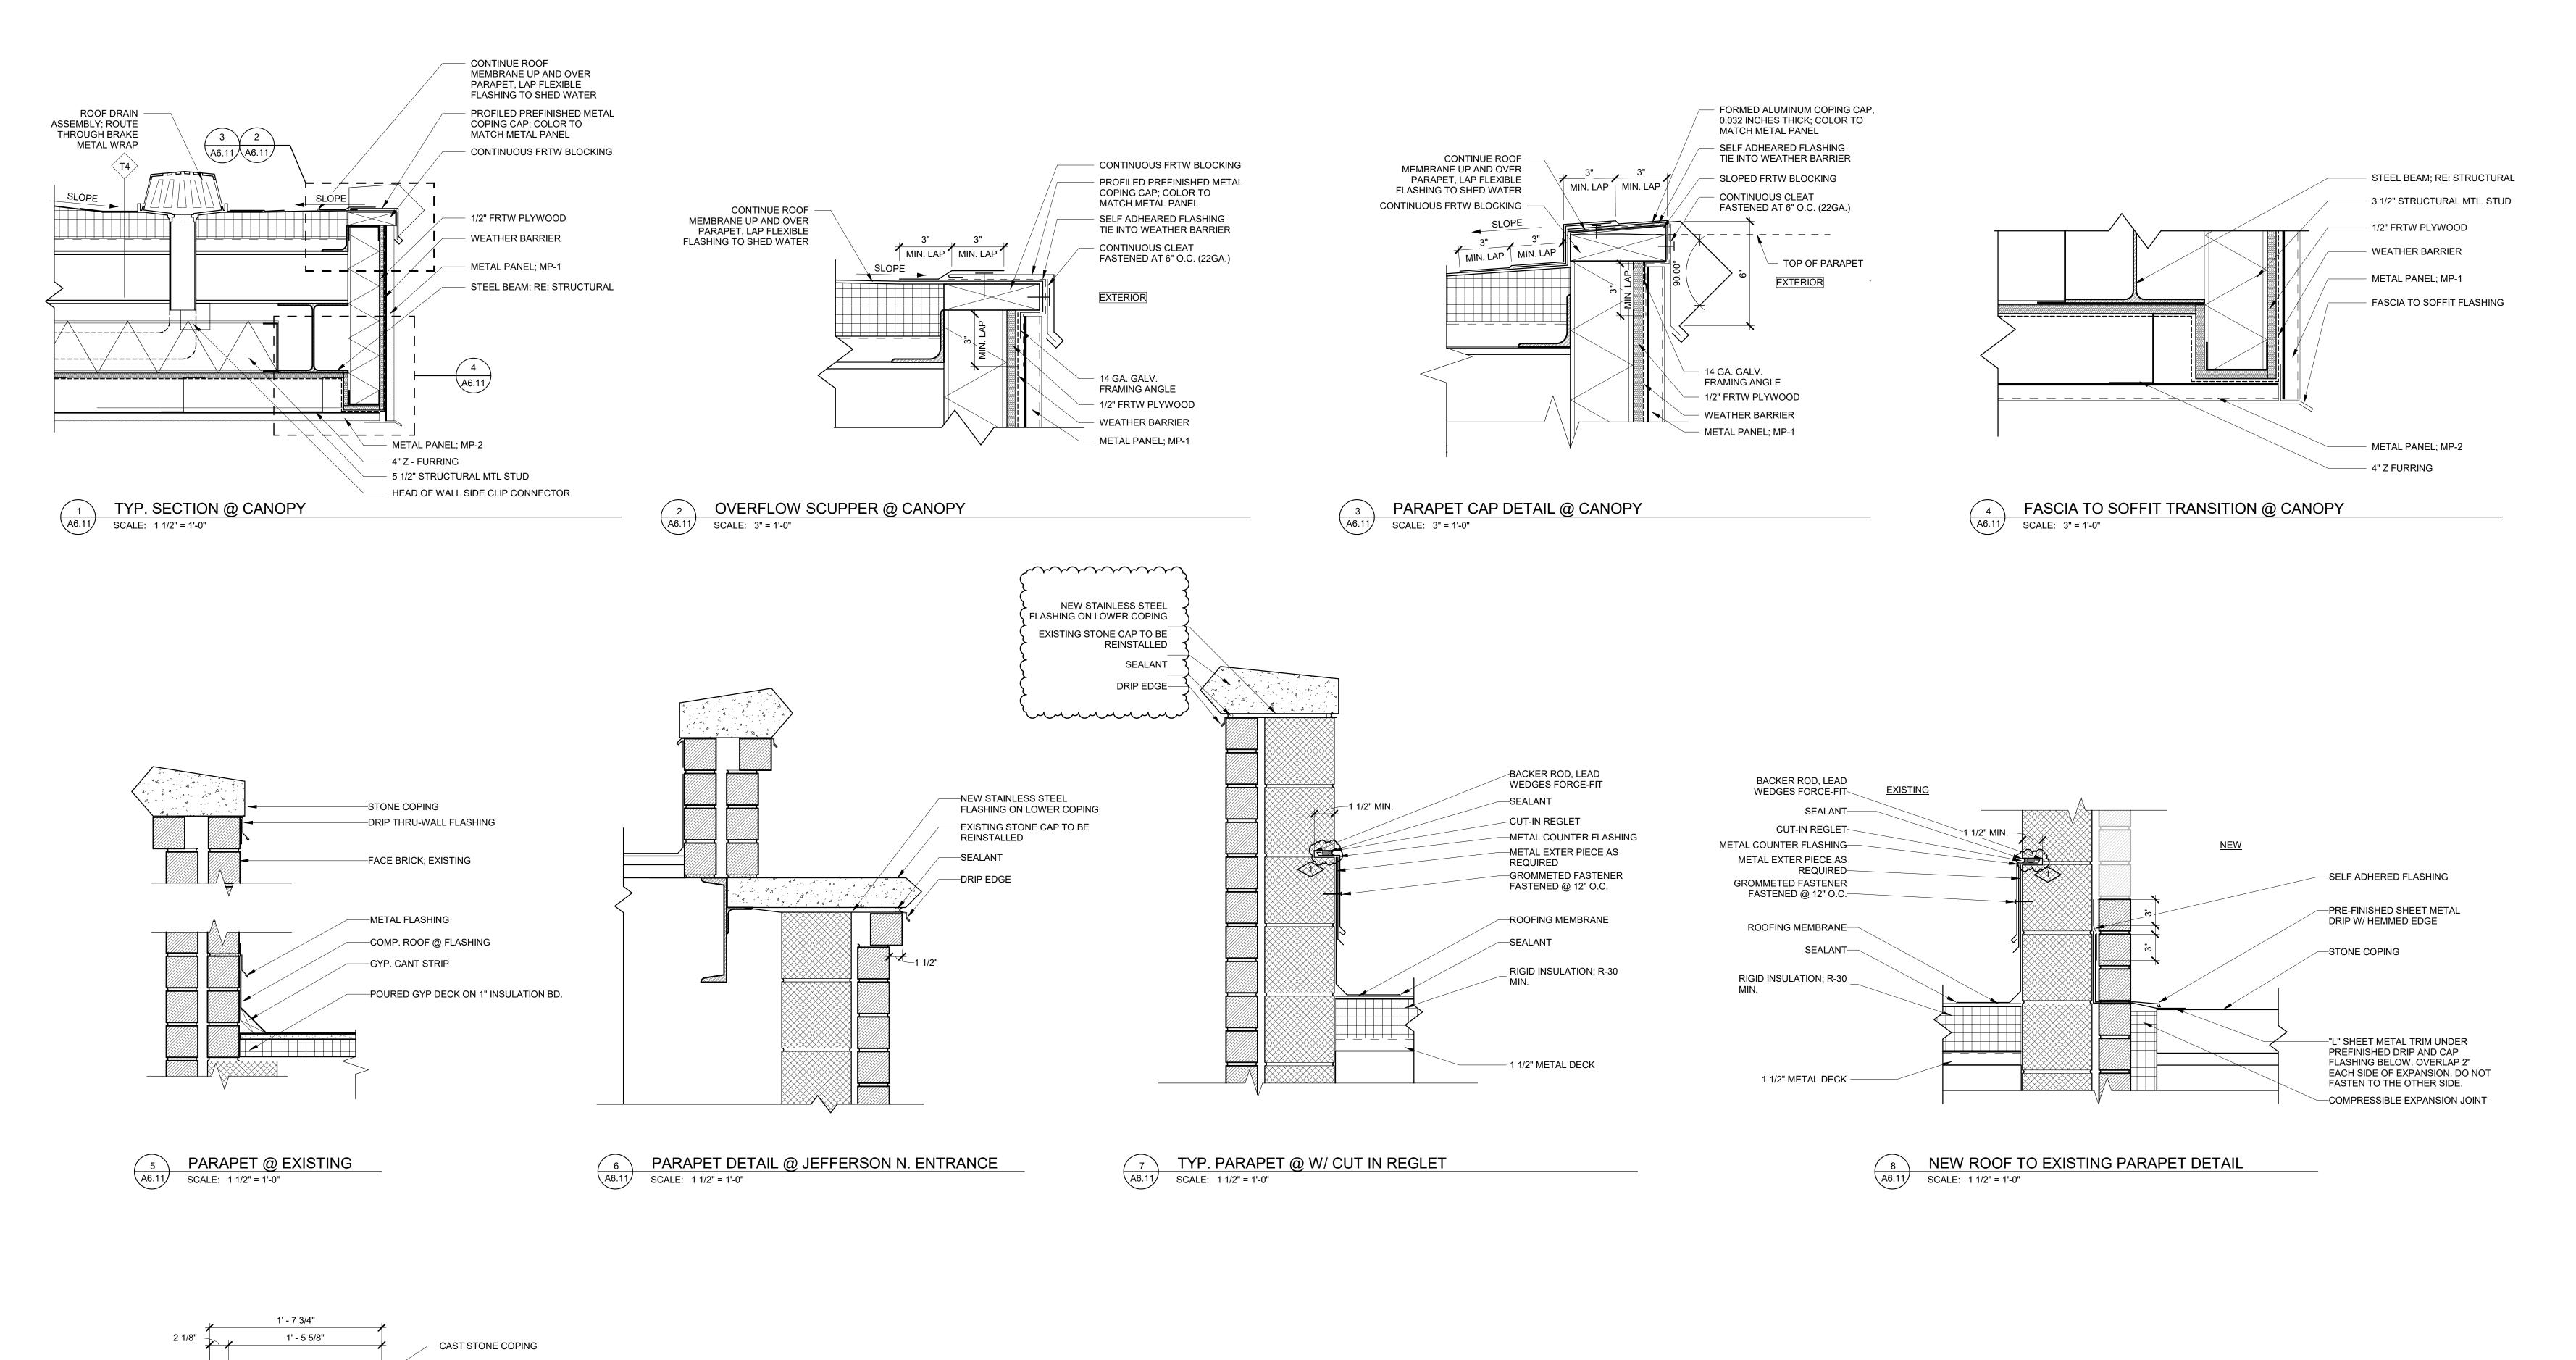

-CAST STONE PARAPET CAP; SEE 9/A6.11 FOR DETAIL ON

(DRILLED INTO CMU @ HEAD

JOINT OF COPING WITH PIN DRILLED INTO COPING —1 - 1/2" BRICK PROJECTION

**ELEVATION** 

-ANCHORING SYSTEM

STONE)

-GROUT SOLID

**SECTION** 

BRICK DETAIL @ STONE COPING

SCALE: 1 1/2" = 1'-0"

—SEALANT AND BACKER ROD; B.S.

—GROMMETED FASTENER FASTENED @ 12" O.C.

FLASHING

—GROUT SOLID

> <

9 TYP. PARAPET @ NEW ADDITION

SCALE: 1 1/2" = 1'-0"

-STAINLESS STEEL 2 PEICE COUNTER

-ROOF MEMBRANE

ROOF MEMBRANE

- 1 1/2" METAL DECK


RIGID INSULATION; R-30

—SEALANT; WELD TO ADJACENT

—2X P.T. BLOCKING - PROVIDE
BLOCKING LEVEL WITH TOP OF
INSULATION. THICKNESS VARIES

STAINLESS STEEL-

FLASHING; HEMMED EDGE

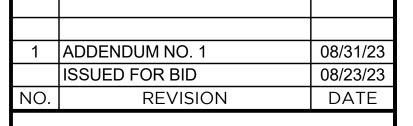

WTAARCH.COM

WTA ARCHITECTS

100 S Jefferson Ave, Suite 601

Saginaw, Michigan 48607 989 752 8107 COPYRIGHT © 2023

PROJECT TITLE

RENOVATION AND ADDITION:
MIDLAND COUNTY ESA

MIDLAND, MICHIGAN


ROOF DETAILS


JMJ

PROJECT NUMBER SHEET NUMBER 2022006.1

PROJECT DATE
AUGUST 23, 2023

CHECKED BY

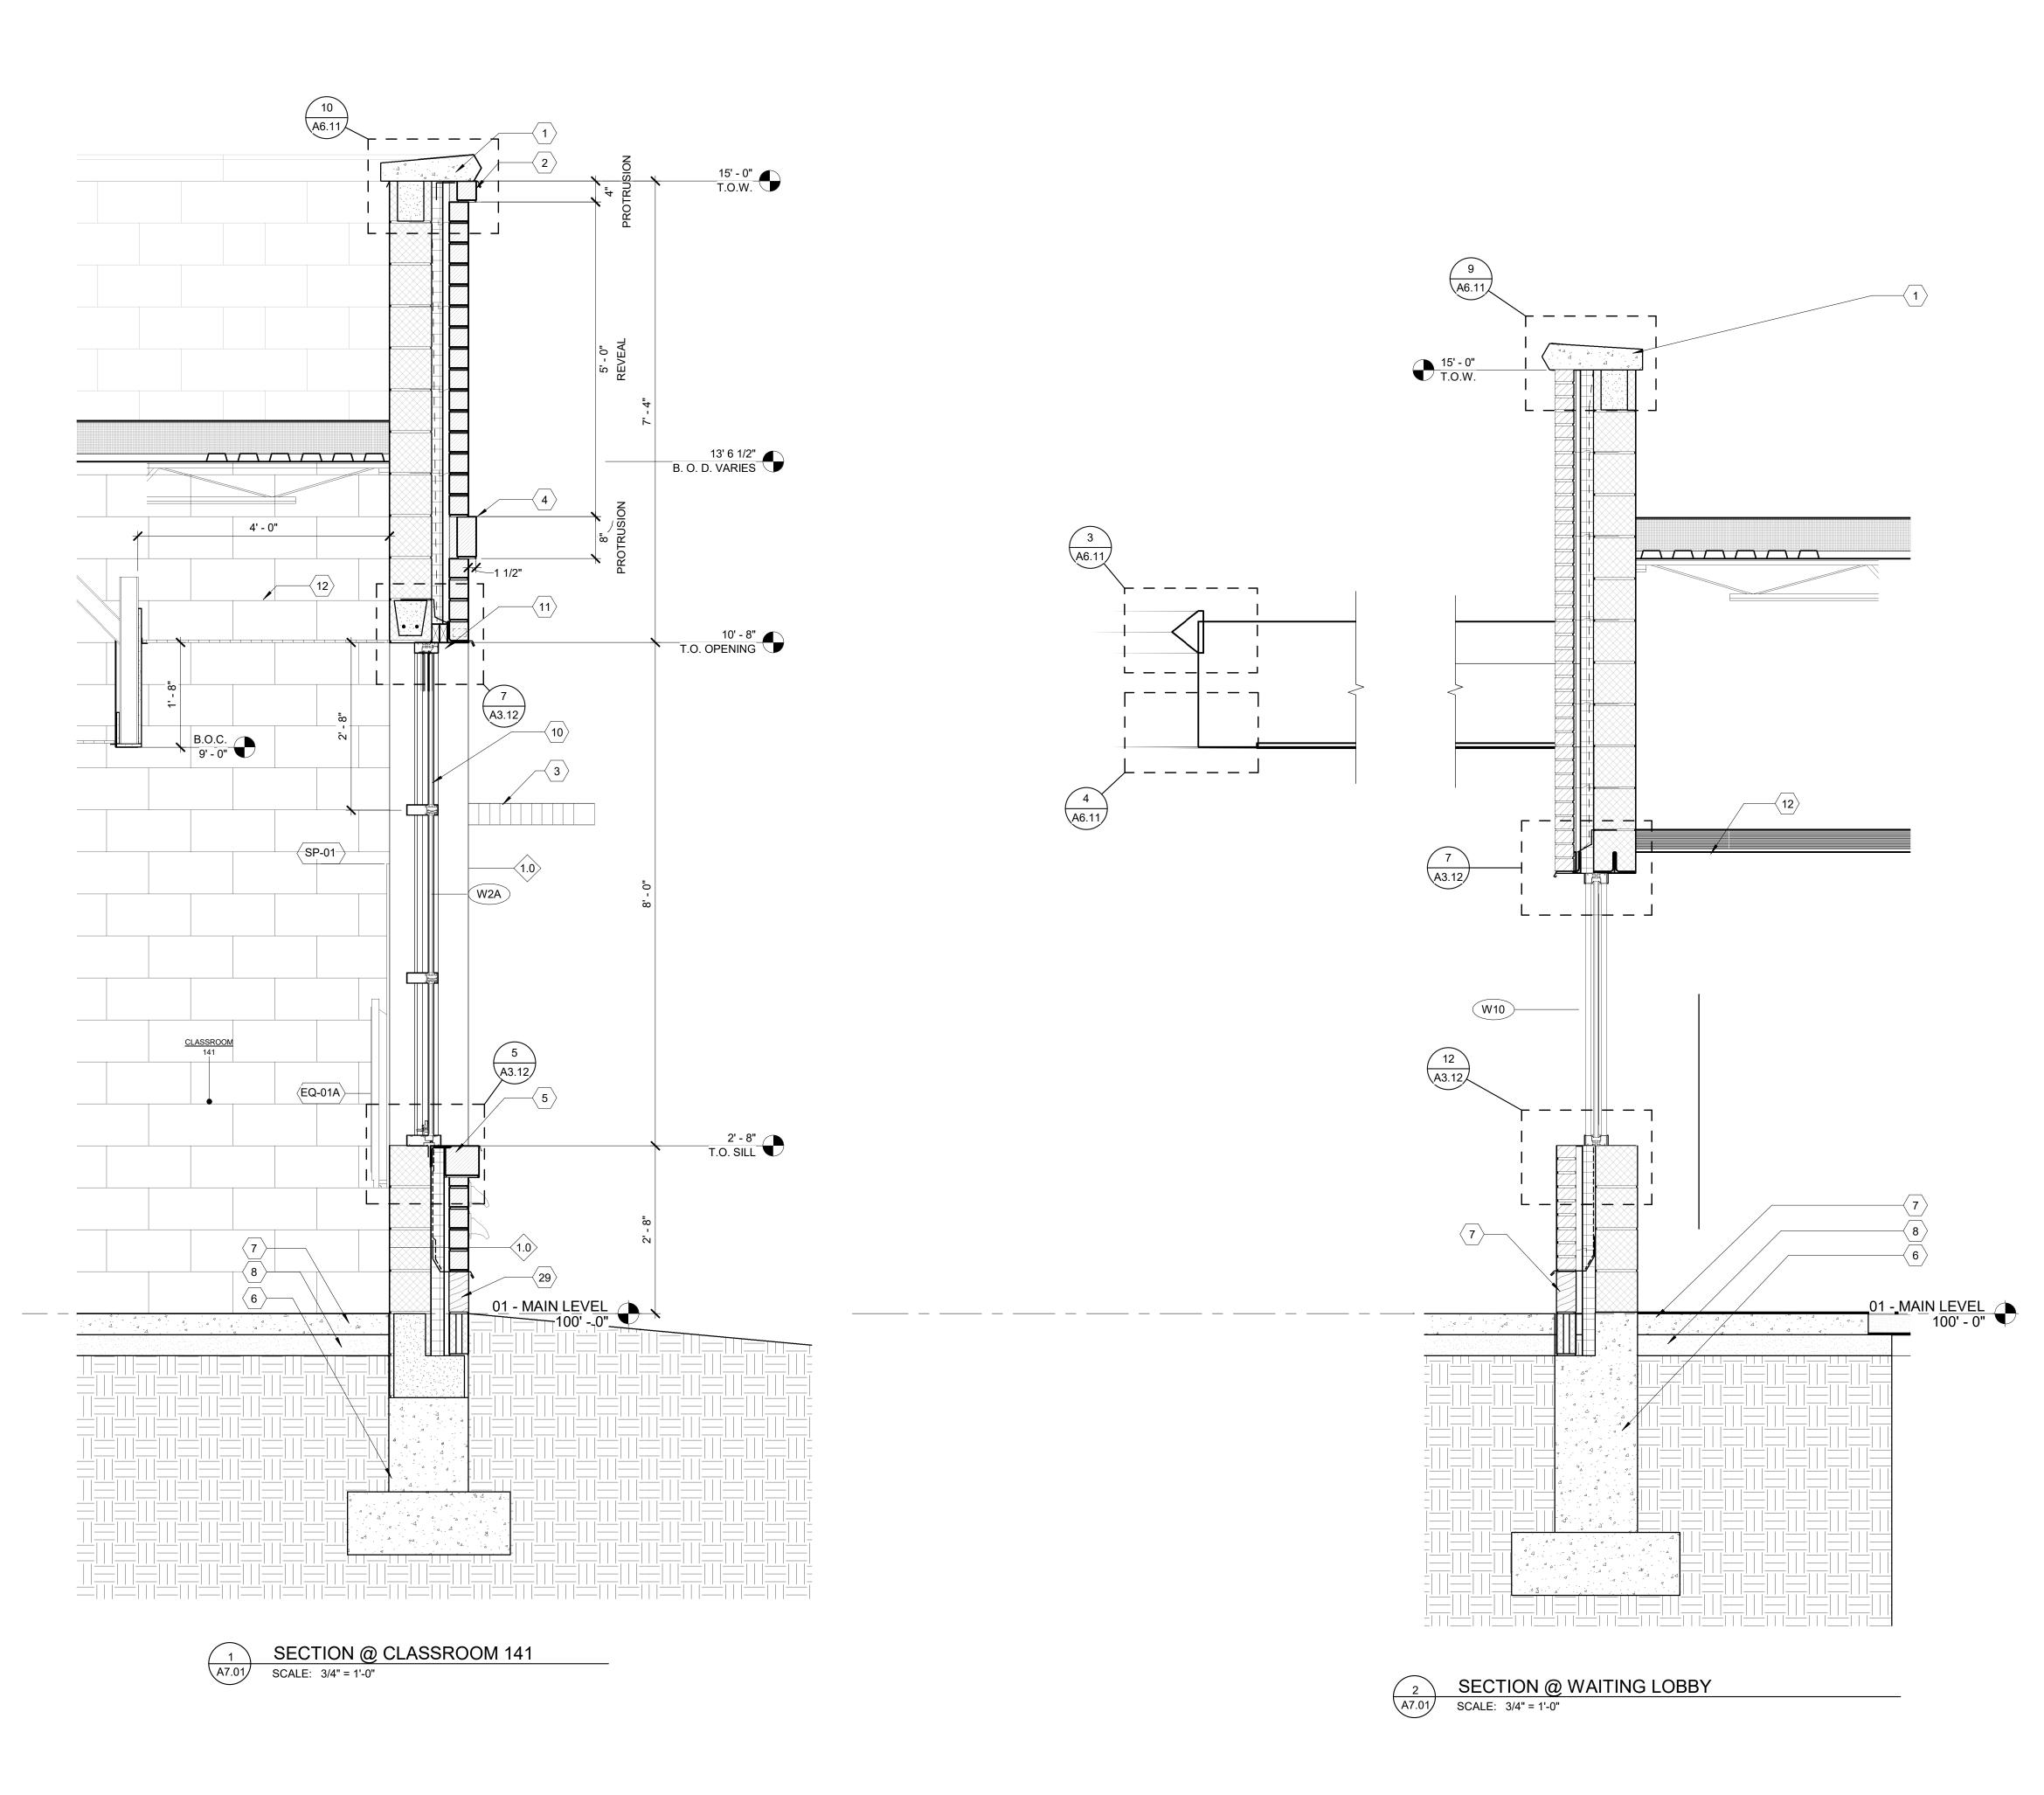

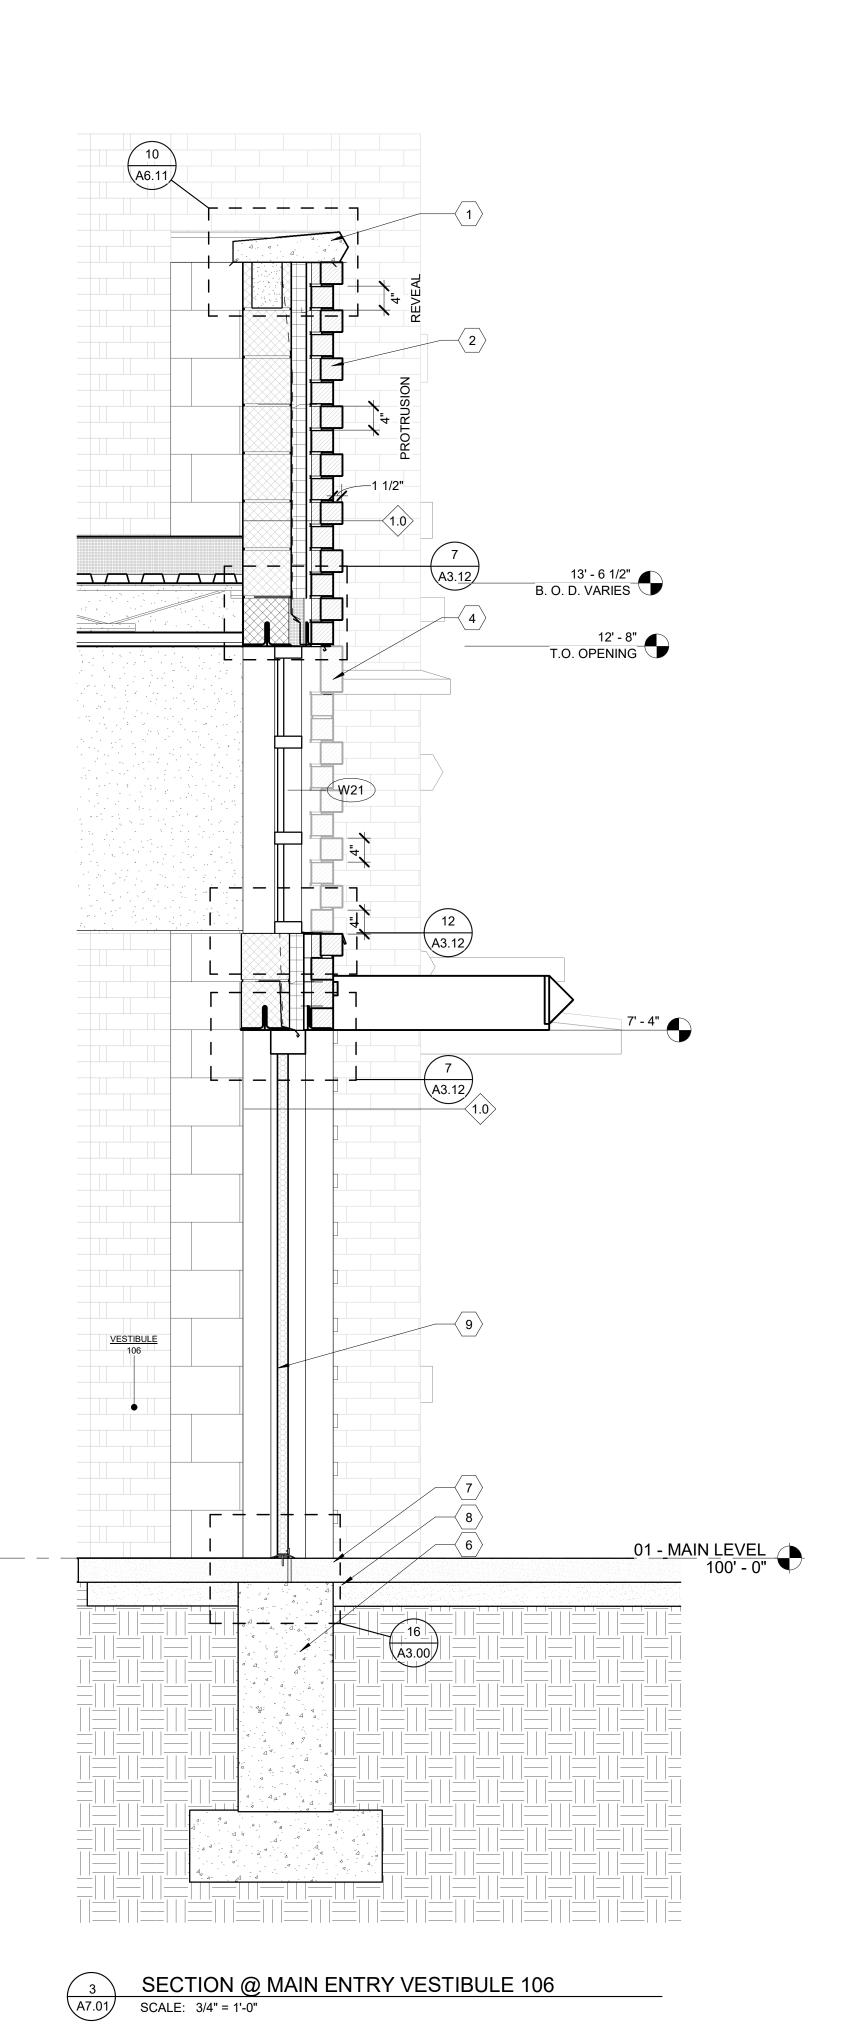

(#) MATERIAL KEYNOTES 

1 CAST STONE PARAPHET CAP

3 FIXED SUNSCREEN SYSTEM MOUNTED TO VERTICAL MULLIONSBY WINDOW MFR. RE: ELVATIONS FOR SPECIFIC LOCATIONS

4 1.5" BRICK PROTRUSION; SOLDIER COURSE

5 CAST STONE SILL

6 FOOTING AND FOUNDATION (SEE STRUCTURAL) 7 CONCRETE SLAB (SEE STRUCTURAL) 8 COMPACTED GRAINULAR FILL

9 DOOR (SEE SCHEDULE) 10 GLASS AND GLAZING SYSTEM

11 ALUMINUM FRAMING SYSTEM 12 FIXTURE AS OCCUR; RE: ELECTRICAL

14 REMOVE AND REPLACE ALL CRACKED OR SPALLED BRICK WITHIN THIS AREA WITH NEW. SEE GENERAL NOTE 1 FOR ALLOWANCE. 15 EXISTING MORTAR JOINS WITHIN AREA ARE CRACKED, LOOSE, MISSING, OPEN, OR

GENERALLY DETERIORATED. REMOVE ALL IDENTIFIED MORTAR TO MINIMUM DEPTH OF 1" AND REPOINT WITH NEW MORTAR. SEE GENERAL NOTE 3 FOR ALLOWANCE. 16 OPEN CRACK IN STONE. INJECT THE CRACK

FULL WITH EPOXY AND PATCH/FINISH THE EXTERIOR SURFACE OF THE STONE WITH A COLORED CEMENTITIOUS COMPOUND IN ORDER TO BLEND THE REPAIR INTO THE ADJACENT SURFACES OF THE EXISTING STONE. SEE GENERAL NOTE 5 FOR ALLOWANCE.

17 REMOVED EXISTING SEALANT AND BACKER ROD (IF PRESENT) BETWEEN WINDOW OR FRAME, AND ADJACENT MASONRY. INSTALL NEW BACKER ROD AND SEALANT.

18 MASONRY CONTRACTOR SHALL OPEN AREAS INDICATED SIMILAR TO CONDITION [SEE DETAILS]. CONTRACTOR SHALL THEN PROVIDE ACCESS FOR ARCHITECT/ENGINEER TO REVIEW. ONCE REVIEW IS COMPLETE THEN CONTRACTOR SHALL INFILL WITH EXISTING KIND MATERIALS.

19 SALVAGE A MINIMUM OF THREE COURSES OF BRICK ABOVE TOP OF WINDOW TO EXPOSE EXISTING LINTEL. REMOVE EXISTING LINTEL AND FLASHING AND INSTALL NEW LINTEL AND THRU WALL FLASHING AND REPLACE BRICK. SEE

GENERAL NOTE 1.3-4 FOR ALLOWNACES. SEE DETAIL 1/A5.13. 2/A5.13. 20 SALVAGE STONE HEADER AND ONE COURSE OF BRICK ABOVE HEADER TO EXPOSE EXISTING LINTEL. REMOVE EXISTING LINTEL AND FLASHING AND INSTALL NEW LINTEL AND THRU

WALL FLASHING. REINSTALL HEADER AND BRICK. SEE GENERAL NOTE 1, 3, 4, FOR ALLOWANCES. SEE DETAIL (3/A5.13.) 21 SAW CUT BRICK, INSTALL A NEW 1/2" VERTICAL EXPANSION JOINT FREE OF MASONRY AND

MORTAR FULL DEPTH. FILL JOINT WITH NEW BACKER ROD AND SEALANT. SEE DETAIL 4/A5.13. 22 EXISTING LIMESTONE COPING PIECE TO BE REMOVED AND SALVAGED FOR REINSTALLATION. ALL EXPOSED SURFACES SHALL BE CHEMICALLY CLEANED TO REMOVE DIRT AND STAINS. ALL EXISTING MORTAR AND FLASHING SHALL BE REMOVED FROM HEAD AND BED JOINT SURFACES. INSTALL NEW COPING FLASHING ALONG THE ENTIRE LENGTH, OF

23 HATCHING INDICATES AREA OF BRICK WALL TO BE SALVAGED IN ORDER TO REPAIR AND FLASH EMBEDDED STEEL CONDITIONS. 24 REMOVE EXISTING ABANDONED ANCHOR. INFILL

REPLACED COPING. SEE DETAIL 7/A6.11.

CAVITY WITH MORTAR AND RESEAL. 25 RESEAL GAP WITH SILICONE AROUND EXISTING

26 INJECT CONCRETE CRACK FULL WITH EPOXY AND PATCH/FINISH THE EXTERIOR SURFACE WITH CEMENTITIOUS COMPOUND IN ORDER TO BLEND THE REPAIR INTO ADJACENT EXISTING SURFACE. SEE GENERAL NOTE 6 FOR

28 CAST ALUMINUM LETTERING 18" HIGH CENTERED IN FACIA.

29 LIMESTONE BASE COURSE

ALLOWANCE.

30 MASONRY CONTROL JOINT

31 LIMESTONE BASE COURSE

(32 EXISTING LIMESTONE COPING. ALL EXPOSED

SURFACES TO BE CHEMICALLY CLEANED TO

REMOVE DIRT & STAINS. ALL MISALIGNED

COPING TO BE REMOVED AND REINSTALLED TO MATCH EXISTING. ALL DETERIORATED MORTAR S
JOINTS AND SEALANT TO BE CLEANED AND

mmmmm

ADDENDUM NO. 1 ISSUED FOR BID 08/23/23 REVISION DATE



WTAARCH.COM

**WTA** ARCHITECTS

100 S Jefferson Ave, Suite 601

Saginaw, Michigan 48607 989 752 8107 COPYRIGHT © 2023

PROJECT TITLE

RENOVATION AND ADDITION:


MIDLAND COUNTY ESA

MIDLAND, MICHIGAN

WALL SECTIONS


PROJECT NUMBER SHEET NUMBER 2022006.1 PROJECT DATE A7.01 AUGUST 23, 2023

CHECKED BY Checker

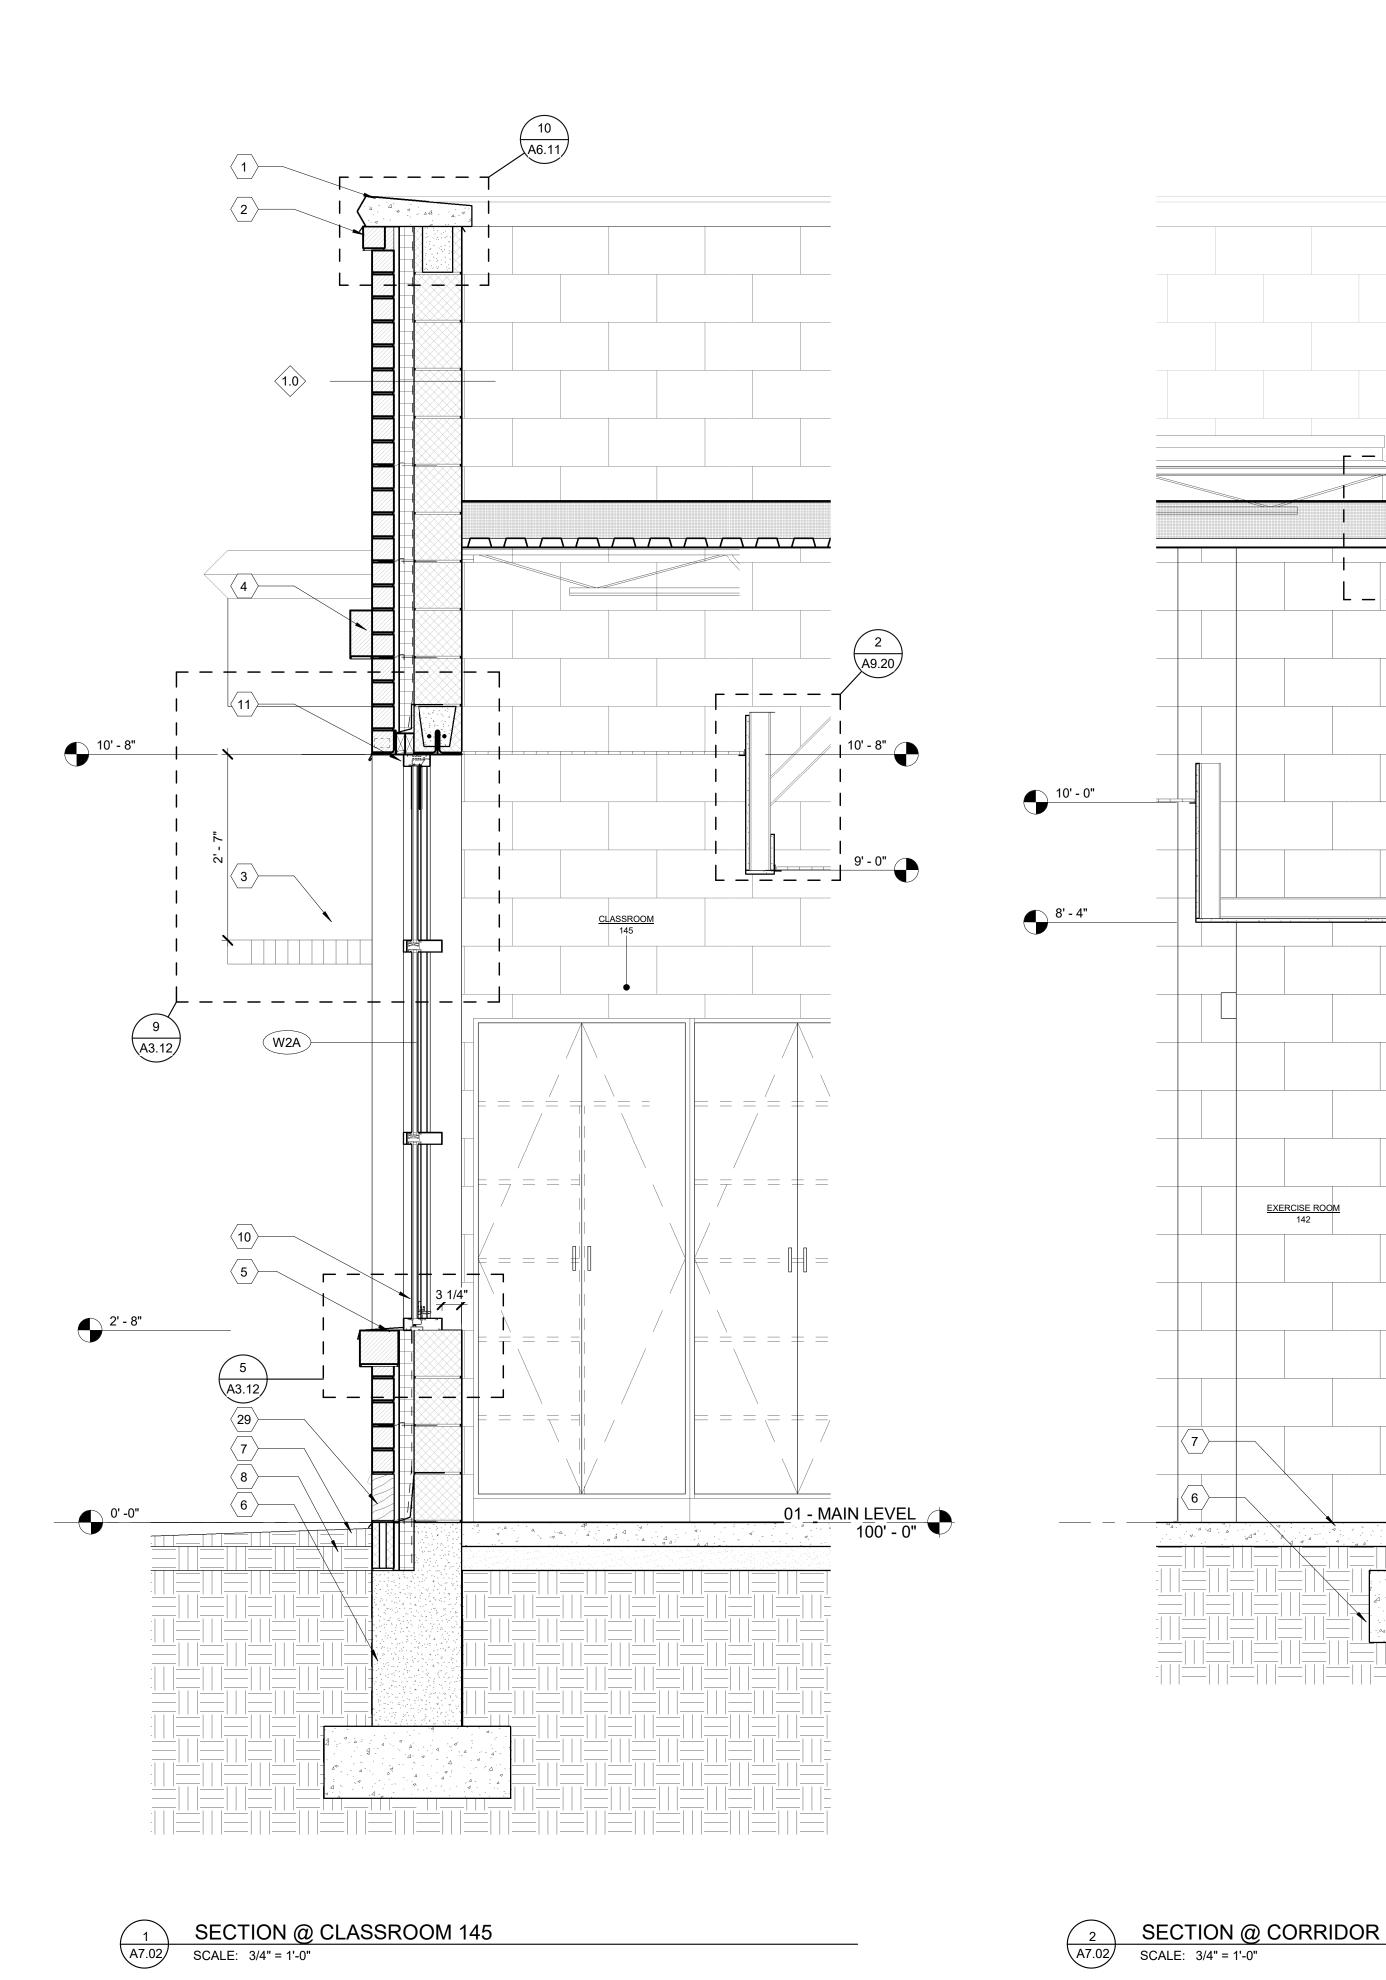

A7.10

01 - MAIN LEVEL 100' - 0"

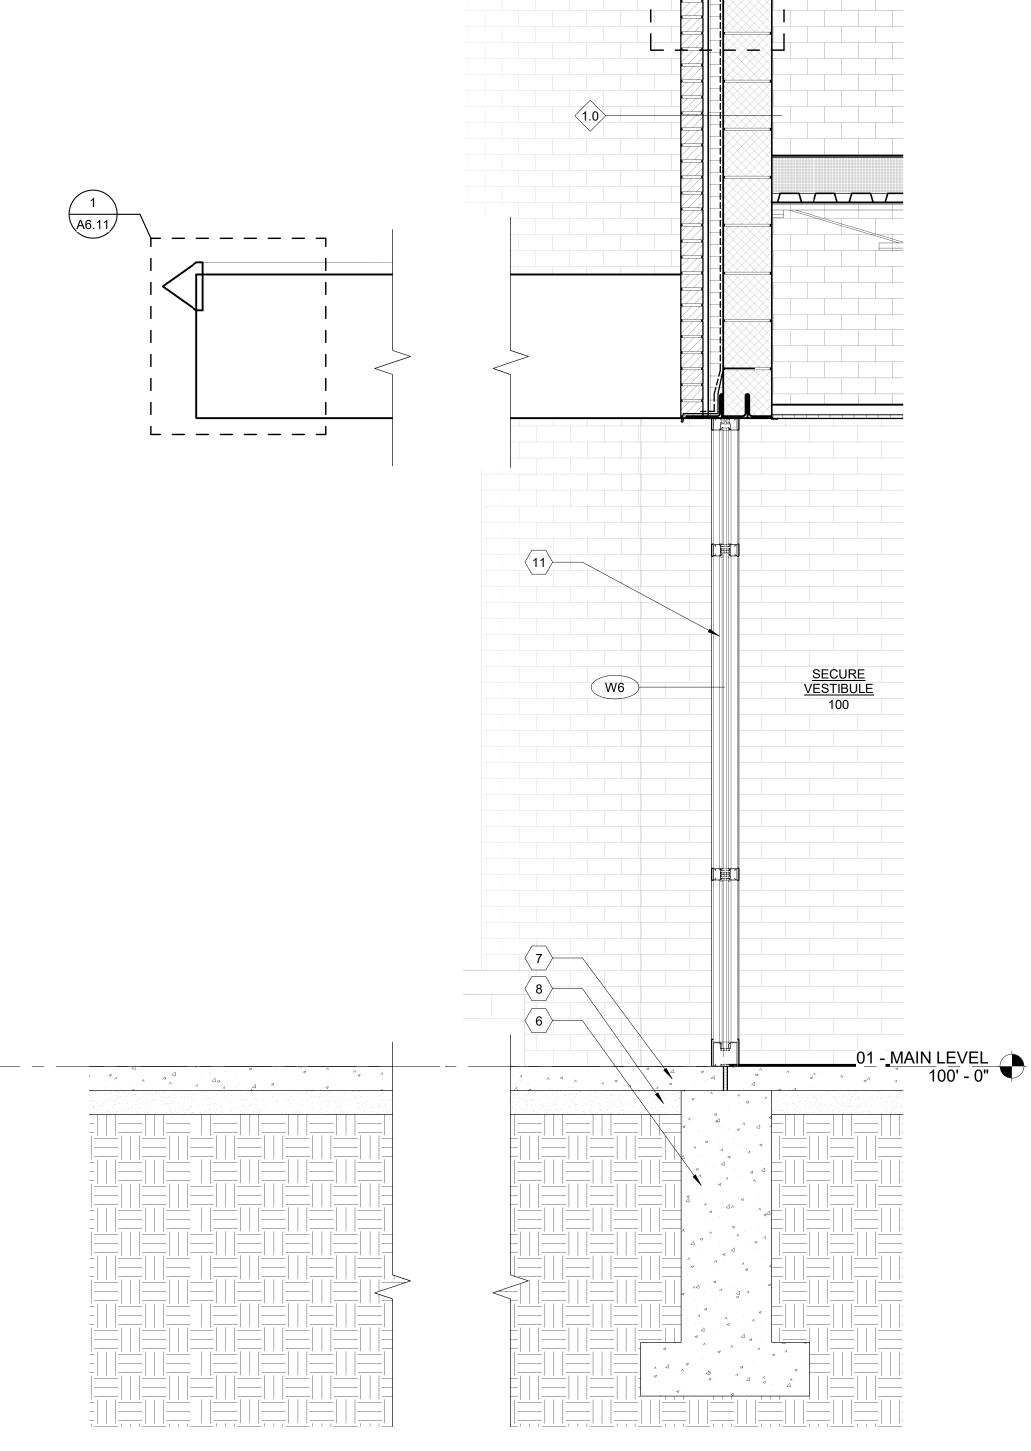

SECTION @ MAIN ENTRY VESTIBULE 100

SCALE: 3/4" = 1'-0"

(#) MATERIAL KEYNOTES

5 CAST STONE SILL

1 CAST STONE PARAPHET CAP 24.5"BRICK PROTRUSION 1>

7 CONCRETE SLAB (SEE STRUCTURAL)

12 FIXTURE AS OCCUR; RE: ELECTRICAL 14 REMOVE AND REPLACE ALL CRACKED OR

8 COMPACTED GRAINULAR FILL

9 DOOR (SEE SCHEDULE) 10 GLASS AND GLAZING SYSTEM 11 ALUMINUM FRAMING SYSTEM

3 FIXED SUNSCREEN SYSTEM MOUNTED TO VERTICAL MULLIONSBY WINDOW MFR. RE:

6 FOOTING AND FOUNDATION (SEE STRUCTURAL)

SPALLED BRICK WITHIN THIS AREA WITH NEW. SEE GENERAL NOTE 1 FOR ALLOWANCE. 15 EXISTING MORTAR JOINS WITHIN AREA ARE CRACKED, LOOSE, MISSING, OPEN, OR GENERALLY DETERIORATED. REMOVE ALL IDENTIFIED MORTAR TO MINIMUM DEPTH OF 1" AND REPOINT WITH NEW MORTAR. SEE GENERAL NOTE 3 FOR ALLOWANCE. 16 OPEN CRACK IN STONE. INJECT THE CRACK FULL WITH EPOXY AND PATCH/FINISH THE EXTERIOR SURFACE OF THE STONE WITH A COLORED CEMENTITIOUS COMPOUND IN ORDER TO BLEND THE REPAIR INTO THE ADJACENT SURFACES OF THE EXISTING STONE. SEE GENERAL NOTE 5 FOR ALLOWANCE.

17 REMOVED EXISTING SEALANT AND BACKER ROD (IF PRESENT) BETWEEN WINDOW OR FRAME, ÀND ADJACENT MASONRY. INSTALL NEW

18 MASONRY CONTRACTOR SHALL OPEN AREAS INDICATED SIMILAR TO CONDITION [SEE DETAILS]. CONTRACTOR SHALL THEN PROVIDE ACCESS FOR ARCHITECT/ENGINEER TO REVIEW.

19 SALVAGE A MINIMUM OF THREE COURSES OF BRICK ABOVE TOP OF WINDOW TO EXPOSE EXISTING LINTEL. REMOVE EXISTING LINTEL AND FLASHING AND INSTALL NEW LINTEL AND THRU WALL FLASHING AND REPLACE BRICK. SEE GENERAL NOTE 1.3, 4 FOR ALLOWNACES. SEE DETAIL 1/A5.13. 2/A5.13. 1 20 SALVAGE STONE HEADER AND ONE COURSE OF BRICK ABOVE HEADER TO EXPOSE EXISTING LINTEL. REMOVE EXISTING LINTEL AND

CONTRACTOR SHALL INFILL WITH EXISTING KIND

FLASHING AND INSTALL NEW LINTEL AND THRU WALL FLASHING. REINSTALL HEADER AND

BRICK. SEE GENERAL NOTE 1 3 4 FOR ALLOWANCES. SEE DETAIL (3/A5.13. ) 1
21 SAW CUT BRICK, INSTALL A NEW 1/2" VERTICAL

EXPANSION JOINT FREE OF MASONRY AND

22 EXISTING LIMESTONE COPING PIECE TO BE 1

REINSTALLATION. ALL EXPOSED SURFACES SHALL BE CHEMICALLY CLEANED TO REMOVE DIRT AND STAINS. ALL EXISTING MORTAR AND FLASHING SHALL BE REMOVED FROM HEAD AND BED JOINT SURFACES. INSTALL NEW COPING FLASHING ALONG THE ENTIRE LENGTH, OR REPLACED COPING. SEE DETAIL 7/A6.11.

23 HATCHING INDICATES AREA OF BRICK WALL TO BE SALVAGED IN ORDER TO REPAIR AND FLASH

24 REMOVE EXISTING ABANDONED ANCHOR. INFILL

25 RESEAL GAP WITH SILICONE AROUND EXISTING

AND PATCH/FINISH THE EXTERIOR SURFACE
WITH CEMENTITIOUS COMPOUND IN ORDER TO
BLEND THE REPAIR INTO ADJACENT EXISTING

~34~HMESTQHE/BASE/GOURSE/~~~~~

32 EXISTING LIMESTONE COPING. ALL EXPOSED SURFACES TO BE CHEMICALLY CLEANED TO REMOVE DIRT & STAINS. ALL MISALIGNED COPING TO BE REMOVED AND REINSTALLED TO

Yummunum.

MATCH EXISTING. ALL DETERIORATED MORTAR
JOINTS AND SEALANT TO BE CLEANED AND

08/23/23

DATE

WTAARCH.COM

COPYRIGHT © 2023

26 INJECT CONCRETE CRACK FULL WITH EPOXY

SURFACE. SEE GENERAL NOTE 6 FOR

28 CAST ALUMINUM LETTERING 18" HIGH CENTERED IN FACIA.

ALLOWANCE.

29 LIMESTONE BASE COURSE

30 MASONRY CONTROL JOINT

REINSTALLED.

ADDENDUM NO. 1 ISSUED FOR BID

989 752 8107

PROJECT TITLE

100 S Jefferson Ave, Suite 601 Saginaw, Michigan 48607

RENOVATION AND ADDITION:

MIDLAND, MICHIGAN

PROJECT NUMBER

WALL SECTIONS

REVISION

**WTA** ARCHITECTS

MIDLAND COUNTY ESA

27 CANOPY

REMOVED AND SALVAGED FOR

EMBEDDED STEEL CONDITIONS.

CAVITY WITH MORTAR AND RESEAL.

MORTAR FULL DEPTH. FILL JOINT WITH NEW BACKER ROD AND SEALANT. SEE DETAIL 4/A5.13.

BACKER ROD AND SEALANT.

MATERIALS.


ONCE REVIEW IS COMPLETE THEN


ELVATIONS FOR SPECIFIC LOCATIONS 4 1.5" BRICK PROTRUSION; SOLDIER COURSE

A7.02 CHECKED BY Checker

SHEET NUMBER

2022006.1 PROJECT DATE AUGUST 23, 2023

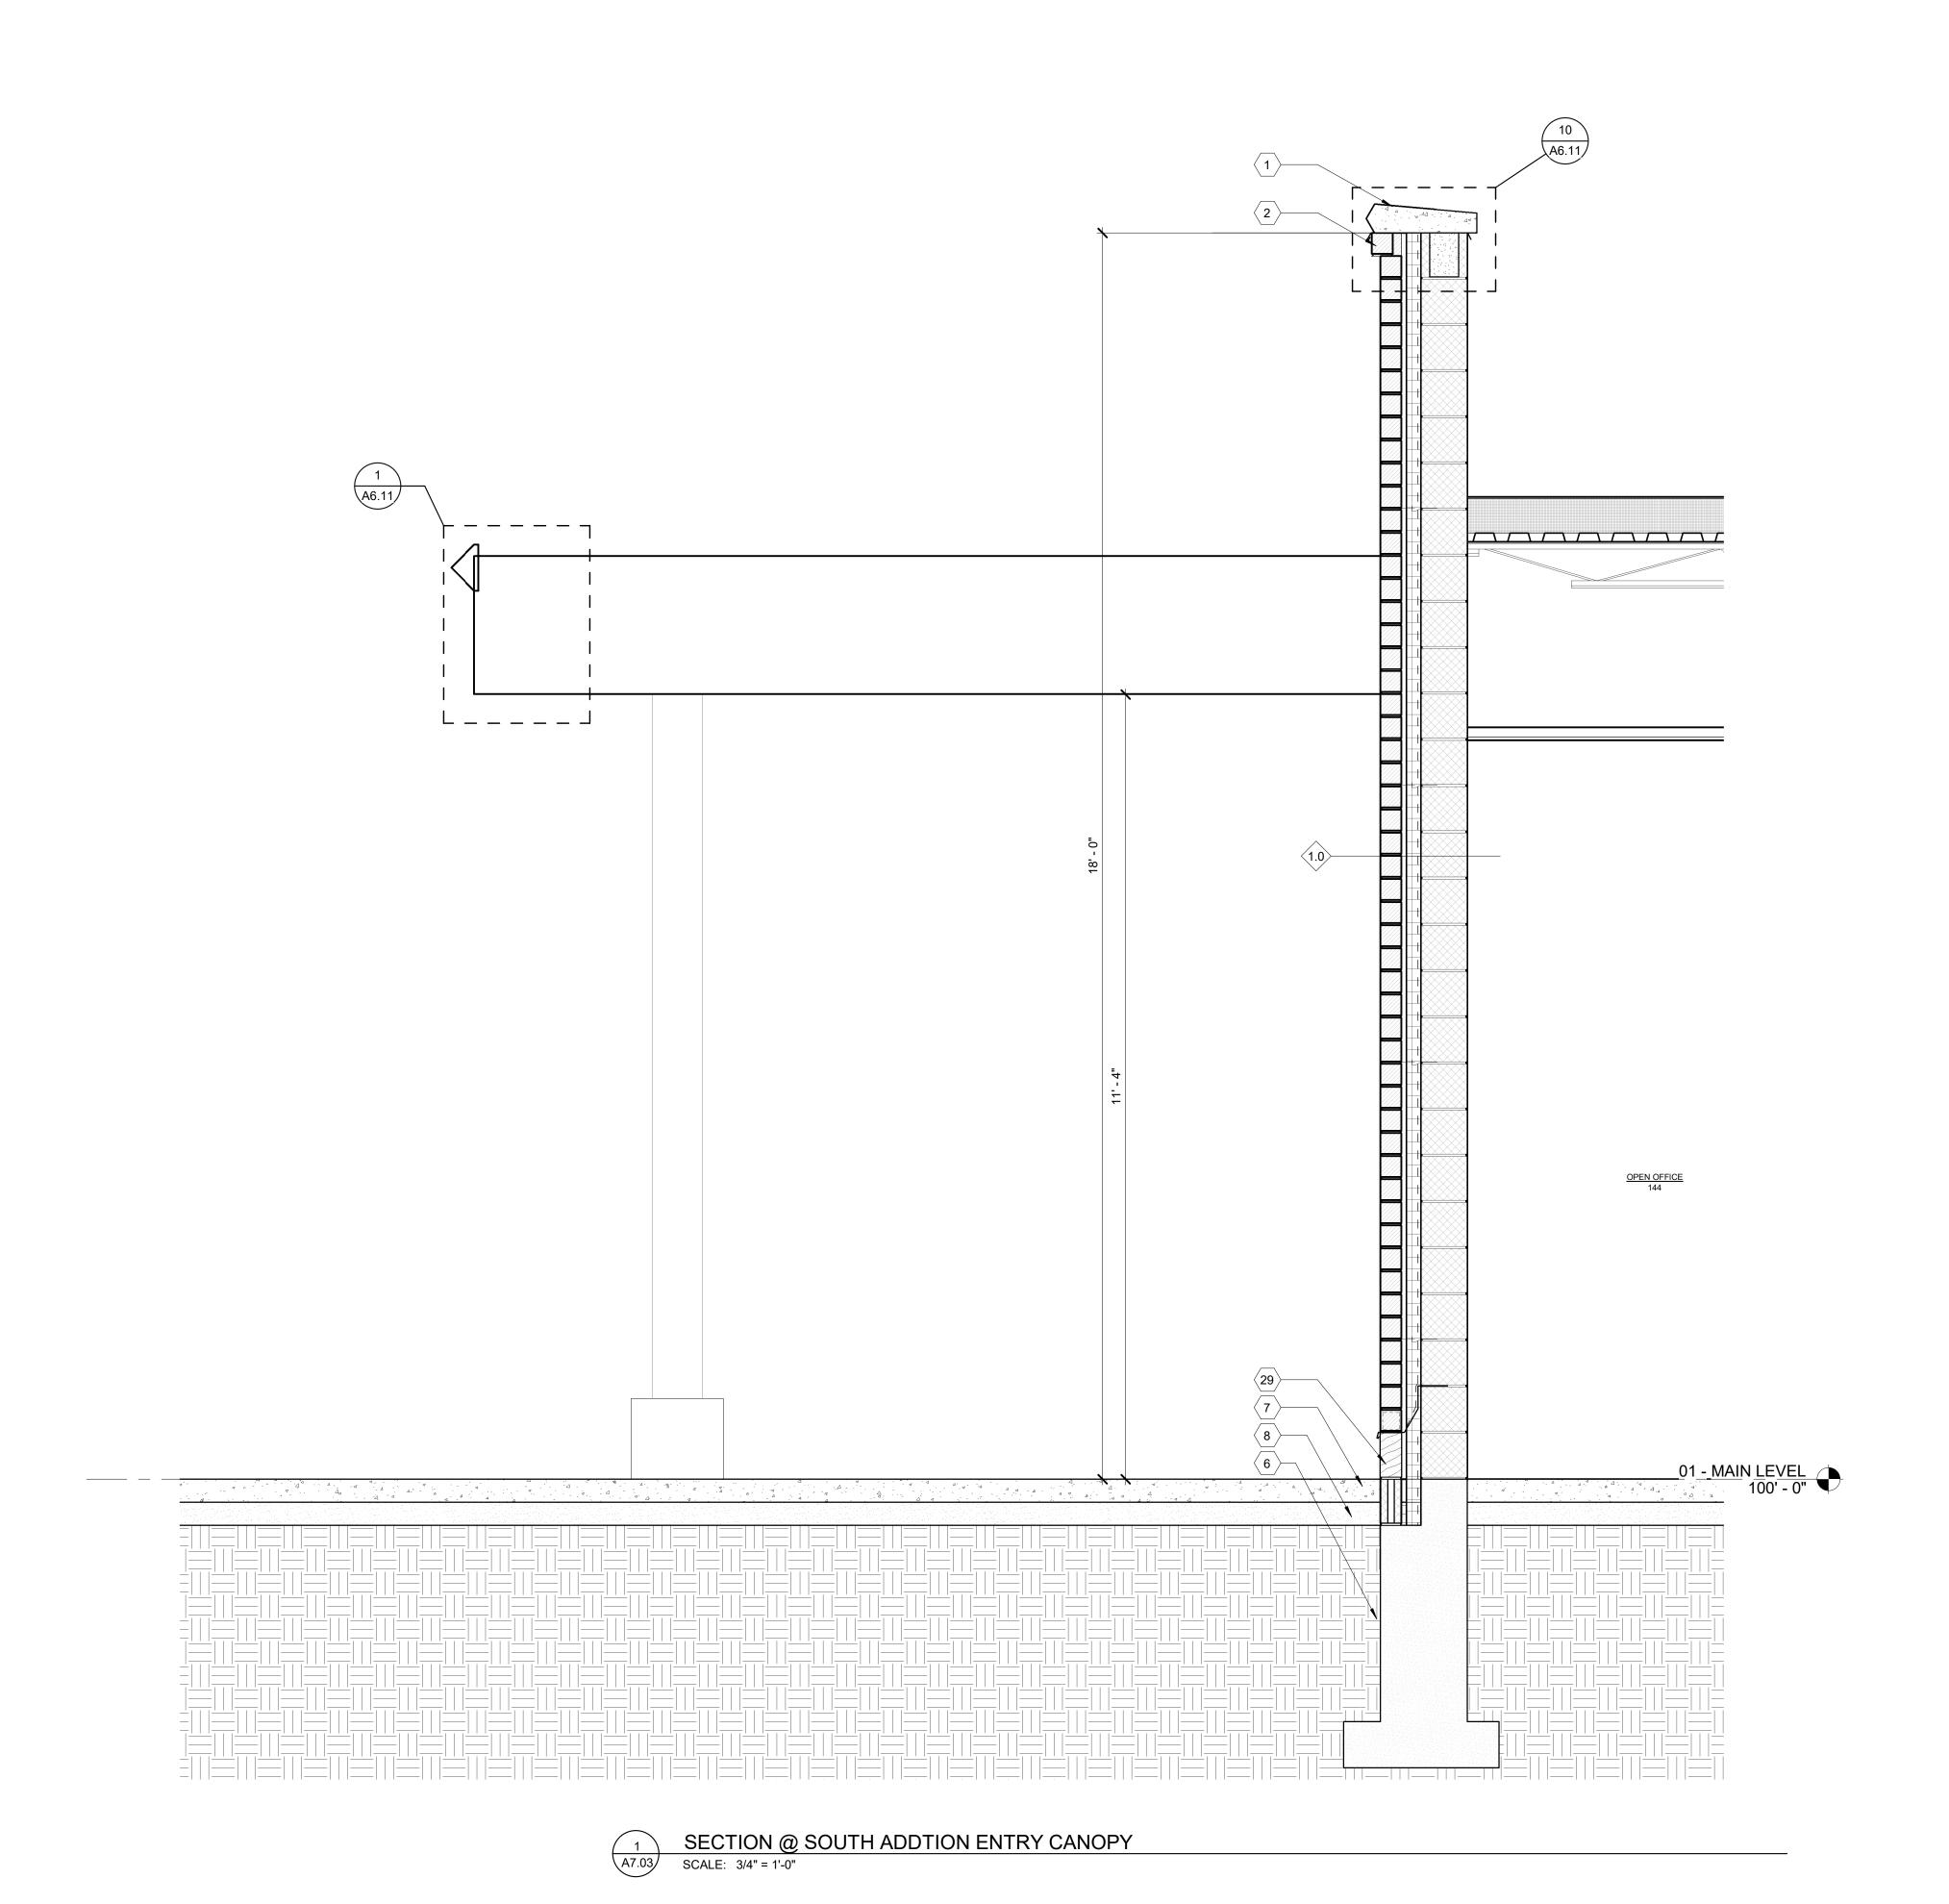

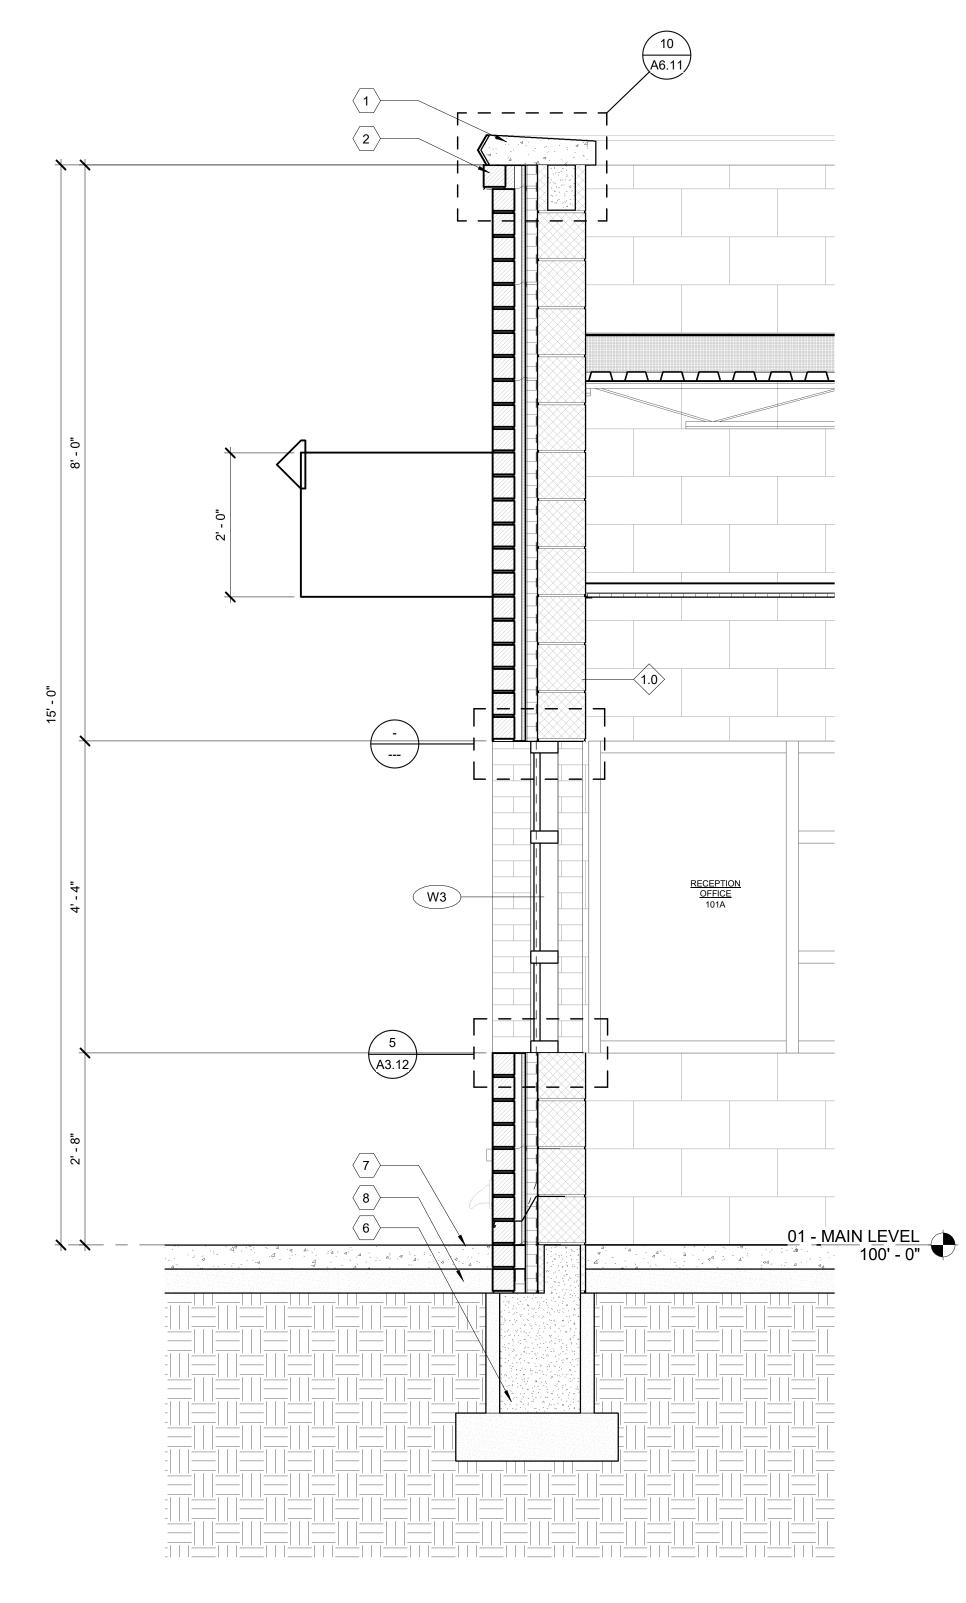

SECTION @ MAIN ENTRY CANOPY

SCALE: 3/4" = 1'-0"

(#) MATERIAL KEYNOTES

1 CAST STONE PARAPHET CAP 2-1.5"BRICK-PROTRUSION-1>

3 FIXED SUNSCREEN SYSTEM MOUNTED TO VERTICAL MULLIONSBY WINDOW MFR. RE: ELVATIONS FOR SPECIFIC LOCATIONS

4 1.5" BRICK PROTRUSION; SOLDIER COURSE 5 CAST STONE SILL 6 FOOTING AND FOUNDATION (SEE STRUCTURAL)

7 CONCRETE SLAB (SEE STRUCTURAL) 8 COMPACTED GRAINULAR FILL

9 DOOR (SEE SCHEDULE) 10 GLASS AND GLAZING SYSTEM 11 ALUMINUM FRAMING SYSTEM

12 FIXTURE AS OCCUR; RE: ELECTRICAL

14 REMOVE AND REPLACE ALL CRACKED OR SPALLED BRICK WITHIN THIS AREA WITH NEW. SEE GENERAL NOTE 1 FOR ALLOWANCE.

15 EXISTING MORTAR JOINS WITHIN AREA ARE CRACKED, LOOSE, MISSING, OPEN, OR GENERALLY DETERIORATED. REMOVE ALL IDENTIFIED MORTAR TO MINIMUM DEPTH OF 1" AND REPOINT WITH NEW MORTAR. SEE GENERAL NOTE 3 FOR ALLOWANCE.

EXTERIOR SURFACE OF THE STONE WITH A COLORED CEMENTITIOUS COMPOUND IN ORDER TO BLEND THE REPAIR INTO THE ADJACENT SURFACES OF THE EXISTING STONE. SEE GENERAL NOTE 5 FOR ALLOWANCE. 17 REMOVED EXISTING SEALANT AND BACKER ROD

(IF PRESENT) BETWEEN WINDOW OR FRAME,

16 OPEN CRACK IN STONE. INJECT THE CRACK FULL WITH EPOXY AND PATCH/FINISH THE

ÀND ADJACENT MASONRY. INSTALL NEW BACKER ROD AND SEALANT. 18 MASONRY CONTRACTOR SHALL OPEN AREAS INDICATED SIMILAR TO CONDITION [SEE DETAILS]. CONTRACTOR SHALL THEN PROVIDE ACCESS FOR ARCHITECT/ENGINEER TO REVIEW.

ONCE REVIEW IS COMPLETE THEN CONTRACTOR SHALL INFILL WITH EXISTING KIND 19 SALVAGE A MINIMUM OF THREE COURSES OF

BRICK ABOVE TOP OF WINDOW TO EXPOSE EXISTING LINTEL. REMOVE EXISTING LINTEL AND FLASHING AND INSTALL NEW LINTEL AND THRU WALL FLASHING AND REPLACE BRICK. SEE GENERAL NOTE 1, 3, 4 FOR ALLOWNACES. SEE DETAIL (1/A5.13, 2/A5.13. )

20 SALVAGE STONE HEADER AND ONE COURSE OF

BRICK ABOVE HEADER TO EXPOSE EXISTING LINTEL. REMOVE EXISTING LINTEL AND FLASHING AND INSTALL NEW LINTEL AND THRU WALL FLASHING. REINSTALL HEADER AND

BRICK. SEE GENERAL NOTE 1 3 4. FOR ALLOWANCES. SEE DETAIL (3/A5.13. )
21 SAW CUT BRICK, INSTALL A NEW 1/2" VERTICAL EXPANSION JOINT FREE OF MASONRY AND MORTAR FULL DEPTH. FILL JOINT WITH NEW BACKER ROD AND SEALANT. SEE DETAIL 4/A5.13.

22 EXISTING LIMESTONE COPING PIECE TO BE 1 REMOVED AND SALVAGED FOR REINSTALLATION. ALL EXPOSED SURFACES SHALL BE CHEMICALLY CLEANED TO REMOVE DIRT AND STAINS. ALL EXISTING MORTAR AND FLASHING SHALL BE REMOVED FROM HEAD AND BED JOINT SURFACES. INSTALL NEW COPING

FLASHING ALONG THE ENTIRE LENGTH OF REPLACED COPING. SEE DETAIL 7/A6.11. 23 HATCHING INDICATES AREA OF BRICK WALL TO BE SALVAGED IN ORDER TO REPAIR AND FLASH EMBEDDED STEEL CONDITIONS. 24 REMOVE EXISTING ABANDONED ANCHOR. INFILL

CAVITY WITH MORTAR AND RESEAL. 25 RESEAL GAP WITH SILICONE AROUND EXISTING

26 INJECT CONCRETE CRACK FULL WITH EPOXY AND PATCH/FINISH THE EXTERIOR SURFACE WITH CEMENTITIOUS COMPOUND IN ORDER TO BLEND THE REPAIR INTO ADJACENT EXISTING SURFACE. SEE GENERAL NOTE 6 FOR

27 CANOPY 28 CAST ALUMINUM LETTERING 18" HIGH CENTERED IN FACIA.

29 LIMESTONE BASE COURSE

ALLOWANCE.

30 MASONRY CONTROL JOINT

~\$\~\\MESTQNE\BASECQUERSE\~\~\~\ 32 EXISTING LIMESTONE COPING. ALL EXPOSED SURFACES TO BE CHEMICALLY CLEANED TO REMOVE DIRT & STAINS. ALL MISALIGNED . COPING TO BE REMOVED AND REINSTALLED TO MATCH EXISTING. ALL DETERIORATED MORTAR
JOINTS AND SEALANT TO BE CLEANED AND REINSTALLED.

ADDENDUM NO. 1 ISSUED FOR BID 08/23/23 REVISION DATE



WTAARCH.COM

**WTA** ARCHITECTS

100 S Jefferson Ave, Suite 601 Saginaw, Michigan 48607

989 752 8107 COPYRIGHT © 2023

PROJECT TITLE

RENOVATION AND ADDITION:


MIDLAND COUNTY ESA

MIDLAND, MICHIGAN


WALL SECTIONS

SHEET NUMBER PROJECT NUMBER 2022006.1 PROJECT DATE

A7.03 AUGUST 23, 2023 CHECKED BY JMJ

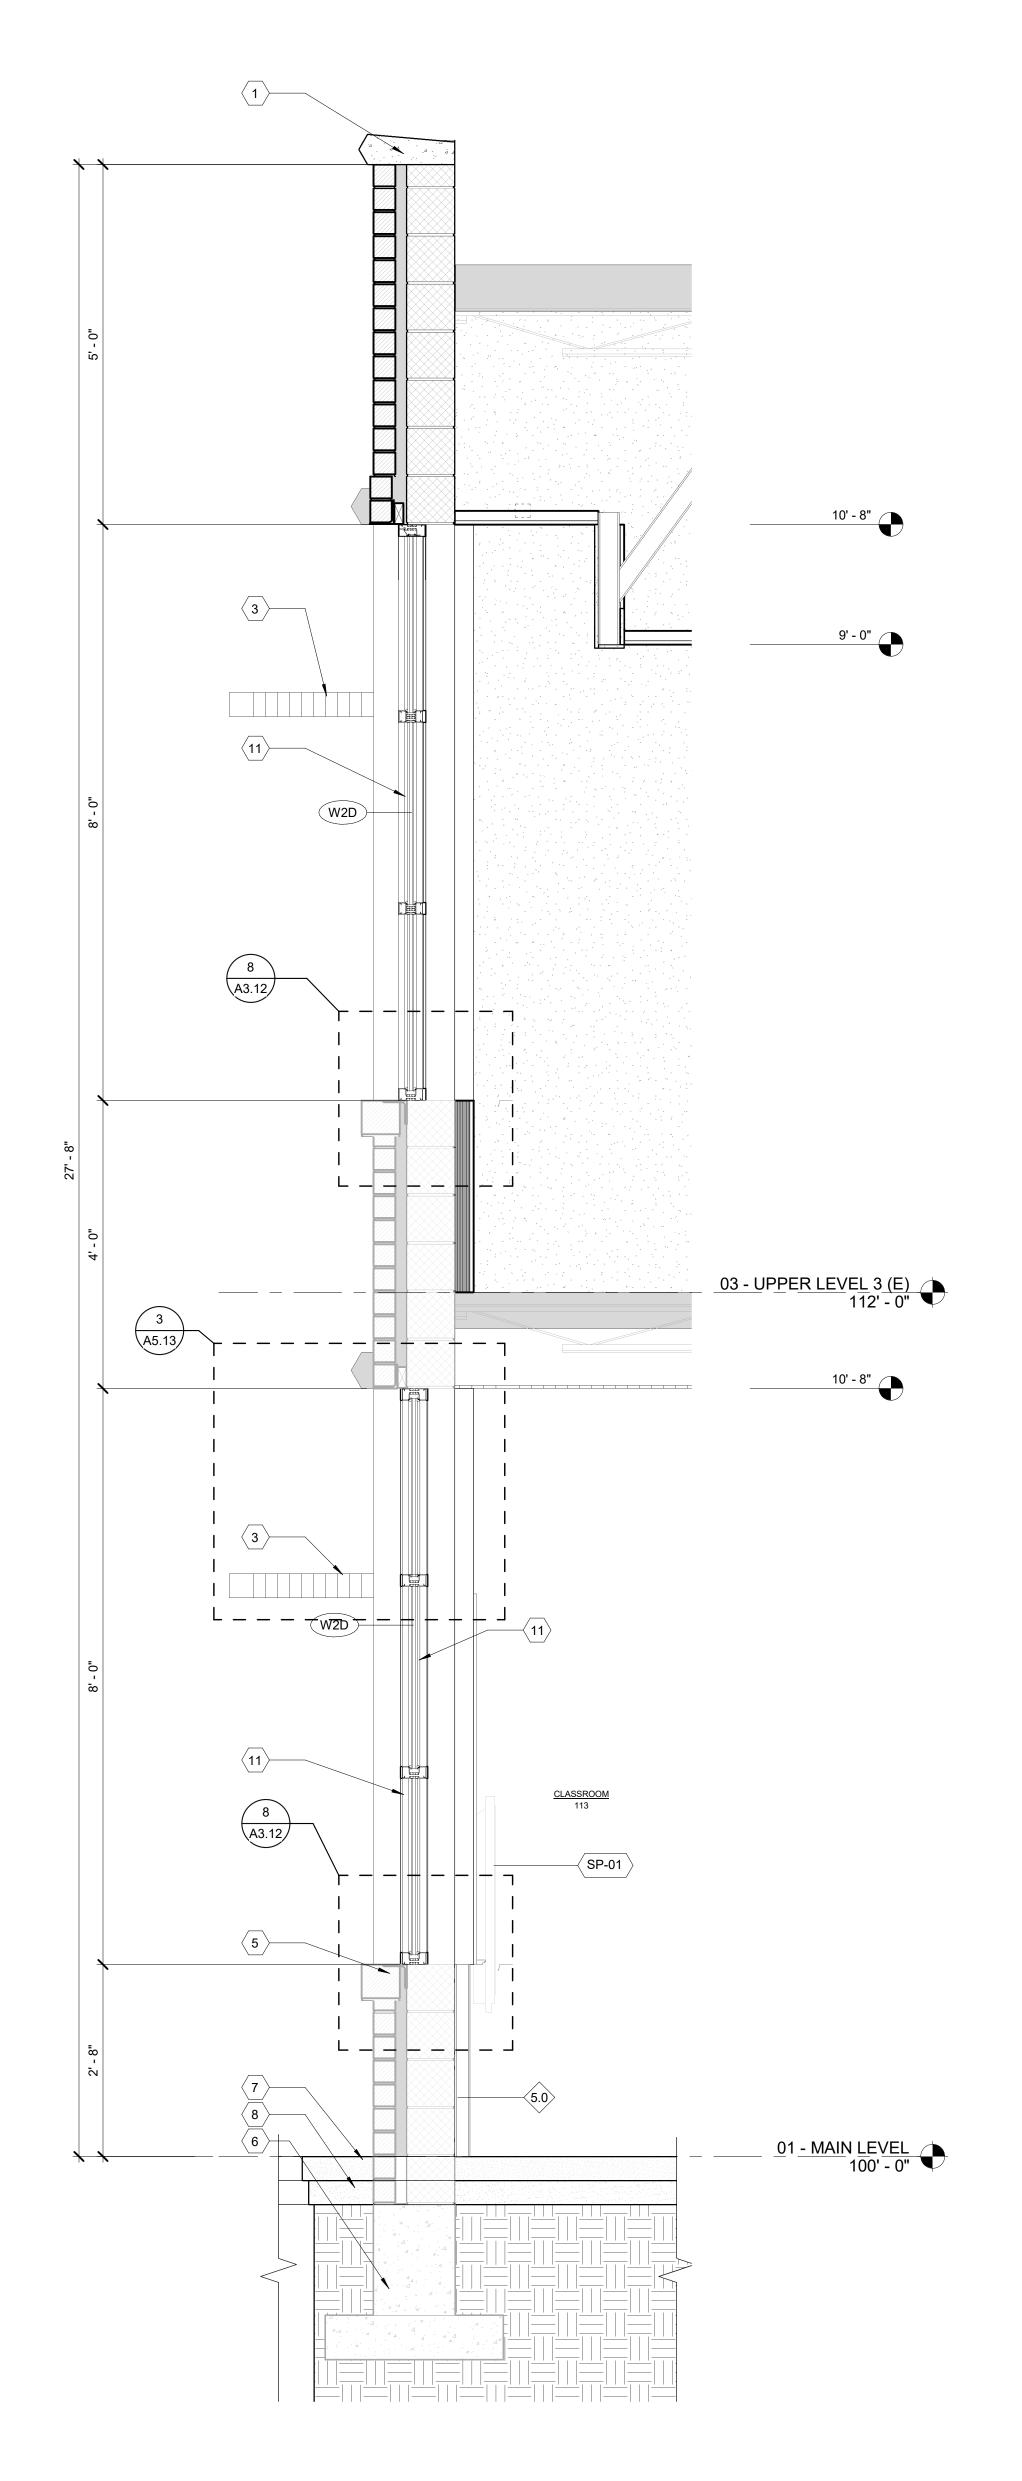

SECTION @ CLASSROOM 113 FURRING UP TO WINDOW SILL

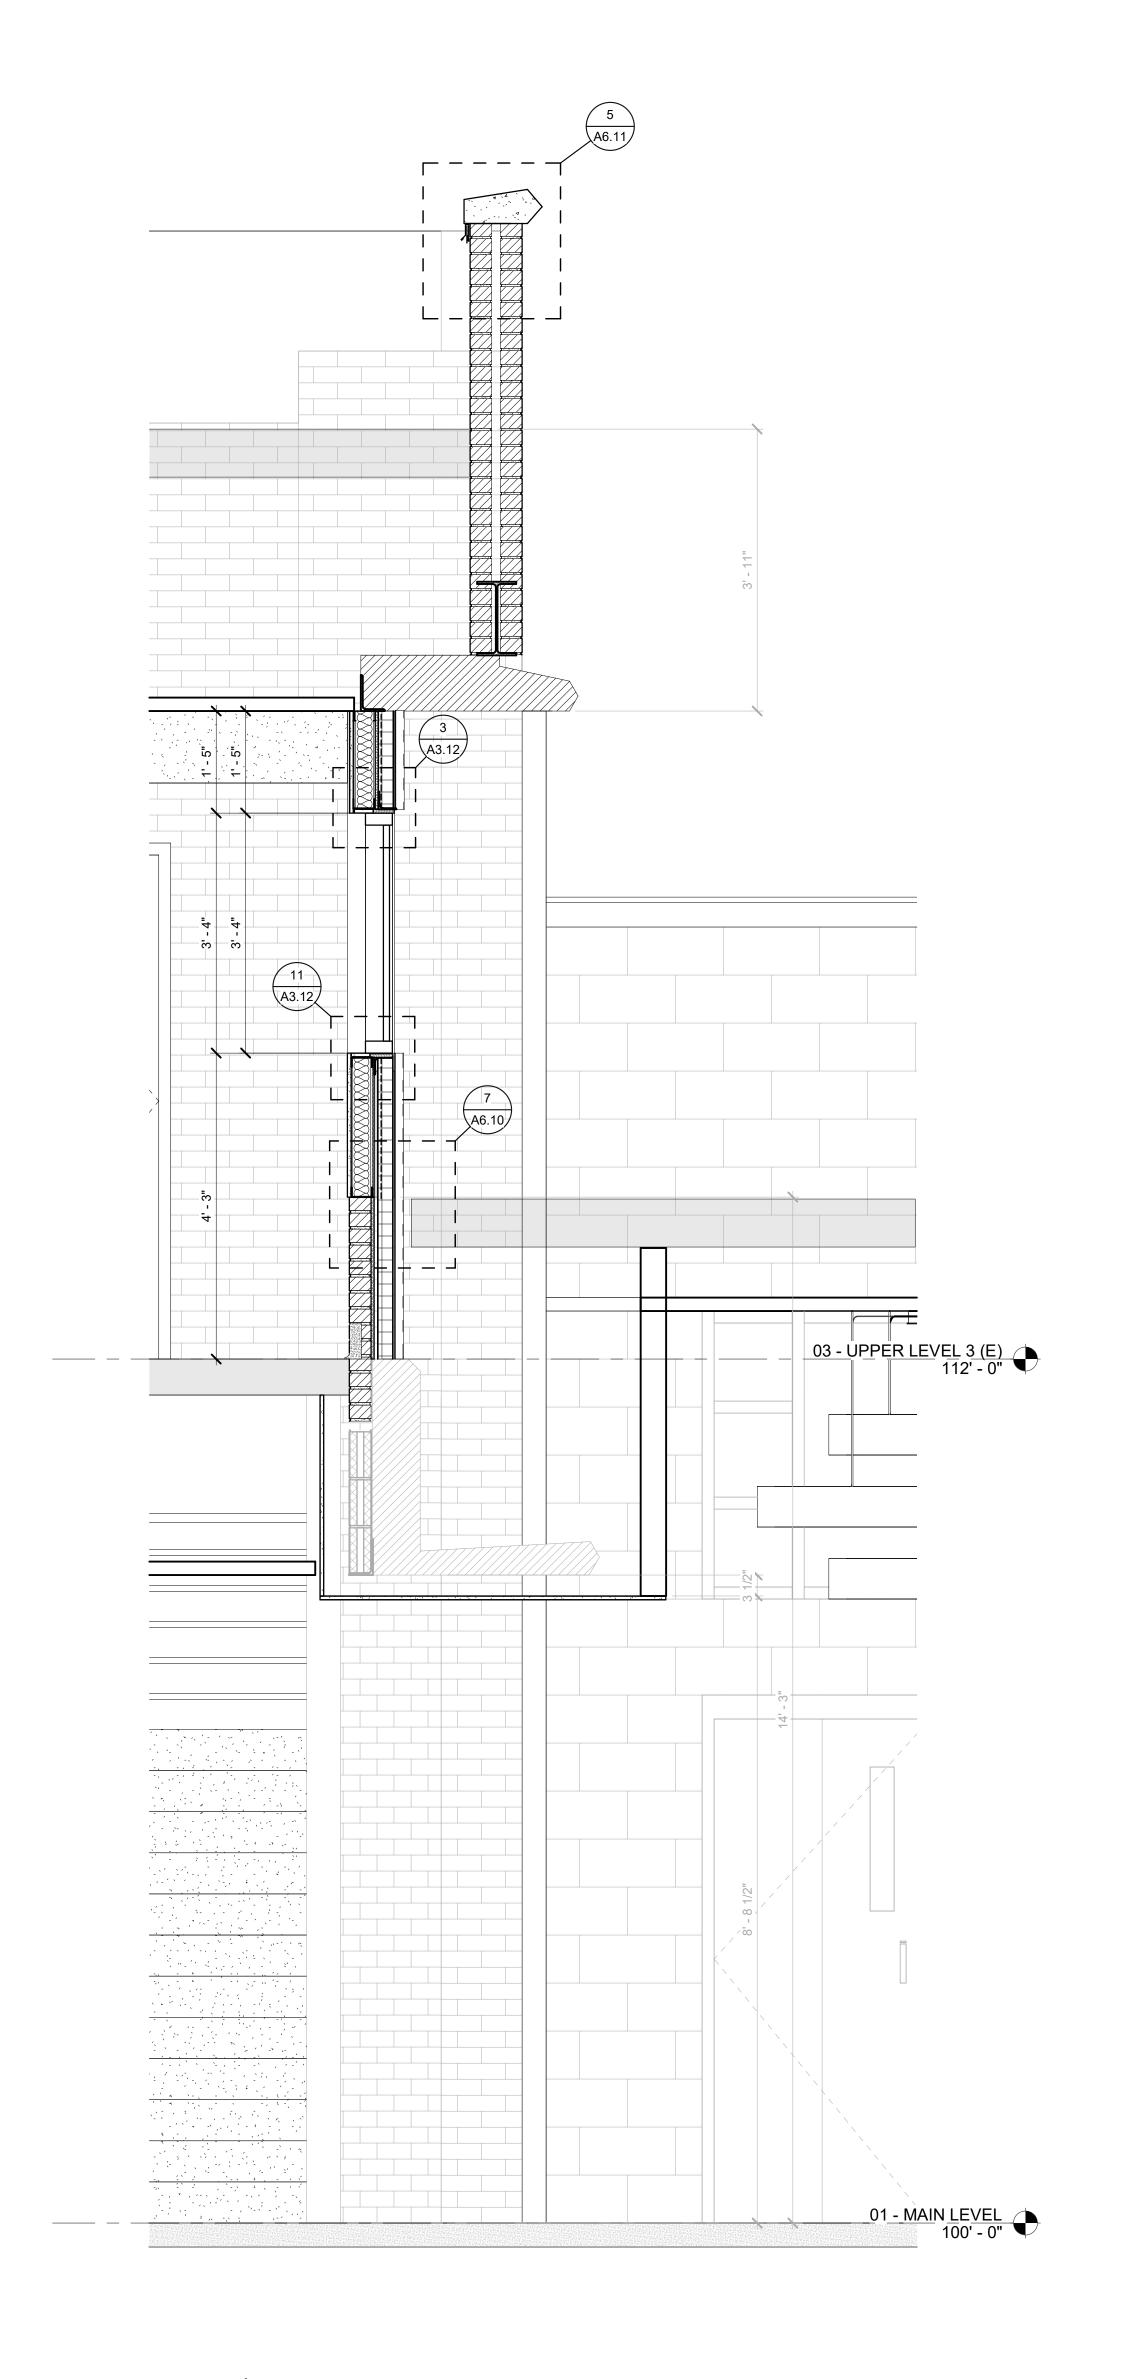



#### (#) MATERIAL KEYNOTES

- 1 CAST STONE PARAPHET CAP 2 1.5 BRICKPROTROSION
- 3 FIXED SUNSCREEN SYSTEM MOUNTED TO VERTICAL MULLIONSBY WINDOW MFR. RE:
- ELVATIONS FOR SPECIFIC LOCATIONS 4 1.5" BRICK PROTRUSION; SOLDIER COURSE
- 5 CAST STONE SILL
- 6 FOOTING AND FOUNDATION (SEE STRUCTURAL)
- 7 CONCRETE SLAB (SEE STRUCTURAL) 8 COMPACTED GRAINULAR FILL
- 9 DOOR (SEE SCHEDULE) 10 GLASS AND GLAZING SYSTEM
- 11 ALUMINUM FRAMING SYSTEM 12 FIXTURE AS OCCUR; RE: ELECTRICAL
- SPALLED BRICK WITHIN THIS AREA WITH NEW. SEE GENERAL NOTE 1 FOR ALLOWANCE. 15 EXISTING MORTAR JOINS WITHIN AREA ARE CRACKED, LOOSE, MISSING, OPEN, OR

14 REMOVE AND REPLACE ALL CRACKED OR

- GENERALLY DETERIORATED. REMOVE ALL IDENTIFIED MORTAR TO MINIMUM DEPTH OF 1" AND REPOINT WITH NEW MORTAR. SEE
- GENERAL NOTE 3 FOR ALLOWANCE. 16 OPEN CRACK IN STONE. INJECT THE CRACK FULL WITH EPOXY AND PATCH/FINISH THE EXTERIOR SURFACE OF THE STONE WITH A COLORED CEMENTITIOUS COMPOUND IN ORDER
- SURFACES OF THE EXISTING STONE. SEE GENERAL NOTE 5 FOR ALLOWANCE. 17 REMOVED EXISTING SEALANT AND BACKER ROD (IF PRESENT) BETWEEN WINDOW OR FRAME.

TO BLEND THE REPAIR INTO THE ADJACENT

- ÀND ADJACENT MASONRY. INSTALL NEW BACKER ROD AND SEALANT. 18 MASONRY CONTRACTOR SHALL OPEN AREAS INDICATED SIMILAR TO CONDITION [SEE DETAILS]. CONTRACTOR SHALL THEN PROVIDE ACCESS FOR ARCHITECT/ENGINEER TO REVIEW.
- CONTRACTOR SHALL INFILL WITH EXISTING KIND MATERIALS. 19 SALVAGE A MINIMUM OF THREE COURSES OF BRICK ABOVE TOP OF WINDOW TO EXPOSE EXISTING LINTEL. REMOVE EXISTING LINTEL AND FLASHING AND INSTALL NEW LINTEL AND THRU WALL FLASHING AND REPLACE BRICK. SEE

ONCE REVIEW IS COMPLETE THEN

- GENERAL NOTE 1, 3, 4 FOR ALLOWNACES. SEE DETAIL 1/A5.13. 2/A5.13. 1 20 SALVAGE STONE HEADER AND ONE COURSE OF BRICK ABOVE HEADER TO EXPOSE EXISTING LINTEL. REMOVE EXISTING LINTEL AND FLASHING AND INSTALL NEW LINTEL AND THRU
- BRICK. SEE GENERAL NOTE 1, 3, 4, FOR ALLOWANCES. SEE DETAIL 3/A5. 3. 21 SAW CUT BRICK, INSTALL A NEW 1/2" VERTICAL EXPANSION JOINT FREE OF MASONRY AND MORTAR FULL DEPTH. FILL JOINT WITH NEW

WALL FLASHING. REINSTALL HEADER AND

BACKER ROD AND SEALANT. SEE DETAI (4/A5.13.

- 22 EXISTING LIMESTONE COPING PIECE TO BE 1 REMOVED AND SALVAGED FOR REINSTALLATION. ALL EXPOSED SURFACES SHALL BE CHEMICALLY CLEANED TO REMOVE DIRT AND STAINS. ALL EXISTING MORTAR AND FLASHING SHALL BE REMOVED FROM HEAD AND BED JOINT SURFACES. INSTALL NEW COPING
- FLASHING ALONG THE ENTIRE LENGTH OF REPLACED COPING. SEE DETAIL 7/A6.11. 23 HATCHING INDICATES AREA OF BRICK WALL TO BE SALVAGED IN ORDER TO REPAIR AND FLASH
- EMBEDDED STEEL CONDITIONS. 24 REMOVE EXISTING ABANDONED ANCHOR. INFILL
- CAVITY WITH MORTAR AND RESEAL. 25 RESEAL GAP WITH SILICONE AROUND EXISTING
- 26 INJECT CONCRETE CRACK FULL WITH EPOXY AND PATCH/FINISH THE EXTERIOR SURFACE WITH CEMENTITIOUS COMPOUND IN ORDER TO BLEND THE REPAIR INTO ADJACENT EXISTING SURFACE. SEE GENERAL NOTE 6 FOR
- ALLOWANCE. 27 CANOPY 28 CAST ALUMINUM LETTERING 18" HIGH
- CENTERED IN FACIA. 29 LIMESTONE BASE COURSE
- 30 MASONRY CONTROL JOINT 31 LIMESTONE BASE COURSE
- REMOVE DIRT & STAINS. ALL MISALIGNED COPING TO BE REMOVED AND REINSTALLED TO MATCH EXISTING. ALL DETERIORATED MORTAR JOINTS AND SEALANT TO BE CLEANED AND REINSTALLED.

ADDENDUM NO. 1 ISSUED FOR BID 08/23/23 DATE REVISION



WTAARCH.COM

**WTA** ARCHITECTS

100 S Jefferson Ave, Suite 601 Saginaw, Michigan 48607

989 752 8107 COPYRIGHT © 2023

PROJECT TITLE

RENOVATION AND ADDITION:

MIDLAND COUNTY ESA


MIDLAND, MICHIGAN

WALL SECTIONS

PROJECT NUMBER SHEET NUMBER 2022006.1


PROJECT DATE A7.04 AUGUST 23, 2023

CHECKED BY

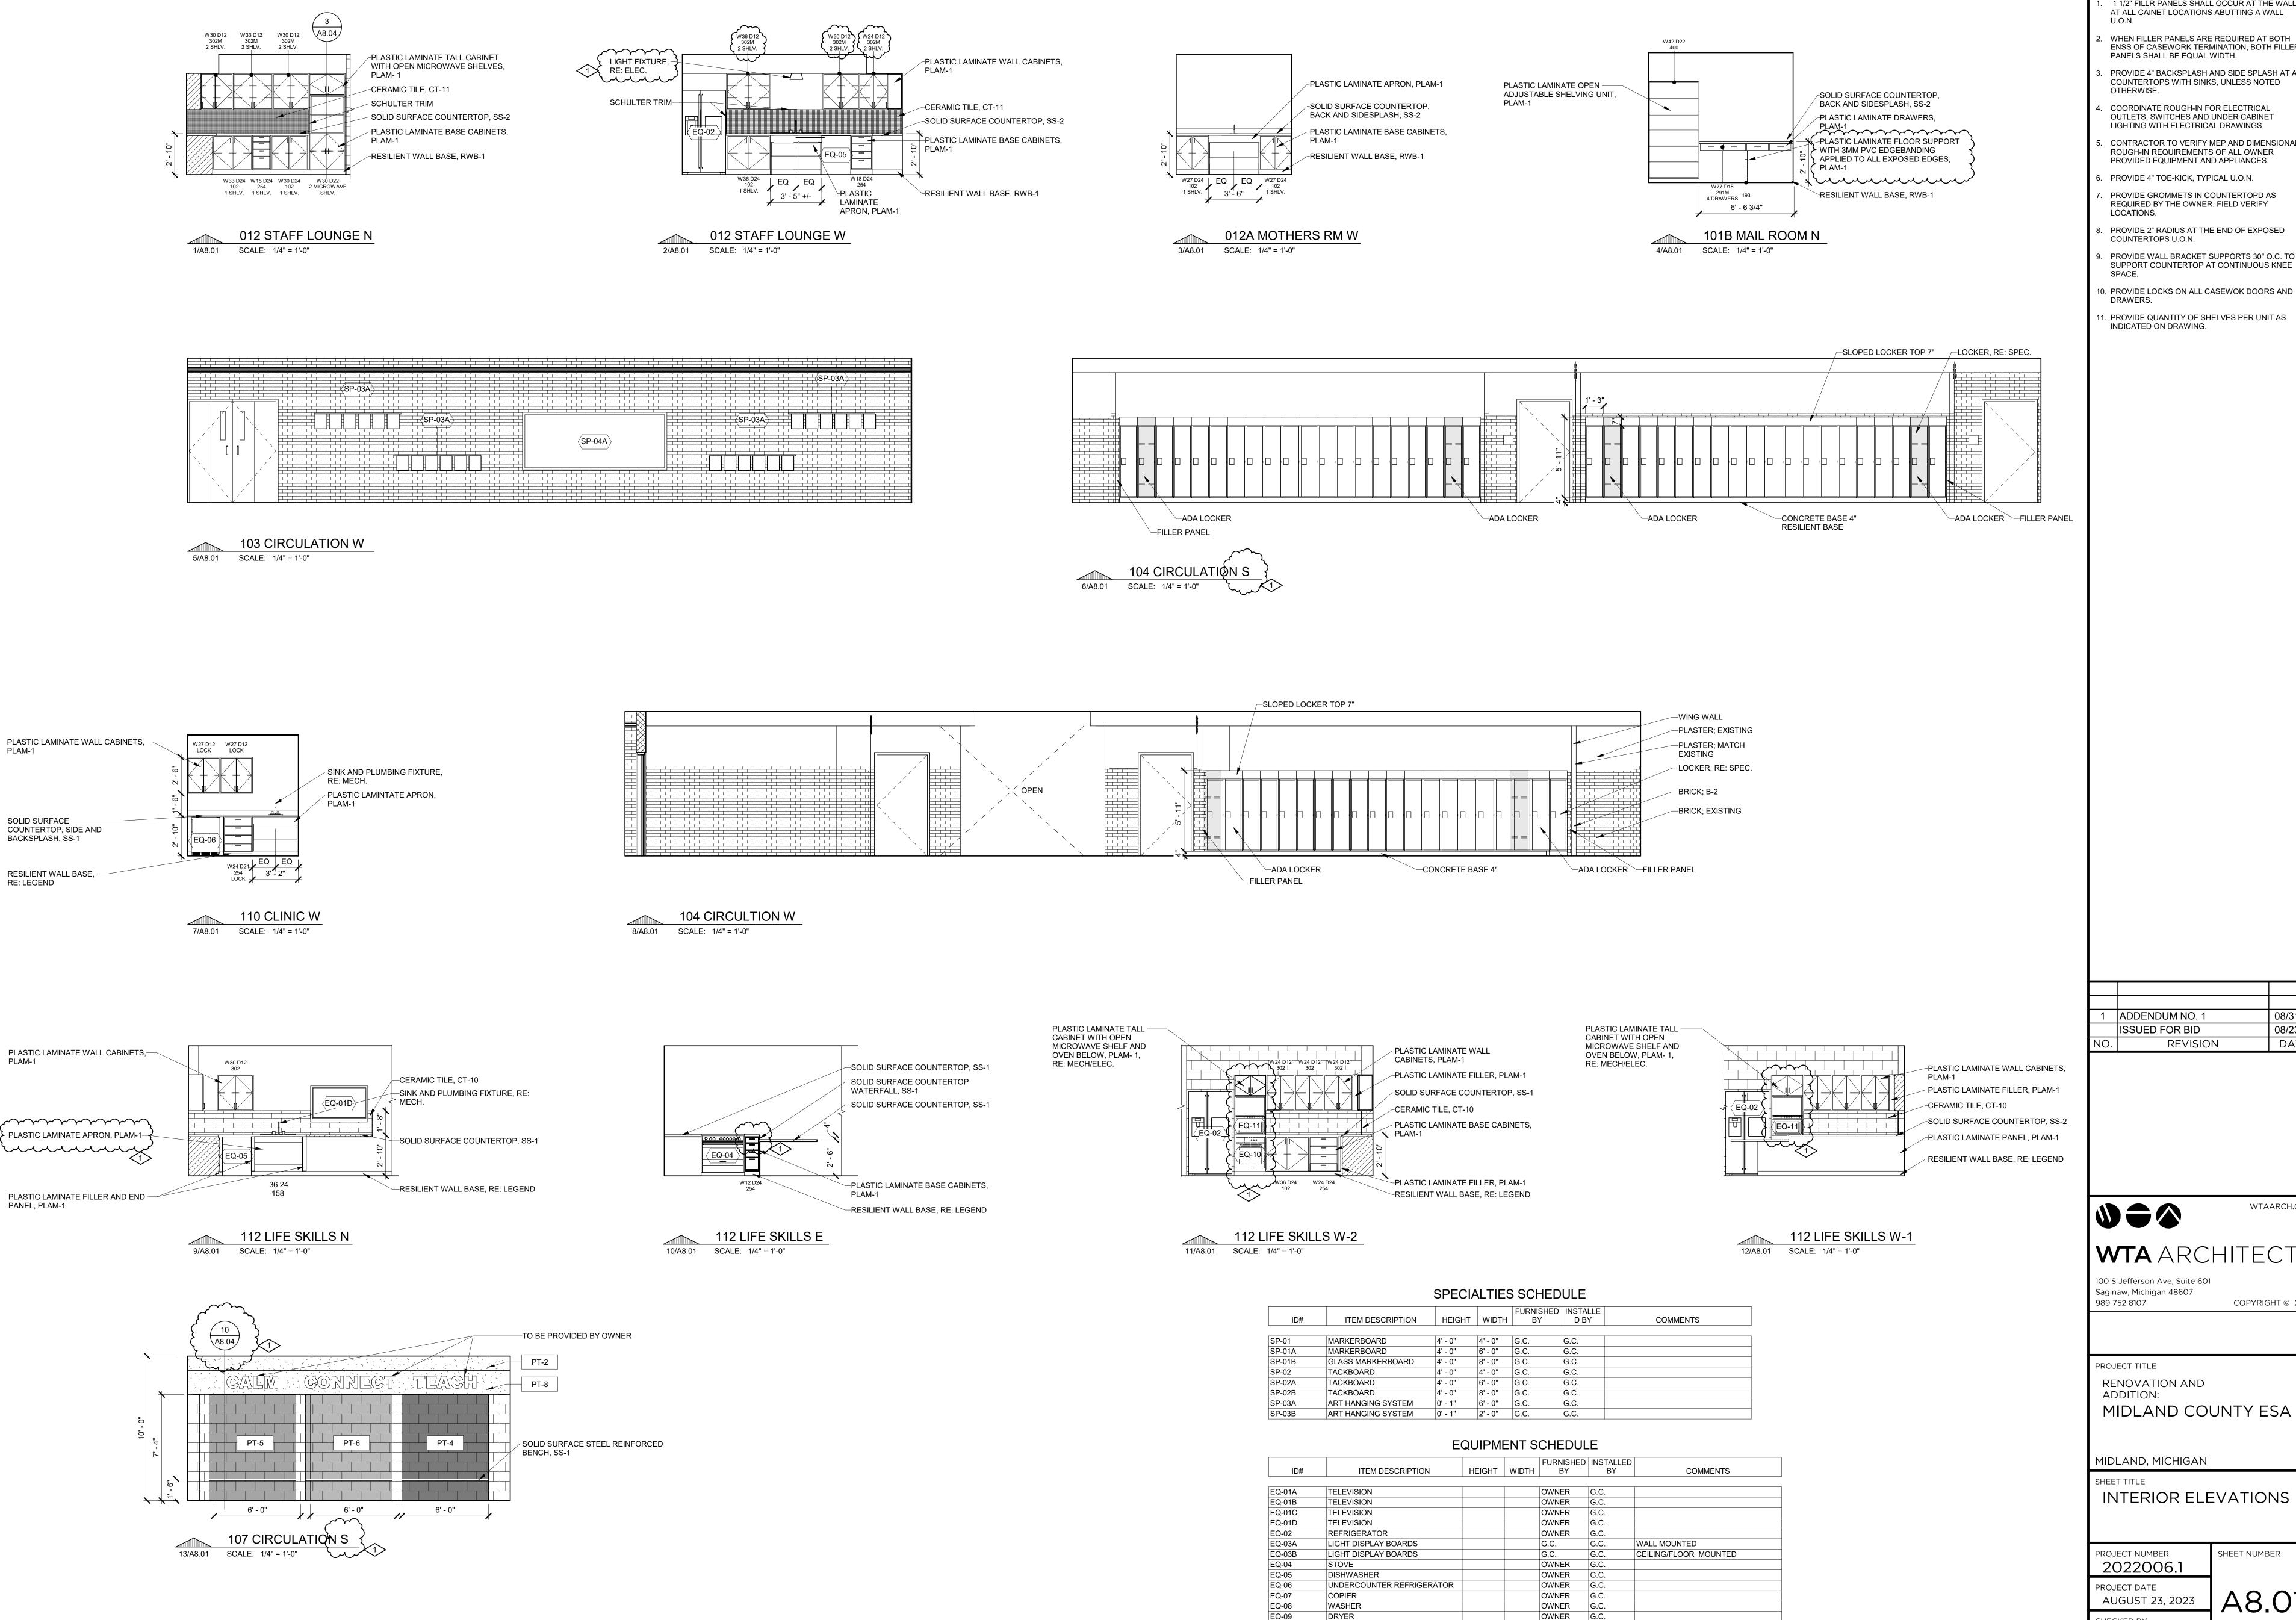

#### **CASEWORK GENERAL NOTES:**

- . 1 1/2" FILLR PANELS SHALL OCCUR AT THE WALL AT ALL CAINET LOCATIONS ABUTTING A WALL
- WHEN FILLER PANELS ARE REQUIRED AT BOTH ENSS OF CASEWORK TERMINATION, BOTH FILLER PANELS SHALL BE EQUAL WIDTH. PROVIDE 4" BACKSPLASH AND SIDE SPLASH AT ALL
- OTHERWISE. COORDINATE ROUGH-IN FOR ELECTRICAL OUTLETS, SWITCHES AND UNDER CABINET
- CONTRACTOR TO VERIFY MEP AND DIMENSIONAL ROUGH-IN REQUIREMENTS OF ALL OWNER
- PROVIDED EQUIPMENT AND APPLIANCES.
- PROVIDE 4" TOE-KICK, TYPICAL U.O.N.
- PROVIDE GROMMETS IN COUNTERTOPD AS REQUIRED BY THE OWNER. FIELD VERIFY LOCATIONS.
- PROVIDE 2" RADIUS AT THE END OF EXPOSED COUNTERTOPS U.O.N.
- PROVIDE WALL BRACKET SUPPORTS 30" O.C. TO SUPPORT COUNTERTOP AT CONTINUOUS KNEE
- 1. PROVIDE QUANTITY OF SHELVES PER UNIT AS
- INDICATED ON DRAWING.

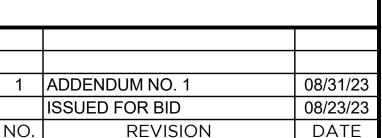



WTAARCH.COM

### **WTA** ARCHITECTS

100 S Jefferson Ave, Suite 601 Saginaw, Michigan 48607

COPYRIGHT © 2023 989 752 8107

PROJECT TITLE

RENOVATION AND ADDITION:

MIDLAND COUNTY ESA

MIDLAND, MICHIGAN

CHECKED BY

JMJ

OWNER G.C.

OWNER


WALL OVEN

MICROWAVE

INTERIOR ELEVATIONS

PROJECT NUMBER SHEET NUMBER 2022006.1 PROJECT DATE AUGUST 23, 2023

A8.01

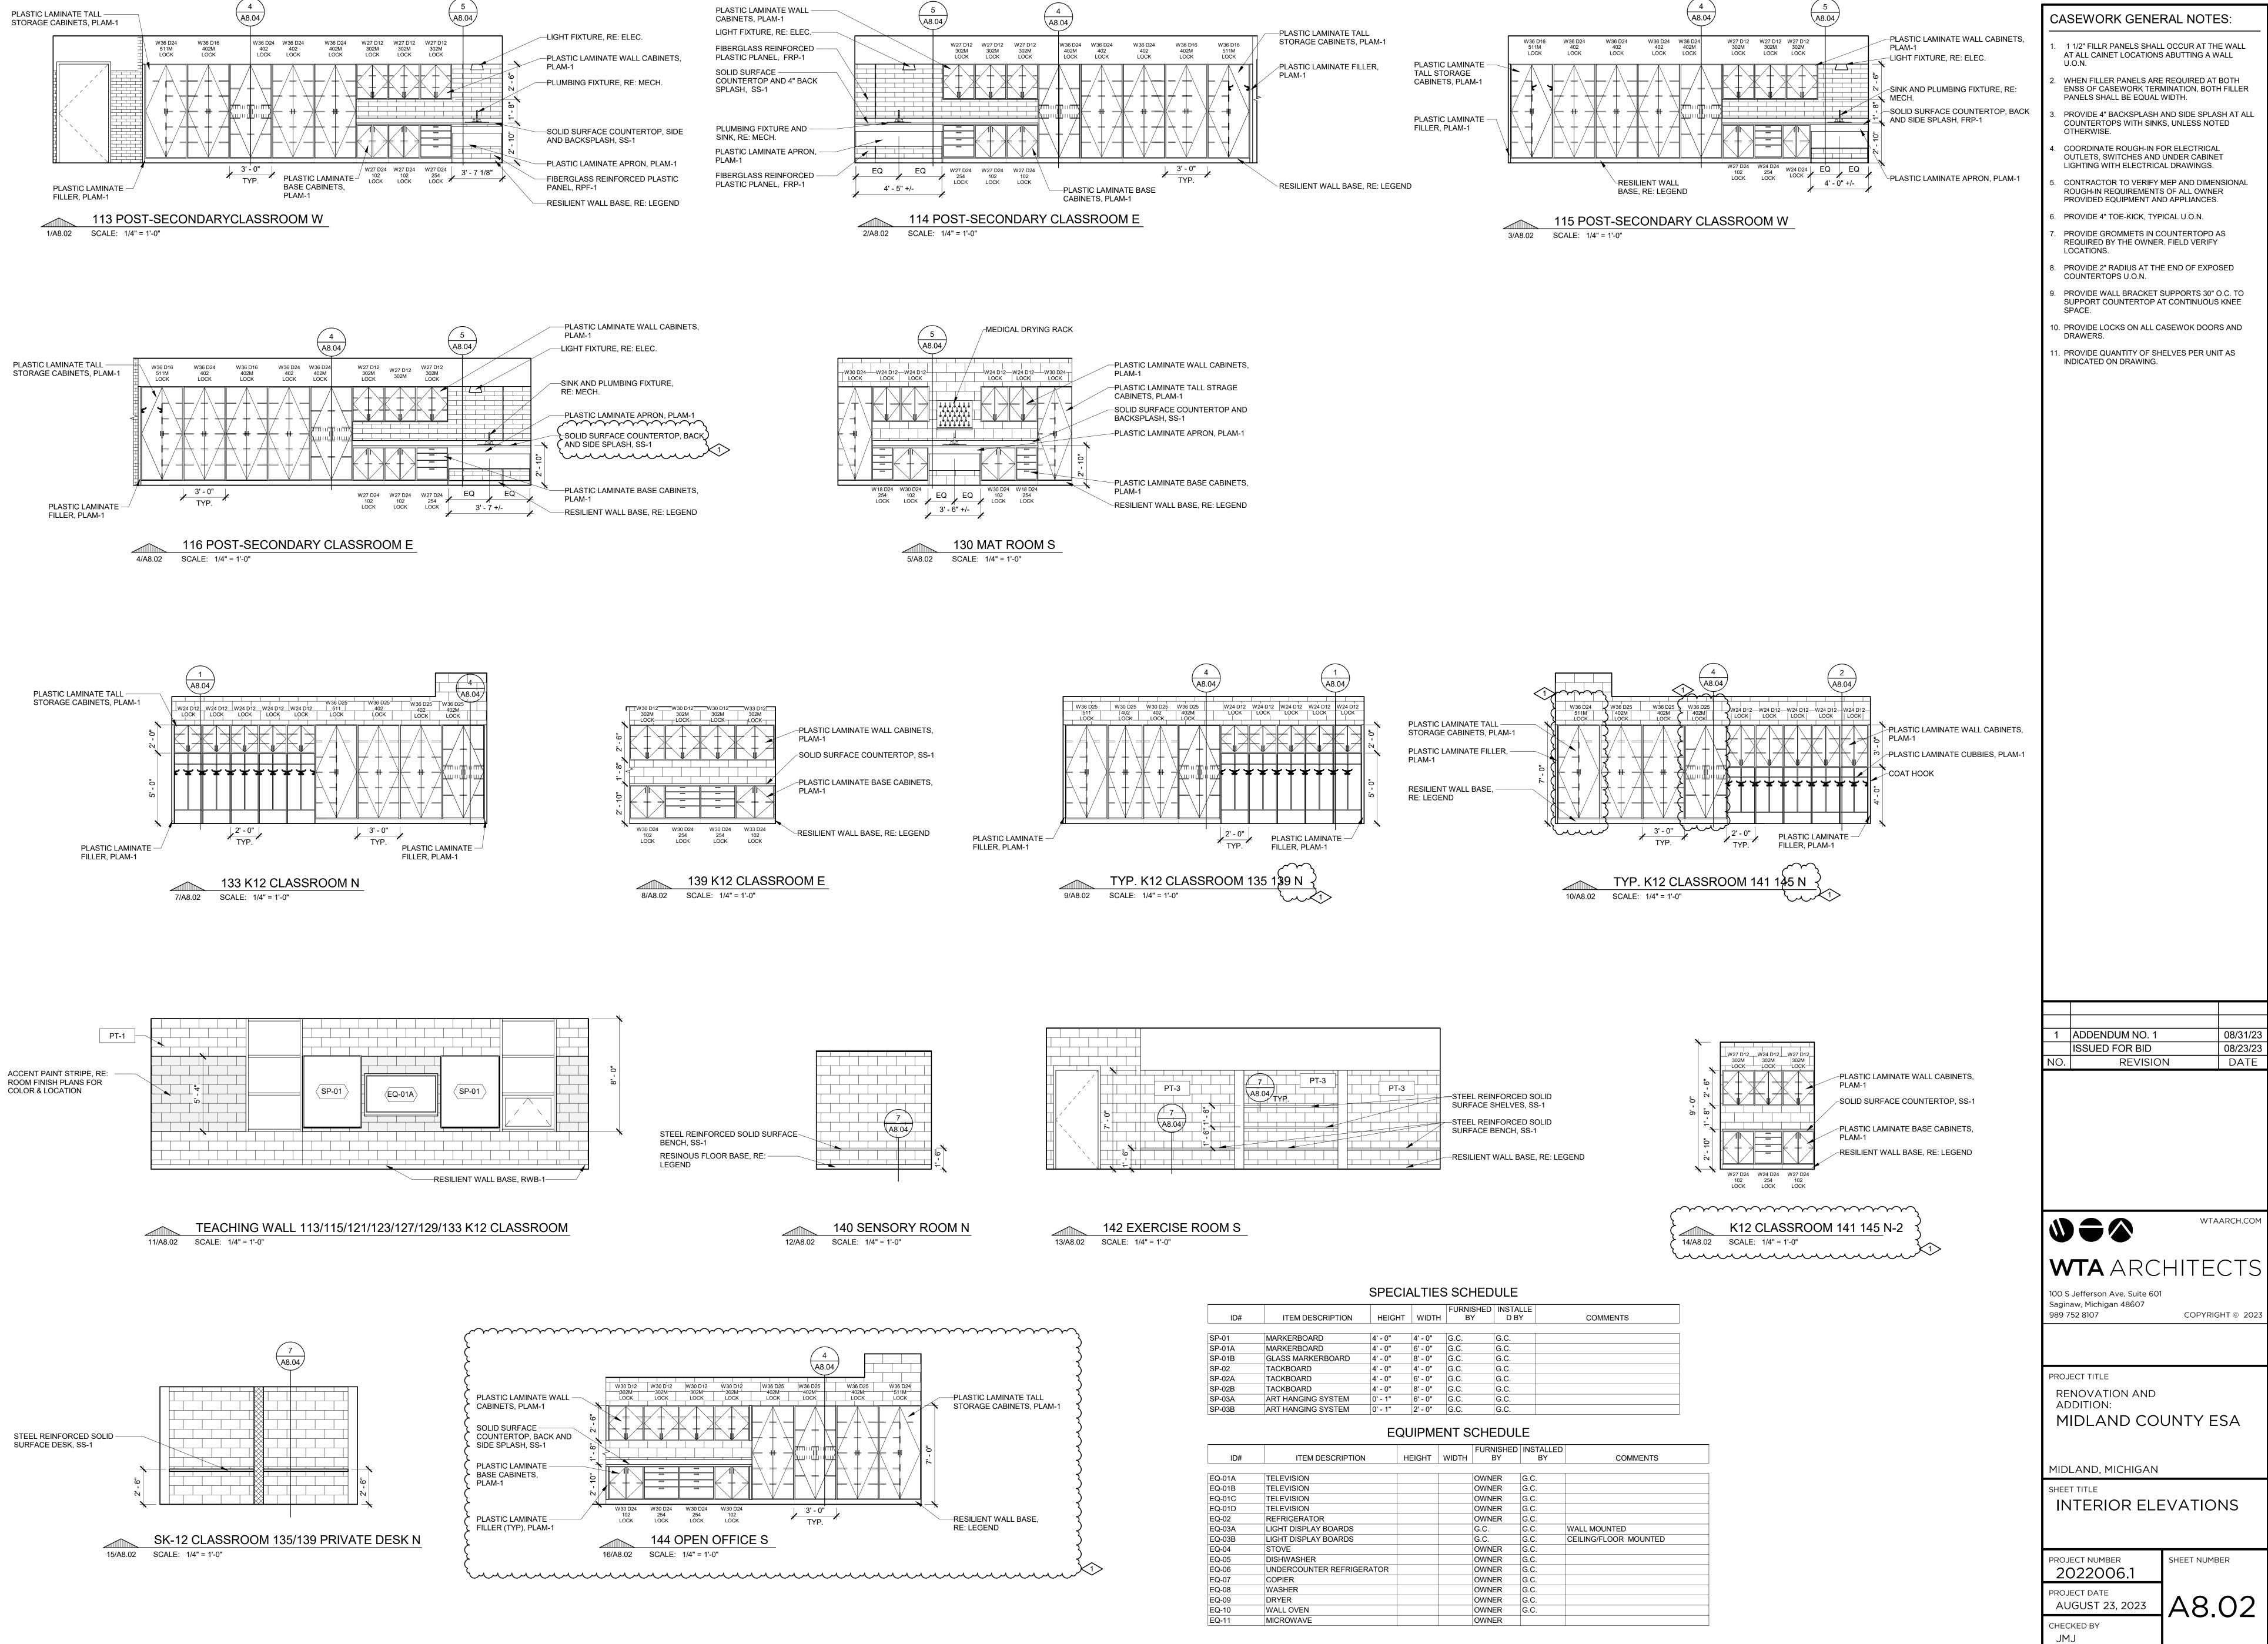

**CASEWORK GENERAL NOTES:** 

1 1/2" FILLR PANELS SHALL OCCUR AT THE WALL AT ALL CAINET LOCATIONS ABUTTING A WALL

ENSS OF CASEWORK TERMINATION, BOTH FILLER PROVIDE 4" BACKSPLASH AND SIDE SPLASH AT ALL

COORDINATE ROUGH-IN FOR ELECTRICAL OUTLETS, SWITCHES AND UNDER CABINET

CONTRACTOR TO VERIFY MEP AND DIMENSIONAL ROUGH-IN REQUIREMENTS OF ALL OWNER PROVIDED EQUIPMENT AND APPLIANCES.

PROVIDE GROMMETS IN COUNTERTOPD AS REQUIRED BY THE OWNER. FIELD VERIFY


PROVIDE 2" RADIUS AT THE END OF EXPOSED


PROVIDE WALL BRACKET SUPPORTS 30" O.C. TO SUPPORT COUNTERTOP AT CONTINUOUS KNEE

08/23/23 DATE

MIDLAND COUNTY ESA

SHEET NUMBER

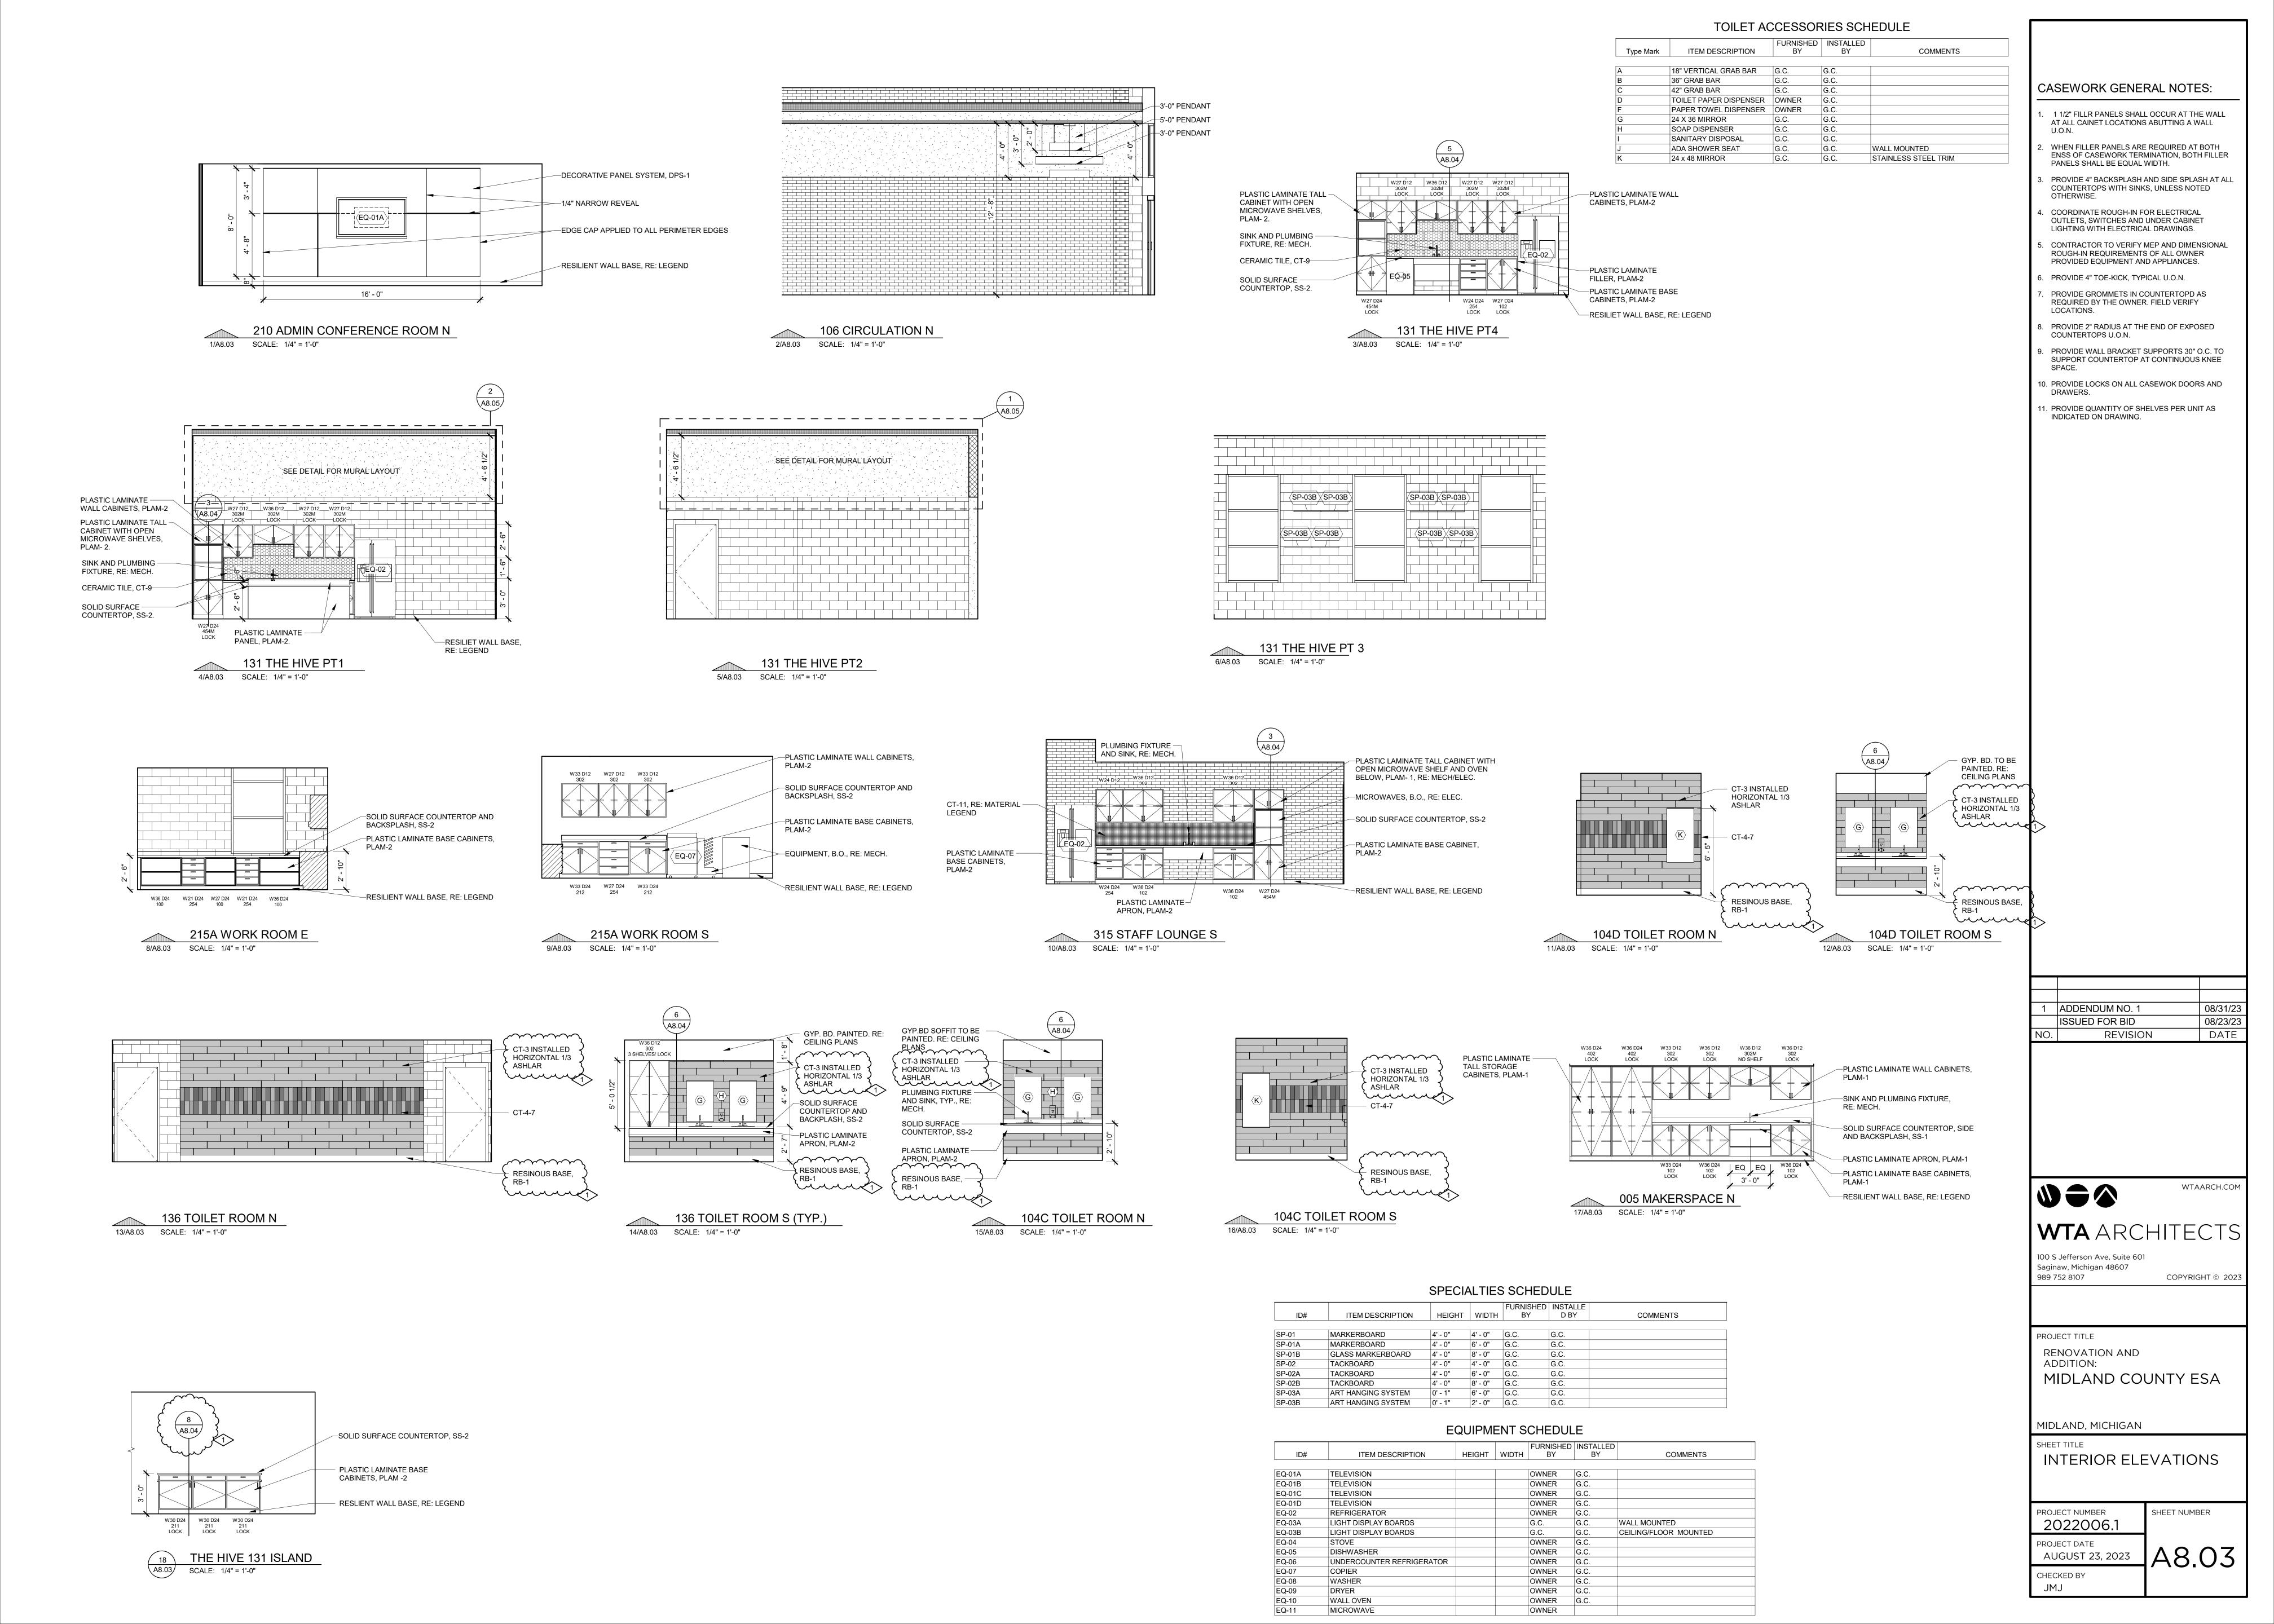

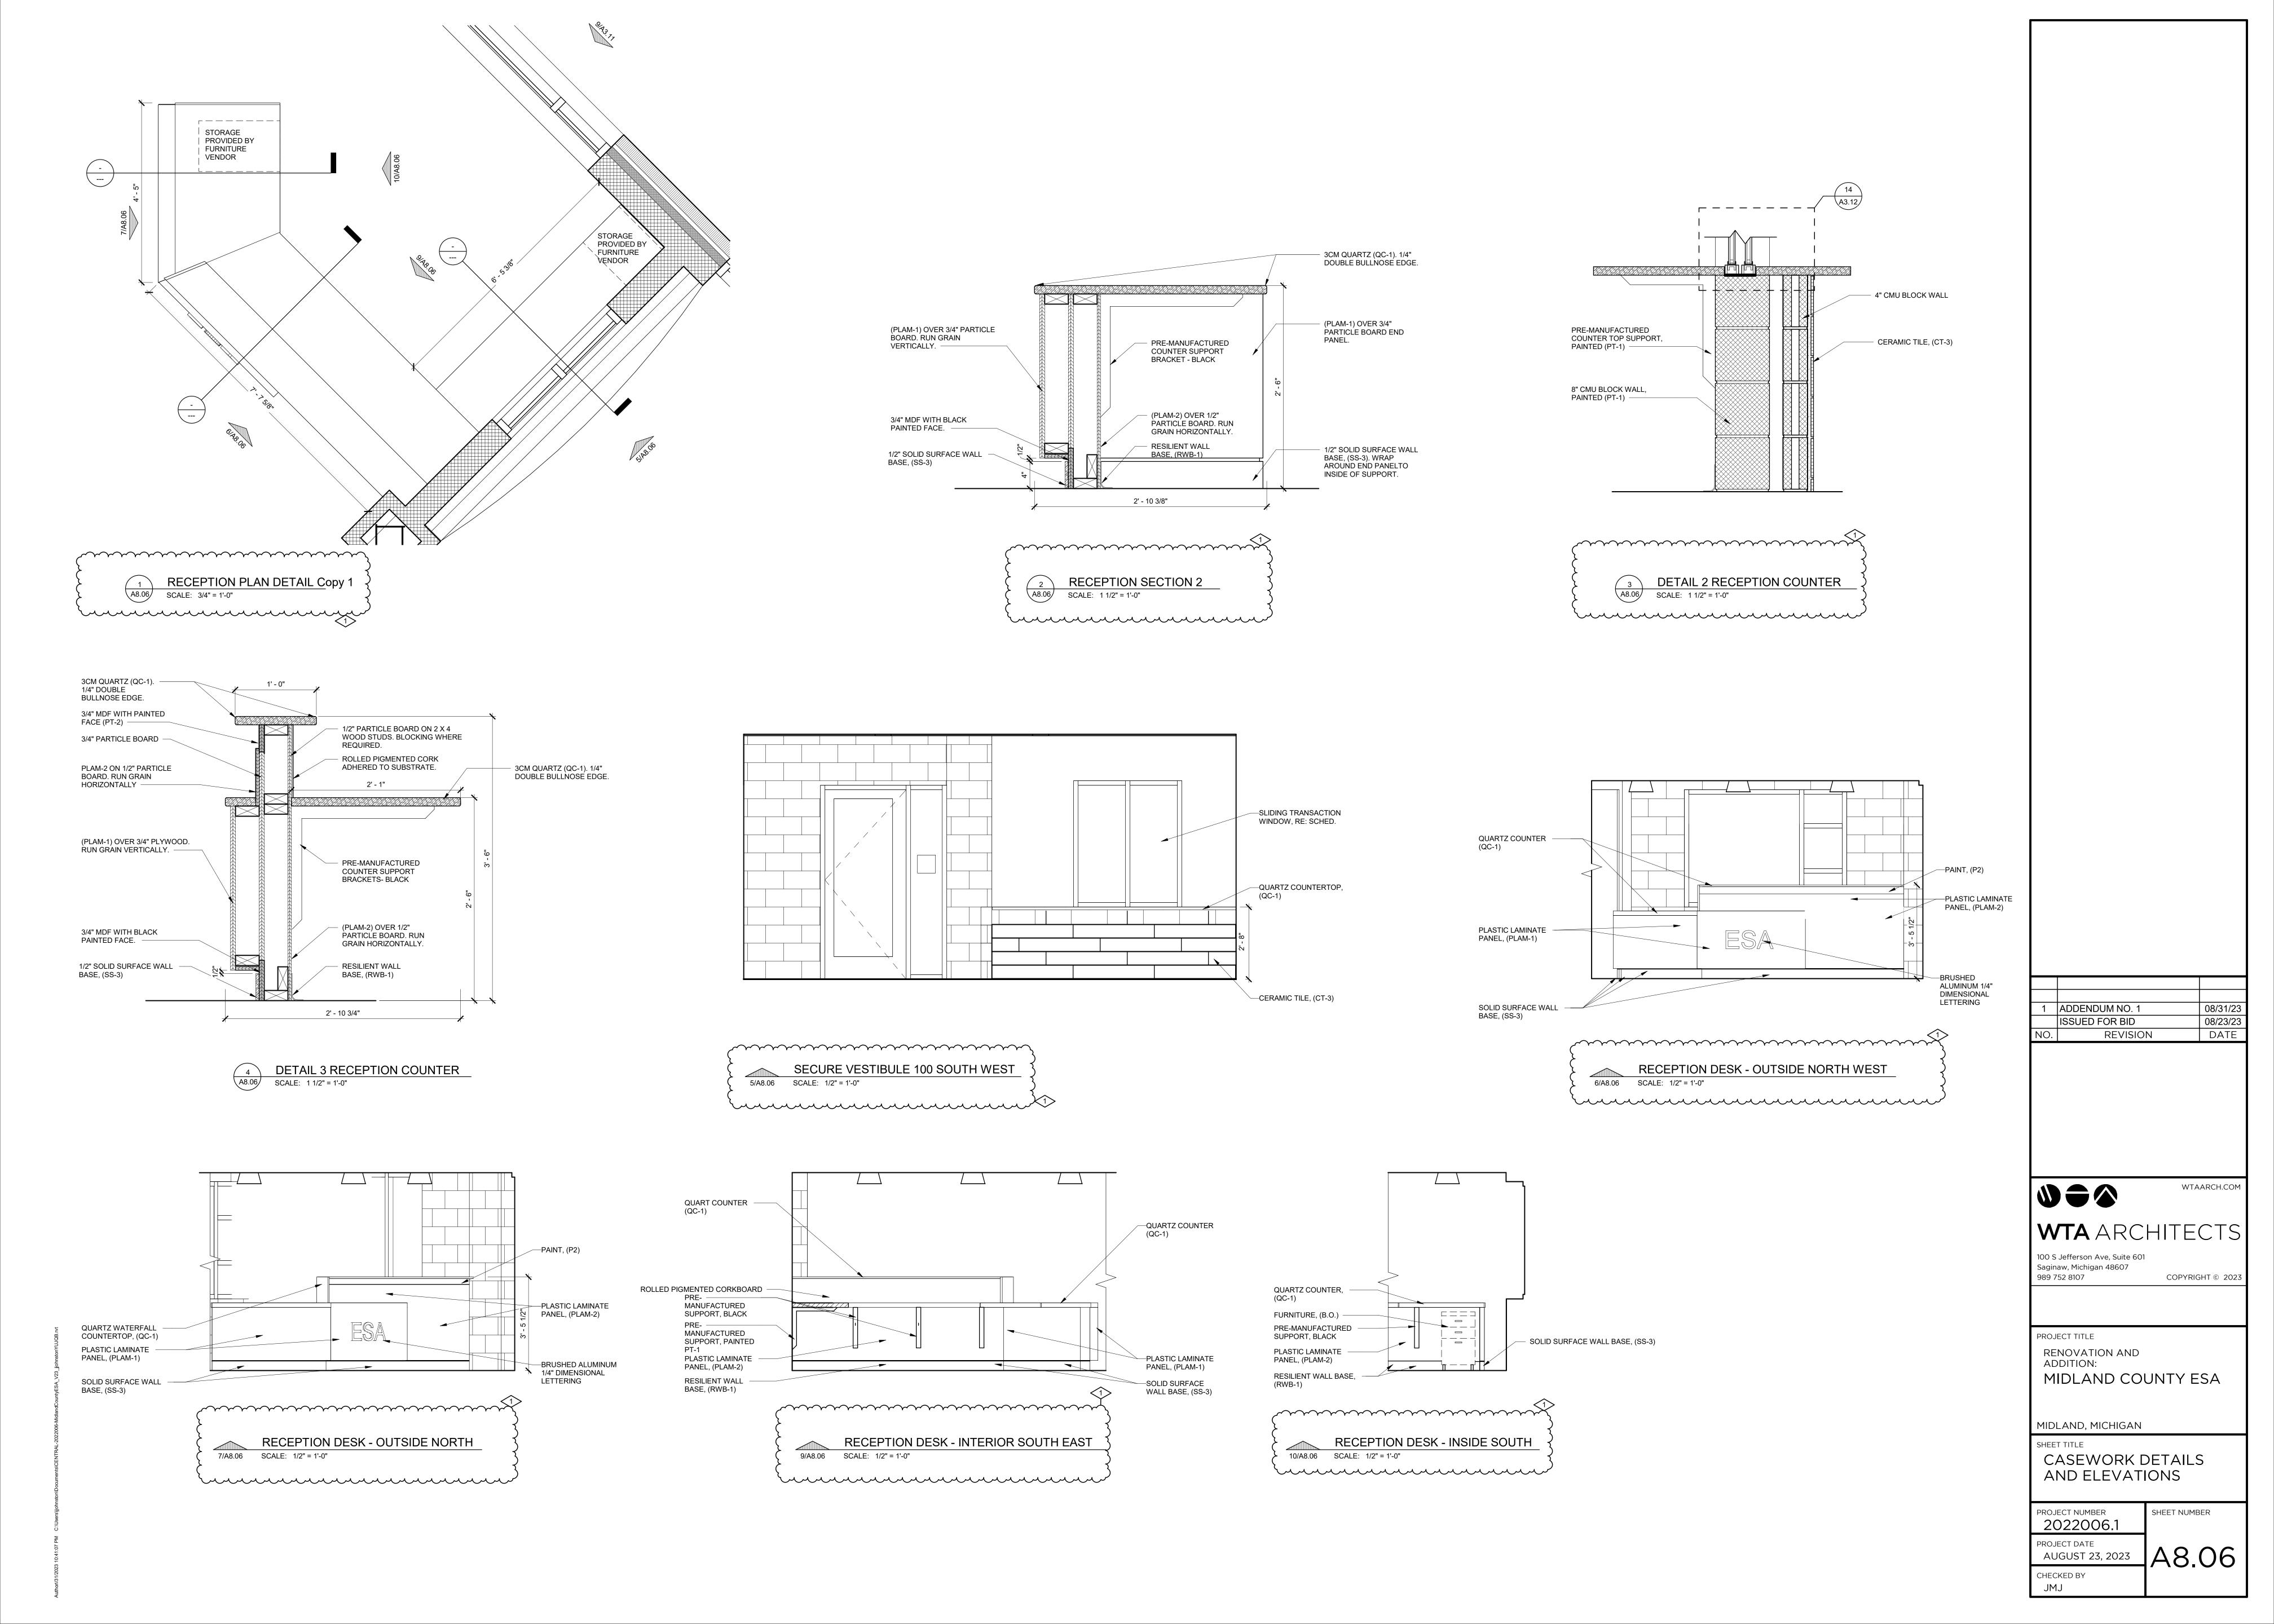



#### REFLECTED CEILING LEGEND:

2x4 LIGHT FIXTURE (REFER TO ELECTRICAL





2 X 2 LIGHT FIXTURE (REFER TO ELECTRICAL



WALL MOUNTED LIGHT FIXTURE (REFER TO ELECTRICAL)

UNDER COUNTER LIGHT FIXTURE (REFER TO ELECTRICAL) SUPPLY AIR DIFFUSER (REFER TO MECHANICAL)


RETURN AIR DIFFUSER (REFER TO MECHANICAL)

MECHANICAL ITEM (REFER TO MECHANICAL) EXIT LIGHT FIXTURE (REFER TO ELECTRICAL


#### CEILING TYPES

(ACT-1) 2x2 CEILING (MIN. NRC .7)


(ACT-2) SECURE LAY-IN CEILING SYSTEM

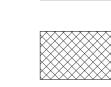


(AP-1) TECTUM SHAPES HEXAGON; COLOR AS INDICATED IN FINISH SCHEDULE

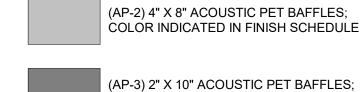

COLOR INDICATED IN FINISH SCHEDULE

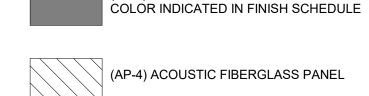

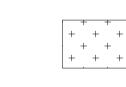

+ + + + EXPOSED CEILING; PAINT STRUCTURE + + + AND EXPOSED CEILING PT-10. ALL + + + ADJACENT SURFACES TO BE CLEANED OF OVERSPRAY.




EXPOSED CEILING; PAINT



GYPSUM BOARD CEILING, PAINT.



SUSPENDED 8'-0" X 8' - 0" UNISTRUT GRID AT 10' - 0" A.F.F.;PAINTED, FINISH PT-11

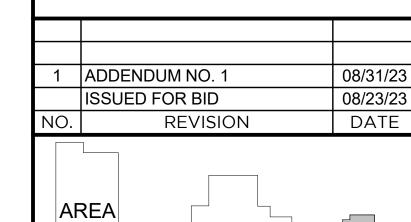

CEILING PLAN GENERAL NOTES:

THE FINISH FLOOR BELOW.

HEADS IN CEILING SYSTEM U.O.N.

TO PROCEEDING WITH WORK.

SPECIAL FINISHES.

OTHERWISE.

INTERIOR ELEVATIONS.

COORDINATE WITH ELECTRICAL.

C# CEILING KEYNOTES

FINAL DESIGN BY SUPPLIER CEILING LIFT SYSTEM PRIVACY CURTAIN TRACK

FIXTURES U.O.N.

ROOM U.O.N.

ALL NOTED CEILING HEIGHTS ARE RELATIVE TO

ALL DIMENSIONS ARE TO FINISH FACE OF SOFFIT OR PARTITION AND TO CENTERLINE OF LIGHT

CENTER CEILING GRID IN BOTH DIRECTIONS IN

CENTER RECESSED DOWN LIGHTS AND SPRINKLER

REFER TO MECHANICAL DRAWINGS FOR DIFFUSER

TYPES. REFER TO ARCHITECTURAL DRAWINGS FOR

ARCHITECT OF ANY POTENTIAL CONFLICTS PRIOR

DRAWINGS FOR EXACT PLACEMENT OF FIXTURES. NOTIFY ARCHITECT OF ANY POTENTIAL CONFLICTS

SEE INTERIOR ELEVATIONS ON THE A8.0 SHEETS

OR DEDICATED INTERIOR REFLECTED CEILING PLANS, AS OCCURS FOR ACCENT COLORS AND

UNDER CABINET LIGHTING (UCL) INDICATED ON

. ALL AREAS EXPOSED TO STRUCTURE WILL HAVE

10. ACCENT PAINT NOTED ON CEILING SOFFITS TO COVER VERTICAL & HORIZONTAL FACES.

2. ALL WALLS ARE TO GO TO THE UNDERSIDE OF THE DECK U.O.N. PROVIDE ACOUSTICAL SEALANT BETWEEN ALL CLASSROOM, WORK ROOM, LOUNGES, CONFERENCE AND OFFICE SPACES

UNISTRUT GRID; B.O.D. PART NO. UGR-B-2P-66-HD;

SEE STRUCTURAL FOR FINAL DESIGN LOADS,

1. ALL GYP. BD. CEILINGS & BULKHEADS TO BE PAINTED PT-11 (WHITE) UNLESS NOTED


EXPOSED WIRING PLACED IN FLEXIBLE CONDUIT.

EXACT PLACEMENT OF DEVICES. NOTIFY

REFER TO ELECTRICAL DRAWINGS FOR LIGHT

FIXTURE TYPES. REFER TO ARCHITECTURAL

PRIOR TO PROCEEDING WITH WORK.

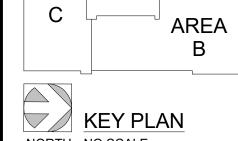



WTAARCH.COM

### **WTA** ARCHITECTS

100 S Jefferson Ave, Suite 601

Saginaw, Michigan 48607 989 752 8107 COPYRIGHT © 2023

PROJECT TITLE

RENOVATION AND ADDITION:

MIDLAND COUNTY ESA

MIDLAND, MICHIGAN


REFLECTED CEILING PLAN - AREA A - LOWER


PROJECT NUMBER 2022006.1 PROJECT DATE


A9.10

SHEET NUMBER

AUGUST 23, 2023 CHECKED BY JMJ

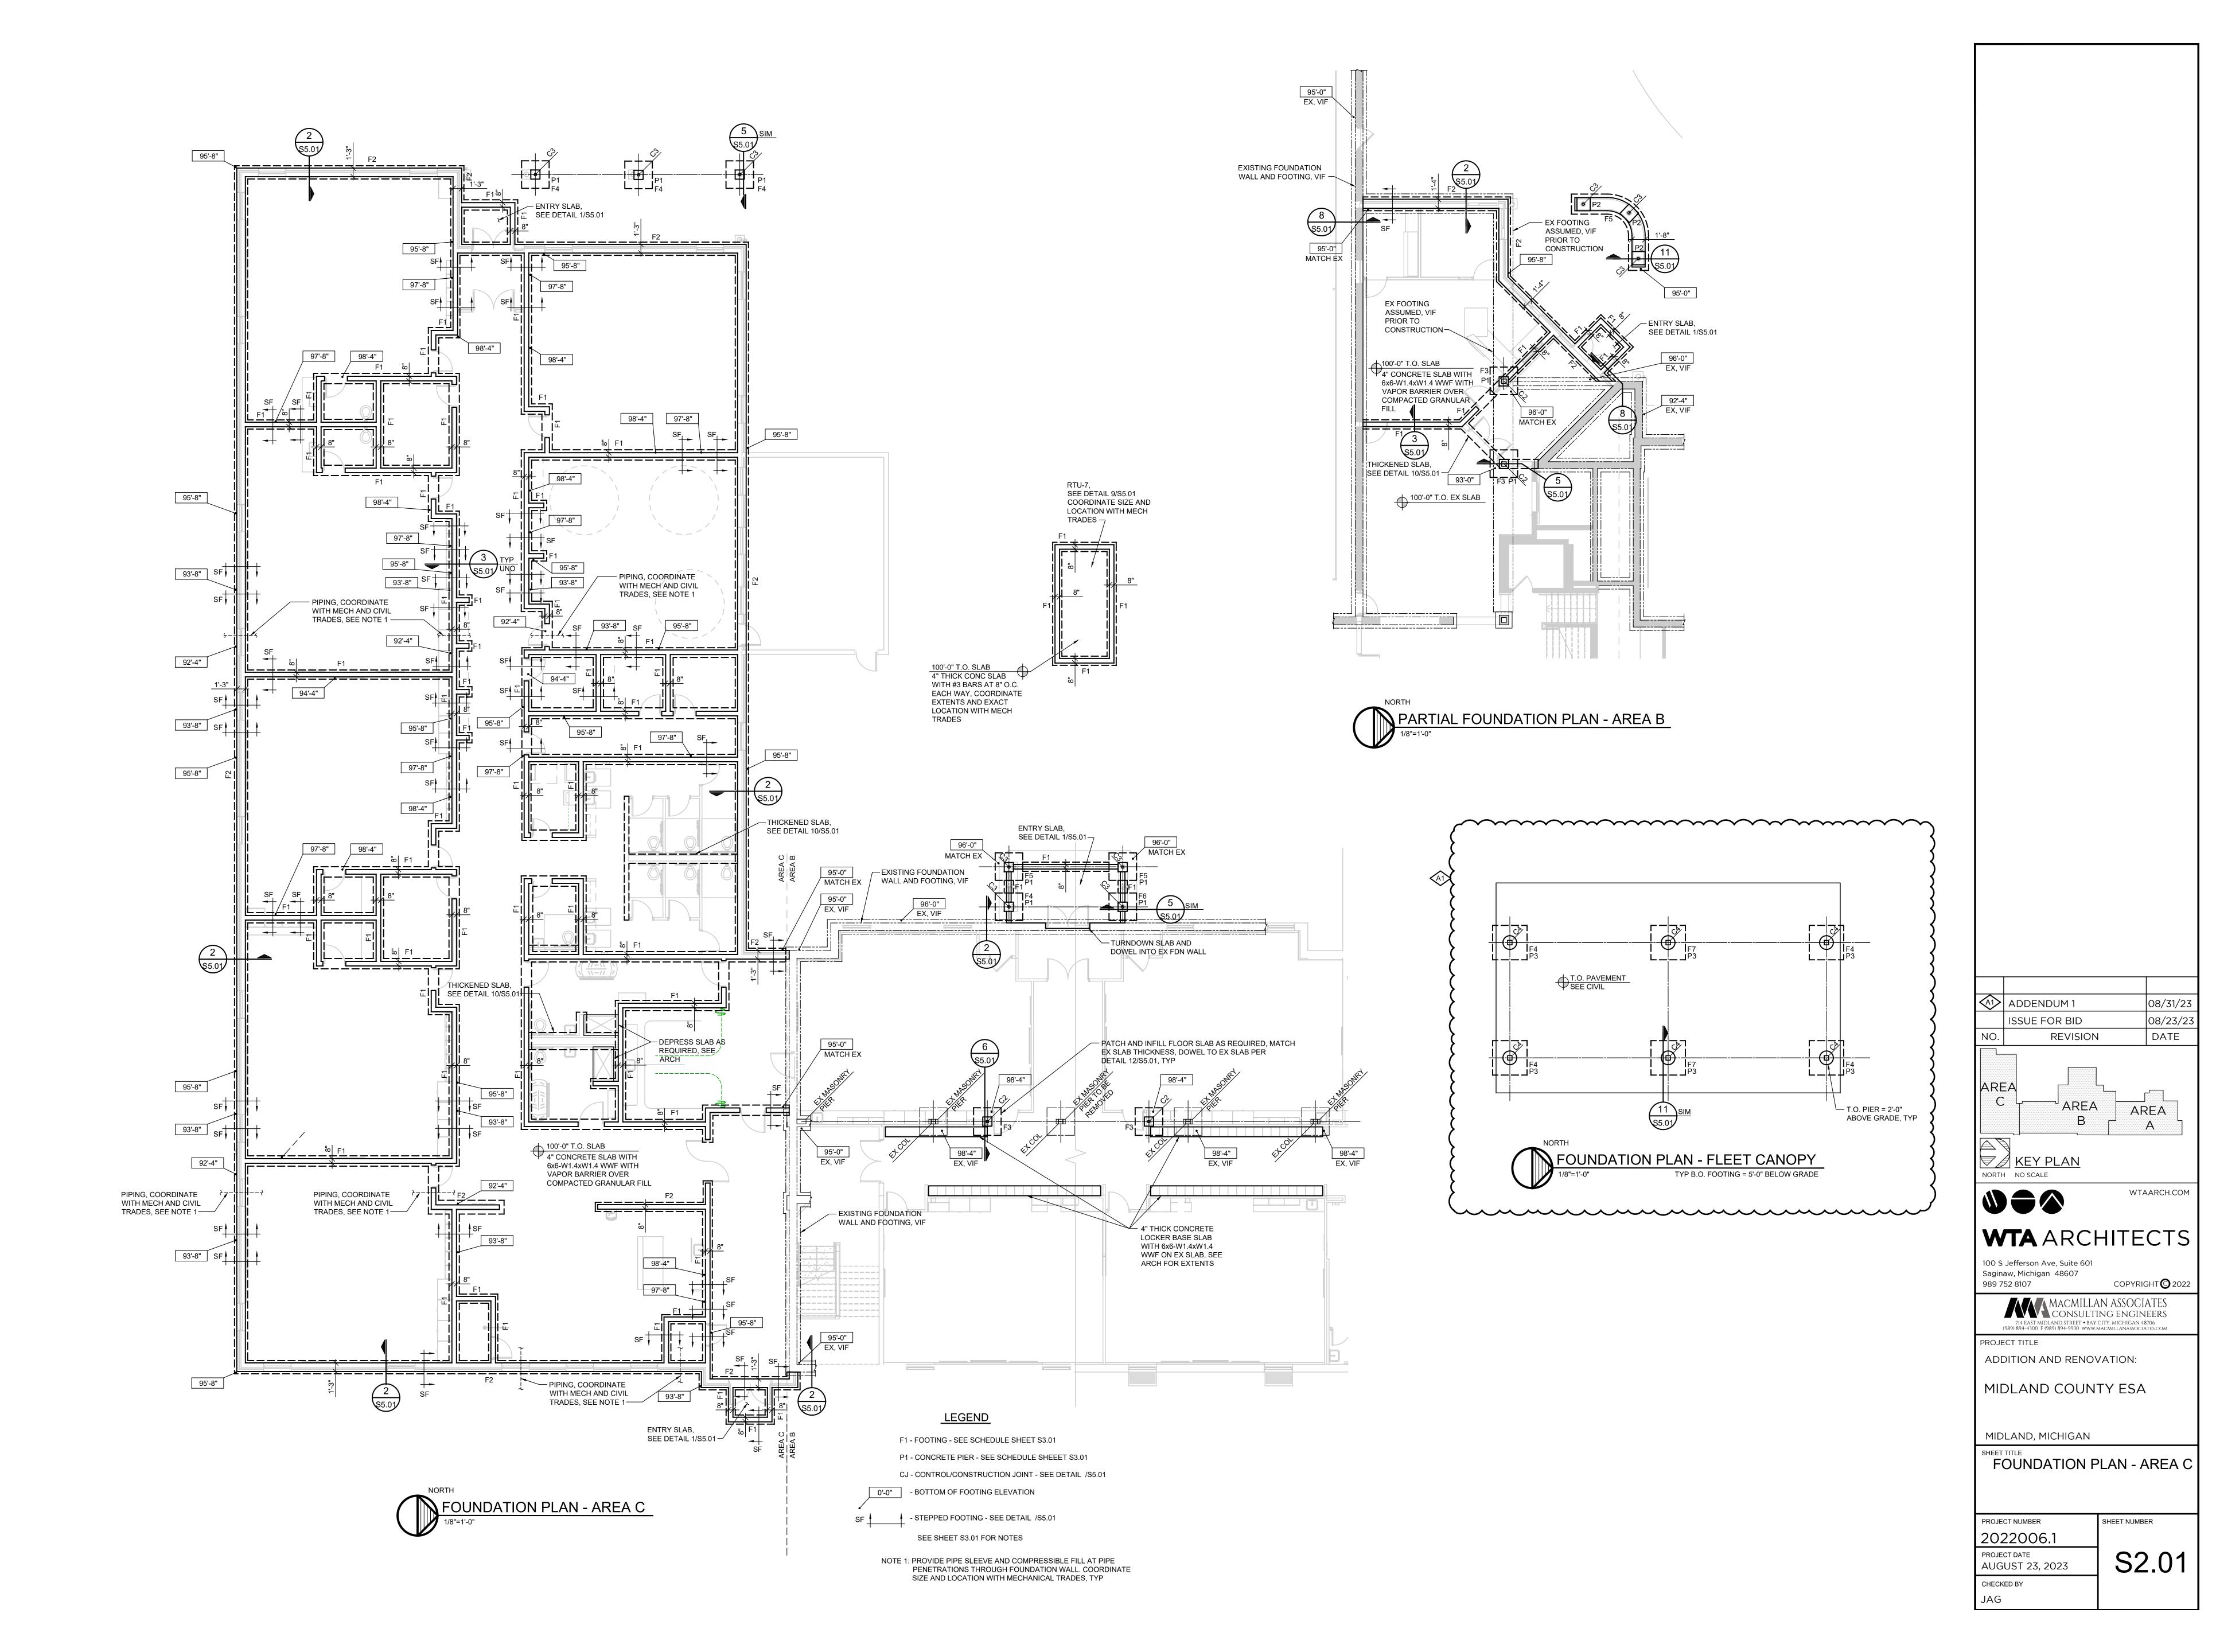


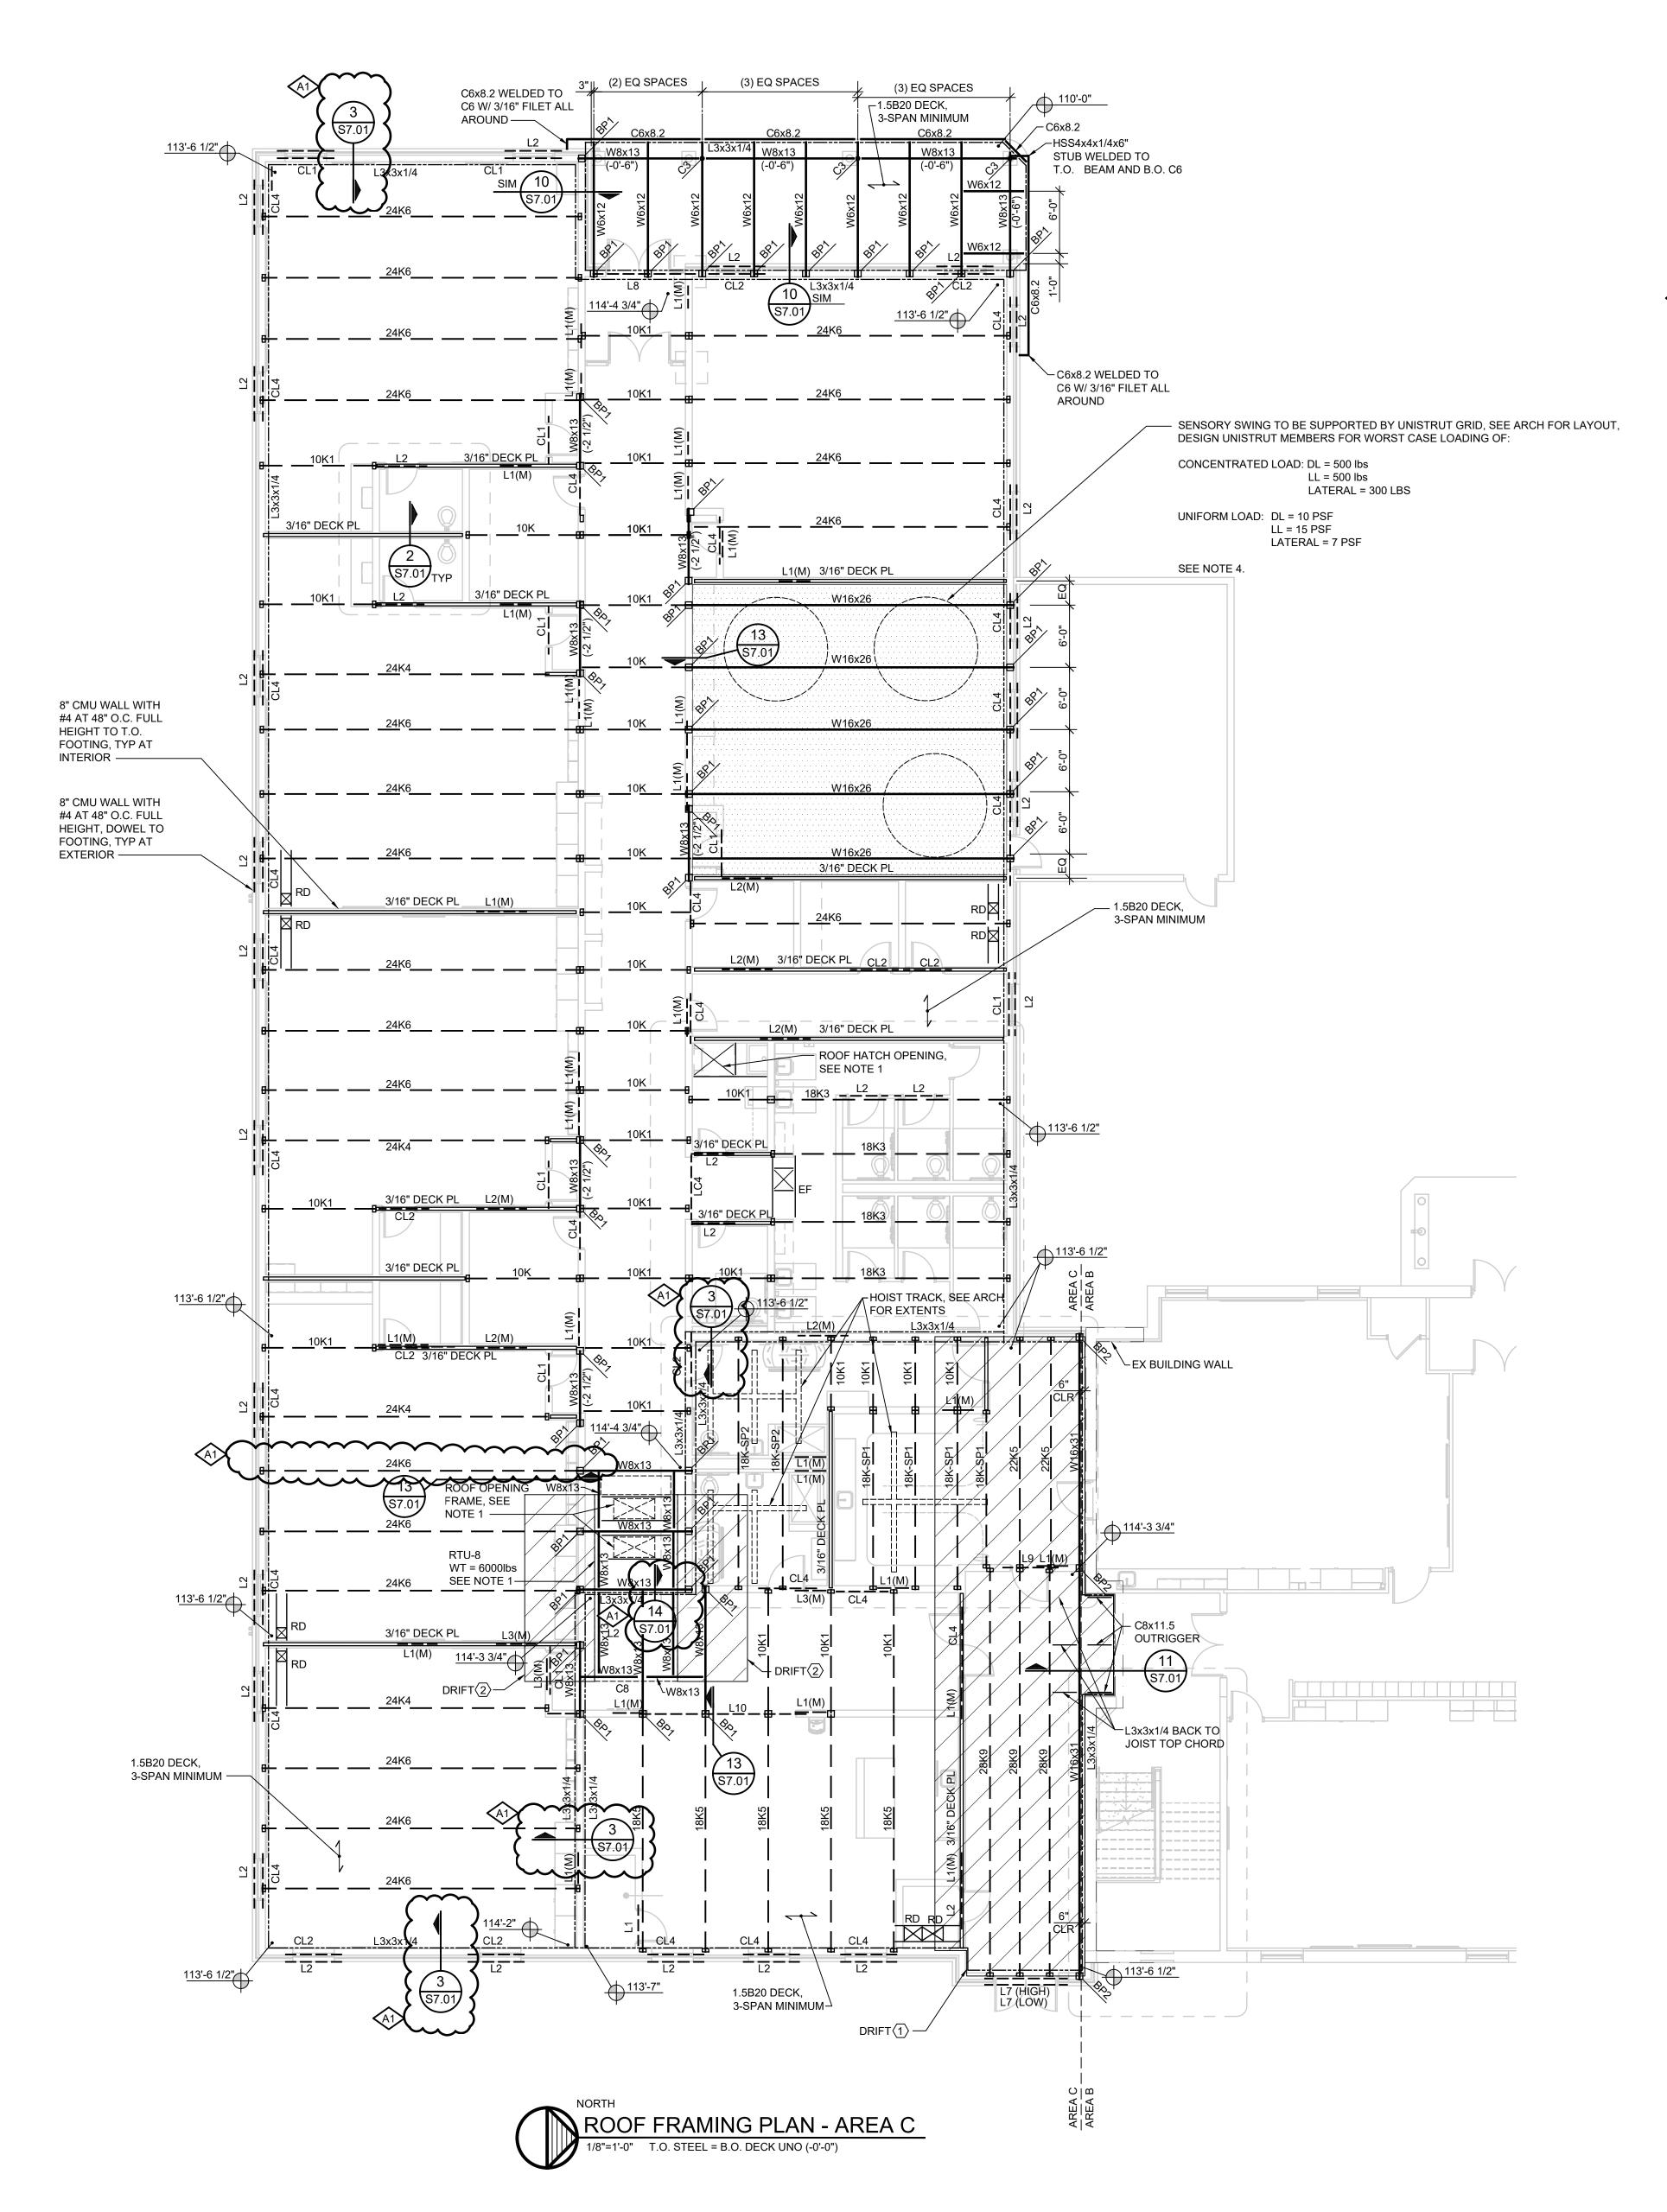

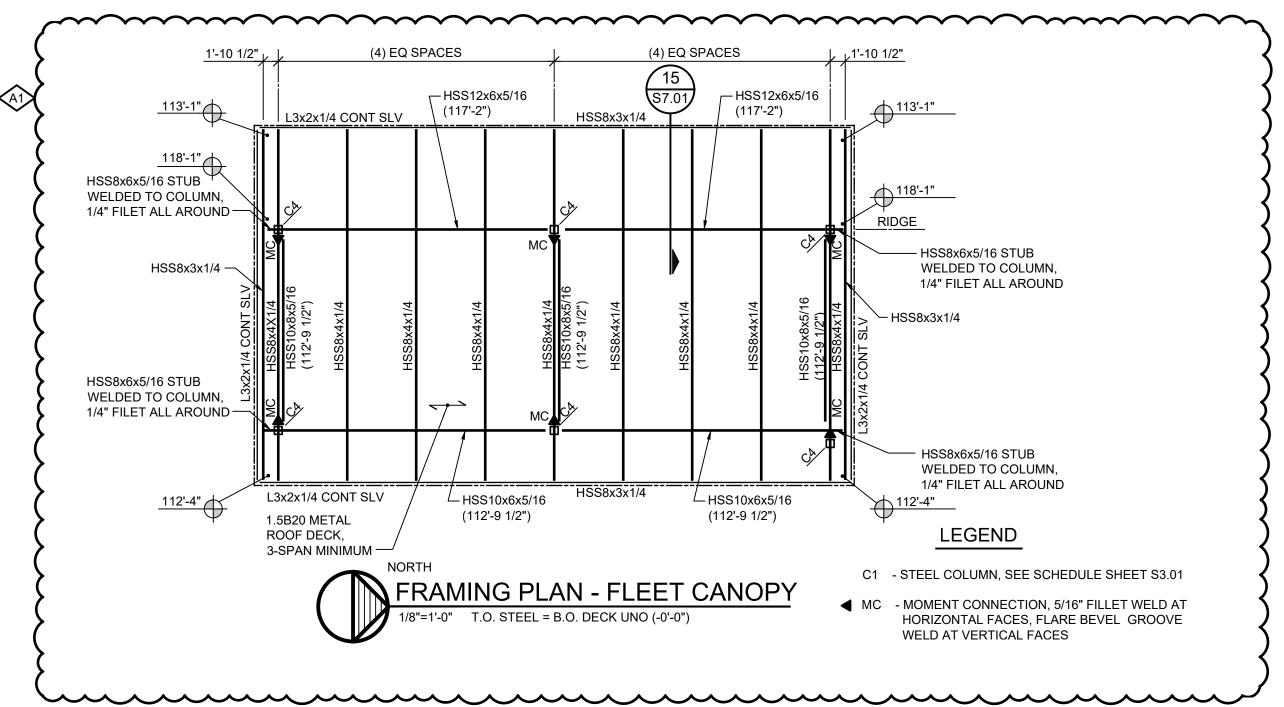

### LEGEND

- BP1 BEAM BEARING PLATE SEE DETAIL /S7.01
- C1 STEEL COLUMN, SEE SCHEDULE SHEET S3.01
- L1 STEEL LINTEL, SEE SCHEDULE SHEET S3.01
- L1(M) STEEL LINTEL AT MECHANICAL OPENING, COORDINATE SIZE AND LOCATION OF OPENING WITH MECHANICAL TRADES
- RD ROOF DRAIN, SEE DETAIL 7/S7.01, COORDINATE SIZE AND LOCATION WITH MECHANICAL TRADES
- EF EXHAUST FAN, PROVIDE ROOF FRAME AT OPENING, SEE DETAIL 7/S7.01, COORDINATE SIZE AND LOCATION WITH MECHANICAL TRADES
- 18K-SP1 SPECIAL JOIST, SEE SHEET S3.01 FOR JOIST LOADING DIAGRAM
- BOTTOM OF DECK ELEVATION
- DRIFT  $\langle 1 \rangle$  DRIFTED SNOW, SEE SHEET S3.01
  - SEE SHEET S3.01 FOR NOTES **NOTES**
  - 1. PROVIDE FRAME UNDER ALL RTU CURBS AND ROOF OPENINGS GREATER THAN 12" WIDE PER DETAIL 7/S7.01. COORDINATE SIZE AND LOCATION WITH MECHANICAL
  - 2. STRUCTURAL STEEL FRAMING TO BE SPACED AT EQUAL INTERVALS BETWEEN COLUMNS AND MASONRY BEARING WALLS UNO.
  - 3. PROVIDE STEEL FRAME AT OPENINGS SIMILAR TO DETAIL 7/S7.01, ANCHOR TO EXISTING JOISTS WITH (2) 1/2" DIA HILTI HY-200 A ADHESIVE.
  - 4. ALL LATERAL LOADS SHOWN ON PLAN ARE SERVICE LEVEL, UNFACTORED DESIGN LOADS. LOADS TO BE APPLIED WITH ALL APPLICABLE LOAD COMBINATIONS PER ASCE7-10. LOADS SHOWN FOR REFERENCE AND BIDDING PURPOSES ONLY. FINAL LOADS SHALL BE PROVIDED BY AND COORDINATED WITH EQUIPMENT SUPPLIER AND OWNER.

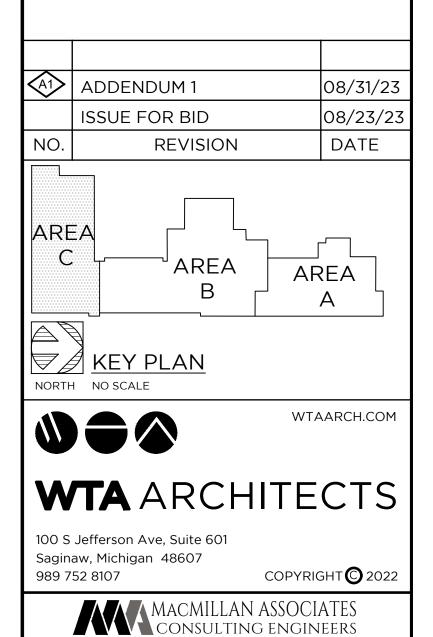

PROJECT TITLE ADDITION AND RENOVATION: MIDLAND COUNTY ESA

714 EAST MIDLAND STREET • BAY CITY, MICHIGAN 48706 (989) 894-4300 F (989) 894-9930 www.macmillanassociates.com

ROOF FRAMING PLAN - AREA C

MIDLAND, MICHIGAN

PROJECT NUMBER SHEET NUMBER 2022006.1 PROJECT DATE

CHECKED BY

S2.02 AUGUST 23, 2023

#### **GENERAL**

- 1. VERIFY DIMENSIONS BEFORE COMMENCING WORK. REPORT DISCREPANCIES TO THE ARCHITECT.
- 2. VERIFY OPENINGS IN THE FRAMING PLANS WITH THE ARCHITECTURAL, MECHANICAL AND ELECTRICAL DRAWINGS.
- 3. ALL WORK SHALL CONFORM TO MICHIGAN BUILDING CODE 2015.
- 4. DESIGN LOADS a. DESIGNED IN ACCORDANCE WITH MICHIGAN BUILDING CODE 2015.

b. BUILDING RISK CATEGORY III c. ROOF SNOW LOAD: GROUND SNOW LOAD PG = 35 PSF

FLAT ROOF SNOW LOAD, PF = 27 PSF SNOW EXPOSURE FACTOR, CE = 1.0

SNOW LOAD IMPORTANCE FACTOR, I = 1.1 THERMAL FACTOR, CT = 1.0, 1.2 AT CANOPIES FOR DRIFTED SNOW LOADS, SEE DIAGRAMS THIS SHEET

BASIC WIND SPEED, VULT = 120 MPH d. WIND LOADS: VASD = 93 MPH WIND EXPOSURE B

INTERNAL PRESSURE COEFFICIENT, GC PI = +/- 0.18

WALL COMPONENTS & CLADDING: **EFFECTIVE** 

PRESSURE (PSF) WIND AREA (FT2) PRESSURE (PSF) 24.6 -INTERIOR ZONE 24.6

e. EARTHQUAKE DESIGN DATA:

SEISMIC USE GROUP, III

SEISMIC IMPORTANCE FACTOR, I = 1.25 SPECTRAL RESPONSE COEFFICIENTS: SDS = 0.08G, SD1 = 0.068G

SITE CLASS D BASIC SEISMIC - FORCE - RESISTING SYSTEM: SHEAR WALL, MOMENT FRAME SEISMIC DESIGN CATEGORY, A

f. MINIMUM ROOF LIVE LOAD: 30 PSF g. SECOND FLOOR LIVE LOADS: AS SHOWN ON FRAMING PLANS

SPECIAL INSPECTIONS:

a. SPECIAL INSPECTIONS SHALL BE IN ACCORDANCE WITH THE MICHIGAN BUILDING CODE 2015

b. THE FOLLOWING TYPES OF WORK REQUIRE SPECIAL INSPECTIONS: (REFER TO THE BUILDING CODE AND SPECIFICATIONS FOR DETAILED INSPECTION REQUIREMENTS).

1. PREPARED FILL. 2. CONCRETE CONSTRUCTION. 3. STEEL CONSTRUCTION. 4. MASONRY CONSTRUCTION.

#### **FOUNDATION NOTES**

- 1. FOUNDATIONS ARE DESIGNED BASED ON SOIL BEARING OF 2000 PSF. IF SOIL OF THIS CAPACITY IS NOT FOUND AT THE ELEVATION NOTED, ENLARGE OR LOWER FOOTINGS AT THE DIRECTION OF THE ARCHITECT/ENGINEER.
- CENTER FOOTINGS AND PIERS UNDER WALL LOCATION AND COLUMNS UNLESS NOTED.
- 3. EARTH FORMS ARE NOT PERMITTED UNLESS SPECIFICALLY NOTED.
- 4. FOLLOWING DEMOLITION OF STRUCTURES AND STRIPPING OF TOPSOIL, PREPARE SOILS IN ACCORDANCE WITH SOILS REPORT BY PSI DATED APRIL 14, 2023.
- 5. DISTURBANCE OF THE FOUNDATION BEARING SOILS SHALL BE AVOIDED.
- 6. EXISTING FOUNDATIONS OR FLOOR SLAB ENCOUNTERED DURING SITE GRADINGS AND EXCAVATION SHALL BE REMOVED TO A DEPTH OF TWO (2) FEET BELOW NEW CONSTRUCTION. REPLACE WITH STRUCTURAL BACKFILL.
- 7. EXTEND WALL FOOTING REINFORCEMENT THROUGH COLUMN FOOTINGS WHERE APPLICABLE. REDUCE THE COLUMN FOOTING REINFORCEMENT BY THE NUMBER OF WALL FOOTING BARS WHICH EXTEND THROUGH THE COLUMN FOOTING IN THE SAME DIRECTION.
- 8. PROVIDE BOND BREAK MATERIAL BETWEEN ALL GRADE SLABS AND VERTICAL SURFACES.
- 9. BACKFILL AND EXCAVATION PER SPECIFICATIONS.

#### CONCRETE NOTES

- 1. ACI BUILDING CODE 318; MANUAL OF STANDARD PRACTICE FOR DETAILING 315 FOR THE MIXING, FABRICATION AND PLACEMENT OF CONCRETE, REINFORCING STEEL, AND ACCESSORIES.
- 2. CONCRETE STRENGTH STANDARD WEIGHT CONCRETE: FOOTINGS, WALLS, PIERS: F'C = 3000 MINIMUM PSI
- CONCRETE SLABS ON GRADE: F'C = 3500 MINIMUM PSI EXTERIOR CONCRETE SLABS EXPOSED TO DE-ICING: F'C = 4500 MINIMUM PSI
- 3. REINFORCING BARS: ASTM A-615 GRADE 60 WELDED WIRE FABRIC: ASTM A-1064
- 4. CONCRETE SLABS ON GRADE REINFORCING: 6X6 W1.4XW1.4 WWF UNLESS NOTED. LOCATED IN THE UPPER 1/3 OF SLAB THICKNESS.
- 5. PROVIDE SAWCUT CONTROL JOINTS AT APPROXIMATELY 12' ON CENTER EACH WAY IN SLABS ON GRADE, SEE DETAILS. LOCATE JOINTS UNDER PARTITIONS WHENEVER POSSIBLE. CONSTRUCTION JOINTS ARE AT
- 6. DEPRESS SLABS AS REQUIRED FOR FLOOR FINISHES, SEE ARCHITECT.
- 7. SLOPE FLOORS AS REQUIRED TO FLOOR DRAINS, SEE ARCHITECT.
- 8. FORM ALL CONCRETE.
- 9. PROVIDE 8" THICKENED FLOOR SLAB REINFORCED WITH (2) #4 UNDER ALL MASONRY WALLS AND MASONRY VENEERED STUD WALLS.
- 10. EXPOSED EDGES OF CONCRETE BEAMS, COLUMNS, ETC. SHALL BE CHAMFERED 3/4".
- 11. PROVIDE CORNER BARS FOR ALL CONTIGUOUS CORNERS.
- 12. WATER/CEMENT RATIO LIMITS:
- F'C = 3000 PSI 0.68 NON-AIR ENTRAINED, 0.50 AIR ENTRAINED F'C = 3500 PSI 0.62 NON-AIR ENTRAINED, 0.50 AIR-ENTRAINED
- F'C = 4500 PSI 0.4 AIR-ENTRAINED
- 13. SLUMP LIMITS: 3" FOR FOUNDATIONS, 4" FOR SLABS AND WALLS
- 14. PROVIDE AIR ENTRAINED CONCRETE FOR EXTERIOR EXPOSURES.
- 15. CONTRACTOR TO SUBMIT SIZE AND LAYOUT OF CONCRETE WALL SLEEVES, OPENINGS, ETC. FOR REVIEW PRIOR TO CONCRETE PLACEMENT.
- 10. REINFORCING LAP SPLICE LENGTHS: 45 BAR DIAMETERS FOR #6 BARS AND SMALLER, 60 BAR DIAMETERS FOR BARS LARGER THAN #6.

#### **MASONRY NOTES**

- 1. WORK SHALL BE PERFORMED IN ACCORDANCE WITH ACI 530 SPECIFICATIONS.
- 2. MORTAR: ASTM C270, TYPE M BELOW GRADE, TYPE M OR S ABOVE GRADE, TYPE N FOR NON-LOAD BEARING ABOVE
- 3. GROUT: ASTM C476, F'C=2000 PSI, TESTED PER ASTM C1019.
- 4. REINFORCING BARS SHALL BE ASTM A-615, GRADE 60, LAP MINIMUM 40 BAR DIAMETERS FOR #5 BARS AND SMALLER, LAP MINIMUM 52 BAR DIAMETERS FOR BARS LARGER THAN #5 UNLESS NOTED OTHERWISE.
- 5. HORIZONTAL WALL REINFORCING: PER ASTM A-82, 9 GA, HOT DIPPED GALVANIZED PER ASTM A-153 (1.5 OZ PER SF.), LADDER TYPE, EQUAL TO DUR-A-WAL. BED JOINTS AT 16" O.C. AND AT 1ST AND 2ND BED JOINTS AT BOTTOM OF WALL, TOP OF WALL, ABOVE LINTELS AND BELOW SILLS. REINFORCING CONTINUOUS EXCEPT AT VERTICAL CONTROL JOINTS. SIDE RODS LAPPED A MINIMUM OF 6" AT SPLICES. PROVIDE PREFABRICATED CORNERS AND
- 6. CONCRETE MASONRY UNITS: ASTM C-90, GRADE N, TWO CORE TYPE FOR REINFORCED MASONRY. DESIGN BASED ON F'M = 1900 PSI.
- VERTICAL WALL REINFORCING: 1 #5 EACH SIDE OF MASONRY OPENINGS UP TO 5'-0" WIDE, 1 #6 EACH SIDE OF MASONRY OPENINGS WIDER THAN 5'-0", CONTROL JOINTS AND AS SHOWN, IN GROUT FILLED BLOCK CORES.
- 8. VERTICAL BAR REINFORCING: PLACE ACCURATELY AND MECHANICALLY HOLD IN POSITION WHILE GROUTING. GROUTING SHALL BE DONE IN LIFTS NOT EXCEEDING 4'-0" AND MECHANICALLY CONSOLIDATED IN PLACE; CONSOLIDATION BY RODDING NOT ACCEPTABLE.
- 9. PROVIDE COMPLETELY GROUTED UNITS: a. UNDER CAST-IN-PLACE CONCRETE FLOOR BEARING
- b. UNDER BRICK VENEER BEARING c. UNDER ANY CHANGE OF WALL THICKNESS, I.E.: 8" ON TOP OF 12" d. UNDER STEEL JOIST OR BEAM BEARING.
- 10. PROVIDE LINTELS FOR OPENINGS IN MASONRY WALLS OVER 8" WIDE. SEE SCHEDULES THIS SHEET.
- 11. RUNNING BOND MASONRY SHALL BE BUILT INTEGRALLY AT WALL CORNERS UNLESS INDICATED OTHERWISE.
- 12. BLOCK CONTROL JOINTS SHALL BE "MICHIGAN" TYPE UNLESS NOTED OTHERWISE. HORIZONTAL REINFORCING SHALL BE DISCONTINUOUS AT CONTROL JOINTS. CMU CONTROL JOINTS TO BE SPACED NO GREATER THAN 1.5 TIMES THE HEIGHT OF THE MASONRY WALL O.C., AT OPENINGS, OR 24'-0" O.C. MAX. SEE ARCH FOR EXTERIOR CONTROL
- 13. TEMPORARY WALL BRACING IS THE CONTRACTORS RESPONSIBILITY. CONFORM TO APPLICABLE CODES AND
- 14. CONTRACTOR SHALL KEEP THE AIR SPACE CAVITY BETWEEN THE CONCRETE MASONRY AND VENEER COMPLETELY CLEAR OF MORTAR AND DEBRIS.

#### STRUCTURAL STEEL

- STRUCTURAL STEEL: FABRICATED AND ERECTED PER THE AISC MANUAL OF STEEL CONSTRUCTION. W-BEAMS: ASTM A-992 GR. 50. HSS: ASTM A-500 GRADE B. STEEL PIPE: ASTM A53, TYPE E, GRADE B. ALL OTHER SHAPES: ASTM A-36.
- 2. ANCHOR RODS: 36 KSI, ASTM F-1554.
- 3. WELDS: TO BE 70 KSI LOW HYDROGEN FILLER METAL PLACED BY WELDERS CERTIFIED IN WELD AND POSITION BY AWS D1.1, STRUCTURAL WELDING CODE. ALL WELDS SHALL BE APPLIED TO SURFACES FREE OF GREASE, PAINT, DIRT, OR OTHER HARMFUL MATERIAL.
- 4. BOLTED CONNECTIONS: 3/4" DIAMETER A-325 BOLTS WITH HEAVY HEX NUTS UNLESS NOTED. DESIGNED FOR BEARING CONNECTIONS, TIGHTENED TO SNUG TIGHT CRITERIA UNLESS NOTED OTHERWISE.
- STEEL PRIMER: SEE SPECIFICATION.
- 6. BEAM CONNECTIONS SHALL BE DESIGNED TO SUPPORT ONE-HALF THE TOTAL UNIFORM LOAD CAPACITY PER AISC.
- SHEAR TAB CONNECTIONS TO STEEL BEAMS ARE NOT ACCEPTABLE UNLESS BEAMS OF EQUAL DEPTHS ARE
- FASTENED ON OPPOSITE SIDES OF THE STEEL BEAM. 8. BEAM BEARING PLATES ARE TO BE LOCATED ON CENTER OF WALL UNLESS NOTED OTHERWISE. BEAR BEAM FULL
- LENGTH OF BEARING PLATES.
- 9. PROVIDE FITTED STIFFENER PLATES EACH SIDE FOR ALL CONDITIONS WHERE BEAMS BEAR ON COLUMNS, BEAMS BEAR ON BEAMS, BEAMS HANG FROM BEAMS, OR COLUMNS BEAR ON BEAMS. STIFFENER PLATES MINIMUM 1/4"

# 19. ALL ARCHITECTURALLY EXPOSED STEEL MEMBERS TO CONFORM TO A COS OR EQUIREMENTS.

STEEL ON STE

11. ALL EXTERIOR BOLTS AND ANCHOR RODS TO BE HOT-DIP GALVANIZED.

WHEREVER POSSIBLE, EXTEND CONNECTIONS FULL DEPTH OF BEAM.

- 1. OPEN WEB STEEL JOIST: DESIGN, FABRICATE AND ERECT PER STEEL JOIST INSTITUTE (SJI) SPECIFICATIONS.
- 2. ITEMS SUPPORTED BY JOISTS SHALL BE ATTACHED AT PANEL POINTS WHERE POSSIBLE. SEE JOIST REINFORCEMENT DETAIL 6/S7.01 FOR NON-PANEL POINT LOADING.
- 3. WELDING OF SUPPORTS TO JOISTS WILL NOT BE PERMITTED UNLESS SPECIFICALLY NOTED.
- WRITTEN APPROVAL OF THE JOIST MANUFACTURER AND THE ARCHITECT/ENGINEER. 5. BRIDGING: HORIZONTAL AND "X" TYPE SIZED NOT LESS THAN MINIMUM REQUIREMENT OF SJI.
- 6. SPECIAL LOADING CONDITIONS ARE SHOWN ON THE DRAWINGS AND SHALL BE USED IN THE DESIGN OF THE STEEL

4. NO STRUCTURAL MEMBER INCLUDING OPEN WEB STEEL JOIST SHALL BE CUT OR MODIFIED WITHOUT PRIOR

- JOIST AS INDICATED ON THE PLANS.
- METAL DECK ROOF DECK: 1 1/2", 20 GAUGE, WIDE RIB, MINIMUM 3 SPANS. DESIGNED AND FABRICATED PER STEEL DECK

7. PROVIDE UPLIFT BRIDGING PER SJI. STEEL JOISTS SHALL BE DESIGNED FOR A NET UPLIFT PRESSURE OF 9 PSF

- #10 SCREWS AT 3'-0" MAXIMUM. 2. DECK FINISH: AS SPECIFIED.
- 3. ROOF DECK OPENINGS LARGER THAN 12" SHALL BE REINFORCED WITH A STEEL ROOF FRAME. SEE ROOF FRAME DETAIL ON DRAWINGS.


INSTITUTE (SDI). WELD TO SUPPORTS WITH 5/8" DIAMETER PUDDLE WELDS 12" SPACING. FASTEN SIDE LAPS WITH

# **LIGHT GAGE METAL FRAMING**

- 1. ALL STUDS SHALL BE FORMED FROM HOT-DIPPED GALVANIZED STEEL, G-60 COATING, CORRESPONDING TO THE REQUIREMENTS OF ASTM A653, STRUCTURAL QUALITY, GRADE 33, WITH A MINIMUM YIELD OF 33 KSI. MEMBERS DESIGNED PER AMERICAN IRON AND STEEL INSTITUTE (AISI) "SPECIFICATION FOR THE DESIGN OF COLD FORMED STEEL STRUCTURAL MEMBERS". MEMBER DESIGNATIONS IN ACCORDANCE WITH THE STEEL STUD MANUFACTURERS ASSOCIATION (SSMA) I.E. 600-S-162-33.
- 2. ALL EXTERIOR STUDS SHALL BE MINIMUM 18 GAUGE.
- 3. SHOP DRAWINGS FOR LIGHT GAUGE METAL FRAMING SHALL BE PREPARED BY THE SUPPLIER AND SUBMITTED TO THE ARCHITECT/ENGINEER FOR APPROVAL

# PLYWOOD SHEATHING

- 1. PLYWOOD FOR WALL STUDS SHALL BE 1/2" THICK APA RATED SHEATHING, (24/16).
- 2. ROOF SHEATHING FASTENED WITH #8 TEK SCREWS NAILS AT 6" O.C. AT PANEL EDGES AND INTERMEDIATE SUPPORTS UNLESS NOTES OTHERWISE.
- 3. PANELS SHALL BE LAID IN A STAGGERED PATTERN, CONTINUOUS OVER TWO SPANS.

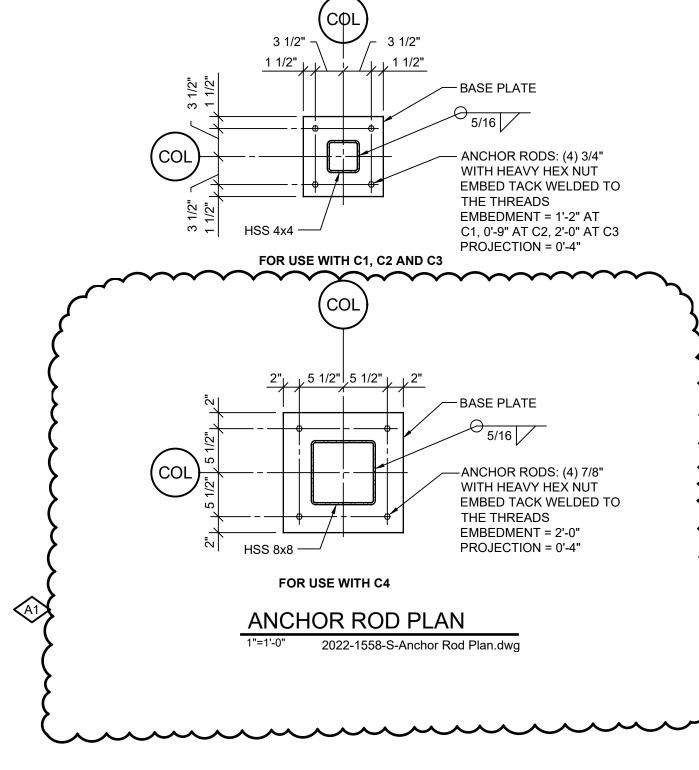

16'-0"

7'-0"

PD HOIST=

300 LBS

PD RTU=

MECH TRADES

500 lbs

SEE ARCH

PD HOIST=

300 LBS

COORD WITH

MECH TRADES 1

PD RTU=

18K-SP3

500 lbs

PD HOIST=

18K-SP1 AND 18K-SP2

SPECIAL JOIST DIAGRAMS

300 LBS

WD = 288 LB/FT

SL = 108 PLF

RLL = 120 PLF

DL = 100 PLF

18K-SP3 ONLY

RTU LOADS FOR

WD = 124 LB/FT

SL = 108 PLF

RLL = 120 PLF

DL = 100 PLF

PD HOIST=

NOTES: 1. ALL LOADS ARE UNFACTORED.

6. SL = SNOW LOAD DL = DEAD LOAD RLL = ROOF LIVE LOAD

4. VERIFY ALL DIMENSIONS.

WITH MECHANICAL CONTRACTOR.

PDL = CONCENTRATED DEAD LOAD

WD = DRIFTED SNOW LOAD

300 LBS


DL HOIST = 50 PLF

2. DESIGN JOIST FOR WORST CASE LOAD COMBINATIONS. 3. DEAD LOADS DO NOT INCLUDE JOIST SELF-WEIGHT.

5. COORDINATE SIZE AND LOCATION OF MECHANICAL RTU

NOTE: DESIGN 18K-SP1 and 18K-SP2 FOR CONCENTRATED MOVING LIVE

OAD OF 800 LBS AT BOTTOM CHORD

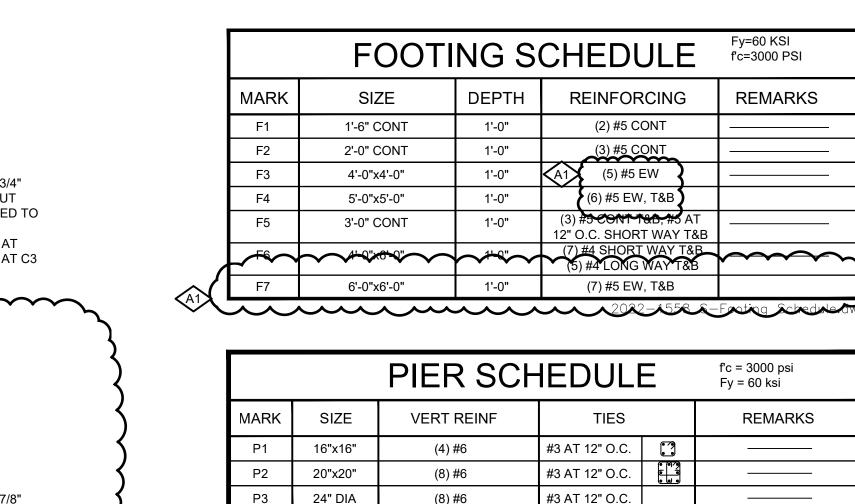

TOP OF PIER ELEVATION = 99'-4" (UNO)

MARK	SIZE	BASE PL	CAP PL	REMARKS
C1	HSS4x4x1/4	3/4"x10"x10"	1/2"	
C2	HSS5x5x1/4	3/4"x10"x10"	1/2"	
<b>√</b> %~	6" DIA DIPE	<b>✓"</b> ✓"  ✓"  ✓"  ✓  ✓  ✓  ✓  ✓  ✓  ✓  ✓  ✓	2/4"×8"×12"	BEAN TO COLUMN. (4) SHI BUT BOLTS.
C4	HSS8x8x5/16	1 1/8"x14"x14"	1/2"	

2022-1558 S-Pier Schedule.dwg

MARK	CLEAR SPAN	SIZE		BEARING EACH END
L1	4'-0"	L3 1/2x2 1/2x1/-	4 SLV	4"
L2	5'-0"	L3 1/2x3x1/4	SLV	6"
L3	6'-0"	L3 1/2x3 1/2x	:1/4	6"
L4	7'-0"	L4x3 1/2x1/4	LLV	6"
L5	8'-0"	L5x3 1/2x1/4	LLV	8"
L6	9'-0"	L6x3 1/2x 3/8	LLV	8"
BOTTOM C SEE ARCH	DF PLATE H DWGS L8	L7 L9	WALL THIC WALL, 3 FC	CHEDULED FOR SINGLE 4" OF CKNESS. PROVIDE 2 FOR 8" OR 10" WALL, 3" HORIZONTAL 3 FOR 12" WALL.
L7	W8x	18 + PL 1/4"x1'-3"		8"
L8	W8x1	8 + PL 1/4'x11 1/2"		8"
L9	W8x18	+ PL 1/4"x7 1/2"		8"
L10	W16	x26 + PL 1/4"x7 1/2"		8"
L11	W16x	26 + PL 1/4x11 1/2		8"

NOTE: 1. GROUT BELOW BEAM BEARING PER DETAIL 1/S7.01.

2. BEARING LENGTH IS OVER CMU OR COMPOSITE BRICK/BLOCK. DO NOT BEAR ON BRICK VENEER UNLESS SINGLE ANGLE LINTEL IS BEING UTILIZED.


3. ANCHOR MASONRY TO BEAMS WITH 9 GA WIRE TIES EACH SIDE AT 2'-8" O.C.

4. PROVIDE STEEL LINTELS AT ALL MASONRY WALL OPENINGS, INCLUDING MECHANICAL AND ELECTRICAL GREATER THAN 8" WIDE. SEE LINTEL SCHEDULE.

5. ALL EXTERIOR LINTELS TO BE HOT-DIP GALVANIZED.


CI	MU LINT	EL S	CHE	DULE	
MARK	CLEAR SPAN	BLOC WIDTH	K SIZE DEPTH	BOTTOM REINFORCING	REMARKS
CL1	4'-0"	8"	8"	(2) #3	
CL2	5'-0"	8"	8"	(2) #4	
CL3	6'-0"	8"	8"	(2) #5	
CL4	7'-0"	8"	16"	(2) #5	
CL5	8'-0"	8"	16"	(2) #6	
CL6	9'-0"	8"	16"	(2) #7	
4 5/8"	8"	51/8"	8'	13 5/8"	- No. 10 10 10 10 10 10 10 10 10 10 10 10 10

BASED ON 8" MIN BEARING EACH END 2022-1558 S-CMU Lintel Schedule.DWG

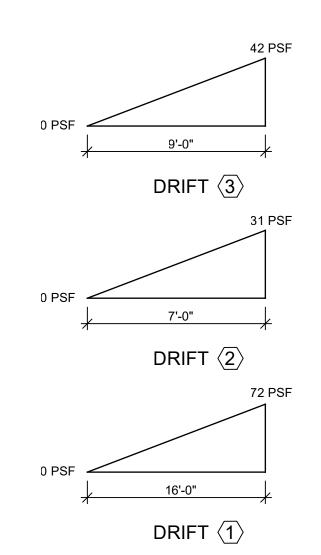

SNOW DRIFTING LOAD DIAGRAM

NOTE: STEEL JOIST DESIGNATIONS HAVE BEEN SELECTED TO ACCOUNT FOR DRIFTED SNOW LOADS, UNLESS NOTED OTHERWISE.

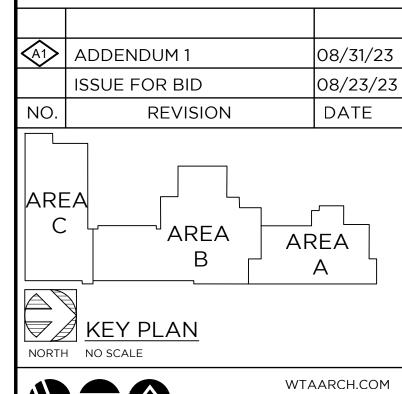



100 S Jefferson Ave, Suite 601 Saginaw, Michigan 48607


COPYRIGHT © 2022 989 752 8107 MACMILLAN ASSOCIATES CONSULTING ENGINEERS 714 EAST MIDLAND STREET • BAY CITY, MICHIGAN 48706 (989) 894-4300 F (989) 894-9930 www.macmillanassociates.coi

PROJECT TITLE ADDITION AND RENOVATION:

MIDLAND COUNTY ESA

MIDLAND, MICHIGAN NOTES AND SCHEDULES


SHEET NUMBER PROJECT NUMBER 2022006.1 PROJECT DATE AUGUST 23, 2023 CHECKED BY

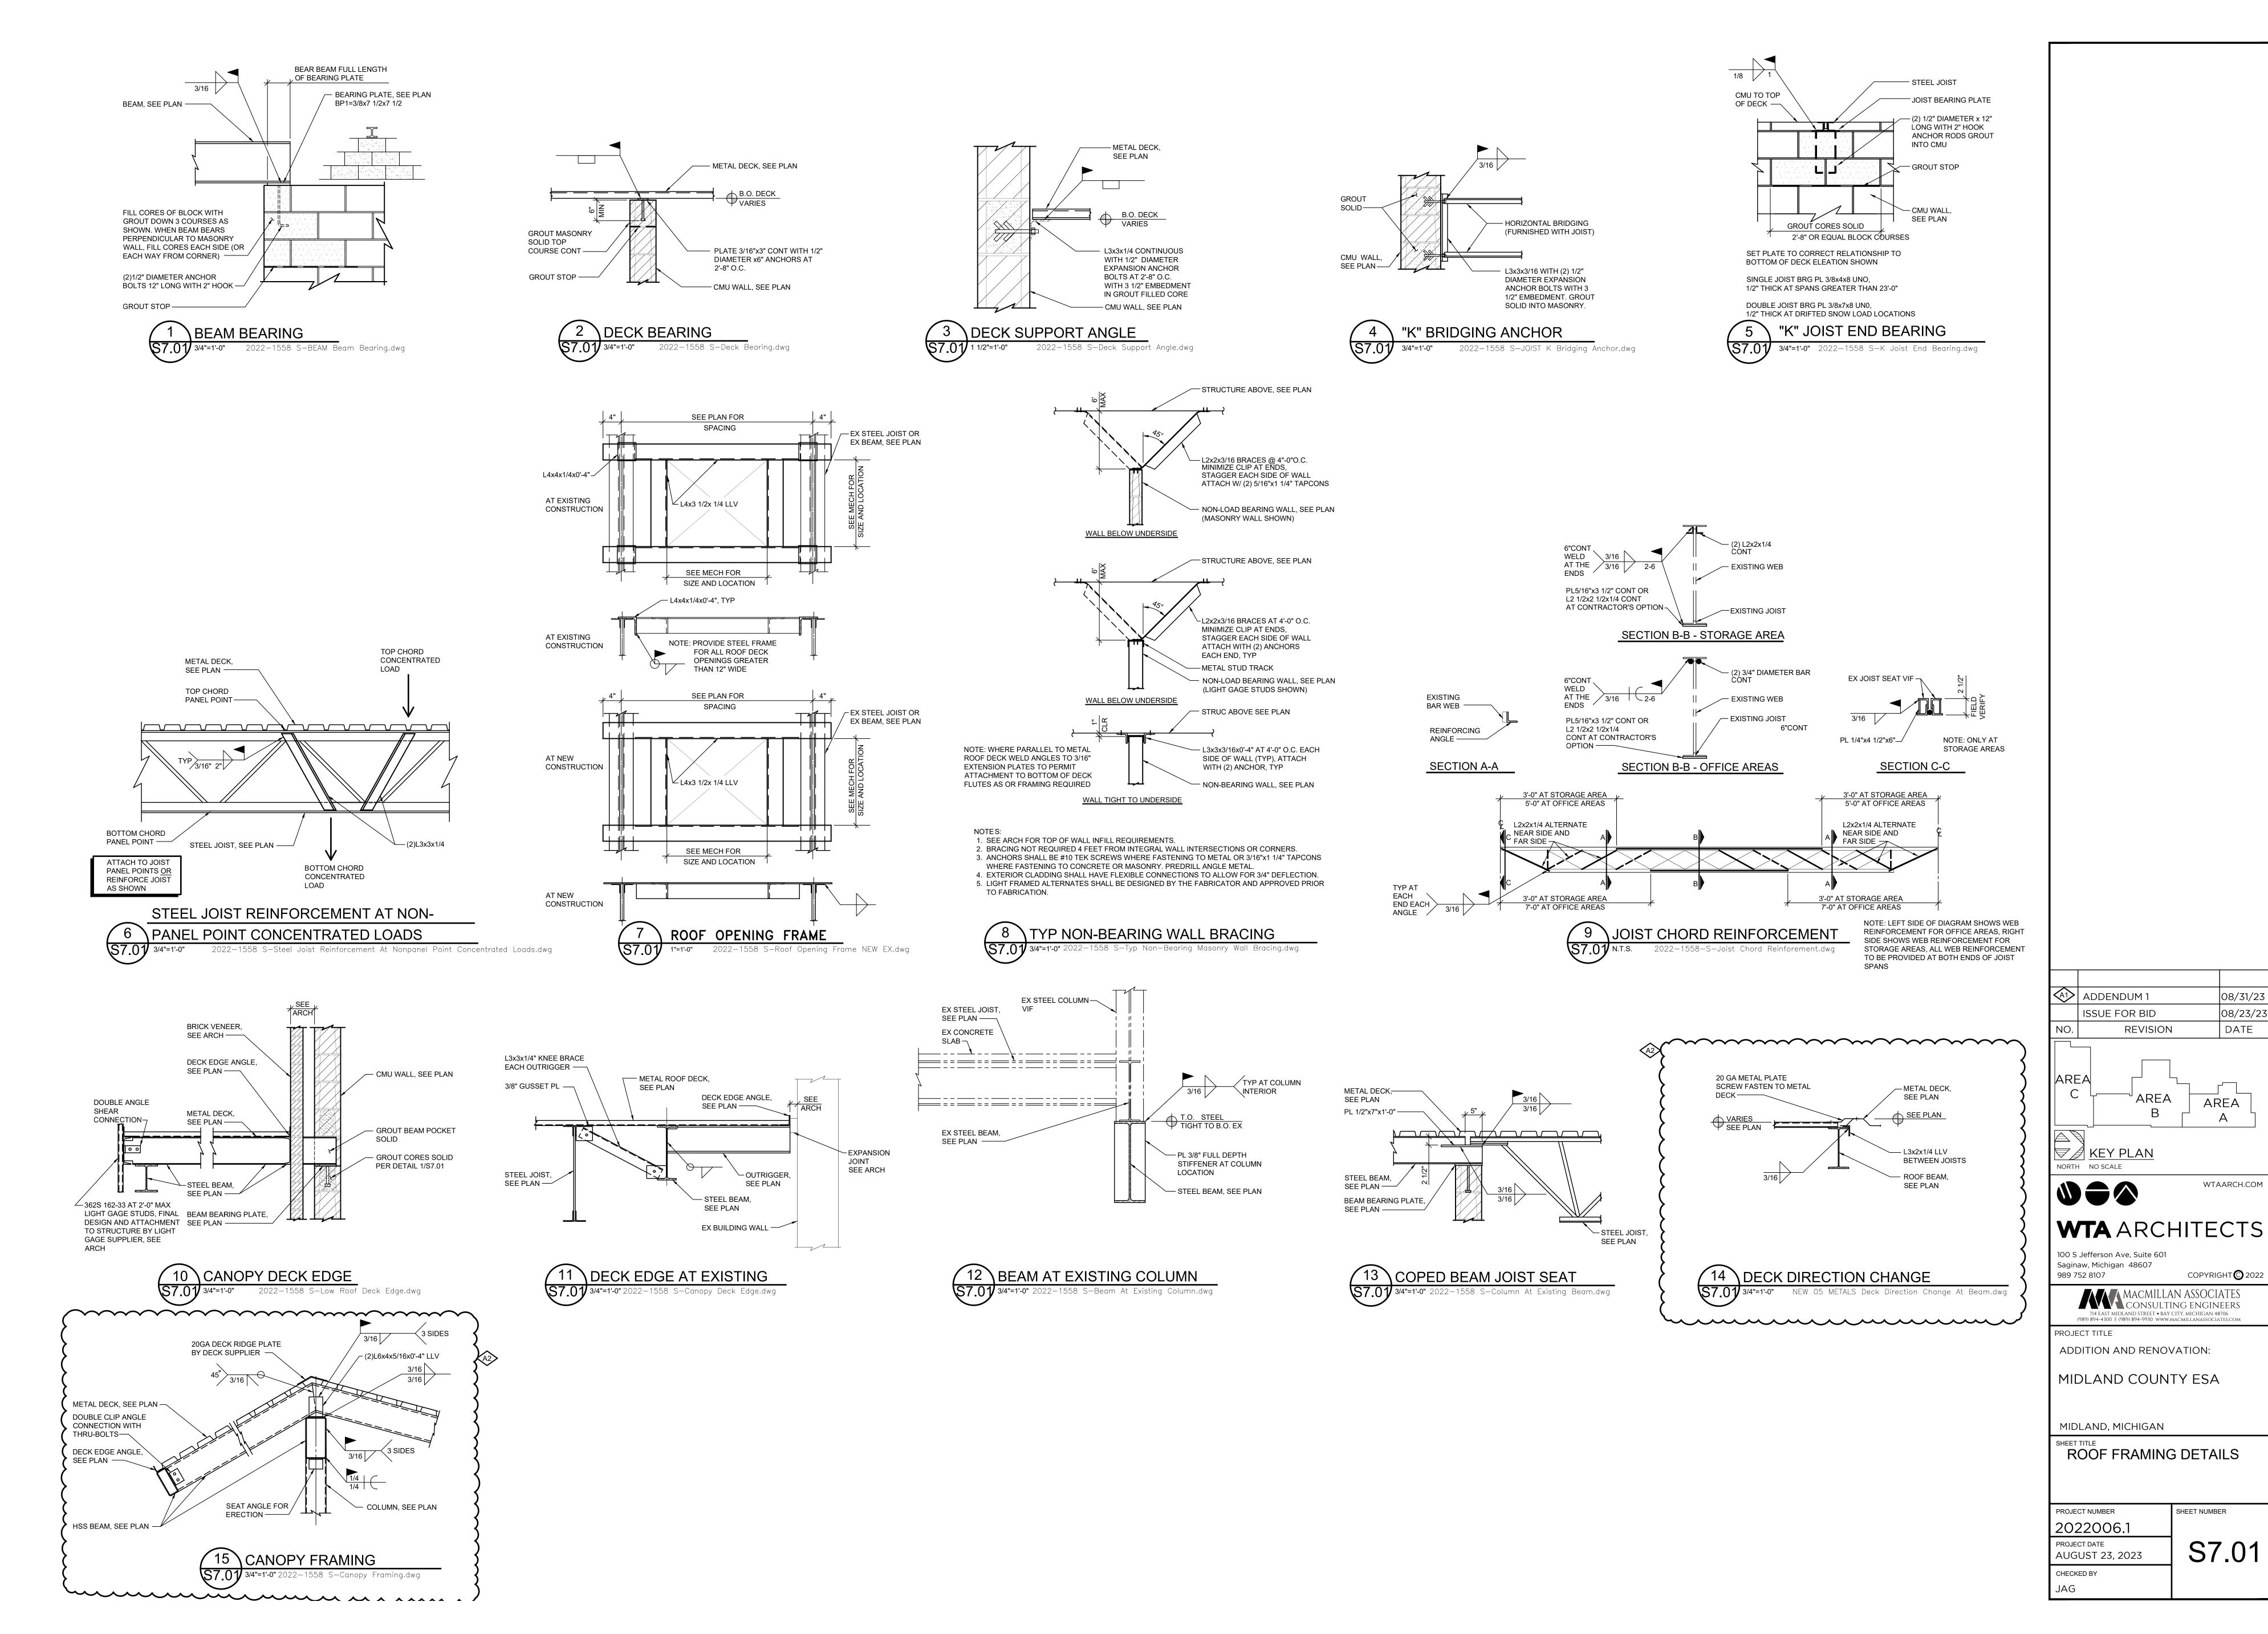



08/31/23

08/23/23

DATE

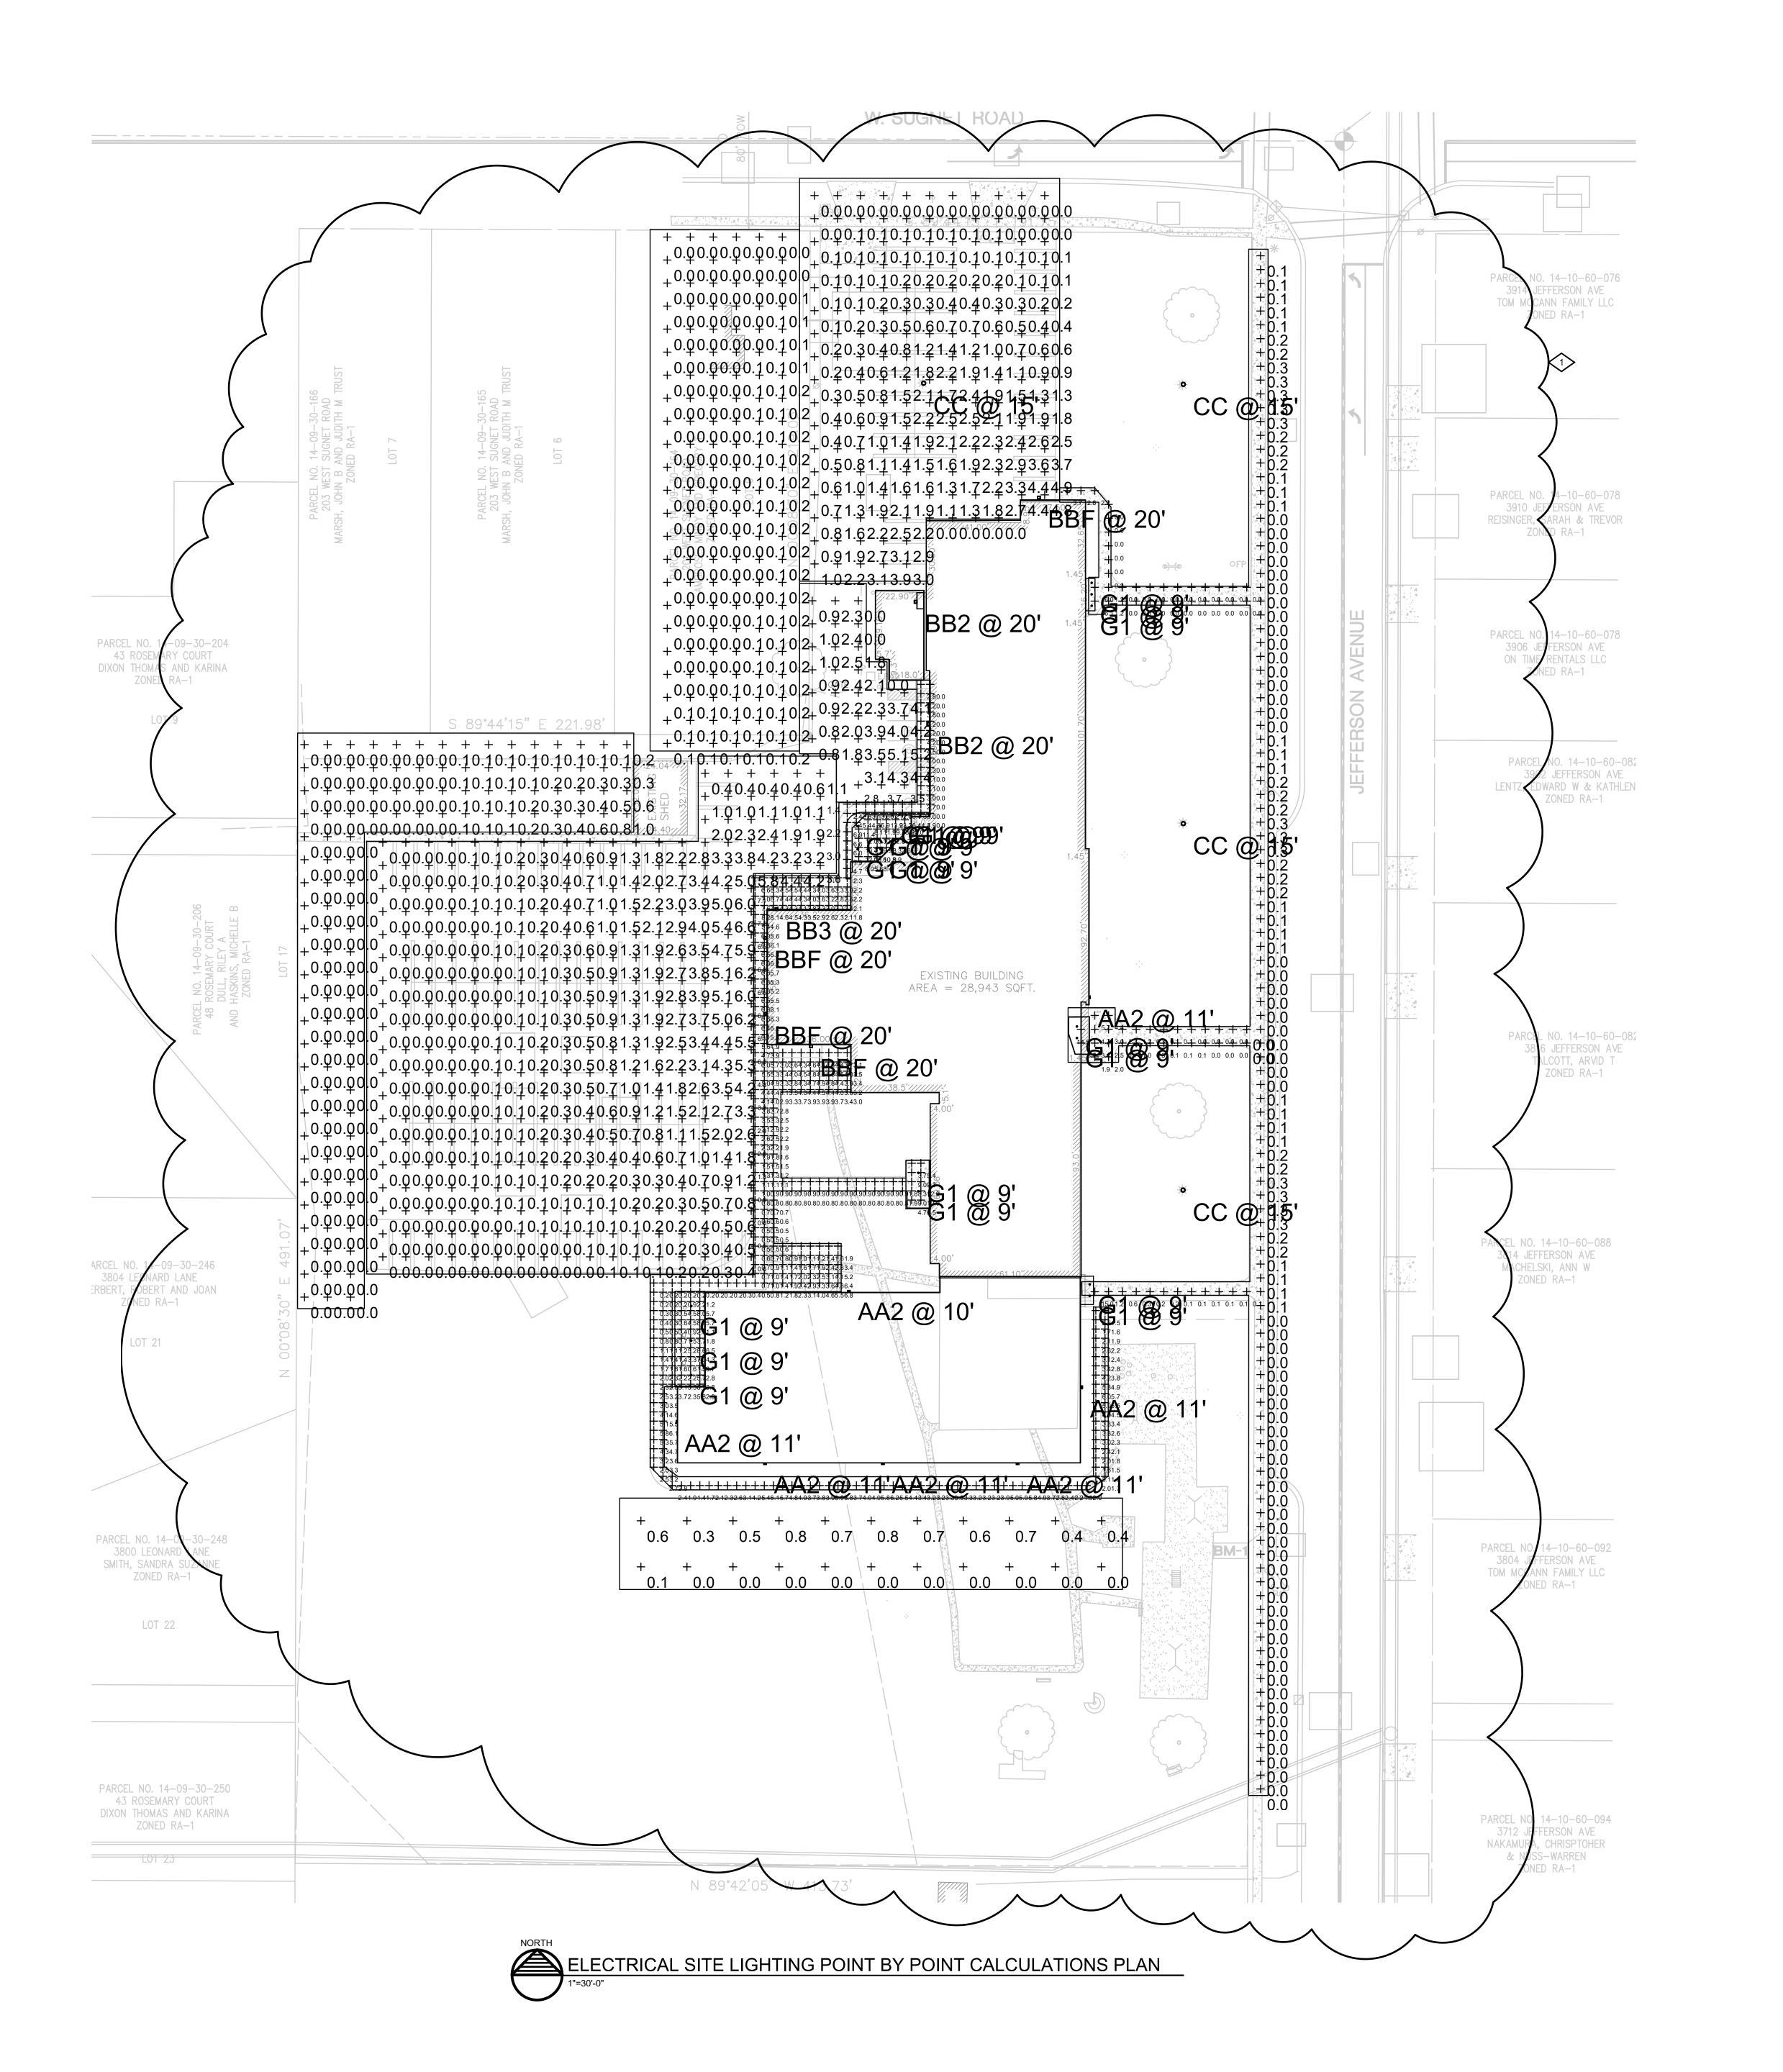

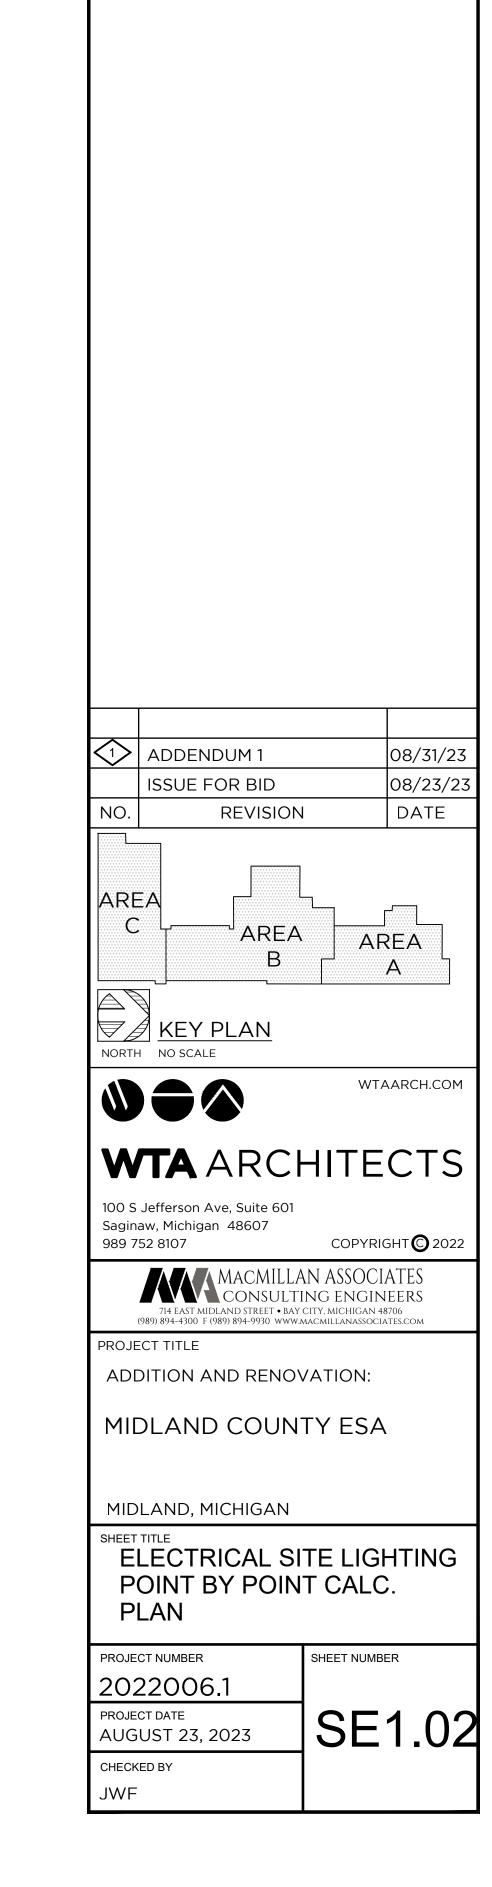

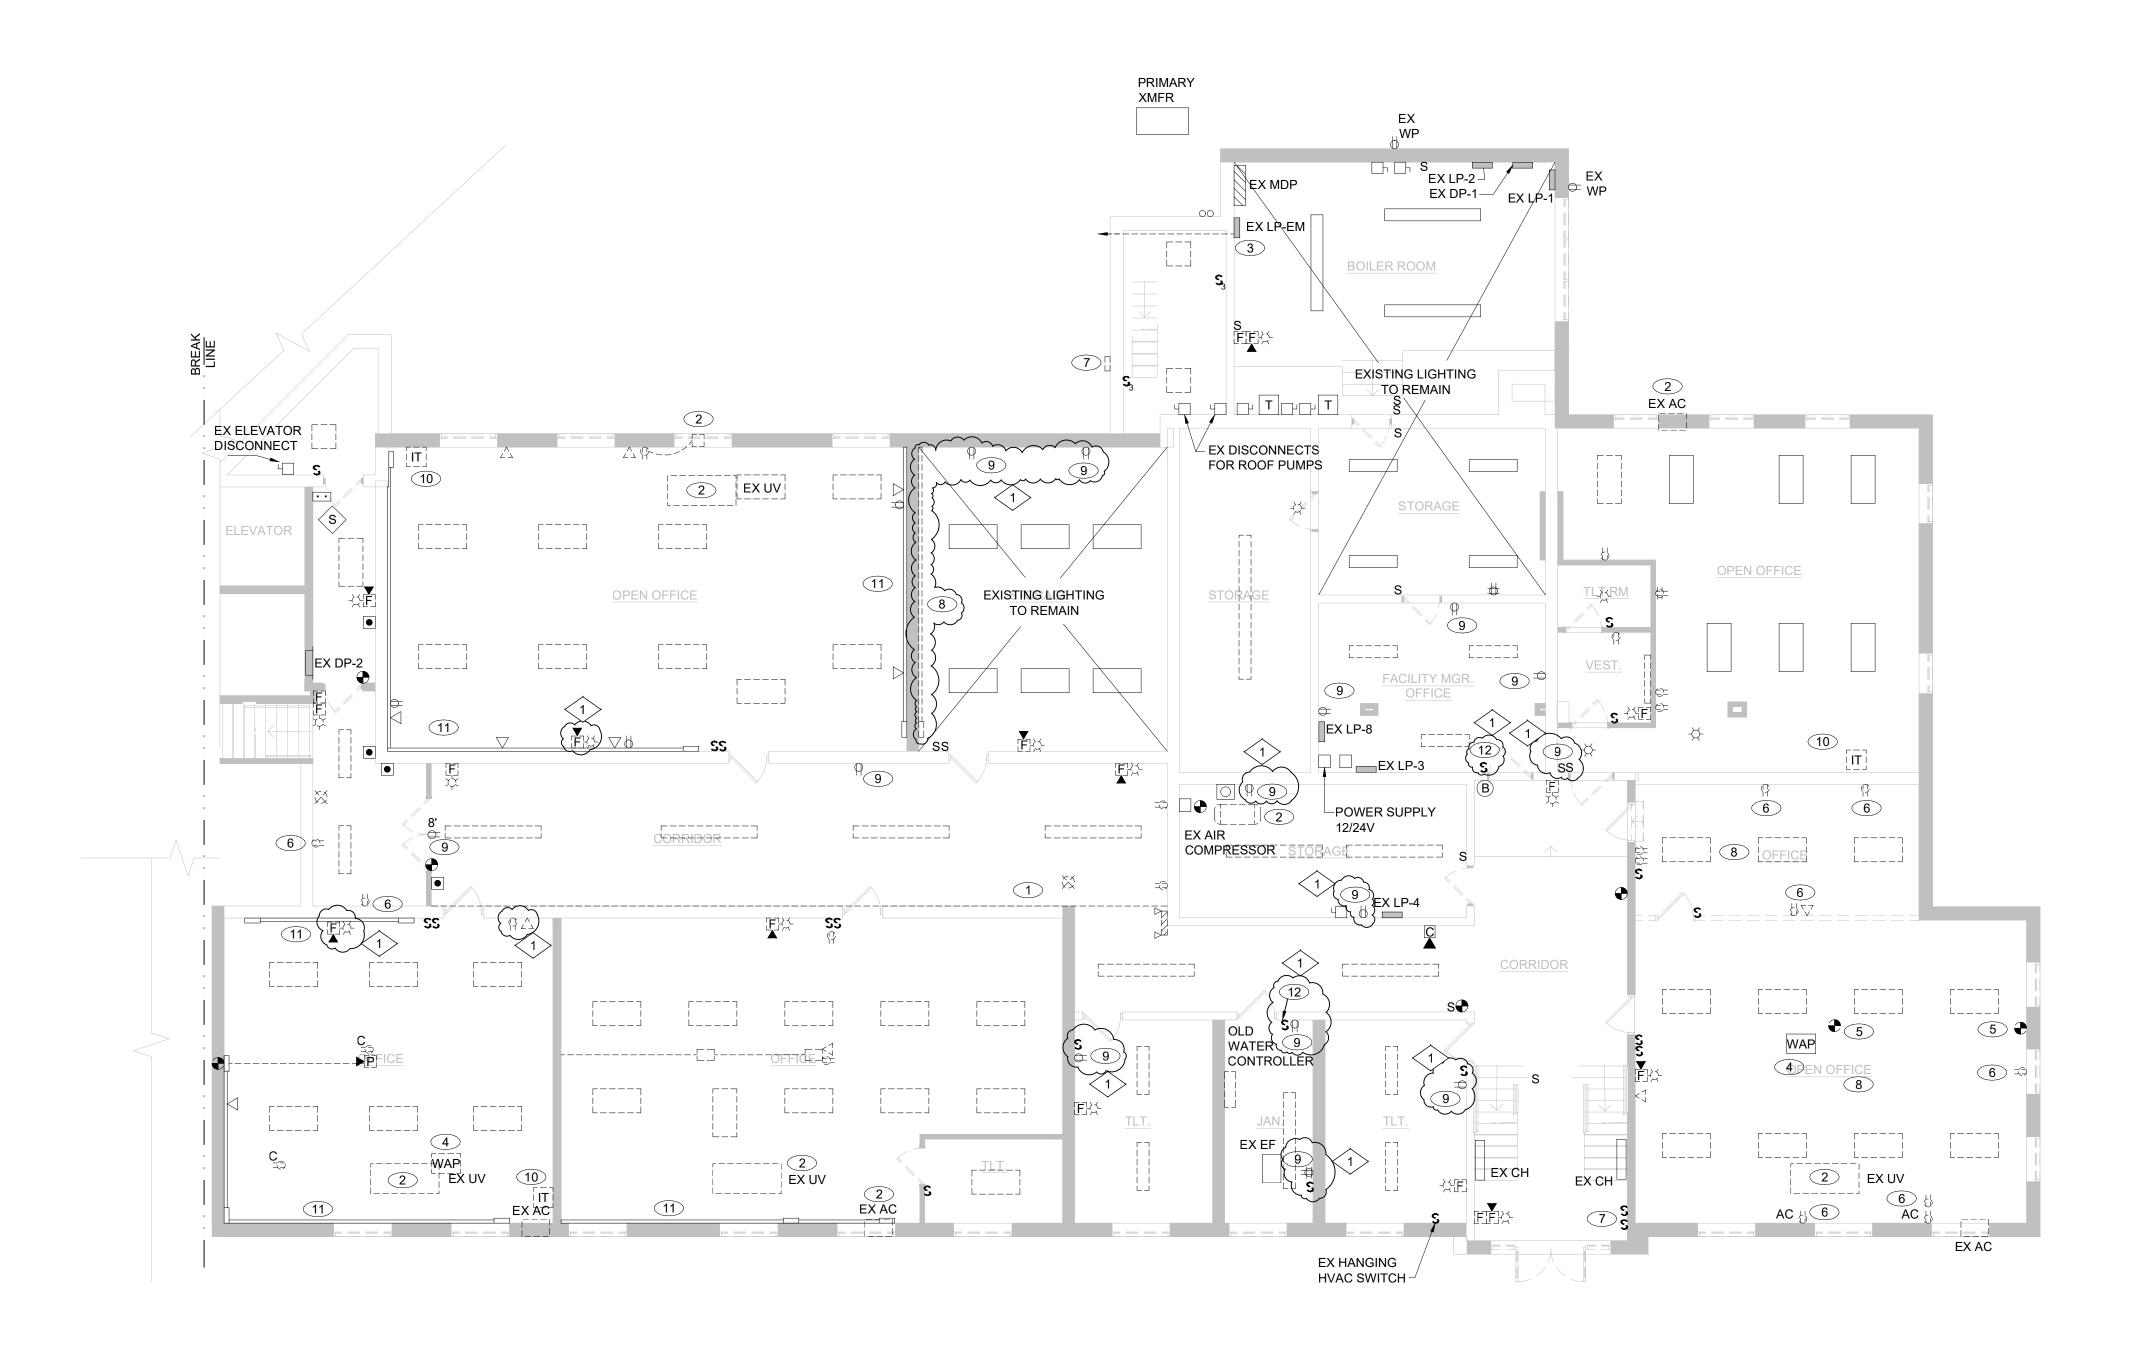



## **DEMOLITION SPECIAL NOTE**

1. DEMO ALL EXISTING FIRE ALARM AND SMOKE DETECTOR DEVICES INCLUDING ALL CONDUCTORS, RACEWAYS, HANGERS AND SUPPORTS. TO PREPARE FOR A NEW FIRE ALARM SYSTEM.

#### **GENERAL NOTES DEMOLITION**

- 1. ELECTRICAL PANELS SHOWN ON THE DEMO PLAN ARE SHOWN FOR REFERENCE. DO NOT REMOVE PANELS UNLESS NOTED OTHERWISE. REFER TO POWER DRAWINGS.
- 2. EC SHALL REMOVE AND PROPERLY DISPOSE OF ALL FIXTURES, LAMPS, BALLASTS AND WIRING SHOWN FOR DEMOLITION.
- 3. EC SHALL REMOVE ALL BLANK COVERS ON BOXES TO CONFIRM THE TYPE OF WIRING, POWER OR LOW VOLTAGE. REMOVE ALL WIRING,
- BOXES IF EMPTY SHALL BE REMOVED FOR WALL PATCHING. 4. ALL ITEMS SHOWN DASHED SHALL BE REMOVED UNLESS OTHERWISE
- 5. REMOVE ALL CONDUIT AND WIRING BACK TO SOURCE FOR ALL DEVICES


#### SHOWN TO BE REMOVED.

- 6. REMOVE ALL DATA CABLES BACK TO THE IDF RACK FOR ALL DATA OUTLETS. A COMPLETE NEW LOW VOLTAGE SYSTEM SHALL BE
- 7. REMOVE ALL FIRE ALARM DEVICES. AS NOTES EXISTING MAIN FIRE ALARM CONTROL PANEL AND ASSOCIATED DEVICES IN AREA WITH LIMITED DEMOLITION SHALL REMAIN. IDENTIFY, PROTECT AND MARK EXISTING CABLING.
- 8. REMOVE ALL WIRELESS ACCESS POINTS AND RETURN TO OWNER. REMOVE CABLING BACK TO THE SOURCE.
- 9. REMOVE ALL HANGERS, SUPPORTS AND STRAPS ASSOCIATED WITH ITEMS BEING REMOVED.
- 10. REMOVE ALL ABANDONED CONDUIT AND BOXES TO PREPARE FOR PATCHING BY GENERAL TRADES.

#### **KEYED NOTES - DEMOLITION**

- 1 DEMO EXISTING MAKESHIFT "WIREMOLD" AND ALL POWER AND DATA CABLING WITHIN IT.
- 2 REMOVE ALL POWER, RACEWAY, CONDUIT AND SUPPORTS FOR DEMOED MECHANICAL EQUIPMENT.
- 3 DEMO FEED TO PANEL LP-EM. REMOVE ALL CONDUIT, WIRE, HANGARS ETC. PANEL TO BE REFED FROM LP-2. REFER TO POWER AND SYSTEMS AND ONE-LINE DRAWINGS.
- 4 REMOVE WIRELESS ACCESS POINT AND RETURN TO OWNER.
- 5 DEMO EXISTING POWER POLE THAT FEEDS CUBICLES.
- 6 REMOVE EXISTING DEVICES, DEMO WIRE AND CONDUIT BACK TO CEILING. RECEPTACLE CIRCUIT TO BE REUSED.
- 7 REMOVE EXISTING EXTERIOR WALL PACK LIGHT FIXTURE.
- 8 REMOVE EXISTING SURFACE RACEWAY. DEMO BACK TO CEILING.
- 9 EXISTING DEVICE TO REMAIN.
- 10 REMOVE IT EQUIPMENT AND RETURN TO OWNER.
- 11) EXISTING RACEWAY TO REMAIN. 11) EXISTING RACEWAY TO REMAIN.

  12) EXISTING ROUGH-IN TO BE REUSED. REMOVE OLD DEVICE AND REPLACE WITH NEW DEVICE ACCORDING TO ELECTRICAL PLANS.

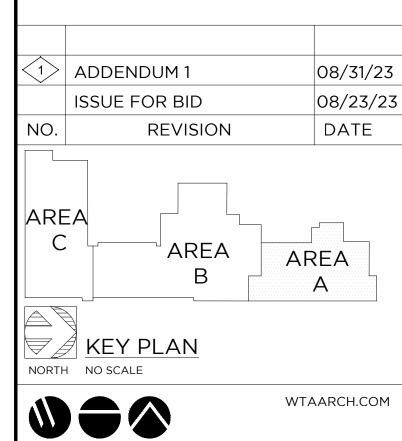



**WTA** ARCHITECTS

100 S Jefferson Ave, Suite 601 Saginaw, Michigan 48607

COPYRIGHT © 2022 714 EAST MIDLAND STREET • BAY CITY, MICHIGAN 48706 (989) 894-4300 F (989) 894-9930 www.macmillanassociates.com

ADDITION AND RENOVATION:

MIDLAND COUNTY ESA

MIDLAND, MICHIGAN

DEMOLITION ELECTRICAL PLAN - LOWER LEVEL AREA A

SHEET NUMBER

PROJECT NUMBER 2022006.1

PROJECT DATE
AUGUST 23, 2023 E1.01

CHECKED BY



**DEMOLITION SPECIAL NOTE** 

**DEMOLITION KEYED NOTES** 

ELECTRICAL PLANS.

AND REPLACE WITH NEW DEVICE ACCORDING TO

2 REMOVE PROJECTOR AND SPEAKERS AND RETURN TO

4 REMOVE SECURITY CAMERA AND RETURN TO OWNER.

5 DEMO EXISTING ELECTRICAL PANEL. DEMO ALL BRANCH

FED FROM CEILING THEN DEMO LINE SIDE FEED TO

REFER TO POWER AND SYSTEMS PLAN. IF PANEL LP-98A IS

FED UNDERGROUND THEN DEMO LINE-SIDE FEED BACK TO

3 REMOVE WIRELESS ACCESS POINT AND RETURN TO OWNER.

1) EXISTING ROUGH-IN TO BE REUSED. REMOVE OLD DEVICE 1. DEMO ALL EXISTING FIRE ALARM AND SMOKE DETECTOR DEVICES

TO PREPARE FOR A NEW FIRE ALARM SYSTEM.

GENERAL NOTES DEMOLITION

1. ELECTRICAL PANELS SHOWN ON THE DEMO PLAN ARE SHOWN FOR REFERENCE. DO NOT REMOVE PANELS UNLESS NOTED OTHERWISE. REFER TO POWER DRAWINGS.

INCLUDING ALL CONDUCTORS, RACEWAYS, HANGERS AND SUPPORTS.

2. EC SHALL REMOVE AND PROPERLY DISPOSE OF ALL FIXTURES, LAMPS, CIRCUITS. FIELD TRACE LINE-SIDE FEED. IF PANEL LP-98A IS BALLASTS AND WIRING SHOWN FOR DEMOLITION.

ACCESSIBLE CEILING SPACE CLOSEST TO NEW PANEL RP1B. 3. EC SHALL REMOVE ALL BLANK COVERS ON BOXES TO CONFIRM THE TYPE OF WIRING, POWER OR LOW VOLTAGE. REMOVE ALL WIRING, BOXES IF EMPTY SHALL BE REMOVED FOR WALL PATCHING.

4. ALL ITEMS SHOWN DASHED SHALL BE REMOVED UNLESS OTHERWISE

5. REMOVE ALL CONDUIT AND WIRING BACK TO SOURCE FOR ALL DEVICES


6. REMOVE ALL DATA CABLES BACK TO THE IDF RACK FOR ALL DATA OUTLETS. A COMPLETE NEW LOW VOLTAGE SYSTEM SHALL BE

7. REMOVE ALL FIRE ALARM DEVICES. AS NOTES EXISTING MAIN FIRE ALARM CONTROL PANEL AND ASSOCIATED DEVICES IN AREA WITH LIMITED DEMOLITION SHALL REMAIN. IDENTIFY, PROTECT AND MARK

REMOVE CABLING BACK TO THE SOURCE.

9. REMOVE ALL HANGERS, SUPPORTS AND STRAPS ASSOCIATED WITH

10. REMOVE ALL ABANDONED CONDUIT AND BOXES TO PREPARE FOR

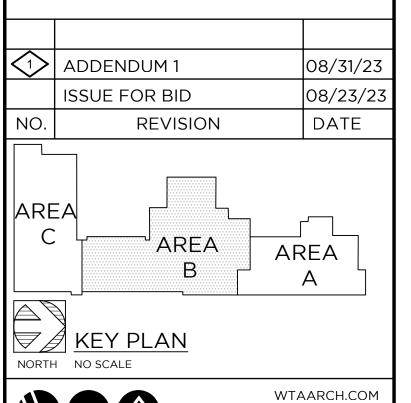



100 S Jefferson Ave, Suite 601

Saginaw, Michigan 48607

ADDITION AND RENOVATION:

MIDLAND COUNTY ESA

MIDLAND, MICHIGAN

DEMOLITION ELECTRICAL PLAN - MAIN LEVEL SOUTH WING - AREA B

PROJECT NUMBER 2022006.1 PROJECT DATE

E1.02

SHEET NUMBER

CHECKED BY

AUGUST 23, 2023

# DEMOLITION KEYED NOTES

- 1 EXISTING ROUGH-IN TO BE REUSED. REMOVE OLD DEVICE AND REPLACE WITH NEW DEVICE ACCORDING TO ELECTRICAL PLANS.
- 2 REMOVE WIRELESS ACCESS POINT AND RETURN TO OWNER.
- 3 REMOVE AND REINSTALL CARD READER. JUNCTION BOX TO BE REPLACED.
- 4 DEMO EXISTING PHOTOCELL AND JUNCTION BOX. NEW JUNCTION BOX TO BE INSTALLED AT T-JUNCTION OF VERTICAL CONDUIT RUN.
- 5 REMOVE ALL POWER, RACEWAY, CONDUIT AND SUPPORTS FOR DEMOED MECHANICAL EQUIPMENT.
- 6 REMOVE EXISTING SITE LIGHT. DESIGN INTENT IS TO REPLACE ONE-FOR-ONE.
- 7 REMOVE EXISTING IT EQUIPMENT AND RETURN TO OWNER.
- 8 REMOVE CAMERA AND RETURN TO OWNER.
- 9 CONTRACTOR SHALL PROVIDE (2) 3" FLOOR CORES FOR TEMP DATA DURING CONSTRUCTION FROM EX UPPER LEVEL MDP TO NEW LOWER LEVEL MDL. PATCH HOLES AT THE END OF CONSTRUCTION.

#### DEMOLITION SPECIAL NOTE


 DEMO ALL EXISTING FIRE ALARM AND SMOKE DETECTOR DEVICES INCLUDING ALL CONDUCTORS, RACEWAYS, HANGERS AND SUPPORTS. TO PREPARE FOR A NEW FIRE ALARM SYSTEM.

#### GENERAL NOTES DEMOLITION

- ELECTRICAL PANELS SHOWN ON THE DEMO PLAN ARE SHOWN FOR REFERENCE. DO NOT REMOVE PANELS UNLESS NOTED OTHERWISE. REFER TO POWER DRAWINGS.
- EC SHALL REMOVE AND PROPERLY DISPOSE OF ALL FIXTURES, LAMPS, BALLASTS AND WIRING SHOWN FOR DEMOLITION.
- 3. EC SHALL REMOVE ALL BLANK COVERS ON BOXES TO CONFIRM THE
- TYPE OF WIRING, POWER OR LOW VOLTAGE. REMOVE ALL WIRING, BOXES IF EMPTY SHALL BE REMOVED FOR WALL PATCHING.
- 5. REMOVE ALL CONDUIT AND WIRING BACK TO SOURCE FOR ALL DEVICES


4. ALL ITEMS SHOWN DASHED SHALL BE REMOVED UNLESS OTHERWISE

- SHOWN TO BE REMOVED.
- REMOVE ALL DATA CABLES BACK TO THE IDF RACK FOR ALL DATA OUTLETS. A COMPLETE NEW LOW VOLTAGE SYSTEM SHALL BE INSTALLED.
- REMOVE ALL FIRE ALARM DEVICES. AS NOTES EXISTING MAIN FIRE ALARM CONTROL PANEL AND ASSOCIATED DEVICES IN AREA WITH LIMITED DEMOLITION SHALL REMAIN. IDENTIFY, PROTECT AND MARK EXISTING CABLING.
- 8. REMOVE ALL WIRELESS ACCESS POINTS AND RETURN TO OWNER. REMOVE CABLING BACK TO THE SOURCE.
- REMOVE ALL HANGERS, SUPPORTS AND STRAPS ASSOCIATED WITH ITEMS BEING REMOVED.
- REMOVE ALL ABANDONED CONDUIT AND BOXES TO PREPARE FOR PATCHING BY GENERAL TRADES.

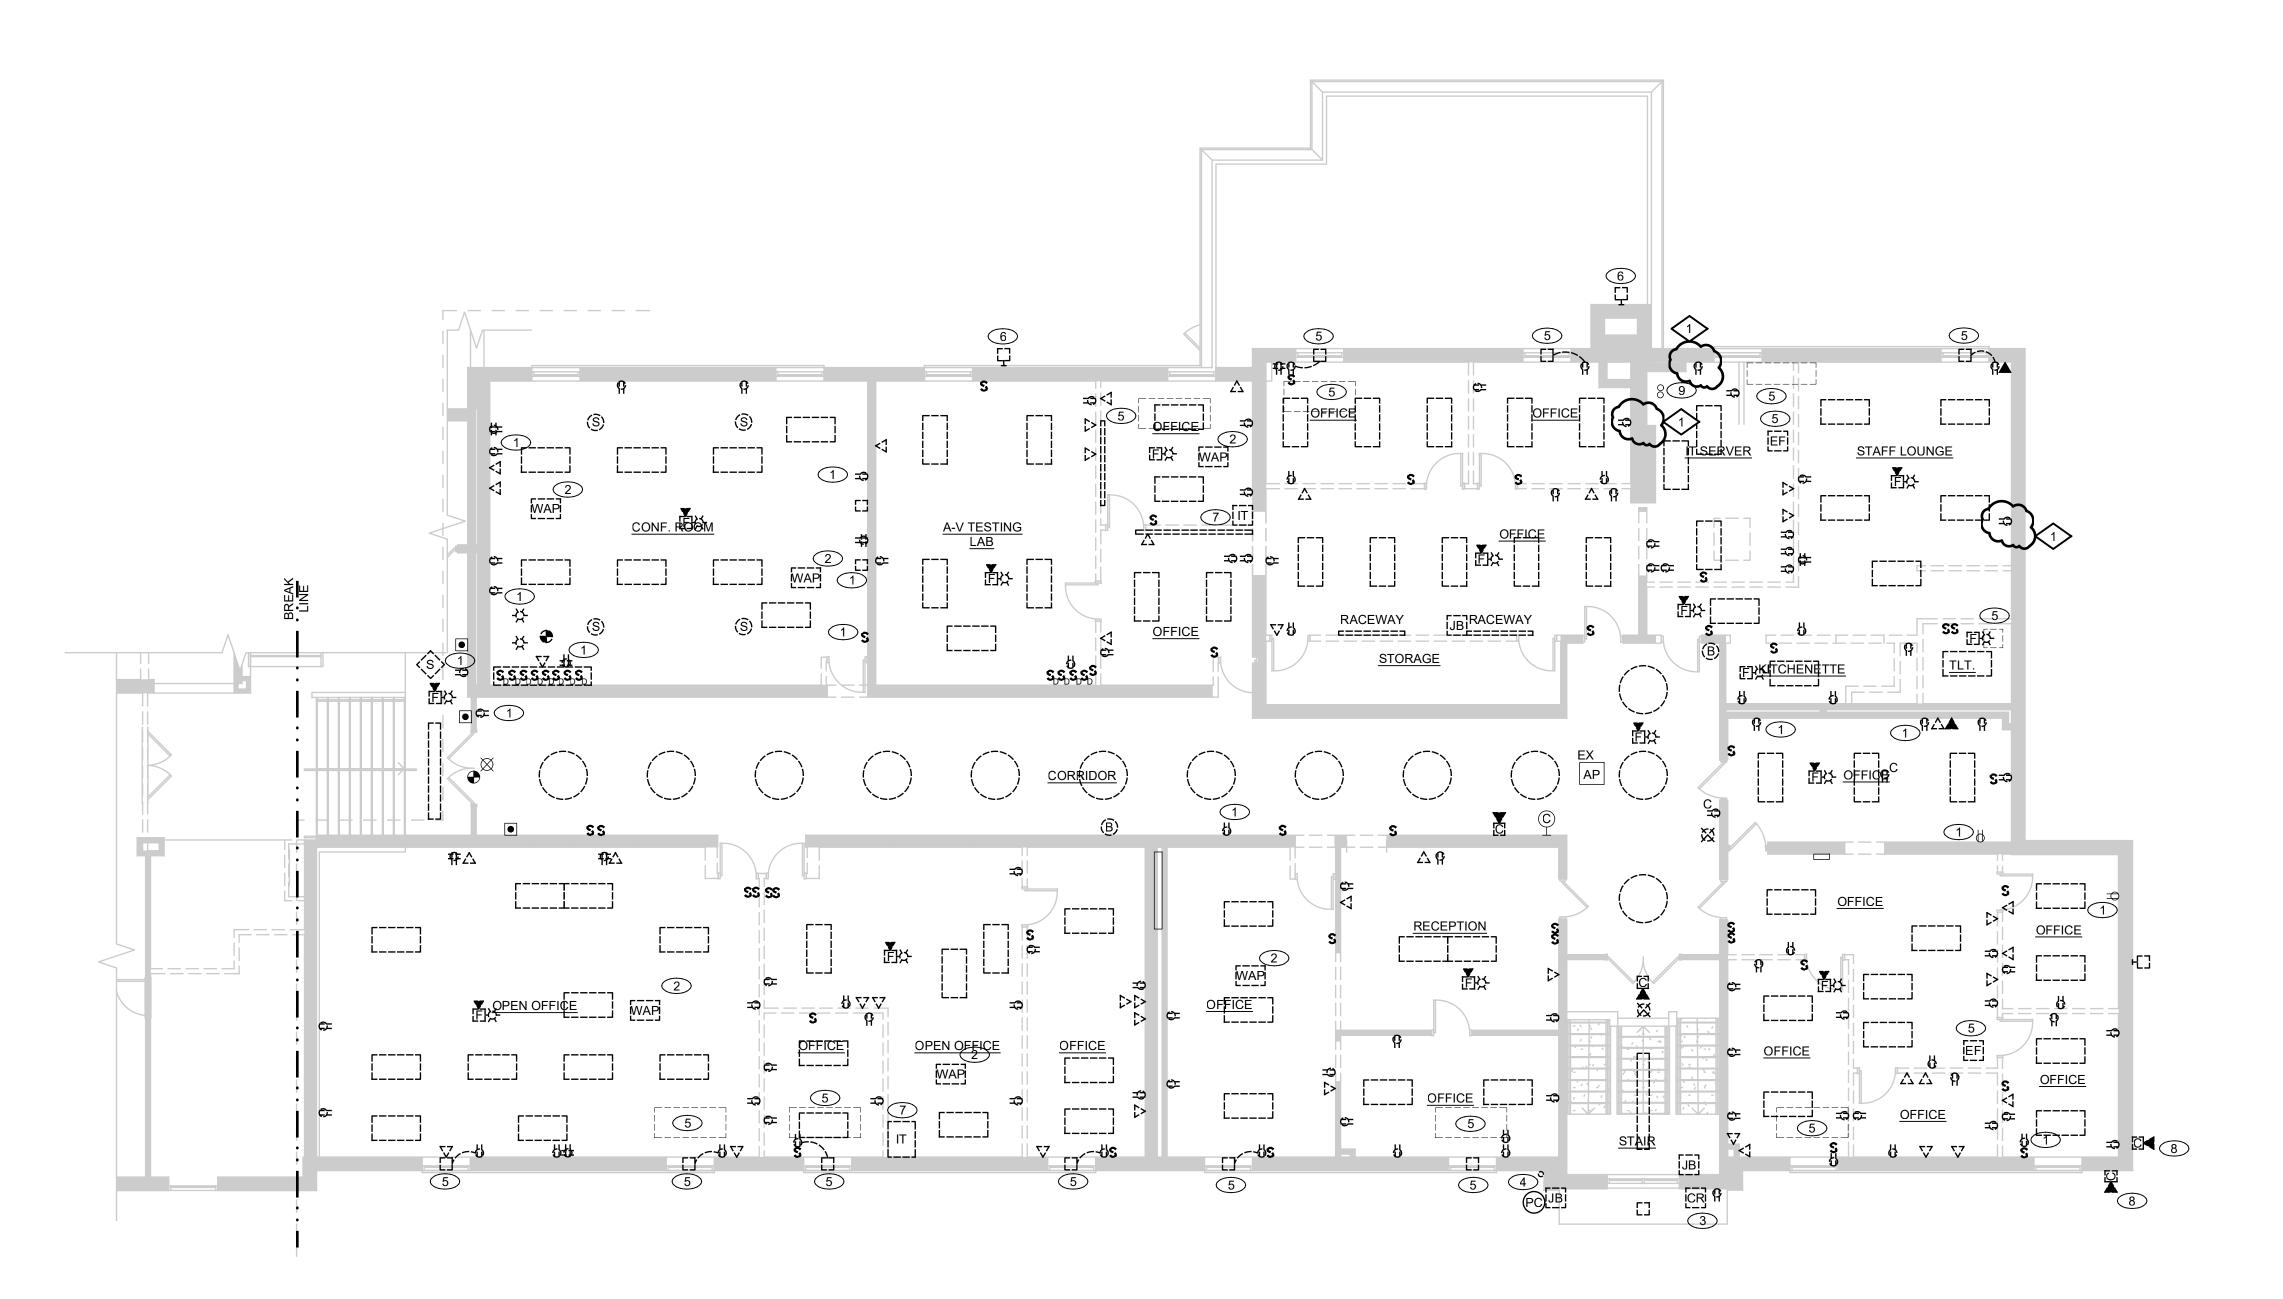

DEMOLITION ELECTRICAL PLAN - MAIN LEVEL NORTH WING - AREA A

1/8"=1'-0"

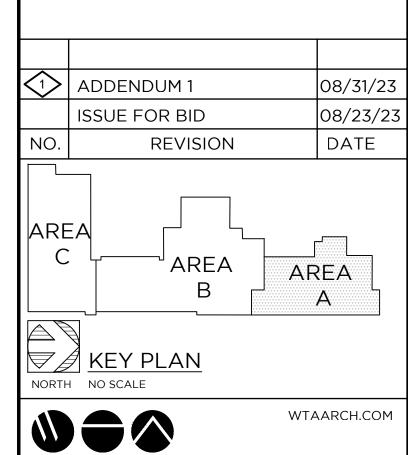



100 S Jefferson Ave, Suite 601

Saginaw, Michigan 48607 989 752 8107

MACMILLAN ASSOCIATES
CONSULTING ENGINEERS
714 EAST MIDLAND STREET • BAY CITY, MICHIGAN 48706
(989) 894-4300 F (989) 894-9930 WWW.MACMILLANASSOCIATES.COM

PROJECT TITLE

ADDITION AND RENOVATION:

MIDLAND COUNTY ESA

MIDLAND, MICHIGAN

DEMOLITION ELECTRICAL
PLAN - MAIN LEVEL
NORTH WING - AREA A

PROJECT NUMBER

2022006.1

PROJECT DATE

AUGUST 23, 2023

CHECKED BY

\_ E1.03


SHEET NUMBER

#### KEYED NOTES


- 1 INSTALL HALLWAY OCCUPANCY SENSOR PER MANUFACTURER'S INSTRUCTIONS. MOUNT AT 7' AFF WITH CLEAR LINE-OF-SIGHT.
- REUSE EXISTING LIGHTING CIRCUITING TO FEED NEW LIGHTS. MODIFY AND EXTEND CIRCUIT AS REQUIRED.

#### LIGHTING WIRING METHODS

- EXIT LIGHTS SHALL OPERATE 24-7 AND ARE EQUIPPED WITH A BATTERY RATED FOR 90 MINUTES, WIRE THE EXIT LIGHT TO THE LOCAL LIGHTING CIRCUIT AHEAD OF ANY SWITCHING.
- HALF-TONE SHADED FIXTURES REPRESENTS THE FIXTURE IS AN EMERGENCY LIGHT AND EQUIPPED WITH AN EMERGENCY BATTERY PACK.
- CONFIRM LIGHT FIXTURE LAYOUT WITH THE ARCHITECTURAL REFLECTED CEILING PLAN AND ARCHITECTURAL DETAILS FOR LOCATION AND MOUNTING DETAILS.
- MC CABLE IS ONLY ACCEPTABLE AS A FINAL WIRING CONNECTION TO RECESSED LIGHTING INSTALLED IN ACCESSIBLE CEILINGS. MC CABLE LENGTH SHALL NOT EXCEED 6'-0".
- PROVIDE AN EQUIPMENT GROUNDING CONDUCTOR FOR LIGHTING CIRCUITS. THE USE OF THE RACEWAY FOR A GROUNDING PATH IS NOT ACCEPTABLE FOR THIS PROJECT.
- 6. SMALL ROOMS SUCH AS STORAGE ROOM, INDIVIDUAL TOILET ROOMS, JANITORS CLOSET, DATA CLOSET AND OFFICES SHALL HAVE WALL SWITCH TYPE OCCUPANCY SENSORS SWITCHES TO AUTOMATICALLY CONTROL THE LIGHTS AS NOTED AND SPECIFIED ON THE DRAWINGS.
- 7. OCCUPANCY SENSORS, POWER PACKS AND CONTROLS ARE SHOWN DIAGRAMMATICALLY. INFRARED SENSORS MUST REMAIN AT A MINIMUM OF 4'-0" AWAY FROM ANY MECHANICAL HEAT DIFFUSER TO ELIMINATE FALSE TRIPS. CIRCUIT LINES ARE SHOWN FROM SWITCHES TO LIGHT FIXTURES TO COMMUNICATE SWITCHING CONFIGURATION ONLY. ALL SENSORS, POWER PACKS AND WIRING MUST BE WIRED PER MANUFACTURER'S WIRING METHOD.
- 8. A SINGLE POWER PACK CAN HAVE MULTIPLE SWITCHES WIRED TO THE DEVICE PROVIDED THAT THE FIXTURES BEING CONTROLLED BY THESE SWITCHES ARE ON THE SAME CIRCUIT. TWO POWER PACKS ARE REQUIRED IF A SECOND CIRCUIT IS INTRODUCED. REFER TO MANUFACTURER'S WIRING METHODS. POWER PACKS AND OR OCCUPANCY SENSORS SHALL INCLUDE A HVAC RELAY AS SCHEDULED AND NOTED ON THE DRAWINGS FOR THE BUILDING AUTOMATION SYSTEM CONNECTION. BUILDING AUTOMATION WIRING SHALL BE COMPLETED AS PART OF THE TEMPERATURE CONTROL CONTRACTOR'S BID.
- THE ELECTRICAL CONTRACTOR SHALL BE RESPONSIBLE FOR FIRE STOPPING PENETRATIONS THRU FIRE RATED WALLS FOR THEIR WORK.
   POWER PACKS SHOWN DIAGRAMMATICALLY. WHEN SHOWN IN GYP BOARD CEILING, LOCATE POWER PACK IN NEAREST LAY-IN CEILING OR CLOSET SPACE.

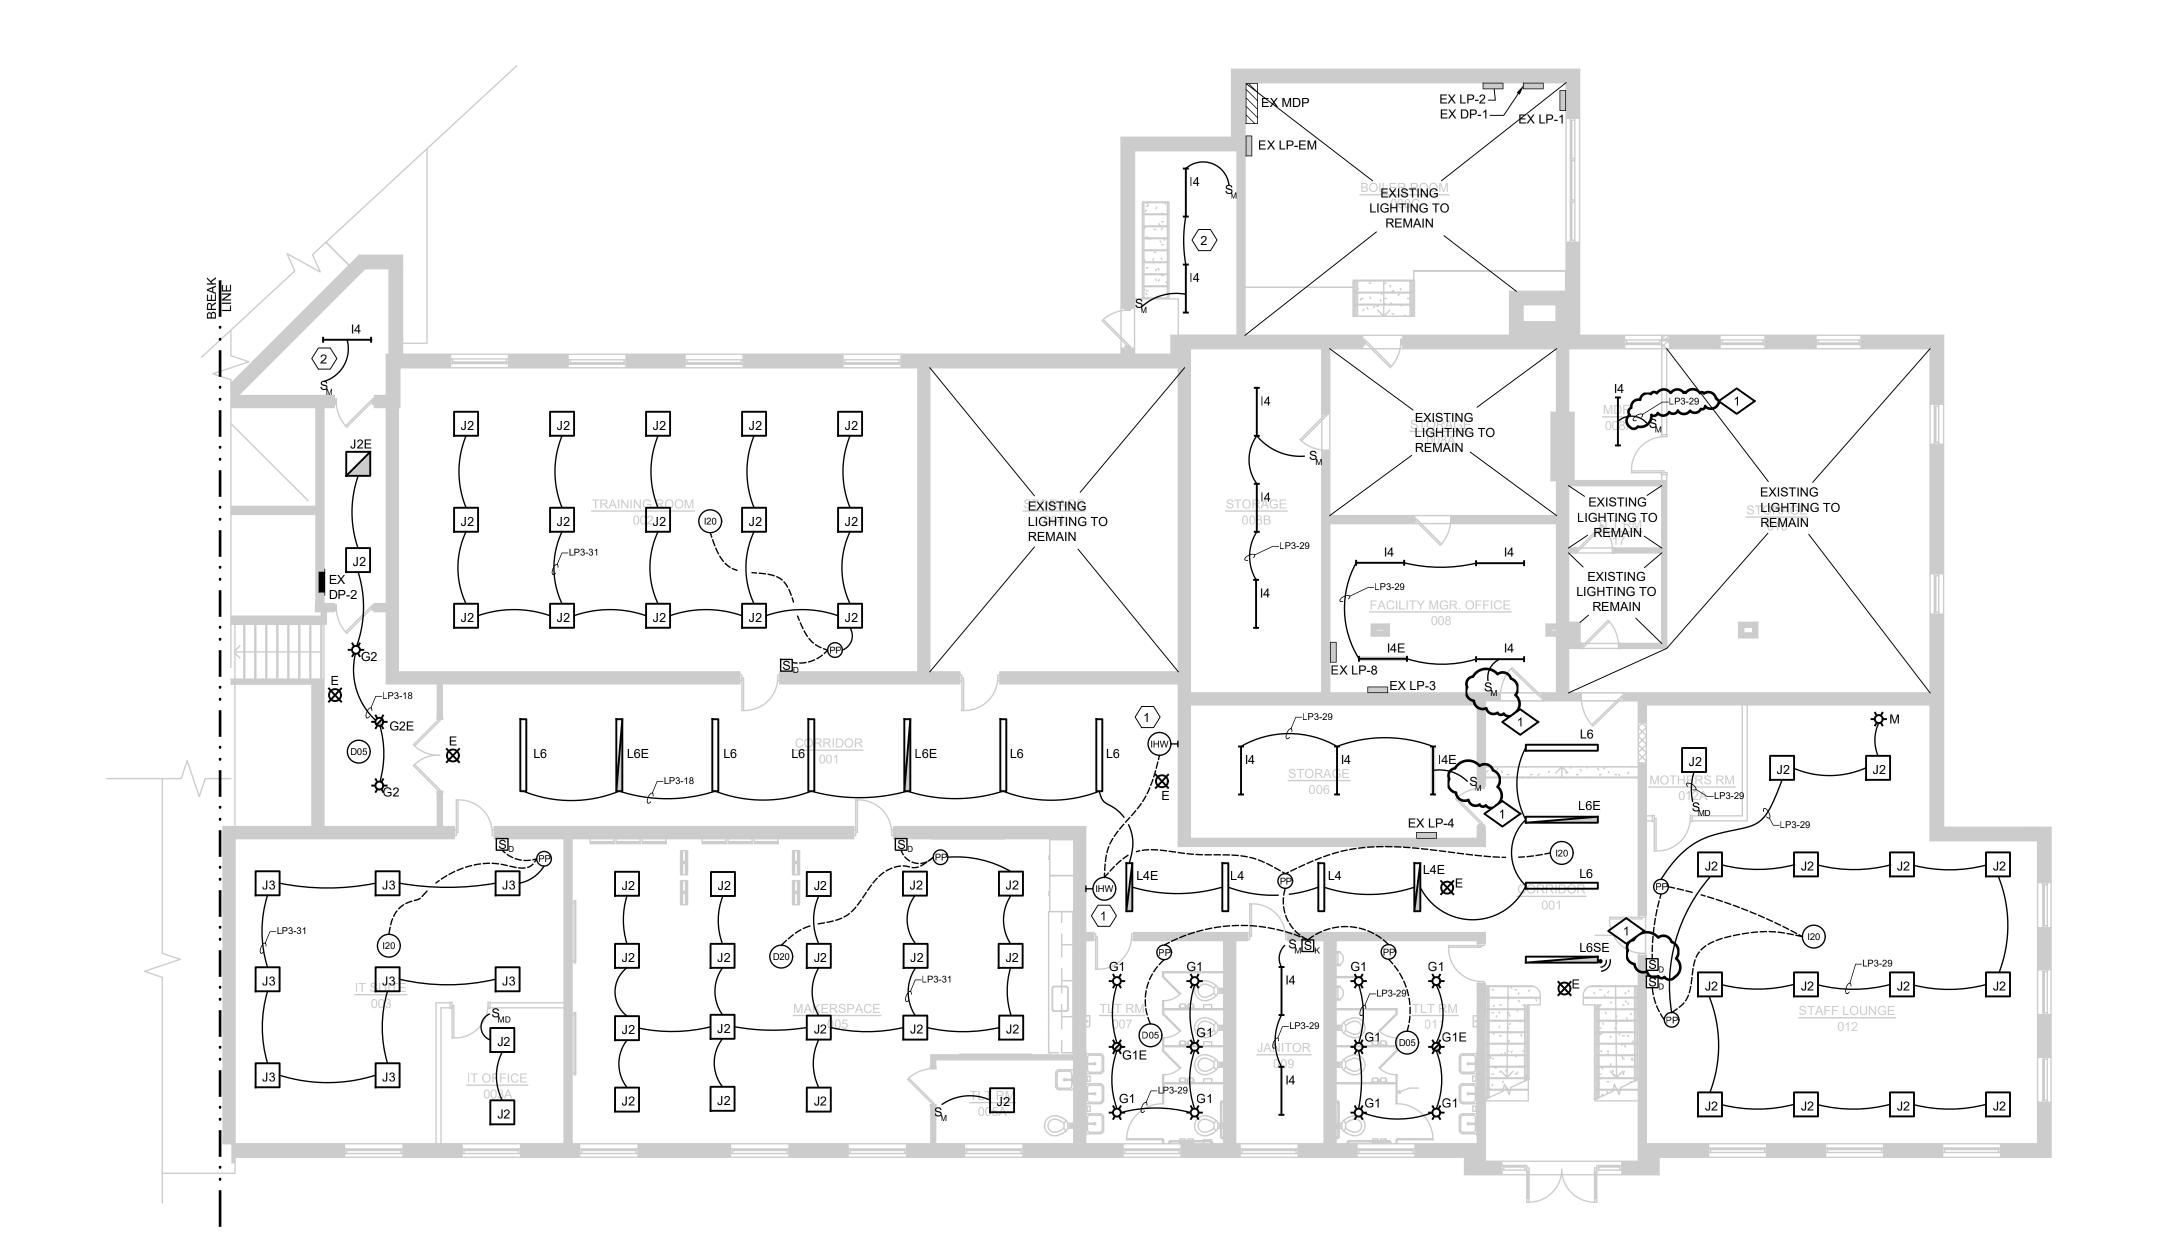



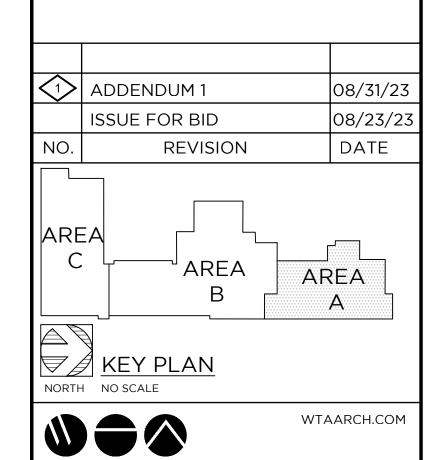



100 S Jefferson Ave, Suite 601 Saginaw, Michigan 48607 989 752 8107

MACMILLAN ASSOCIATES

CONSULTING ENGINEERS

714 EAST MIDLAND STREET • BAY CITY, MICHIGAN 48706
(989) 894-4300 F (989) 894-9930 WWW.MACMILLANASSOCIATES.COM

PROJECT TITLE

ADDITION AND RENOVATION:

MIDLAND COUNTY ESA

LIGHTING PLAN
LOWER LEVEL
AREA A

MIDLAND, MICHIGAN

PROJECT NUMBER

2022006.1


PROJECT DATE

AUGUST 23, 2023


CHECKED BY

\_\_ E2.01

SHEET NUMBER

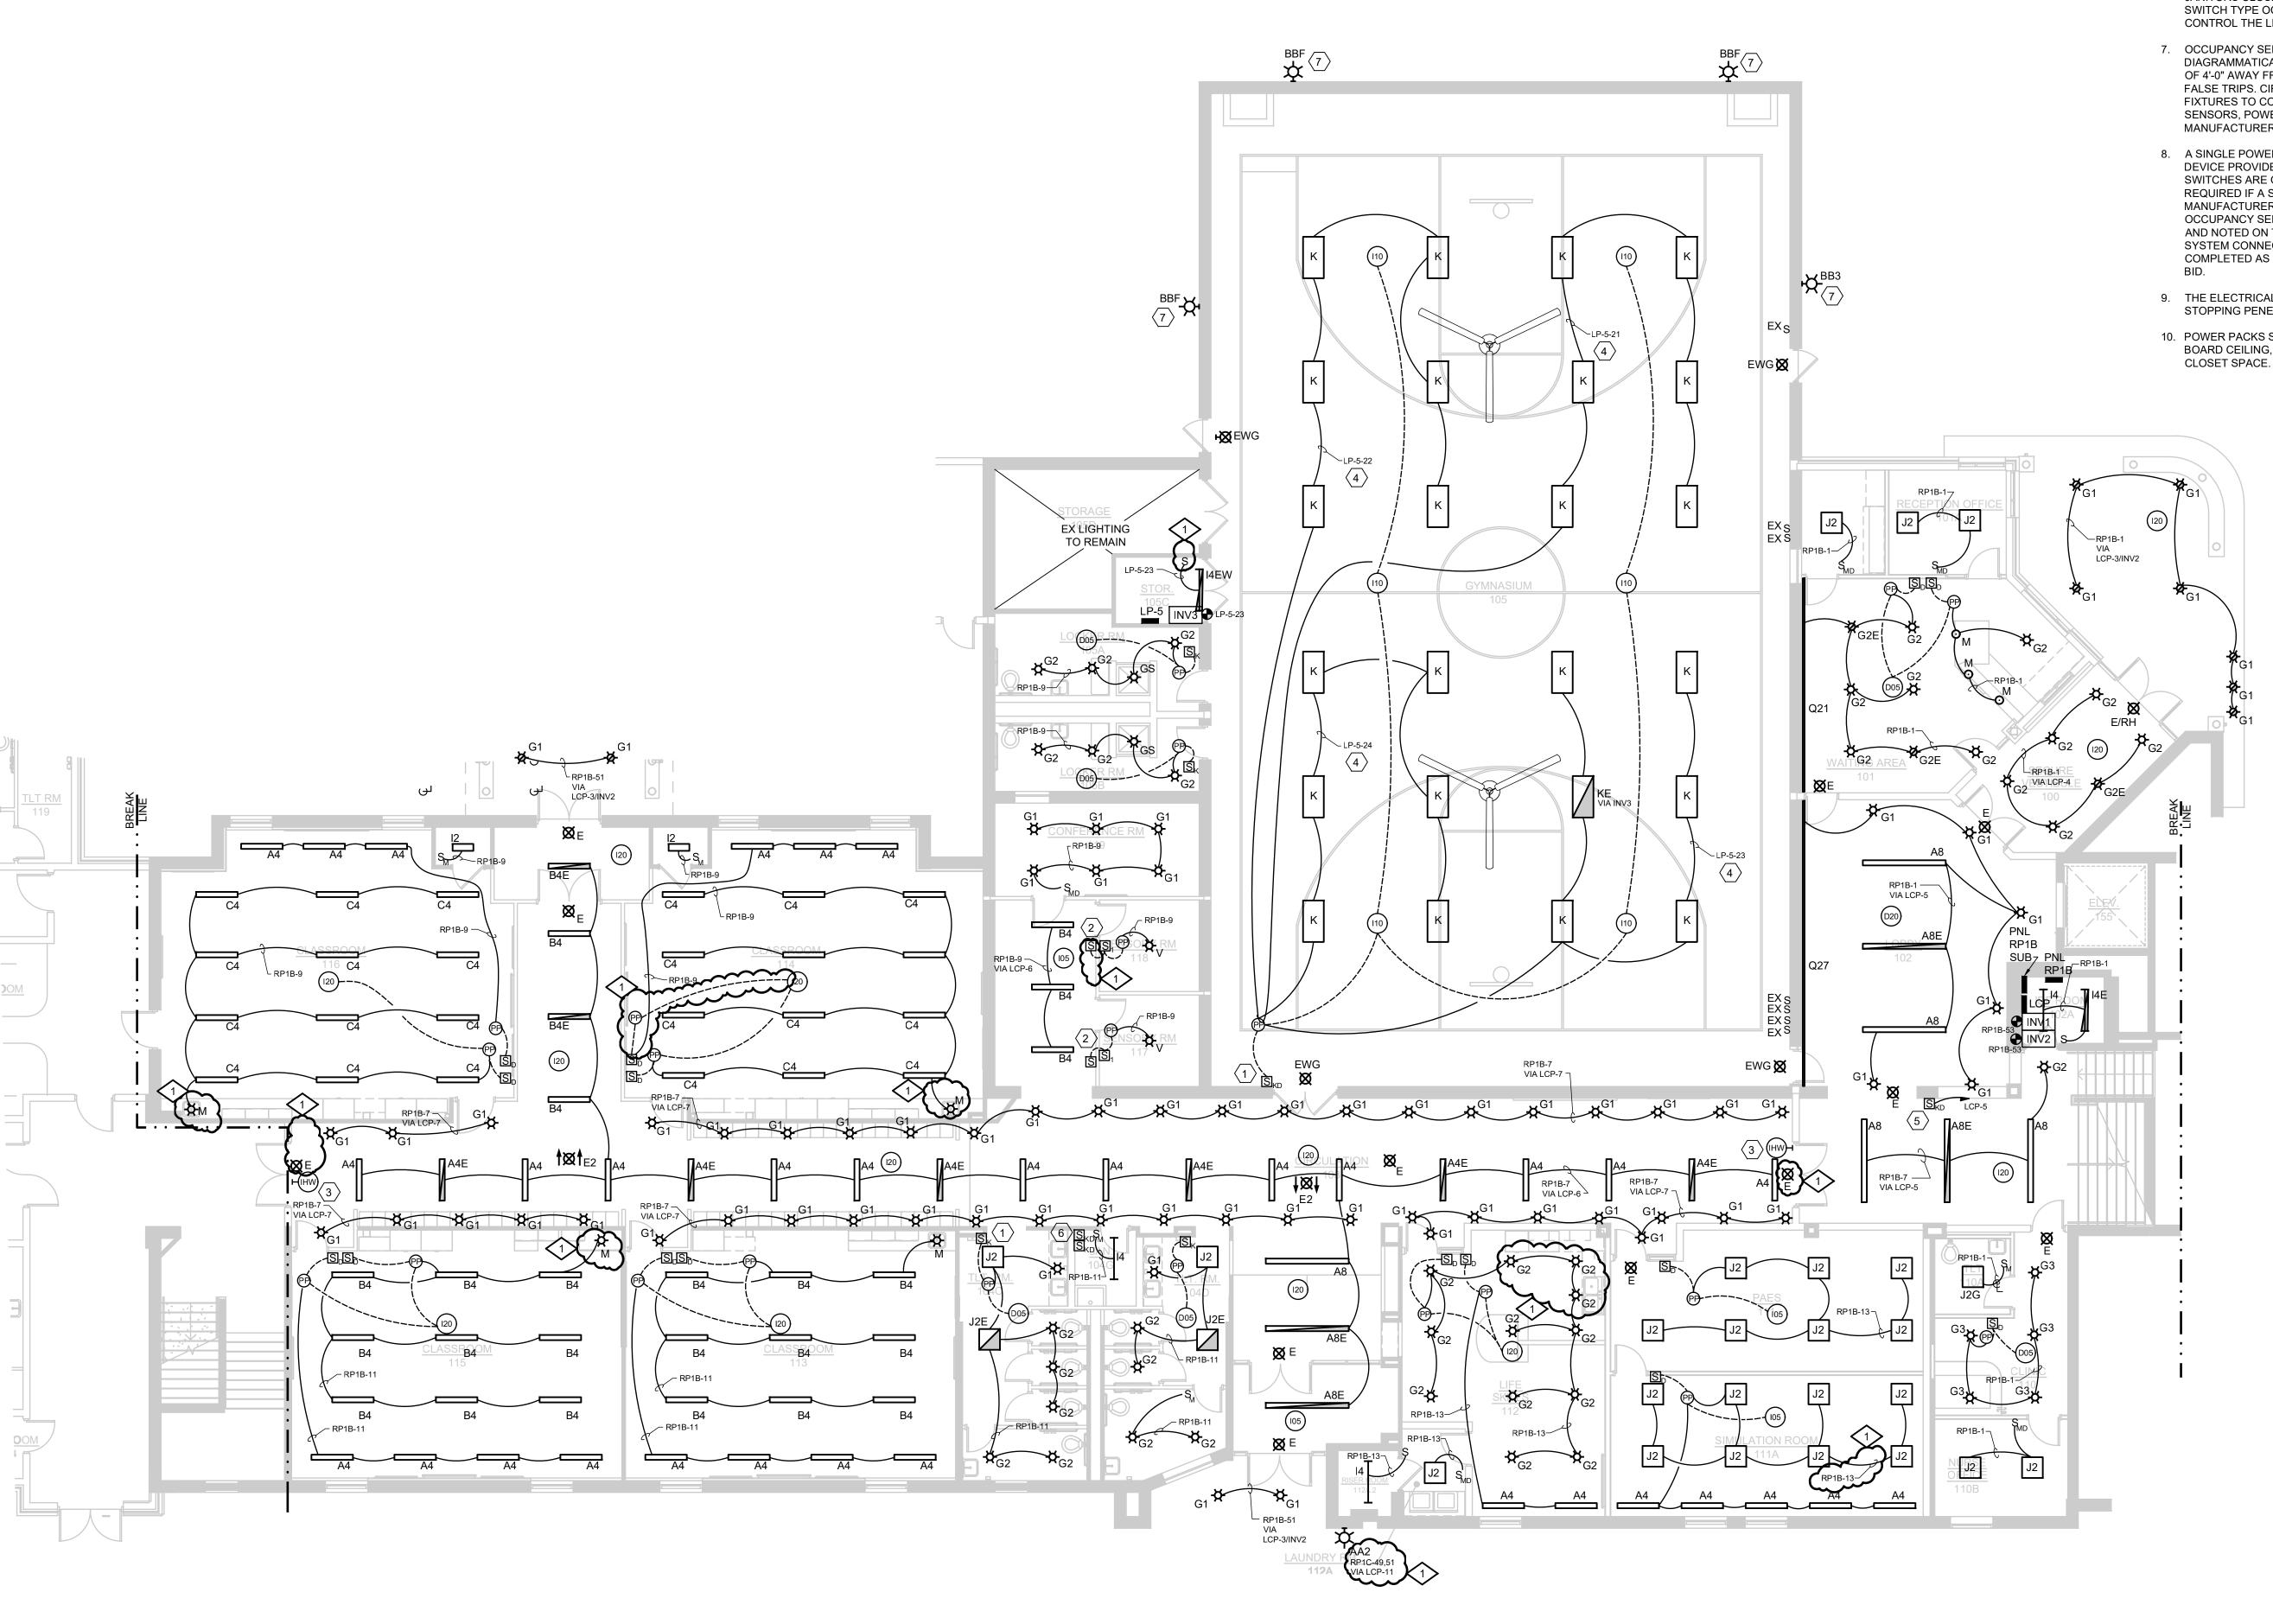


LIGHTING PLAN - MAIN LEVEL SOUTH WING - AREA B

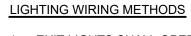

- 1 EXISTING ROUGH IN TO BE REUSED. FURNISH AND INSTALL NEW DEVICE.
- 2 SWITCH ON EXTERIOR OF SENSORY ROOM TO OVERRIDE SWITCH ON THE
- 3 INSTALL HALLWAY OCCUPANCY SENSOR PER MANUFACTURER'S INSTRUCTIONS. MOUNT AT 7' AFF WITH CLEAR LINE-OF-SIGHT.

**KEYED NOTES** 

- REPLACE EXISTING GYM LIGHT FIXTURES ONE-FOR-ONE. REUSE EXISTING LP-5 CIRCUIT. MODIFY AND EXTEND AS NECESSARY.
- $\overline{5}$  KEYED SWITCH SHALL BE MANUAL OVERRIDE FOR LOBBY LIGHTING.
- 6 LOW VOLTAGE KEYED SWITCH SHALL BE MANUAL OVERRIDE FOR CORRIDOR LIGHTING.
- $\left\langle 7 \right
  angle$  INSTALL FIXTURE IN SAME LOCATION OF REMOVED FLOODLIGHT. MODIFY AND EXTEND EXISTING CIRCUITING TO FEED NEW FIXTURE AS REQUIRED. ELECTRICAL CONTRACTOR SHALL VERIFY EXISTING CIRCUITING IS 208V, 1PH PRIOR TO ORDERING NEW LIGHT FIXTURES.
- EXIT LIGHTS SHALL OPERATE 24-7 AND ARE EQUIPPED WITH A BATTERY RATED FOR 90 MINUTES, WIRE THE EXIT LIGHT TO THE LOCAL LIGHTING CIRCUIT AHEAD OF ANY SWITCHING.
- 2. HALF-TONE SHADED FIXTURES REPRESENTS THE FIXTURE IS AN EMERGENCY LIGHT AND EQUIPPED WITH AN EMERGENCY BATTERY
- 3. CONFIRM LIGHT FIXTURE LAYOUT WITH THE ARCHITECTURAL REFLECTED CEILING PLAN AND ARCHITECTURAL DETAILS FOR LOCATION AND MOUNTING DETAILS.
- 4. MC CABLE IS ONLY ACCEPTABLE AS A FINAL WIRING CONNECTION TO RECESSED LIGHTING INSTALLED IN ACCESSIBLE CEILINGS. MC CABLE LENGTH SHALL NOT EXCEED 6'-0".
- PROVIDE AN EQUIPMENT GROUNDING CONDUCTOR FOR LIGHTING CIRCUITS. THE USE OF THE RACEWAY FOR A GROUNDING PATH IS NOT ACCEPTABLE FOR THIS PROJECT.
- 6. SMALL ROOMS SUCH AS STORAGE ROOM, INDIVIDUAL TOILET ROOMS, JANITORS CLOSET, DATA CLOSET AND OFFICES SHALL HAVE WALL SWITCH TYPE OCCUPANCY SENSORS SWITCHES TO AUTOMATICALLY CONTROL THE LIGHTS AS NOTED AND SPECIFIED ON THE DRAWINGS.
- 7. OCCUPANCY SENSORS, POWER PACKS AND CONTROLS ARE SHOWN DIAGRAMMATICALLY. INFRARED SENSORS MUST REMAIN AT A MINIMUM OF 4'-0" AWAY FROM ANY MECHANICAL HEAT DIFFUSER TO ELIMINATE FALSE TRIPS. CIRCUIT LINES ARE SHOWN FROM SWITCHES TO LIGHT FIXTURES TO COMMUNICATE SWITCHING CONFIGURATION ONLY. ALL SENSORS, POWER PACKS AND WIRING MUST BE WIRED PER MANUFACTURER'S WIRING METHOD.
- 8. A SINGLE POWER PACK CAN HAVE MULTIPLE SWITCHES WIRED TO THE DEVICE PROVIDED THAT THE FIXTURES BEING CONTROLLED BY THESE SWITCHES ARE ON THE SAME CIRCUIT. TWO POWER PACKS ARE REQUIRED IF A SECOND CIRCUIT IS INTRODUCED. REFER TO MANUFACTURER'S WIRING METHODS. POWER PACKS AND OR OCCUPANCY SENSORS SHALL INCLUDE A HVAC RELAY AS SCHEDULED AND NOTED ON THE DRAWINGS FOR THE BUILDING AUTOMATION SYSTEM CONNECTION. BUILDING AUTOMATION WIRING SHALL BE COMPLETED AS PART OF THE TEMPERATURE CONTROL CONTRACTOR'S
- 9. THE ELECTRICAL CONTRACTOR SHALL BE RESPONSIBLE FOR FIRE STOPPING PENETRATIONS THRU FIRE RATED WALLS FOR THEIR WORK.
- 10. POWER PACKS SHOWN DIAGRAMMATICALLY. WHEN SHOWN IN GYP BOARD CEILING, LOCATE POWER PACK IN NEAREST LAY-IN CEILING OR CLOSET SPACE.

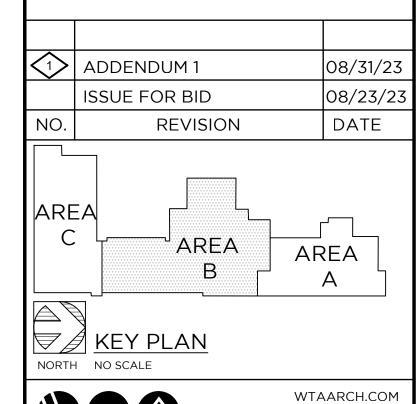



**WTA** ARCHITECTS

100 S Jefferson Ave, Suite 601 Saginaw, Michigan 48607

ADDITION AND RENOVATION:

MIDLAND COUNTY ESA

MIDLAND, MICHIGAN

SHEET TITLE
LIGHTING PLAN -MAIN LEVEL SOUTH WING - AREA B

SHEET NUMBER

E2.02

PROJECT NUMBER 2022006.1 PROJECT DATE

AUGUST 23, 2023 CHECKED BY


## **KEYED NOTES**

- $\langle 1 \rangle$  EXISTING ROUGH-IN TO BE REUSED. FURNISH AND INSTALL NEW DEVICE.
- 2 INSTALL HALLWAY OCCUPANCY SENSOR PER MANUFACTURER'S INSTRUCTIONS. MOUNT AT 7' AFF WITH CLEAR LINE-OF-SIGHT.
- $\overline{\langle 3 \rangle}$  SWITCHES SHOWN DIAGRAMMATICALLY. ALL 3 SWITCHES SHALL BE (4) CUSTOM PENDANT TO BE INSTALLED WITH 3', 5' AND 3' DIAMETER RINGS. SINGULAR POWER FEED WITH 3 POWER CORDS. COORDINATE MOUNTING
- DURING SUBMITTALS PHASE. 5 TYPE L6SE FIXTURE TO BE CONTROLLED WITH STAIRWELL FIXTURES.
- $\langle$  6  $\rangle$  INSTALL FIXTURE IN SAME LOCATION OF REMOVED FLOODLIGHT. MODIFY AND EXTEND EXISTING CIRCUITING TO FEED NEW FIXTURE AS REQUIRED. ELECTRICAL CONTRACTOR SHALL VERIFY EXISTING CIRCUITING IS 208V, 1PH PRIOR TO ORDERING NEW LIGHT FIXTURES.


- 1. EXIT LIGHTS SHALL OPERATE 24-7 AND ARE EQUIPPED WITH A BATTERY RATED FOR 90 MINUTES, WIRE THE EXIT LIGHT TO THE LOCAL LIGHTING CIRCUIT AHEAD OF ANY SWITCHING.
- 2. HALF-TONE SHADED FIXTURES REPRESENTS THE FIXTURE IS AN EMERGENCY LIGHT AND EQUIPPED WITH AN EMERGENCY BATTERY

LIGHTING WIRING METHODS

- 3. CONFIRM LIGHT FIXTURE LAYOUT WITH THE ARCHITECTURAL REFLECTED CEILING PLAN AND ARCHITECTURAL DETAILS FOR LOCATION AND MOUNTING DETAILS.
- 4. MC CABLE IS ONLY ACCEPTABLE AS A FINAL WIRING CONNECTION TO RECESSED LIGHTING INSTALLED IN ACCESSIBLE CEILINGS. MC CABLE LENGTH SHALL NOT EXCEED 6'-0".
- PROVIDE AN EQUIPMENT GROUNDING CONDUCTOR FOR LIGHTING CIRCUITS. THE USE OF THE RACEWAY FOR A GROUNDING PATH IS NOT ACCEPTABLE FOR THIS PROJECT.
- 6. SMALL ROOMS SUCH AS STORAGE ROOM, INDIVIDUAL TOILET ROOMS, JANITORS CLOSET, DATA CLOSET AND OFFICES SHALL HAVE WALL SWITCH TYPE OCCUPANCY SENSORS SWITCHES TO AUTOMATICALLY CONTROL THE LIGHTS AS NOTED AND SPECIFIED ON THE DRAWINGS.
- 7. OCCUPANCY SENSORS, POWER PACKS AND CONTROLS ARE SHOWN DIAGRAMMATICALLY. INFRARED SENSORS MUST REMAIN AT A MINIMUM OF 4'-0" AWAY FROM ANY MECHANICAL HEAT DIFFUSER TO ELIMINATE FALSE TRIPS. CIRCUIT LINES ARE SHOWN FROM SWITCHES TO LIGHT FIXTURES TO COMMUNICATE SWITCHING CONFIGURATION ONLY. ALL SENSORS, POWER PACKS AND WIRING MUST BE WIRED PER MANUFACTURER'S WIRING METHOD.
- 8. A SINGLE POWER PACK CAN HAVE MULTIPLE SWITCHES WIRED TO THE DEVICE PROVIDED THAT THE FIXTURES BEING CONTROLLED BY THESE SWITCHES ARE ON THE SAME CIRCUIT. TWO POWER PACKS ARE REQUIRED IF A SECOND CIRCUIT IS INTRODUCED. REFER TO MANUFACTURER'S WIRING METHODS. POWER PACKS AND OR OCCUPANCY SENSORS SHALL INCLUDE A HVAC RELAY AS SCHEDULED AND NOTED ON THE DRAWINGS FOR THE BUILDING AUTOMATION SYSTEM CONNECTION. BUILDING AUTOMATION WIRING SHALL BE COMPLETED AS PART OF THE TEMPERATURE CONTROL CONTRACTOR'S
- 9. THE ELECTRICAL CONTRACTOR SHALL BE RESPONSIBLE FOR FIRE STOPPING PENETRATIONS THRU FIRE RATED WALLS FOR THEIR WORK.
- 10. POWER PACKS SHOWN DIAGRAMMATICALLY. WHEN SHOWN IN GYP BOARD CEILING, LOCATE POWER PACK IN NEAREST LAY-IN CEILING OR CLOSET SPACE.

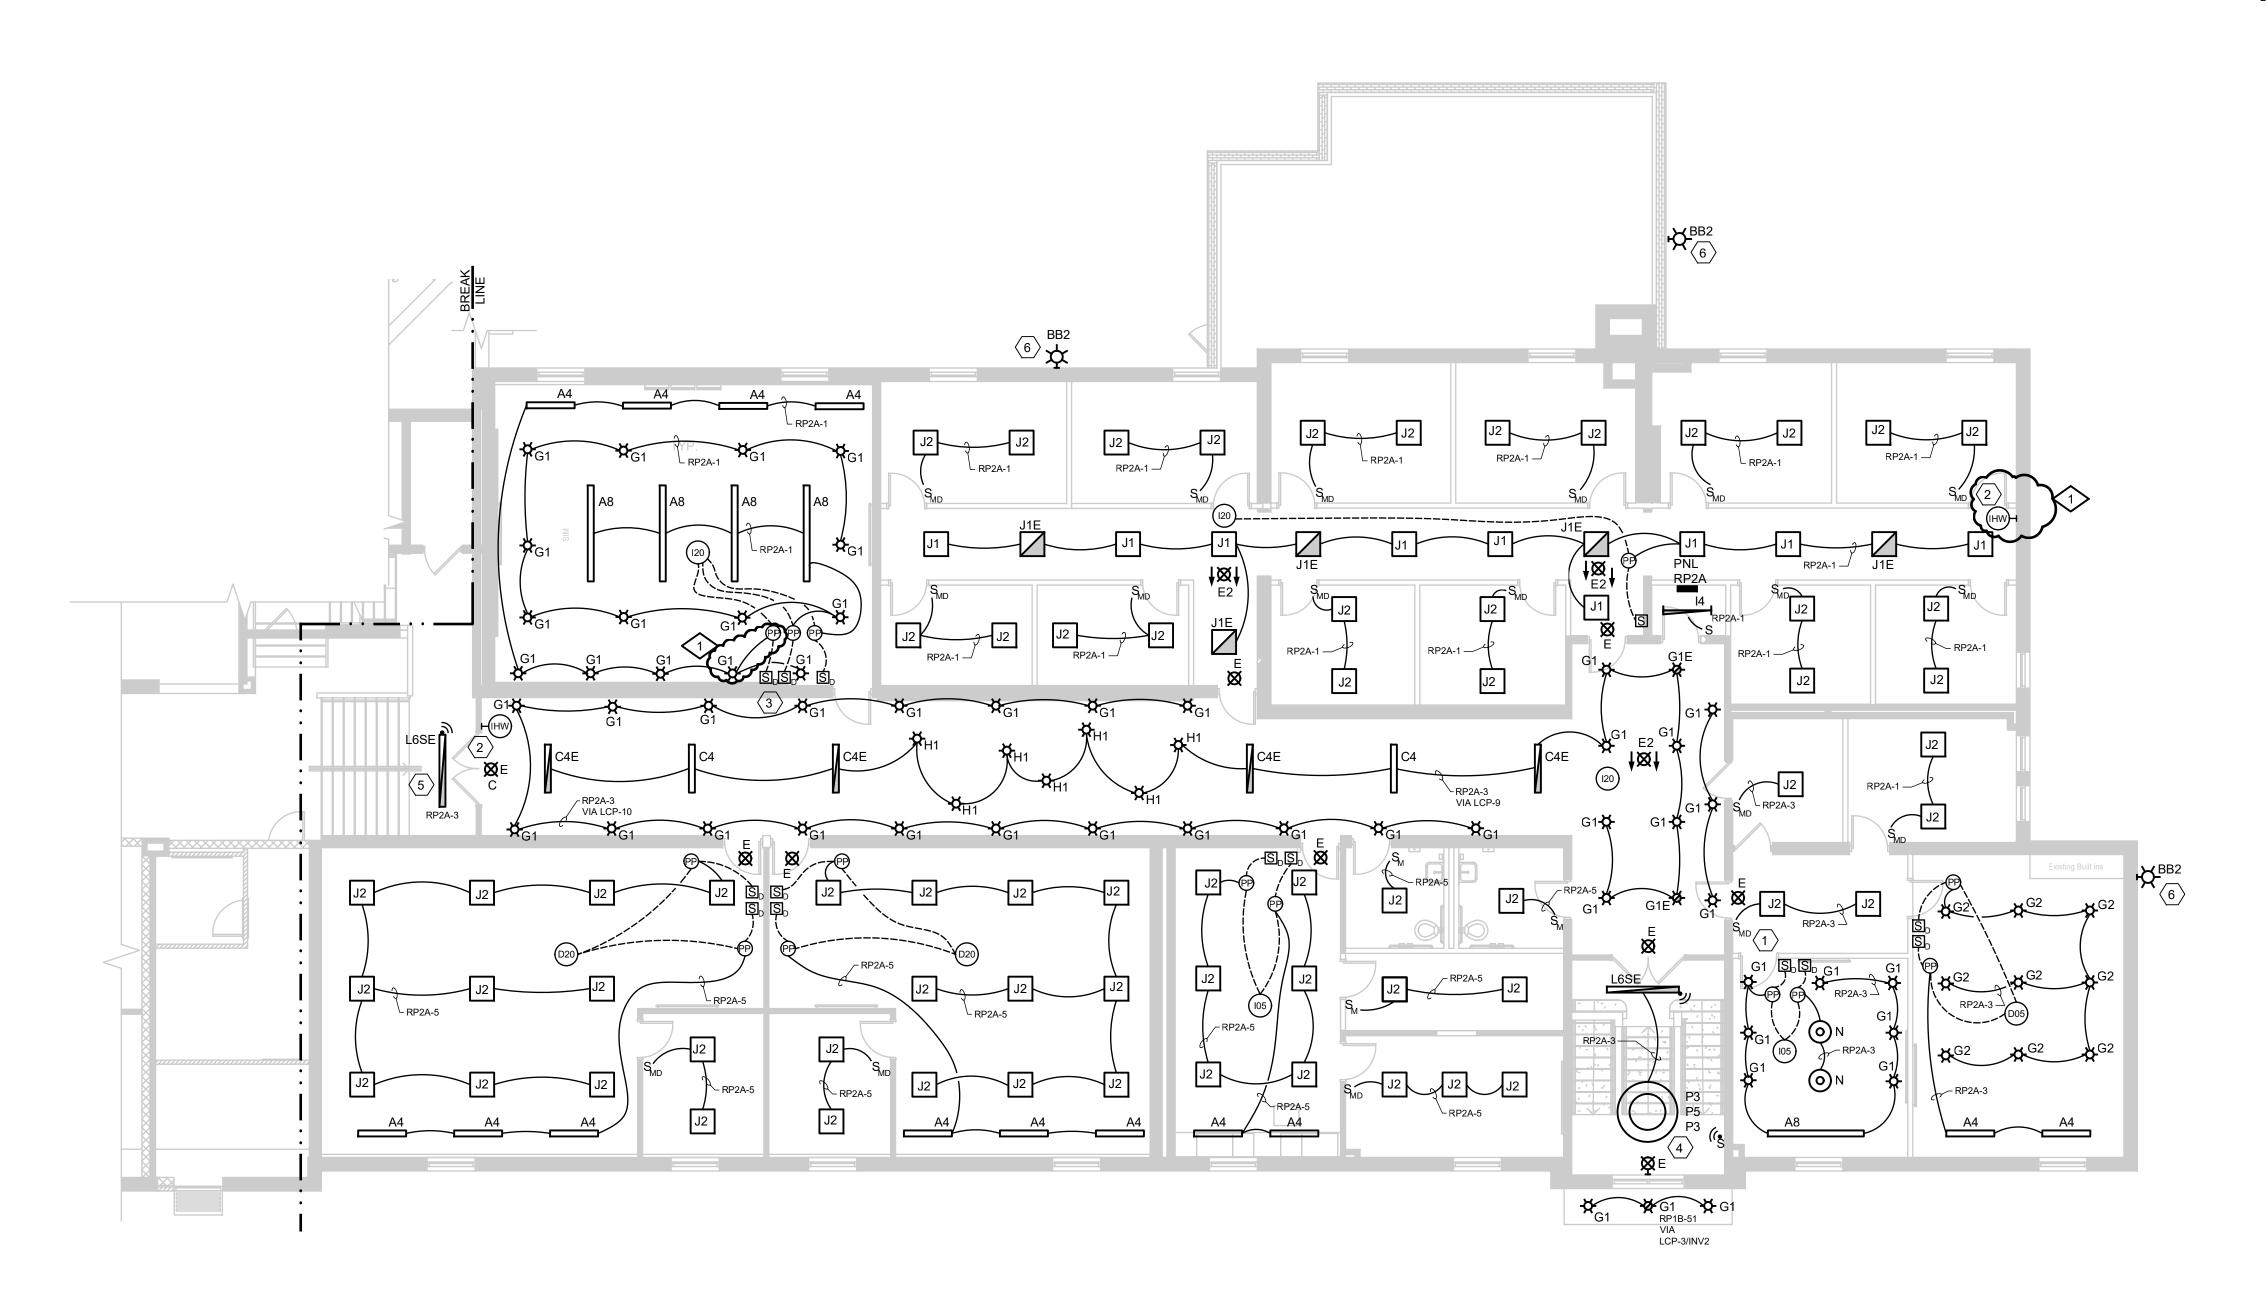



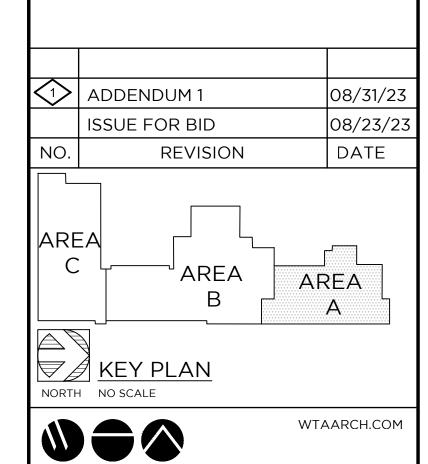



100 S Jefferson Ave, Suite 601 Saginaw, Michigan 48607

ADDITION AND RENOVATION:

MIDLAND COUNTY ESA

MIDLAND, MICHIGAN


SHEET TITLE

LIGHTING PLAN -MAIN LEVEL NORTH WING - AREA A

PROJECT NUMBER 2022006.1 PROJECT DATE

CHECKED BY

SHEET NUMBER E2.03 AUGUST 23, 2023

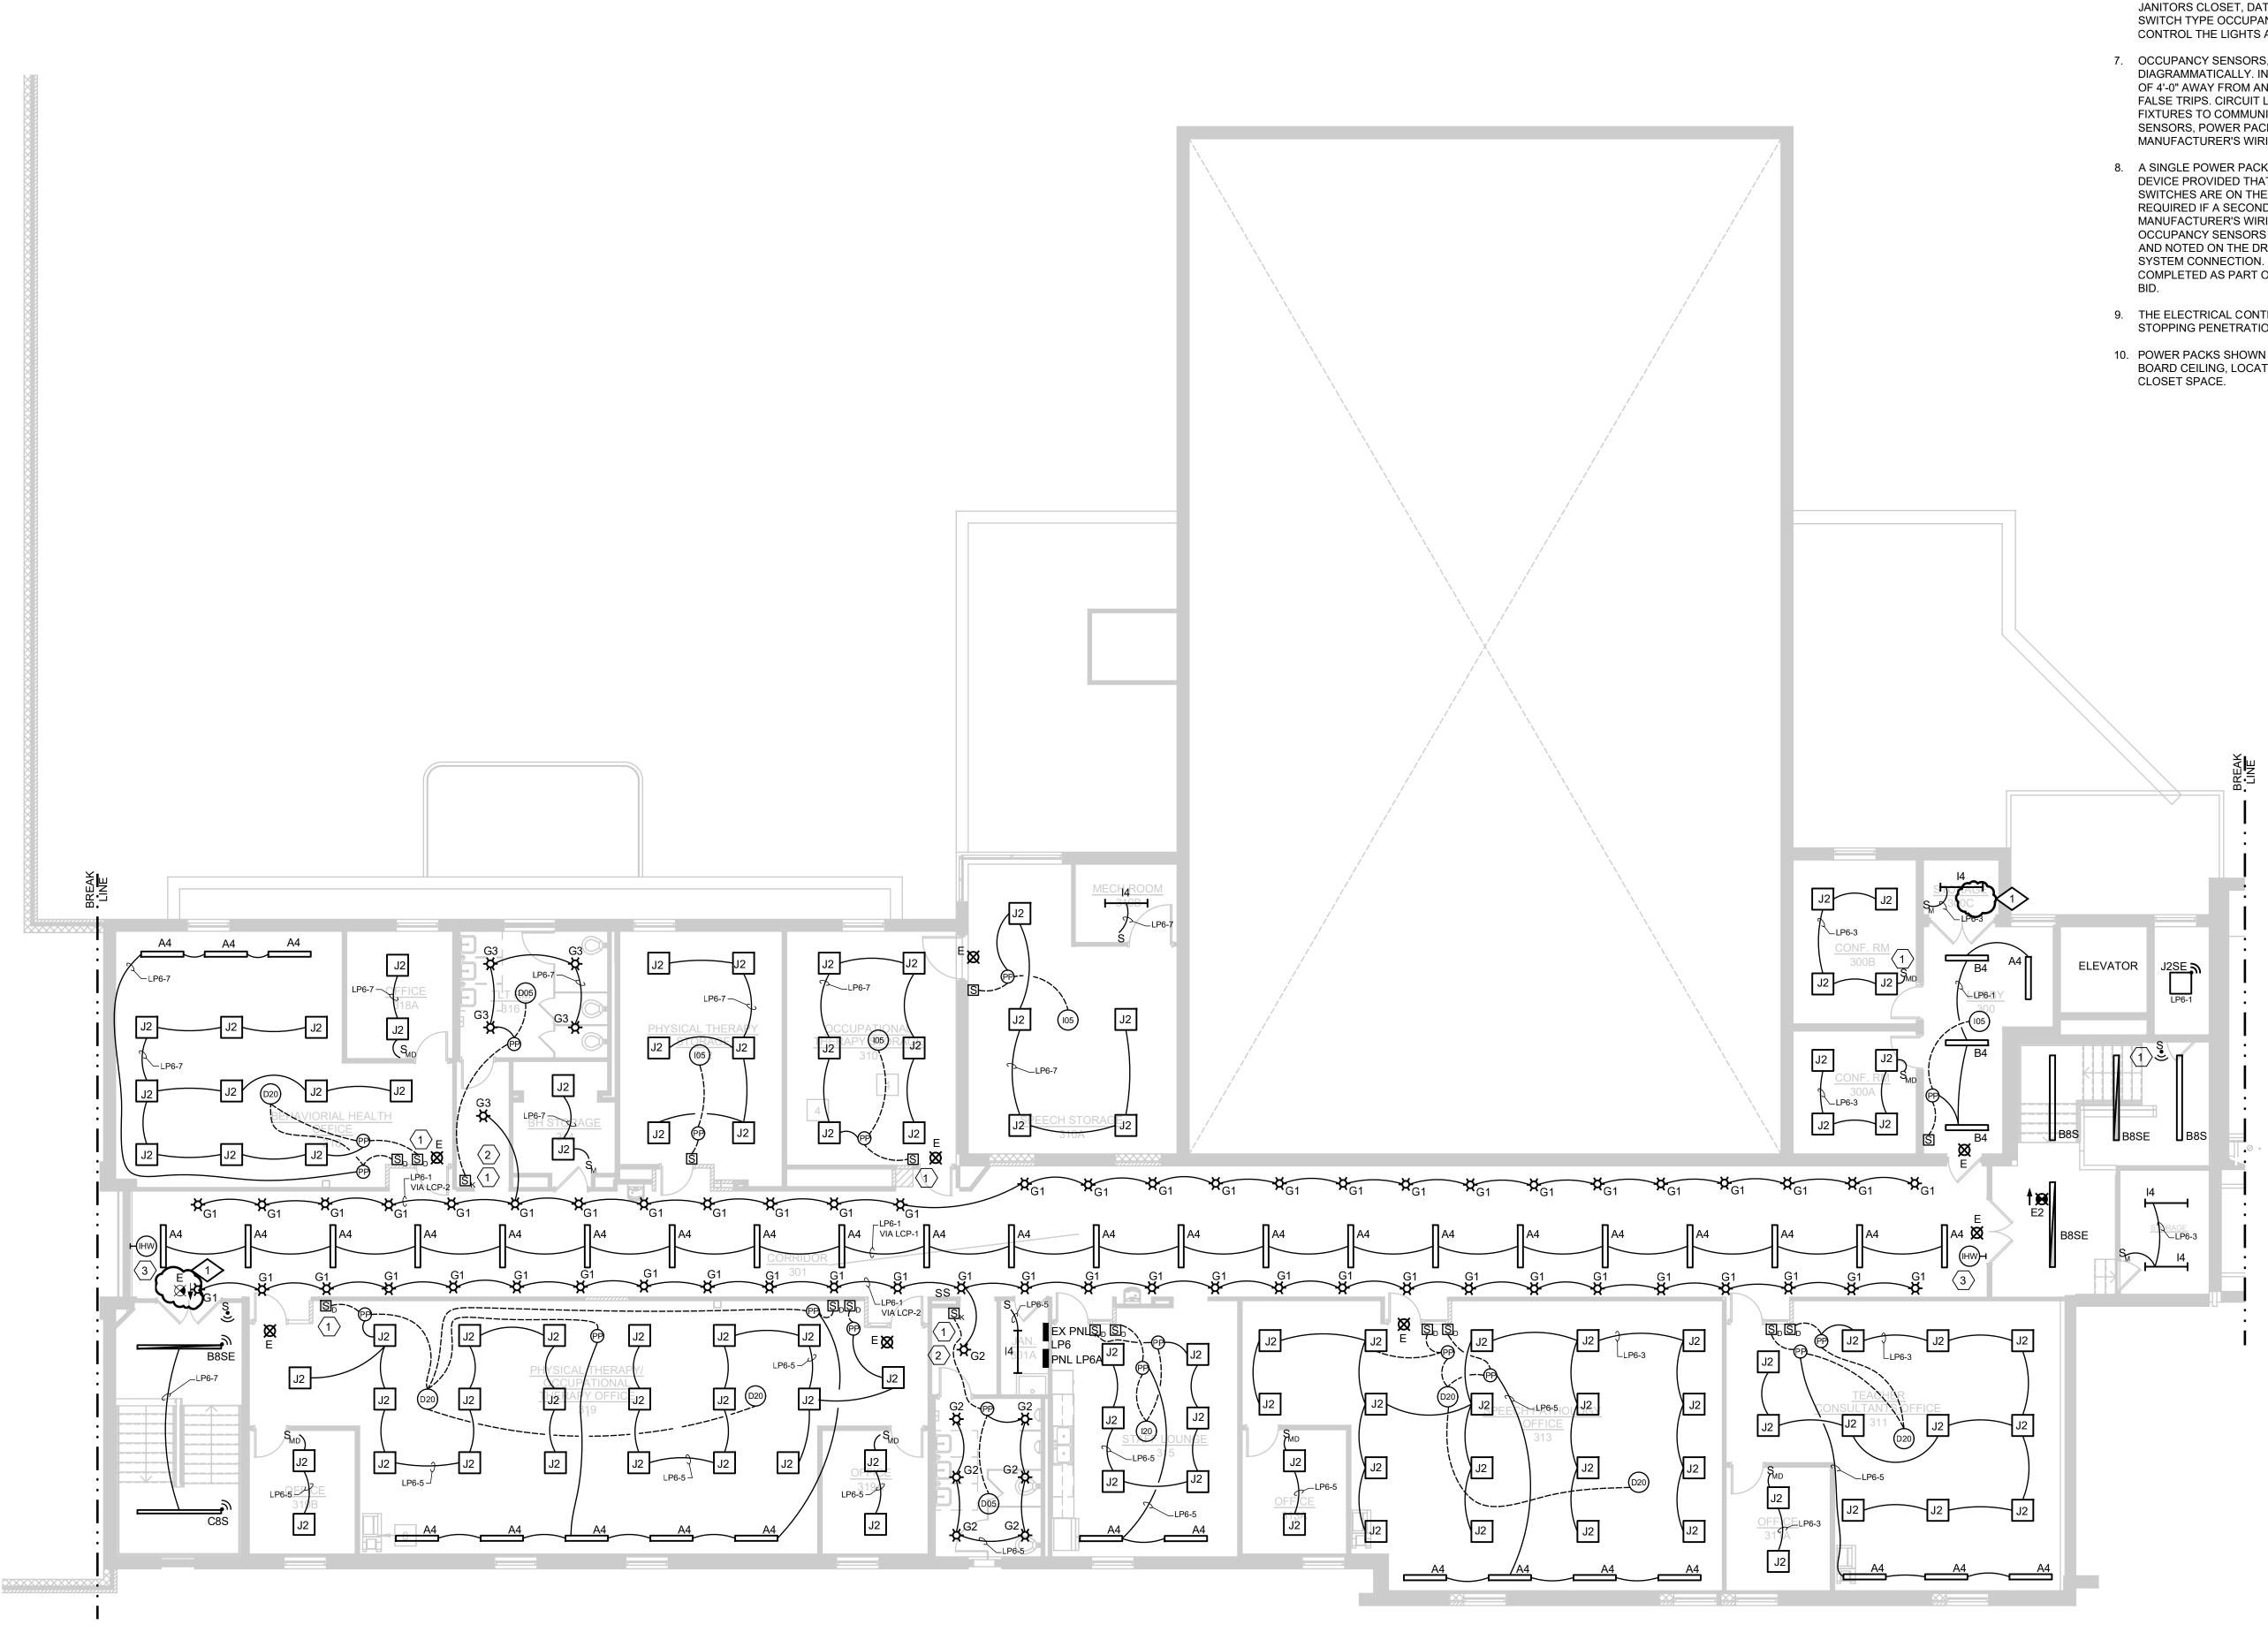

NORTH LIGHTING PLAN - UPPER LEVEL - AREA B

1/8"=1'-0"



**KEYED NOTES** 

LABEL SWITCH.


1 EXISTING ROUGH-IN TO BE REUSED. FURNISH AND INSTALL NEW DEVICE.

(2) KEYED SWITCH SHALL CONTROL RESTROOM LIGHTS. EC SHALL CLEARLY

INSTRUCTIONS. MOUNT AT 7' AFF WITH CLEAR LINE-OF-SIGHT. TIE IN TO

(3) INSTALL HALLWAY OCCUPANCY SENSOR PER MANUFACTURER'S

- EXIT LIGHTS SHALL OPERATE 24-7 AND ARE EQUIPPED WITH A BATTERY RATED FOR 90 MINUTES, WIRE THE EXIT LIGHT TO THE LOCAL LIGHTING CIRCUIT AHEAD OF ANY SWITCHING.
- 2. HALF-TONE SHADED FIXTURES REPRESENTS THE FIXTURE IS AN EMERGENCY LIGHT AND EQUIPPED WITH AN EMERGENCY BATTERY
- 3. CONFIRM LIGHT FIXTURE LAYOUT WITH THE ARCHITECTURAL REFLECTED CEILING PLAN AND ARCHITECTURAL DETAILS FOR LOCATION AND MOUNTING DETAILS.
- 4. MC CABLE IS ONLY ACCEPTABLE AS A FINAL WIRING CONNECTION TO RECESSED LIGHTING INSTALLED IN ACCESSIBLE CEILINGS. MC CABLE LENGTH SHALL NOT EXCEED 6'-0".
- PROVIDE AN EQUIPMENT GROUNDING CONDUCTOR FOR LIGHTING CIRCUITS. THE USE OF THE RACEWAY FOR A GROUNDING PATH IS NOT ACCEPTABLE FOR THIS PROJECT.
- 6. SMALL ROOMS SUCH AS STORAGE ROOM, INDIVIDUAL TOILET ROOMS, JANITORS CLOSET, DATA CLOSET AND OFFICES SHALL HAVE WALL SWITCH TYPE OCCUPANCY SENSORS SWITCHES TO AUTOMATICALLY CONTROL THE LIGHTS AS NOTED AND SPECIFIED ON THE DRAWINGS.
- 7. OCCUPANCY SENSORS, POWER PACKS AND CONTROLS ARE SHOWN DIAGRAMMATICALLY. INFRARED SENSORS MUST REMAIN AT A MINIMUM OF 4'-0" AWAY FROM ANY MECHANICAL HEAT DIFFUSER TO ELIMINATE FALSE TRIPS. CIRCUIT LINES ARE SHOWN FROM SWITCHES TO LIGHT FIXTURES TO COMMUNICATE SWITCHING CONFIGURATION ONLY. ALL SENSORS, POWER PACKS AND WIRING MUST BE WIRED PER MANUFACTURER'S WIRING METHOD.
- 8. A SINGLE POWER PACK CAN HAVE MULTIPLE SWITCHES WIRED TO THE DEVICE PROVIDED THAT THE FIXTURES BEING CONTROLLED BY THESE SWITCHES ARE ON THE SAME CIRCUIT. TWO POWER PACKS ARE REQUIRED IF A SECOND CIRCUIT IS INTRODUCED. REFER TO MANUFACTURER'S WIRING METHODS. POWER PACKS AND OR OCCUPANCY SENSORS SHALL INCLUDE A HVAC RELAY AS SCHEDULED AND NOTED ON THE DRAWINGS FOR THE BUILDING AUTOMATION SYSTEM CONNECTION. BUILDING AUTOMATION WIRING SHALL BE COMPLETED AS PART OF THE TEMPERATURE CONTROL CONTRACTOR'S
- THE ELECTRICAL CONTRACTOR SHALL BE RESPONSIBLE FOR FIRE STOPPING PENETRATIONS THRU FIRE RATED WALLS FOR THEIR WORK.
- POWER PACKS SHOWN DIAGRAMMATICALLY. WHEN SHOWN IN GYP BOARD CEILING, LOCATE POWER PACK IN NEAREST LAY-IN CEILING OR CLOSET SPACE.

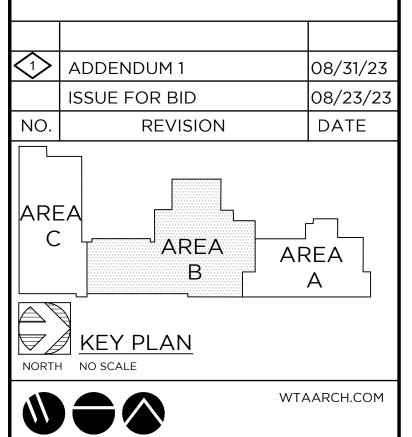

WTA ARCHITECTS

100 S Jefferson Ave, Suite 601 Saginaw, Michigan 48607 989 752 8107

> MACMILLAN ASSOCIAT CONSULTING ENGINEE 714 EAST MIDLAND STREET • BAY CITY, MICHIGAN 48706 (989) 894-4300 f (989) 894-9930 www.macmillanassociates

PROJECT TITLE

ADDITION AND RENOVATION:

MIDLAND COUNTY ESA

SHEET NUMBER


E2.04

MIDLAND, MICHIGAN

LIGHTING PLAN -UPPER LEVEL AREA B


PROJECT NUMBER
2022006.1

PROJECT DATE
AUGUST 23, 2023
CHECKED BY

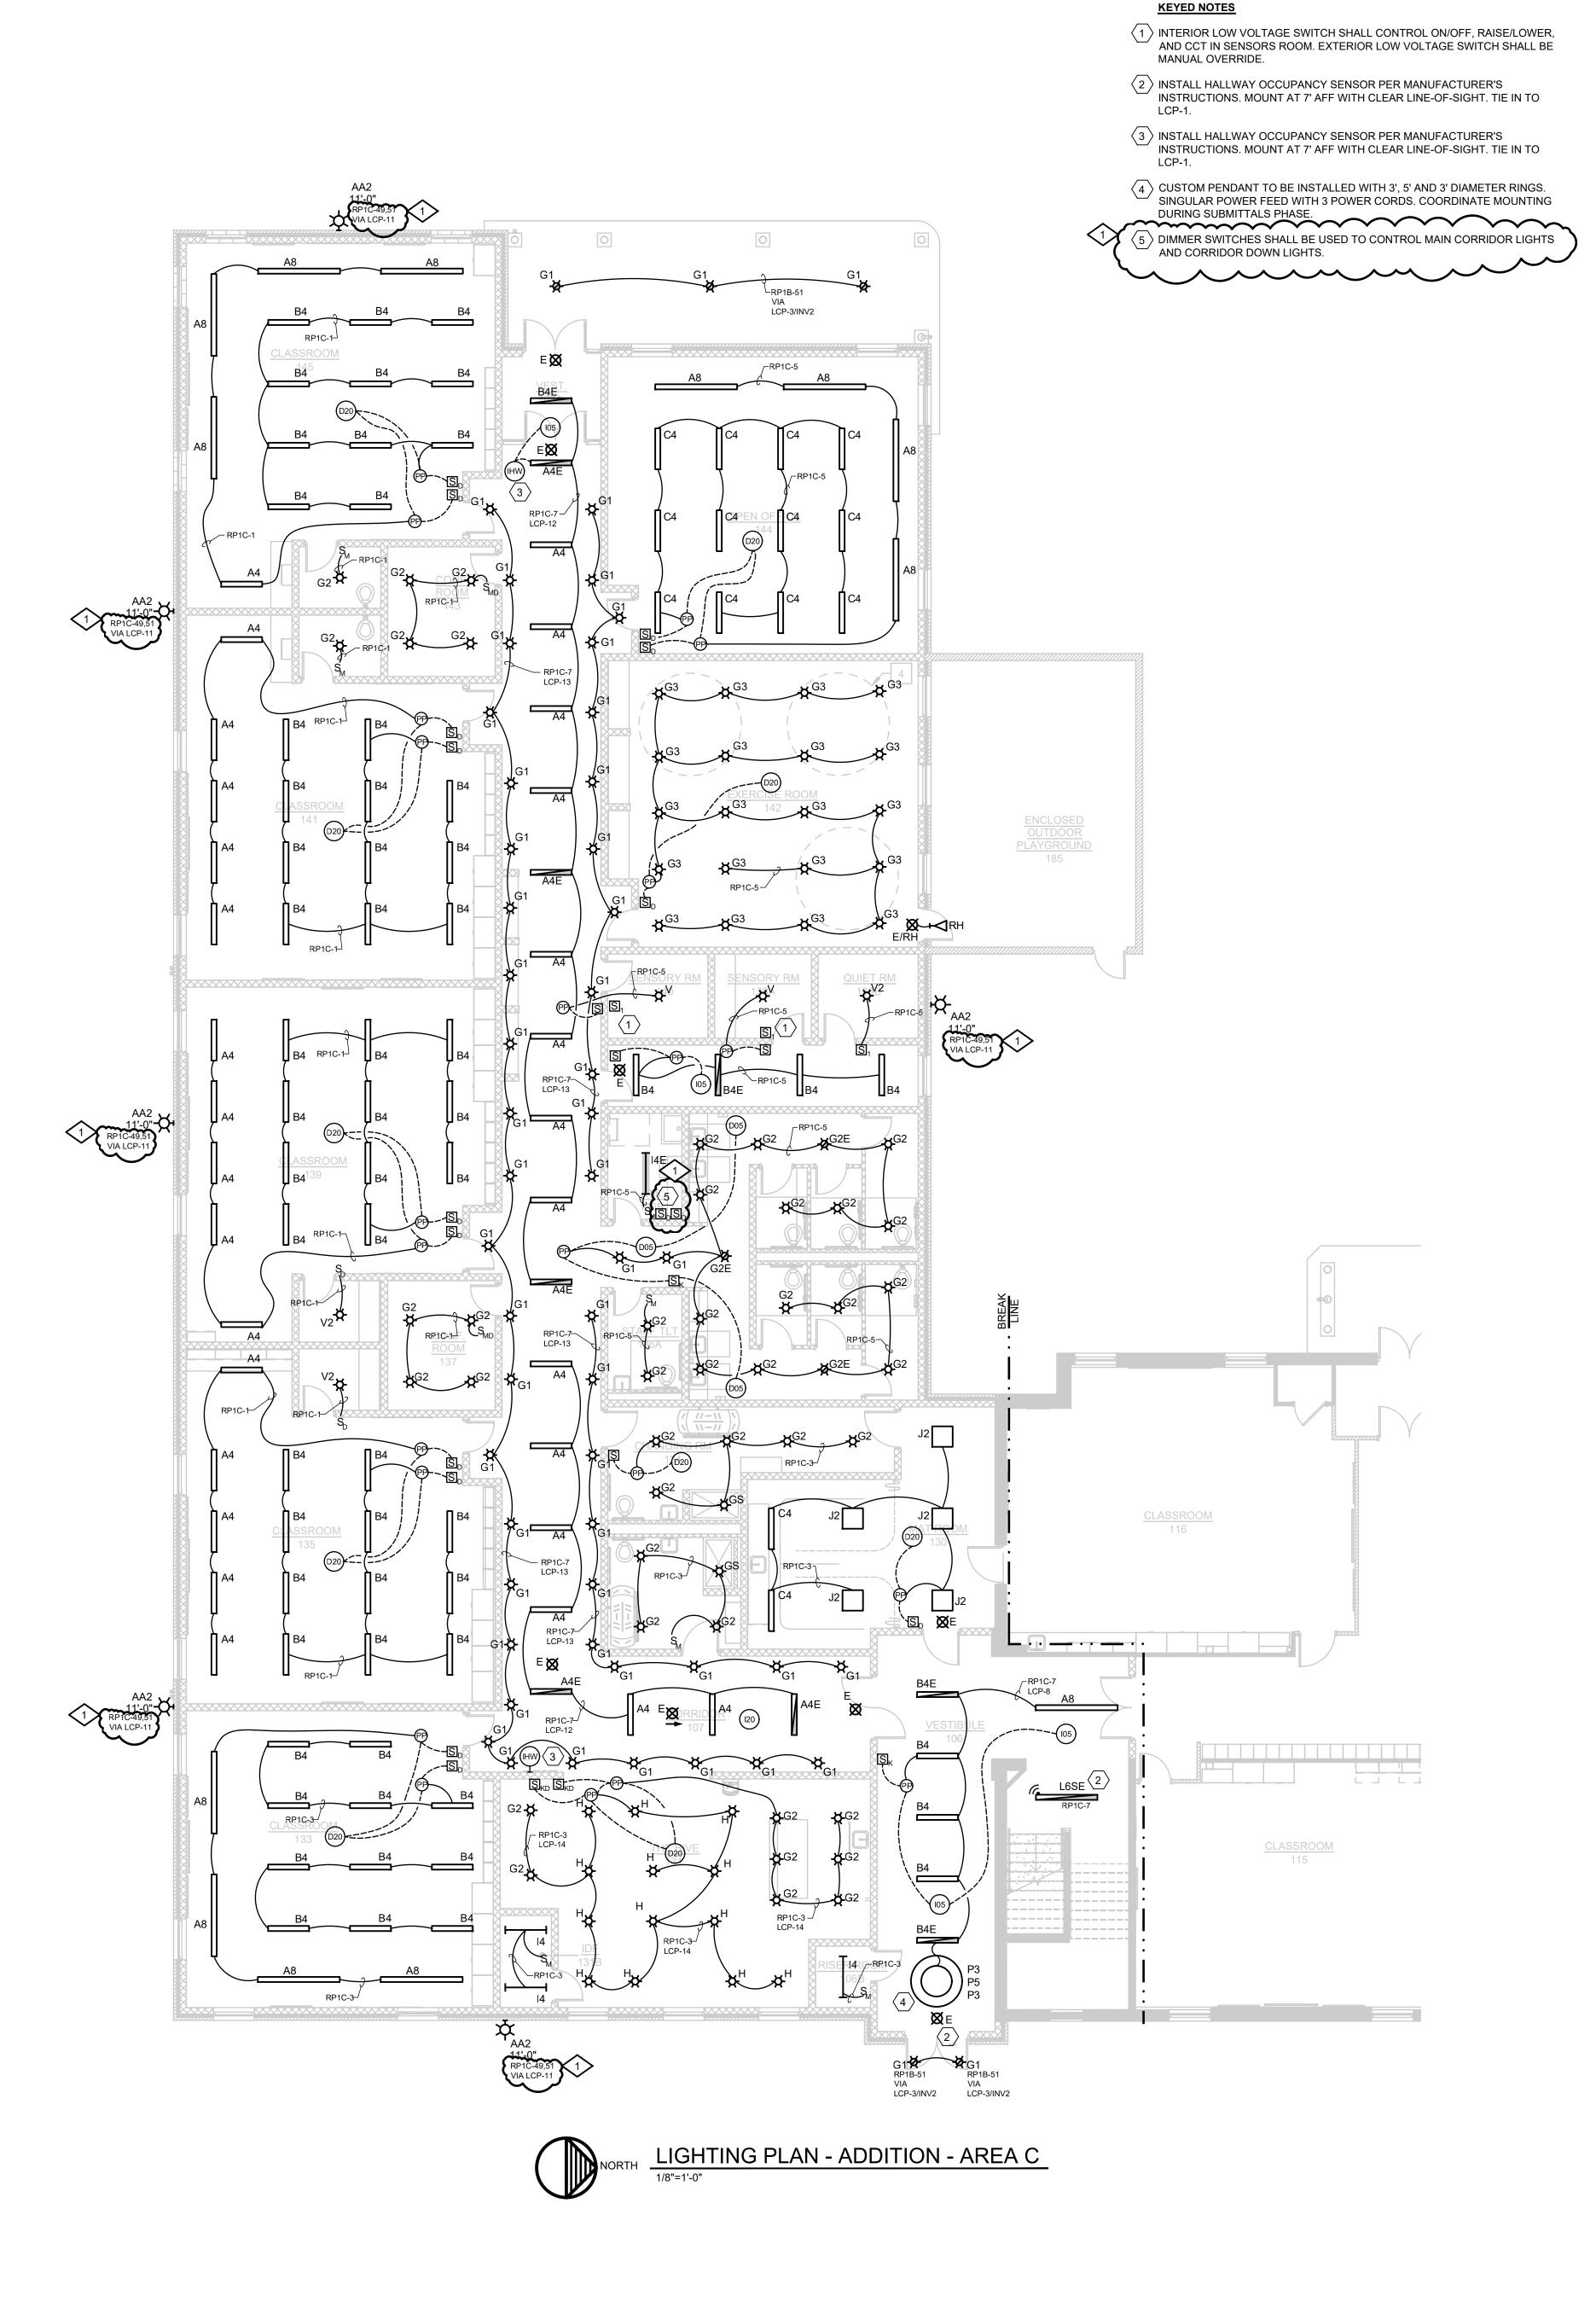

#### LIGHTING WIRING METHODS

- EXIT LIGHTS SHALL OPERATE 24-7 AND ARE EQUIPPED WITH A BATTERY RATED FOR 90 MINUTES, WIRE THE EXIT LIGHT TO THE LOCAL LIGHTING CIRCUIT AHEAD OF ANY SWITCHING.
- 2. HALF-TONE SHADED FIXTURES REPRESENTS THE FIXTURE IS AN EMERGENCY LIGHT AND EQUIPPED WITH AN EMERGENCY BATTERY
- CONFIRM LIGHT FIXTURE LAYOUT WITH THE ARCHITECTURAL REFLECTED CEILING PLAN AND ARCHITECTURAL DETAILS FOR LOCATION AND MOUNTING DETAILS.
- 4. MC CABLE IS ONLY ACCEPTABLE AS A FINAL WIRING CONNECTION TO RECESSED LIGHTING INSTALLED IN ACCESSIBLE CEILINGS. MC CABLE LENGTH SHALL NOT EXCEED 6'-0".
- PROVIDE AN EQUIPMENT GROUNDING CONDUCTOR FOR LIGHTING CIRCUITS. THE USE OF THE RACEWAY FOR A GROUNDING PATH IS NOT ACCEPTABLE FOR THIS PROJECT.
- 6. SMALL ROOMS SUCH AS STORAGE ROOM, INDIVIDUAL TOILET ROOMS, JANITORS CLOSET, DATA CLOSET AND OFFICES SHALL HAVE WALL SWITCH TYPE OCCUPANCY SENSORS SWITCHES TO AUTOMATICALLY CONTROL THE LIGHTS AS NOTED AND SPECIFIED ON THE DRAWINGS.
- 7. OCCUPANCY SENSORS, POWER PACKS AND CONTROLS ARE SHOWN DIAGRAMMATICALLY. INFRARED SENSORS MUST REMAIN AT A MINIMUM OF 4'-0" AWAY FROM ANY MECHANICAL HEAT DIFFUSER TO ELIMINATE FALSE TRIPS. CIRCUIT LINES ARE SHOWN FROM SWITCHES TO LIGHT FIXTURES TO COMMUNICATE SWITCHING CONFIGURATION ONLY. ALL SENSORS, POWER PACKS AND WIRING MUST BE WIRED PER MANUFACTURER'S WIRING METHOD.
- 8. A SINGLE POWER PACK CAN HAVE MULTIPLE SWITCHES WIRED TO THE DEVICE PROVIDED THAT THE FIXTURES BEING CONTROLLED BY THESE SWITCHES ARE ON THE SAME CIRCUIT. TWO POWER PACKS ARE REQUIRED IF A SECOND CIRCUIT IS INTRODUCED. REFER TO MANUFACTURER'S WIRING METHODS. POWER PACKS AND OR OCCUPANCY SENSORS SHALL INCLUDE A HVAC RELAY AS SCHEDULED AND NOTED ON THE DRAWINGS FOR THE BUILDING AUTOMATION SYSTEM CONNECTION. BUILDING AUTOMATION WIRING SHALL BE COMPLETED AS PART OF THE TEMPERATURE CONTROL CONTRACTOR'S BID.
- 9. THE ELECTRICAL CONTRACTOR SHALL BE RESPONSIBLE FOR FIRE STOPPING PENETRATIONS THRU FIRE RATED WALLS FOR THEIR WORK.
- POWER PACKS SHOWN DIAGRAMMATICALLY. WHEN SHOWN IN GYP BOARD CEILING, LOCATE POWER PACK IN NEAREST LAY-IN CEILING OR CLOSET SPACE.

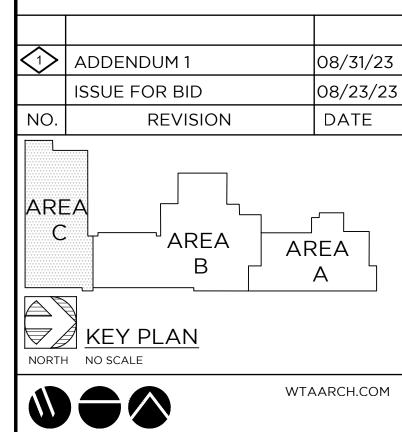



WTA ARCHITECTS

100 S Jefferson Ave, Suite 601

Saginaw, Michigan 48607 989 752 8107 COPY

714 EAST MIDLAND STREET • BAY CITY, MICHIGAN (989) 894-4300 F (989) 894-9930 WWW.MACMILLANASSOC

ADDITION AND RENOVATION:

MIDLAND COUNTY ESA

MIDLAND, MICHIGAN

CHECKED BY

LIGHTING PLAN ADDITION AREA C


PROJECT NUMBER

2022006.1

PROJECT DATE
AUGUST 23, 2023

SHEET NUMBER

E2.05

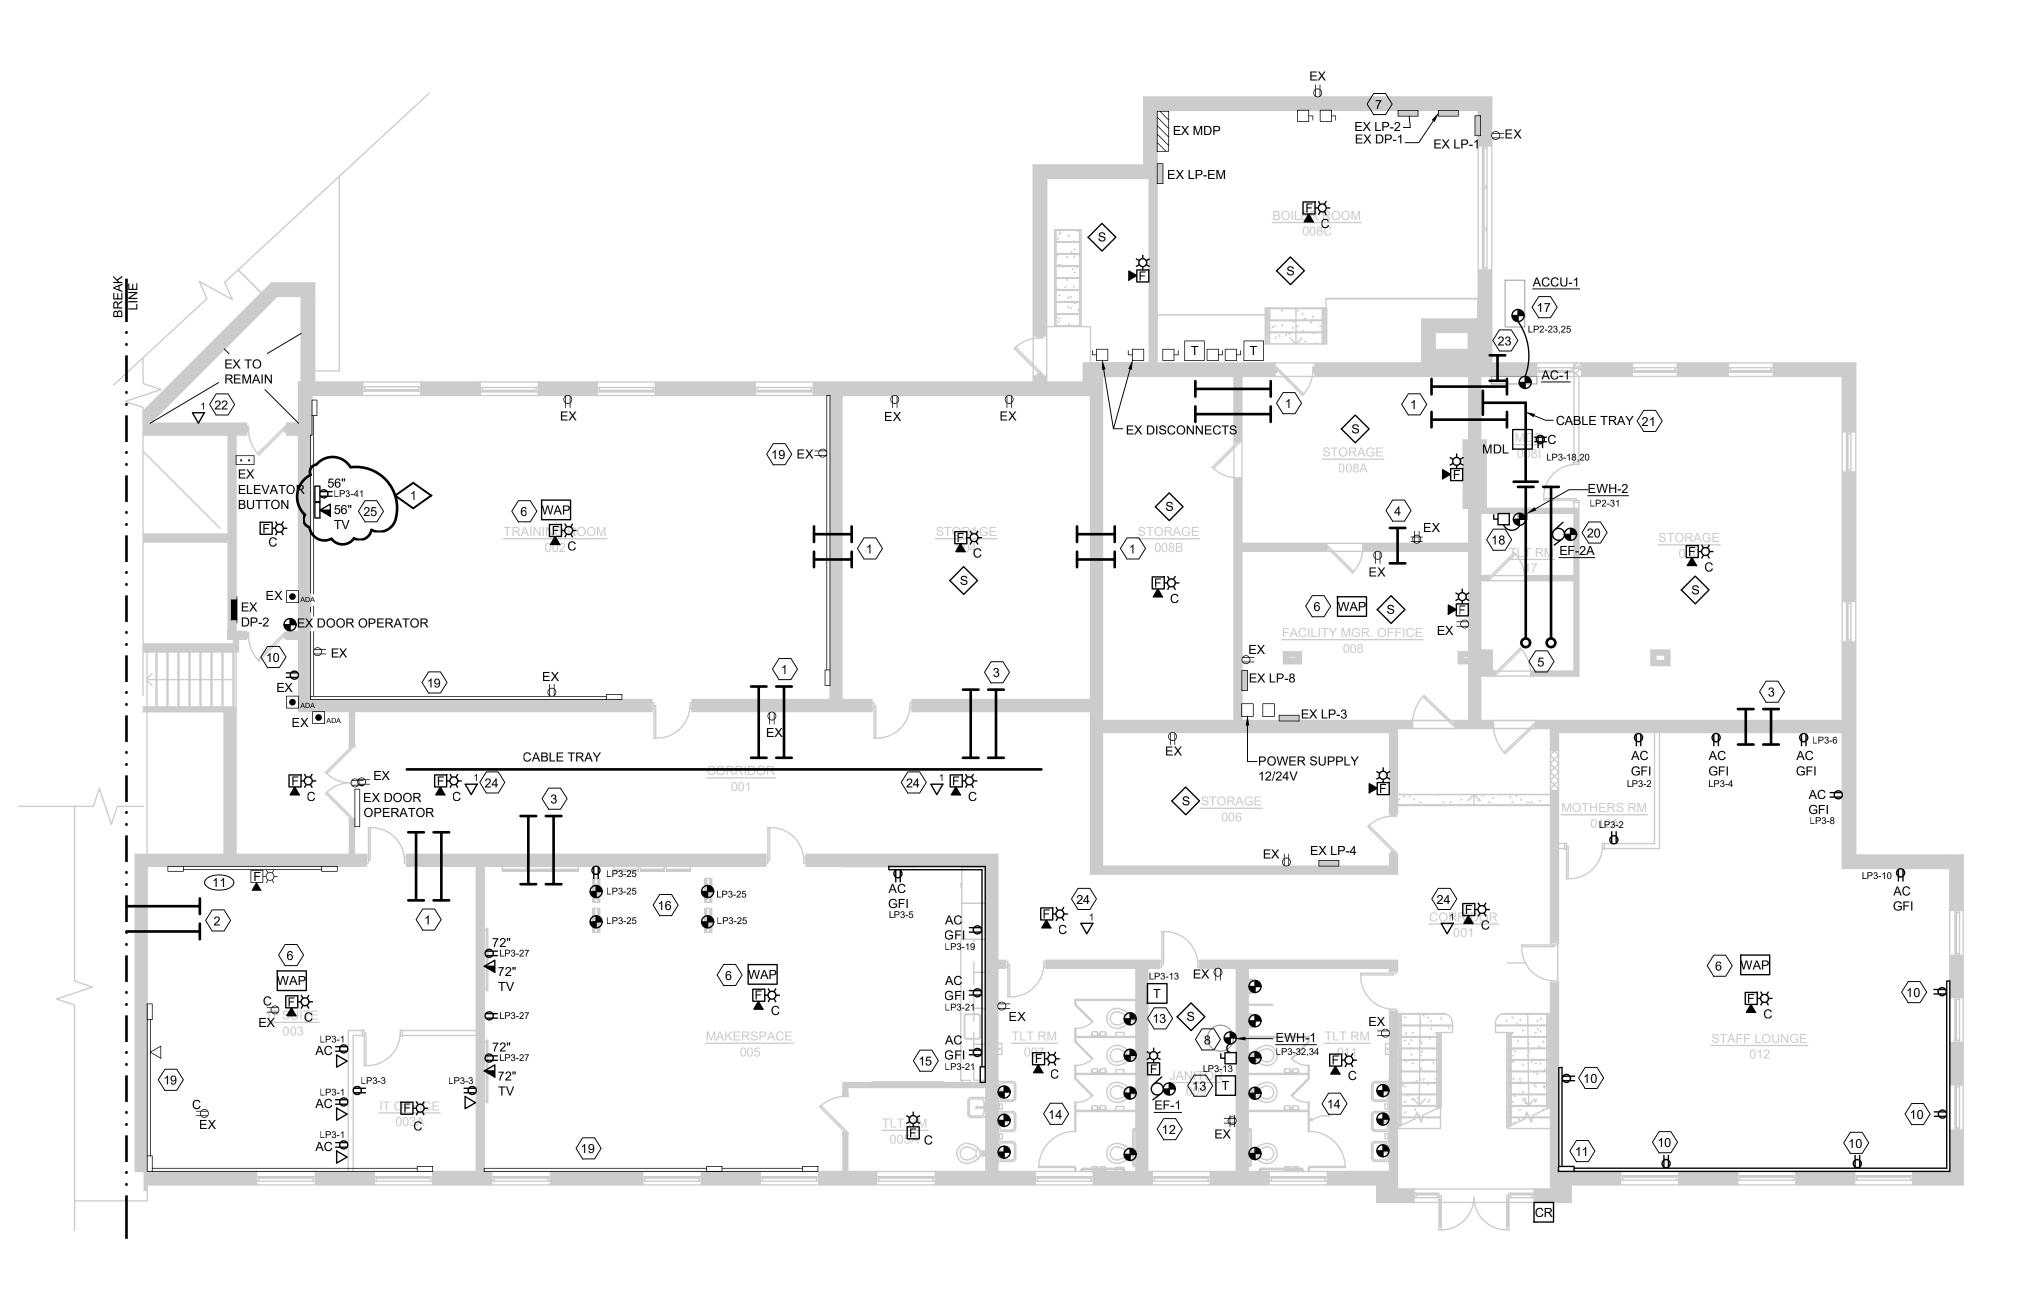

NORTH POWER AND SYSTEMS PLAN - LOWER LEVEL - AREA A

1/8"=1'-0"

#### POWER & SYSTEMS WIRING METHODS

- PROVIDE A DEDICATED NEUTRAL CONDUCTOR FOR EACH RECEPTACLE CIRCUIT. SHARED NEUTRALS ARE NOT PERMITTED.
- 2. PROVIDE EQUIPMENT GROUNDING CONDUCTOR FOR EACH RECEPTACLE. PROVIDE A #12 MINIMUM GROUNDING CONDUCTOR IN EACH RACEWAY. THE USE OF METAL CONDUIT OR RACEWAY FOR A BOND PATH IS NOT ACCEPTABLE FOR THIS PROJECT.
- 3. ALL POWER WIRING SHALL BE INSTALLED IN CONDUIT.
- 4. ALL NEW RECEPTACLES AND VOICE/DATA OUTLETS SHALL BE MOUNTED AT A MINIMUM OF 16" TO THE BOTTOM OF BOX ABOVE THE FINISHED FLOOR, UNLESS NOTED OTHERWISE. 18" IS ONLY AN ACCEPTABLE MOUNTING HEIGHT PENDING FOR MASONRY COARSE LINE INSTALLATION. COORDINATE ALL DEVICE HEIGHTS WITH ARCHITECT.
- 5. ELECTRICAL TRADES SHALL CONFIRM VOICE/DATA AND RECEPTACLE LOCATION WITH THE OWNER'S FURNITURE LAYOUTS AND INSTALLATION.
- 6. ALL RECEPTACLES SHALL BE TAMPER RESISTANT.
- 7. GENERAL PURPOSE DUPLEX RECEPTACLES SHALL BE WHITE, GRAY OR IVORY AS ADVISED BY THE ARCHITECT.
- FIRE ALARM WIRING INSTALLED ABOVE THE FINISHED CEILING IS
  ACCEPTABLE TO USE THE FREE-AIR METHOD. USE "J" HOOKS OR "D"
  RINGS FOR SUPPORT METHODS. PROVIDE PLENUM RATED CABLE FOR
  THE ENTIRE PROJECT.
- 9. FIRE ALARM DEVICE MOUNTING HEIGHTS SHALL BE INSTALLED IN ACCORDANCE WITH NFPA 72 NATIONAL FIRE ALARM CODE, BUREAU OF FIRE SERVICES, 2003 MICHIGAN BARRIER FREE DESIGN MANUAL AND OTHER APPLICABLE CODES. MOUNTING HEIGHT REQUIREMENTS:
- WALL MOUNTED AUDIO/VISUAL UNITS SHALL BE MOUNTED SUCH THAT THE ENTIRE LENS IS NOT LESS THAN 80" AND NOT GREATER THAN 96" ABOVE THE FINISHED FLOOR. CEILING MOUNTED DEVICES ARE ACCEPTABLE AND ARE NOTED ON THE DRAWINGS.
- MANUAL PULL STATIONS SHALL BE MOUNTED 48" MAXIMUM TO THE TOP OF BOX FROM THE FINISHED FLOOR.
- 9. ALL BRANCH DEVICES SHALL USE A 4" SQUARE STEEL BOX WITH A SINGLE GANG TRIM RING FOR INTERIOR GYPSUM BOARD WALLS. MASONRY BOXES ARE ACCEPTABLE FOR MASONRY WALL INSTALLATION. NON-METALLIC BOXES ARE NOT ACCEPTABLE FOR THIS
- 10. J-HOOKS AND CONDUIT OR CABLE TRAY SHALL BE USED FOR THE LOW-VOLTAGE SYSTEM WIRING INCLUDING BUT NOT LIMITED TO: FIRE ALARM, VOICE, DATA, PA, LIGHTING CONTROL, ETC.
- USE MINIMUM 1" CONDUIT SIZE FOR VOICE/DATA OUTLET DROPS. EXTEND THE CONDUIT TO THE ADJACENT CORRIDOR ACCESSIBLE CEILING SPACE.
- 12. MC CABLE IS ONLY ACCEPTABLE FOR FINAL LIGHT FIXTURE CONNECTIONS ABOVE THE LAY-IN CEILING ON THIS PROJECT, UNLESS SPECIFICALLY NOTED.
- 13. RECEPTACLES, VOICE AND DATA OUTLET LOCATIONS SHOWN IN THE OFFICES, WORKROOM, CONFERENCE/LOUNGE AREA ARE BASED ON WORKSTATION, CASEWORK SHOWN AND THE ANTICIPATED OFFICE FURNITURE ARRANGEMENTS. CONFIRM THE FINAL LOCATIONS DURING THE ROUGH-IN PHASE.
- 14. VERIFY LOCATION AND ORIENTATION OF EXISTING STRUCTURAL FRAMING PRIOR TO CORING FLOOR FOR PENETRATION. EXISTING FRAMING SHALL NOT BE CUT, ADJUSTED, OR CHANGED IN ANY WAY WITHOUT APPROVAL OF STRUCTURAL ENGINEER AND ARCHITECT.
- 15. VERIFY ADA OPERATOR LOCATIONS WITH ARCHITECTURAL PLANS AND DOOR HARDWARE VENDOR PRIOR TO ROUGH-IN.

# KEYED NOTES

- 1 FURNISH AND INSTALL (4) 2" CONDUIT STUBS INTO ACCESSIBLE CEILING SPACE FOR LOW VOLTAGE CABLING.
- FURNISH AND INSTALL (4) 2" CONDUIT STUBS. DESIGN INTENT IS TO PROVIDE CONDUIT PATH FROM LOWER LEVEL AREA A MDF TO MAIN LEVEL AREA B IDF ROOM. COORDINATE LOCATION WITH CONDUIT STUBS FROM IDF ROOM.
- 3 FURNISH AND INSTALL (2) 2" CONDUIT STUBS INTO ACCESSIBLE CEILING SPACE. (1) CONDUIT SHALL BE AN EMPTY SPARE.
- FURNISH AND INSTALL (1) 2" CONDUIT STUB THROUGH WALL INTO ACCESSIBLE CEILING SPACE.


100A/2P BREAKER IN LP-2.

- FURNISH AND INSTALL (4) 2" CONDUIT FROM MDF ROOM TO ACCESSIBLE CEILING SPACE BENEATH PANEL RP2A ELECTRICAL ROOM. COORDINATE LOCATION WITH CONDUIT STUBS IN FLOOR ABOVE.
- 6 INSTALL FLUSH MOUNTED DATA JACK IN CEILING FOR WIRELESS ACCESS
- $\langle 7 \rangle$  EX PANEL LP-EM TO BE REFED FROM PANEL LP-2. FURNISH AND INSTALL
- 8 FURNISH AND INSTALL 30 AMP NEMA 1 DISCONNECT. PROVIDE 208V, 1PH POWER CONNECTION FROM DISCONNECT TO ELECTRIC WATER HEATER.
- 9 FURNISH AND INSTALL NEW DEVICE IN EXISTING ROUGH-IN. REUSE EXISTING
- $\langle 10 \rangle$  MODIFY AND EXTEND EXISTING CIRCUITING TO FEED NEW DEVICE.
- FURNISH AND INSTALL NEW WIREMOLD 700 SERIES SURFACE RACEWAY.
  VERTICAL RUN IN CORNER, HORIZONTAL RUN AT RECEPTACLE STANDARD
- REUSE EXISTING EXHAUST FAN CIRCUIT TO FEED NEW EF-1 THROUGH FACTORY MOUNTED DISCONNECT. MODIFY AND EXTEND CIRCUIT AS REQUIRED.
- (13) INSTALL AND WIRE LOW VOLTAGE TRANSFORMER FURNISHED BY MECHANICAL TRADES. RUN LOW VOLTAGE WIRING TO BATHROOM SENSORS.
- PROVIDE LOW VOLTAGE POWER CONNECTIONS TO BATHROOM SENSORS AS REQUIRED BY THE MECHANICAL SCHEDULE.

  (15) FURNISH AND INSTALL NEW WIREMOLD 700 SERIES SURFACE RACEWAY.
- VERTICAL RUN IN CORNER, HORIZONTAL RUN ABOVE COUNTER.

  (16) PROVIDE POWER CONNECTION FROM CEILING TO ILLUMINATED MARKER BOARDS THROUGH POST.
- PROVIDE 208V, 1PH POWER CONNECTION TO ACC-1 THROUGH FACTORY MOUNTED AND WIRED DISCONNECT.
- FURNISH AND INSTALL 30A NEMA 1 DISCONNECT UNDERNEATH SINK CABINET. PROVIDE 120V POWER CONNECTION FROM DISCONNECT TO EWH-2.
- $\langle 19 \rangle$  EXISTING WIREMOLD TO REMAIN.
- 20 USE EXISTING EXHAUST FAN CIRCUIT TO FEED NEW EXHAUST FAN THROUGH FACTORY MOUNTED.
- FURNISH AND INSTALL 12 STRAND ARMORED FIBER OPTIC FROM MDL RACK TO EACH OF THE IDL RACKS. ROUTE THRU BUILDING. PROVIDE ALL
- ELECTRICAL CONTRACTOR SHALL PROVIDE CAT6 CABLE FROM ELEVATOR CONTROLLER TO MDL RACK.
- ELECTRICAL CONTRACTOR SHALL PROVIDE NEW 1" RGS CONDUIT STUB 12"
  BELOW CEILING LINE TO EXTERIOR FOR USE BY OWNER FOR NEW BUILDING FIBER.
- ELECTRICAL CONTRACTOR SHALL ADD DATA JACK IN CORRIDOR FOR FUTURE OWNER SPEAKERS/INTERCOM SYSTEM.

  1
  25 ELECTRICAL CONTRACTOR SHALL INSTALL WIRE MOLD VERTICALLY DOWN WALL FOR TV DEVICES.

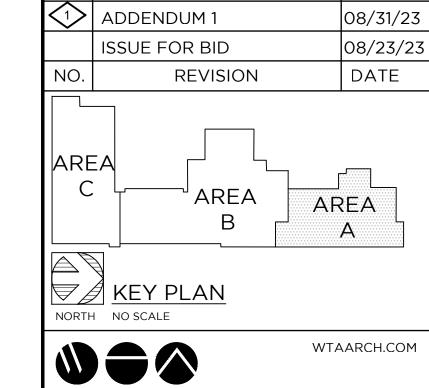



100 S Jefferson Ave, Suite 601 Saginaw, Michigan 48607 989 752 8107

MACMILLAN ASSOCIATES

CONSULTING ENGINEERS

714 EAST MIDLAND STREET • BAY CITY, MICHIGAN 48706
(989) 894-4300 F (989) 894-9930 WWW.MACMILLANASSOCIATES.COM

(989) 894-4300 F (989) 894-9930 WWW.MACMILLANASSON
PROJECT TITLE

ADDITION AND RENOVATION:

MIDLAND COUNTY ESA

MIDLAND, MICHIGAN

CHECKED BY

POWER AND SYSTEMS PLAN
LOWER LEVEL
AREA A


PROJECT NUMBER

2022006.1

PROJECT DATE
AUGUST 23, 2023

SHEET NUMBER

E2.06

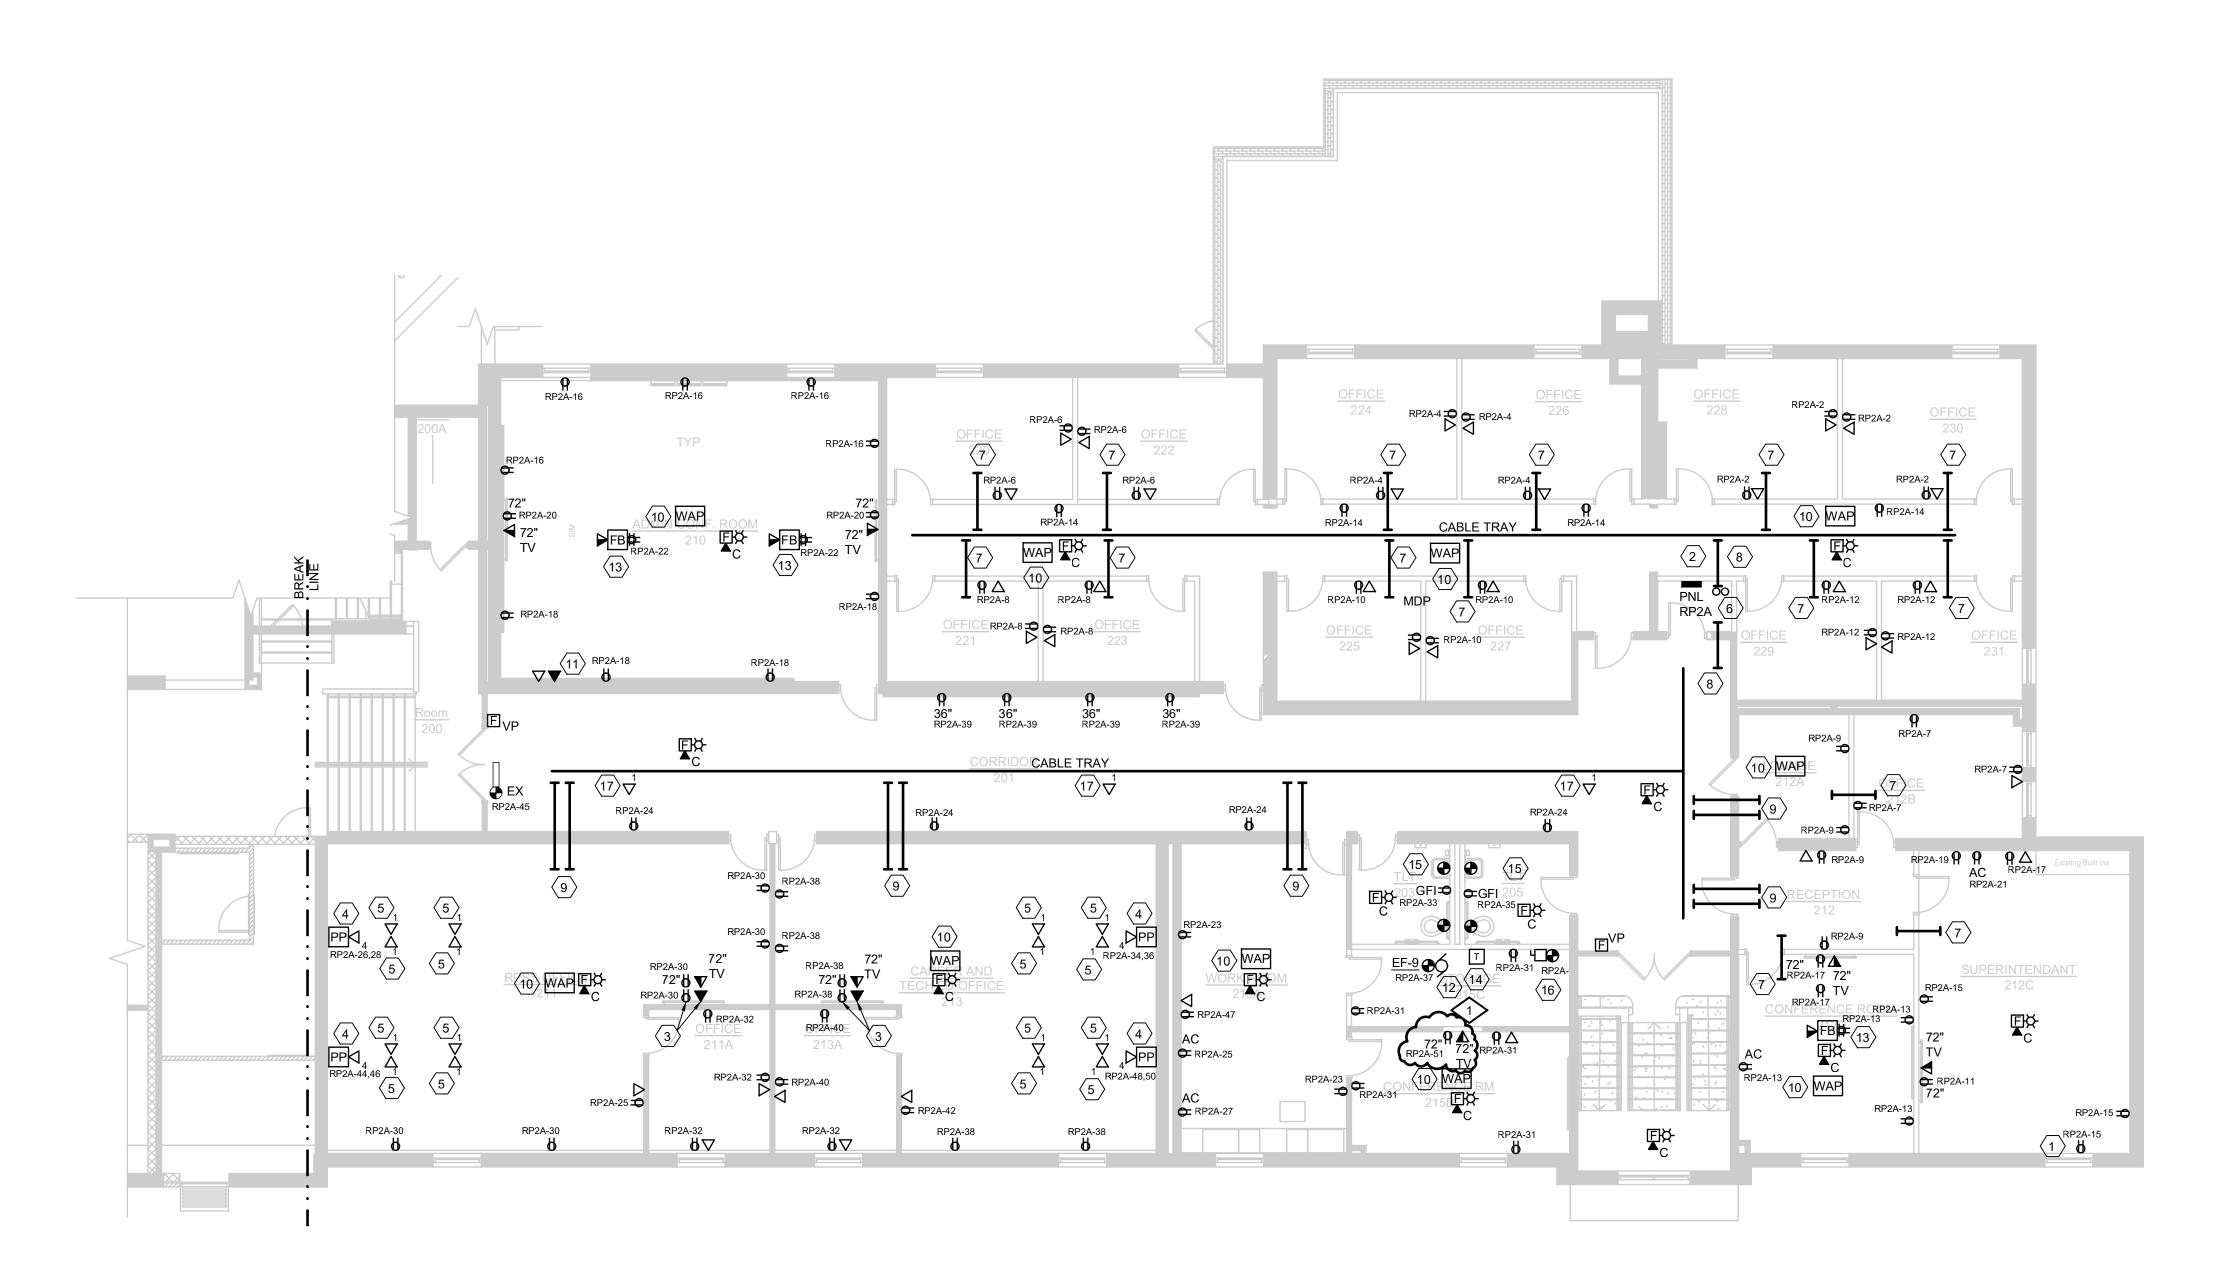

POWER AND SYSTEMS PLAN - MAIN LEVEL NORTH WING - AREA A

#### POWER & SYSTEMS WIRING METHODS

1. PROVIDE A DEDICATED NEUTRAL CONDUCTOR FOR EACH RECEPTACLE CIRCUIT. SHARED NEUTRALS ARE NOT PERMITTED.


- 2. PROVIDE EQUIPMENT GROUNDING CONDUCTOR FOR EACH RECEPTACLE. PROVIDE A #12 MINIMUM GROUNDING CONDUCTOR IN EACH RACEWAY. THE USE OF METAL CONDUIT OR RACEWAY FOR A BOND PATH IS NOT ACCEPTABLE FOR THIS PROJECT.
- 3. ALL POWER WIRING SHALL BE INSTALLED IN CONDUIT.
- 4. ALL NEW RECEPTACLES AND VOICE/DATA OUTLETS SHALL BE MOUNTED AT A MINIMUM OF 16" TO THE BOTTOM OF BOX ABOVE THE FINISHED FLOOR, UNLESS NOTED OTHERWISE. 18" IS ONLY AN ACCEPTABLE MOUNTING HEIGHT PENDING FOR MASONRY COARSE LINE INSTALLATION. COORDINATE ALL DEVICE HEIGHTS WITH ARCHITECT.
- 5. ELECTRICAL TRADES SHALL CONFIRM VOICE/DATA AND RECEPTACLE LOCATION WITH THE OWNER'S FURNITURE LAYOUTS AND INSTALLATION.
- 6. ALL RECEPTACLES SHALL BE TAMPER RESISTANT.
- 7. GENERAL PURPOSE DUPLEX RECEPTACLES SHALL BE WHITE, GRAY OR IVORY AS ADVISED BY THE ARCHITECT.
- 8. FIRE ALARM WIRING INSTALLED ABOVE THE FINISHED CEILING IS ACCEPTABLE TO USE THE FREE-AIR METHOD. USE "J" HOOKS OR "D" RINGS FOR SUPPORT METHODS. PROVIDE PLENUM RATED CABLE FOR THE ENTIRE PROJECT.
- 9. FIRE ALARM DEVICE MOUNTING HEIGHTS SHALL BE INSTALLED IN ACCORDANCE WITH NFPA 72 NATIONAL FIRE ALARM CODE, BUREAU OF FIRE SERVICES, 2003 MICHIGAN BARRIER FREE DESIGN MANUAL AND OTHER APPLICABLE CODES. MOUNTING HEIGHT REQUIREMENTS:
- WALL MOUNTED AUDIO/VISUAL UNITS SHALL BE MOUNTED SUCH THAT THE ENTIRE LENS IS NOT LESS THAN 80" AND NOT GREATER THAN 96" ABOVE THE FINISHED FLOOR. CEILING MOUNTED DEVICES ARE ACCEPTABLE AND ARE NOTED ON THE DRAWINGS.
- MANUAL PULL STATIONS SHALL BE MOUNTED 48" MAXIMUM TO THE TOP OF BOX FROM THE FINISHED FLOOR.
- 9. ALL BRANCH DEVICES SHALL USE A 4" SQUARE STEEL BOX WITH A SINGLE GANG TRIM RING FOR INTERIOR GYPSUM BOARD WALLS. MASONRY BOXES ARE ACCEPTABLE FOR MASONRY WALL INSTALLATION. NON-METALLIC BOXES ARE NOT ACCEPTABLE FOR THIS PROJECT.
- 10. J-HOOKS AND CONDUIT OR CABLE TRAY SHALL BE USED FOR THE LOW-VOLTAGE SYSTEM WIRING INCLUDING BUT NOT LIMITED TO: FIRE ALARM, VOICE, DATA, PA, LIGHTING CONTROL, ETC.
- 11. USE MINIMUM 1" CONDUIT SIZE FOR VOICE/DATA OUTLET DROPS. EXTEND THE CONDUIT TO THE ADJACENT CORRIDOR ACCESSIBLE CEILING SPACE.
- 12. MC CABLE IS ONLY ACCEPTABLE FOR FINAL LIGHT FIXTURE CONNECTIONS ABOVE THE LAY-IN CEILING ON THIS PROJECT, UNLESS SPECIFICALLY NOTED.
- 13. RECEPTACLES, VOICE AND DATA OUTLET LOCATIONS SHOWN IN THE OFFICES, WORKROOM, CONFERENCE/LOUNGE AREA ARE BASED ON WORKSTATION, CASEWORK SHOWN AND THE ANTICIPATED OFFICE FURNITURE ARRANGEMENTS. CONFIRM THE FINAL LOCATIONS DURING THE ROUGH-IN PHASE.
- 14. VERIFY LOCATION AND ORIENTATION OF EXISTING STRUCTURAL FRAMING PRIOR TO CORING FLOOR FOR PENETRATION, EXISTING FRAMING SHALL NOT BE CUT, ADJUSTED, OR CHANGED IN ANY WAY WITHOUT APPROVAL OF STRUCTURAL ENGINEER AND ARCHITECT.
- 15. VERIFY ADA OPERATOR LOCATIONS WITH ARCHITECTURAL PLANS AND DOOR HARDWARE VENDOR PRIOR TO ROUGH-IN.

## **KEYED NOTES**

- 1) EXISTING ROUGH-IN TO BE REUSED. FURNISH AND INSTALL NEW DEVICE AND CONDUCTORS.
- $\langle 2 \rangle$  FURNISH AND INSTALL NEW PANEL RP2A. REFER TO ONE LINE.
- 3 FURNISH AND INSTALL POWER AND HDMI TV PORT 6" ABOVE DESK TO CENTERLINE OF ROUGH-INS.
- A ROUTE POWER AND DATA THROUGH POWER POLE. EACH DESK SHALL HAVE ONE RECEPTACLE AND ONE DATA PORT.
- $\langle 5 \rangle$  UTILIZE POWER POLE FOR POWER AND RACEWAY FOR DATA TO DESK.
- 6 FURNISH AND INSTALL (2) 4" CONDUITS THROUGH FLOOR FOR DATA
- 7 FURNISH AND INSTALL (1) 2" CONDUIT INTO ACCESSIBLE CEILING SPACE.  $\langle 8 \rangle$  FURNISH AND INSTALL (1) 4" CONDUIT FOR DATA ROUTING TO CABLE TRAY.
- $\langle 9 \rangle$  FURNISH AND INSTALL (2) 2" CONDUITS INTO ACCESSIBLE CEILING SPACE. (1) CONDUIT SHALL BE AN EMPTY SPARE.
- 10 INSTALL FLUSH MOUNTED DATA JACK IN CEILING FOR WIRELESS ACCESS POINT.
- (11) ROUTE 1" CONDUIT FROM HDMI OUTLET TO ACCESSIBLE CEILING SPACE AND TO ACCESSIBLE CEILING SPACE IN FLOOR BELOW. (1) HDMI WILL BE CONNECTED TO EACH FLOORBOX, AND (1) HDMI WILL BE CONNECTED TO
- PROVIDE POWER CONNECTION TO EXHAUST FAN THROUGH FACTORY MOUNTED DISCONNECT.

EACH TV. (4) CONNECTIONS IN TOTAL WILL BE AVAILABLE AT HDMI OUTLET.

- (13) FURNISH AND INSTALL FIRE RATED POKE-THRU FLOORBOX. REFER TO
- ELECTRICAL SCHEDULES. 14 INSTALL AND WIRE LOW VOLTAGE TRANSFORMER FURNISHED BY MECHANICAL TRADES. RUN LOW VOLTAGE WIRING TO BATHROOM
- PROVIDE LOW VOLTAGE POWER CONNECTIONS TO BATHROOM SENSORS AS REQUIRED BY THE MECHANICAL SCHEDULE.
- (16) FURNISH AND INSTALL 30A NEMA 1 DISCONNECT UNDERNEATH SINK CABINET. PROVIDE 120V POWER CONNECTION FROM DISCONNECT TO
- ELECTRICAL CONTRACTOR SHALL ADD DATA JACK IN CORRIDOR FOR FUTURE OWNER SPEAKERS/INTERCOM SYSTEM.

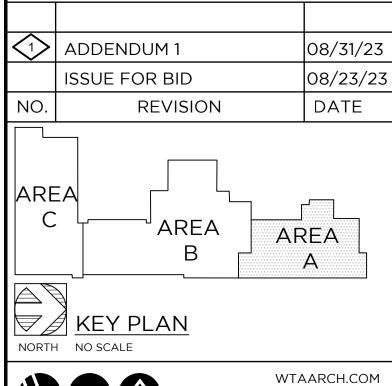



100 S Jefferson Ave, Suite 601

Saginaw, Michigan 48607 COPYRIGHT © 2022

MACMILLAN ASSOCIATES CONSULTING ENGINEERS 714 EAST MIDLAND STREET • BAY CITY, MICHIGAN 48706 (989) 894-4300 F (989) 894-9930 www.macmillanassociates.com

PROJECT TITLE

ADDITION AND RENOVATION:

MIDLAND COUNTY ESA

MIDLAND, MICHIGAN

POWER AND SYSTEMS PLAN MAIN LEVEL NORTH WING - AREA A

SHEET NUMBER PROJECT NUMBER 2022006.1 PROJECT DATE

E2.08 AUGUST 23, 2023 CHECKED BY

RELAY	ZONE CONTROLLED	CHANNEL	CIRCUIT	RELAY	ZONE CONTROLLED	CHANNEL	CIRCUI
1	CORRIDOR 301 LINEARS	В	LP6-1	13	ADDITION CORR. DOWNLIGHTS	В	RP1C-
2	CORRIDOR 301 DOWNLIGHTS	В	LP6-1	14	HIVE LIGHTS	В	RP1C-
3	ALL CANOPY DOWNLIGHTS	Α	VARIOUS	15	SPARE		
4	SECURE VESTIBULE		RP1B-1	16	SPARE		
5	LOBBY	В	RP1B-1,7	17			
6	CORRIDOR 104 LINEARS	В	RP1B-7,9	18			
7	CORRIDOR 104 DOWNLIGHTS	В	RP1B-7	19			
8	ADDITION CORR.	В	RP1C-7	20			
9	MAIN LEVEL N. WING CORRIDOR	В	RP2A-3	21			
$\sim$ 10 $\sim$	MAIN LEVEL N. WUNG CORR DOWNLIGHTS		RP2A-8	22			
11	EXTERIOR LIGHTS	Α	RP1C-49,51	23			
12 🖍	ADDITION CORP. LINEARS	<b>├</b>	~~P1e->~	24			
CHANNELS:	A PHOTOCELL DUSK TILL 11PM. 4AM T	O DAWN.					
	B KEYED SWITCH OVERRIDE. OCC SEN	SOR CONTRO	DL.				
	C NOT USED						

#### LIGHTING CONTROL EXECUTIVE SUMMARY

# KEYED SWITCH MANUAL ON/OFF, RAISE/LOWER. MOTION AUTO ON TO 50%,

AUTO OFF AFTER 20 MIN. NO ACTIVITY.

KEYED SWITCH MANUAL ON/OFF, RAISE/LOWER. SEPARATE CONTROL OF DOWNLIGHTS AND LINEARS. MOTION AUTO ON TO LAST SETTING. AUTO OFF AFTER 20 MIN. NO ACTIVITY.

# MANUAL ON/OFF, RAISE/LOWER. SEPARATE CONTROL OF MAIN CLASSROOM

LIGHTS AND TEACHER BOARD LIGHTING. AUTO ON TO 50%. AUTO OFF AFTER 20 MIN. NO ACTIVITY.


OFFICES
MANUAL ON/OFF, RAISE/LOWER. AUTO OFF AFTER 20 MIN. NO ACTIVITY.

SEPARATE MANUAL ON/OFF, RAISE/LOWER CONTROL OF 3 LIGHTING ZONES. CONFERENCE TABLE LINEARS MOTION AUTO ON TO 50%. ALL LIGHTS AUTO OFF AFTER 20 MIN. NO ACTIVITY.

#### **EXTERIOR CANOPY DOWNLIGHTS** DUSK TO 4PM. 4AM TO DAWN.

EXTERIOR BUILDING MOUNT LIGHTING ALL LIGHTS TO BE INSTALLED WITH INTEGRATED PHOTOSENSORS. ALL FIXTURES SHALL WIRELESSLY COMMUNICATE TO TURN ON AND OFF SYNCHRONOUSLY. AUTO ON AT DUSK, OFF AT 11PM. AUTO ON AT 6AM, OFF AT DUSK.

- A EXIT DEVICE B POWER TRANSFER (ELECTRIC CRASH BAR, STRIKE, OR LATCH)
- C CARDSLOT/SHROUD/MOUNTING PLATE D POWER SUPPLY (ONLY NEEDED WITH CRASH BARS AND/OR DOORS WITH HANDICAP OPENERS)
- E ENCLOSURE AND POWER SUPPLY F DOOR POSITION SWITCH
- G MASTER/DOOR CONTROLLER
- H HANDICAP PUSH BUTTON

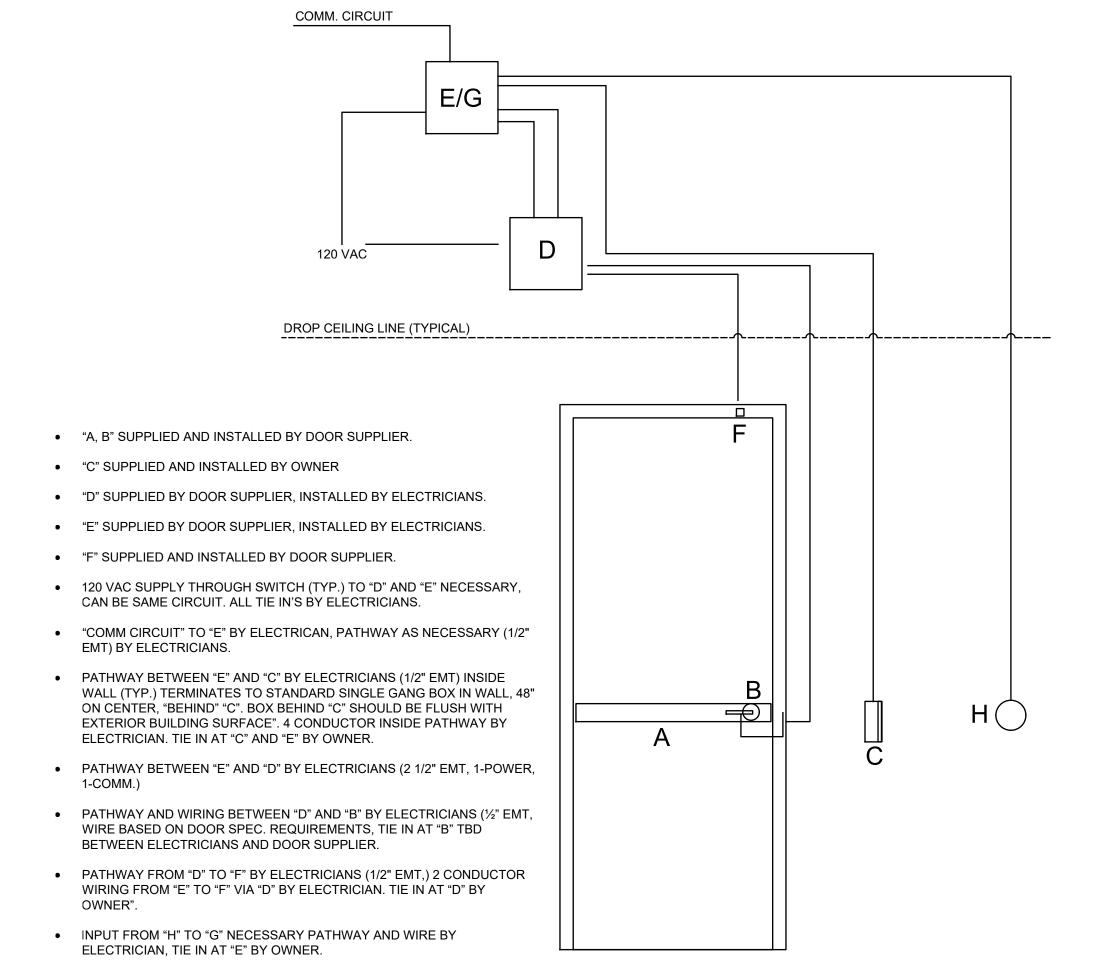

# CARD READER SCHEMATIC

# LIGHTING SCHEDULE

- A4 4' LINEAR LED FLAT PANEL. 2000 LUMEN, 80 CRI, 4000K, FLAT FRAME, SATIN WHITE LENS, 1%MIN DIMMING, 120-277V, MATTE WHITE FINISH. 500LM/FT, LITHONIA #LSIX 4FT 2000LM 80CRI 40K FFR SWL MIN1 EZT MVOLT MW
- A8 SAME AS TYPE A4 EXCEPT 8' LONG, 4000 LUMENS, 29.8 WATT.
- B4 4' LINEAR LED FLAT PANEL. 3000 LUMEN, 80 CRI, 4000K, FLAT FRAME, SATIN WHITE LENS, 1%MIN DIMMING, 120-277V, MATTE WHITE FINISH. 750 LM/FT,
- LITHONIA #LSIX 4FT 3000LM 80CRI 40K FFR SWL MIN1 EZT MVOLT MW
- B8 SAME AS TYPE B4 EXCEPT 8' LONG, 6000 LUMENS, 44.3 WATT. B8E SAME AS TYPE B8 EXCEPT WITH 10 WATT EMERGENCY BATTERY PACK
- B8S SAME AS TYPE B8 EXCEPT WITH INTEGRAL WIRELESS OCCUPANCY #NLTAIR2 PIR
- B8SE SAME AS TYPE B8 EXCEPT WITH 10 WATT EMERGENCY BATTERY AND INTEGRAL WIRELESS OCCUPANCY SENSOR. #E10WLCP NLTAIR2 PIR
- C4 4' LINEAR LED FLAT PANEL. 4000 LUMEN, 80 CRI, 4000K, FLAT FRAME, SATIN WHITE LENS, 1%MIN DIMMING, 120-277V, MATTE WHITE FINISH. 1000 LM/FT, LITHONIA #LSIX 4FT 4000LM 80CRI 40K FFR SWL MIN1 EZT MVOLT MW
- C8 SAME AS TYPE C4 EXCEPT 8' LONG, 8000 LUMEN, 60.3 WATT.
- C8S SAME AS TYPE C8 EXCEPT WITH INTEGRAL WIRELESS OCCUPANCY SENSOR.

C8E SAME AS TYPE B8 EXCEPT WITH 10 WATT EMERGENCY BATTERY PACK

- #NLTAIR2 PIR LED SINGLE SIDED EXIT SIGN, RED LETTERS.
- LITHONIA #LQM E2 SAME AS TYPE E BUT DOUBLE SIDED
- E/RH LED EXIT WITH HIGH OUTPUT BATTERY, RED LETTERS, WHITE. LITHONIA #LHQM LED HO RO
- RHW WET LOCATION EMERGENCY REMOTE HEAD LED, 320 LUMEN, 3.3 WATT, SINGLE HEAD, DARK BRONZE FINISH. LITHONIA #ELMRW SP640L DDBTXD SGL
- F NOT USED
- G1 4" ROUND LED DOWNLIGHT, 3500K, 1000 LUMENS, 10.6 WATT, WHITE TRIM, MATTE DIFFUSE FINISH, WHITE FLANGE, 120-277V, 1%MIN DIMMING. LITHONIA #LDN4 35/10 LO4 WR LD TRW MVOLT EZ1
- G1E SAME AS TYPE G1 EXCEPT WITH 10 WATT EMERGENCY BATTERY PACK.
- G2 SAME AS TYPE G1 EXCEPT 1500 LUMENS, 17.5 WATTS
- G2E SAME AS TYPE G2 EXCEPT WITH A 10 WATT EMERGENCY BATTERY
- G3 SAME AS TYPE G1 EXCEPT 2000 LUMENS. 22.5 WATTS
- G3E SAME AS TYPE G3 EXCEPT WITH A 10 WATT EMERGENCY BATTERY
- GS 4" ROUND SHOWER DOWNLIGHT. WET LOCATION LISTED. IP66 RATED. 1000 LUMEN, 9 WATT, FLUSH SMOOTH LENS, 120V, WHITE TRIM. GOTHAM #EVO4SH 35/10 DFF SMO 120
- H1 6" LED CYLINDER PENDANT DOWNLIGHT. 3500K, 2000 LUMEN, 10.4 WATT, BLACK.
- H2 6" LED CYLINDER PENDANT DOWNLIGHT. 3500K, 2000 LUMEN, 22.5 LITHONIA #LDN6CYL 35/20 LO6BR LD 120 GZ10 PM DBL

LITHONIA #LDN6CYL 35/10 LO6BR LD 120 GZ10 PM DBL

- 12 CLX LED LINEAR, 24", 2000 LUMENS, STANDARD EFFICIENCY, LESS LOUVER, FLAT DIFFUSE LENS, GENERAL DISTRIBUTION, 120-277V, GENERIC 0-10V DIMS TO 1%, 4000K, 80CRI, WHITE FINISH, 14.5 WATTS LITHONIA #CLX L24 2000LM SEF FDL MVOLT GZ1 40K 80CRI WH
- I3 SAME AS TYPE I2 EXCEPT 36", 3000 LUMENS, 20.8 WATTS
- I4 SAME AS TYPE I2 EXCEPT 48", 4000 LUMENS, 25.5 WATTS
- I4E SAME AS TYPE I4 EXCEPT WITH A 10 WATT EMERGENCY BATTERY
- J1 2x2 LED FLAT PANEL. 2000 LUMENS, 16 WATT, 80CRI, 4000K, SATIN LENS, LITHONIA #CPX 2X2 2000LM 80CRI 40K SWL MIN1 ZT MVOLT
- J1E SAME AS TYPE J1 EXCEPT WITH 10 WATT EMERGENCY BATTERY
- J2 SAME AS TYPE J1 EXCEPT 3200LM, 30 WATT.
- J2E SAME AS TYPE J2 EXCEPT WITH 10 WATT EMERGENCY BATTERY
- J2SE SAME AS TYPE J2E EXCEPT WITH INTEGRAL WIRELESS SENSOR. ACUITY #NLTAIR2 PIR
- K 2'X4' LED HIGHBAY RETROFIT. 16,600 LUMENS, 105 WATTS, 120-277V, 4000K, DIMS TO 1%, 0-10V DIMMING, FROSTED IMPACT RESISTANT POLYCARBONATE LENS, SOLID ALUMINUM CONSTRUCTION. ESI #K 24LT D41X5HO 40 D FR-FL CUSTOM POLYCARBONATE LENS
- L4 4' SURFACE MOUNT LED LINEAR. 800 LUMEN/FT, 3500K, 1%MIN DIMMING, 120-277V, FLUSH LENS, WHITE FINISH, 6.33 WATT/FT, 25.3 WATTS. MARK #S4SD XXX 4\_FT XXXX 80CRI 35K 800LMF SCT MIN1 FLL MVOLT WHTT
- L4E SAME AS TYPE L4 EXCEPT WITH 10 WATT EMERGENCY BATTERY PACK. L6 SAME AS TYPE L4 EXCEPT 6', 38 WATTS.
- L6E SAME AS TYPE L6 EXCEPT WITH 10 WATT EMERGENCY BATTERY PACK.
- L6SE SAME AS TYPE L6E EXCEPT WITH WIRELESS OCCUPANCY SENSOR. #NLTAIR2 PDT
- SEMI-RECESSED GLASS CONE DOWNLIGHT. 2000 LUMENS, 3500K, 120V, 22 DELRAY #KLS31 2 W35 D 120
- LED DOME PENDANT. 2500 LUMEN, 3500K, 120-277V, 1%MIN DIMMING, CUSTOM FINISHES, 22 WATTS. VISA #CP4410 L35K(L) 80CRI MVOLT
- P3 3' DIAMETER LED RING PENDANT. SILVER FINISH, LOW OUTPUT, 3500K, SEPARATE MOUNT, DIMMING, REMOTE DRIVER, SILVER CANOPY, BLACK POWER CORD, 51 WATT, 3780 LUMEN. TO BE MOUNTED WITH (1) P5 AND (1) ADDITONAL P3. COORDINATE MOUNTING WITH ARCHITECTURAL DETAILS DURING SHOP DRAWING PHASE. DELRAY #6813 S W35 S D RR
- P5 SAME AS TYPE P3 EXCEPT 5' DIAMETER, 85 WATT, 6300 LUMEN. TO BE MOUNTED WITH (1) P5 AND (1) ADDITIONAL P3. COORDINATE MOUNTING WITH ARCHITECTURAL DETAILS DURING SHOP DRAWING PHASE.
- Q27 2" WIDE, 4" DEEP, PERIMETER SLOT LINEAR LED. 27FT LENGTH, FIELD MEASURE TOTAL LENGTH PRIOR TO ORDERING. STANDARD OUTPUT, 80 CRI, 3500K, LOW-GLOSS WHITE, 120V, SINGLE CIRCUIT, 0-10V 10%MIN DIMMING, END CAP, 3.5 WATT/FT. FINELITE #HP 2 WS 4D XX S 835 96LG 120 SC FC-10%
- Q21 SAME AS TYPE Q27 EXCEPT 21FT LENGTH. FIELD MEASURE TOTAL LENGTH PRIOR TO ORDERING.
- 4" VANDAL RESISTANT TUNABLE WHITE RECESSED DOWNLIGHT. IP66 AND IK10 RATED, TAMPER RESISTANT CEILING GRID MOUNTING, DIMMING TO <1%, 2000 LUMEN, 2700K-6500K TUNING RANGE, MEDIUM DISTRIBUTION, 28 WATT, 90CRI, 120 VOLT, CLEAR POLYCARBONATE LENS, WHITE ANTIMICROBIAL FINISH. LUMINAIRE #VRDL4 GB DARK NLT 2000LM TUWH RHYR MD 90CRI 120 CPL AMF
- V2 4" VANDAL RESISTANT DOWNLIGHT, 2000 LUMEN, 0-10V DIMMING, 120V LUMINAIRE #VRDL4 DARK ZT 2000LM WD 35K 80CRI 120 CPL AMF
- AA2 WALL MOUNT LED LUMINARIE. TYPE 2 DISTRIBUTION, 4000K, 73 WATT, 208V INTEGRATED MOTION/AMBIENT SENSOR. HOUSE-SIDE SHIELD. DARK BRONZE FINISH. LITHONIA #DSXW1 LED 20C 1000 40K T2M PIR HS DDBXD
- BBF WALL MOUNT LED SITE LUMINARIE. FORWARD THROW DISTRIBUTION. PERFORMANCE PACKAGE 7, 4000K, 70CRI, 120-277V, 188 WATT. INTEGRATED MOTION/AMBIENT SENSOR. HOUSE-SIDE SHIELD. DARK LITHONIA #DSX1 LED P7 70CRI TFTM MVOLT WBA PIR HS DDBXD
- BB2 SAME AS TYPE BBF EXCEPT TYPE 2 DISTRIBUTION.
- BB3 SAME AS TYPE BBF EXCEPT TYPE 3M DISTRIBUTION.
- CC POST-TOP LED RETROFIT WITH WIRELESS CONTROL. LITHONIA #RADPT OR EQUAL

# **ELECTRICAL SYMBOLS**

# <u>LIGHTING</u>

# A 2'x4' FIXTURE, TYPE INDICATED

HALF SHADED FIXTURES ARE EMERGENCY FIXTURES

A 2'X2' FIXTURE, TYPE INDICATED

A 1'x4' LED FIXTURE, TYPE INDICATED

A 4' LED STRIP, TYPE INDICATED → DOWNLIGHT OR SURFACE FIXTURE

WALL MOUNTED FIXTURE, TYPE INDICATED

WALL MOUNTED FIXTURE, TYPE INDICATED

PENDANT MOUNTED FIXTURE, TYPE INDICATED

**H**⊠<sub>□</sub> MOUNTED EXIT LIGHT

**⊠**E EXIT LIGHT

**▽▽▽** TRACK LIGHTING FIXTURE

EMERGENCY FIXTURE REMOTE HEAD EMERGENCY FIXTURE

- LIGHTING CONTROLS
- S SINGLE POLE SWITCH S<sub>3</sub> 3-WAY SWITCH
- § FUSED TOGGLE SWITCH
- **SWP** WEATHERPROOF SWITCH
- WALL MOTION SWITCH SENSOR **ACUITY #WSX SERIES OR EQUAL**
- S<sub>MD</sub> COMBINATION WALL MOTION, DIMMING SWITCH SENSOR
- ACUITY #WSX D SERIES OR EQUAL
- ACUITY #SPODMRA D SERIES OR EQUAL LOW VOLTAGE ON/OFF BUTTON SWITCH

DIMMING SWITCH, 0-10 VOLT

- ACUITY #NPODMA SERIES OR EQUAL
- S<sub>D</sub> LOW VOLTAGE ON/OFF, DIMMING. ACUITY #NPODMA DX SERIES OR EQUAL
- SIM LOW VOLTAGE ON/OFF WITH INTEGRATED IR MOTION SENSOR ACUITY #NWSX LV SERIES OR EQUAL
- S LOW VOLTAGE ON/OFF, DIMMING WITH INTEGRATED IR MOTION SENSOR ACUITY #NWSX LV DX SERIES OR EQUAL
- S LOW VOLTAGE SWITCH. ON/OFF, RAISE/LOWER, CCT ADJUST ACUITY #NPODMA DX CCT WH
- S LOW VOLTAGE KEYED SWITCH. ON/OFF
- ACUITY #NPOD KEY MNTN WH
- SIKD LOW VOLTAGE KEYED SWITCH. ON/OFF, RAISE/LOWER. ACUITY #NPOD KEY WH
- WIRELESS LINE VOLTAGE POWERED SWITCH, ON/OFF ACUITY #RPODL MVOLT WH G2
- ROOM CONTROLLER, 3-RELAYS, 0-10V DIMMING, PLENUM RATED COOPER GREENGATE #RC3D-PL OR EQUAL
- PR POWER RELAY
- POWER RELAY PACK ACUITY #NPP16 D SERIES OR EQUAL
- PASSIVE INFRARED, CEILING MOUNTED, LARGE-MOTION DETECTION, 2000 SQFT RADIAL COVERAGE SENSOR
- ACUITY #NCM 10 SERIES OR EQUAL PASSIVE INFRARED, CEILING MOUNTED, SMALL-MOTION DETECTION, 500 SQFT RADIAL COVERAGE SENSOR
- ACUITY #NCM 9 SERIES OR EQUAL PASSIVE INFRARED, CEILING MOUNTED, LARGE-MOTION DETECTION, HIGH MOUNT, 1000 SQFT RADIAL COVERAGE SENSOR
- ACUITY #NCM 6 SERIES OR EQUAL DUAL TECH, CEILING MOUNTED, LARGE-MOTION DETECTION, 2000 SQFT RADIAL COVERAGE SENSOR

ACUITY #NCM PDT 10 SERIES OR EQUAL

- DUAL TECH 360°, CEILING MOUNTED, SMALL-MOTION DETECTION, 500 SQFT RADIAL COVERAGE SENSOR ACUITY #NCM PDT 9 SERIES OR EQUAL
- PASSIVE INFRARED HALLWAY MOTION SENSOR, 130' RANGE. ACUITY #HW13 SERIES OR EQUAL
- WALL MOUNTED SENSOR
- DAYLIGHT PHOTO SENSOR, CEILING MOUNTED, AUTO DIMMING ACUITY #NCM ADCX SERIES OR EQUAL
- (PC) LOW VOLTAGE PHOTOCELL FOR CONNECTION TO LCP. ACUITY #NIO PC
- DUPLEX RECEPTACLE
- QUADPLEX RECEPTACLE
- SPECIAL RECEPTACLE GFCI RECEPTACLE
- GFI FEED THROUGH GFCI DEVICE
- CIRCUIT BREAKER DISCONNECT
- DEVICE CONNECTION
- NON-FUSED DISCONNECT SWITCH

- JUNCTION BOX
- POWER POLE FOR CUBICLE DESKS. POWER AND DATA FLUSH MOUNTED PANEL
- SWITCHBOARD
- SINGLE PHASE MOTOR

THREE PHASE MOTOR

TRANSFORMER

- PUSH BUTTON STATION
- ADA PUSH BUTTON OPERATOR

# <u>ABBREVIATIONS</u>

- WP DENOTES WEATHER PROOF
- AFF ABOVE FINISH FLOOR
- AC ABOVE COUNTER
- EC ELECTRICAL CONTRACTOR
- EX EXISTING
- MDF MAIN DATA FRAME
- IDF INTERMEDIATE DATA FRAME

GFI GROUND FAULT CIRCUIT INTERRUPTER

- WR WEATHER RESISTANT MDP MAIN DISTRIBUTION PANEL
- PP POWER PANEL
- LP LIGHTING PANEL
- RP RECEPTACLE PANEL
- UPS UNINTERRUPTIBLE POWER SUPPLY LCP LIGHTING CONTROL PANEL
- GND GROUND
- MCB MAIN CIRCUIT BREAKER
- MLO MAIN LUGS ONLY
- CU COPPER
- AL ALUMINUM
- ATS AUTOMATIC TRANSFER SWITCH
- FAA FIRE ALARM ANNUNCIATOR PANEL
- FACP FIRE ALARM CONTROL PANEL
- CP CIRCULATION PUMP
- ADA AMERICANS WITH DISABILITIES ACT

# FIRE ALARM

VP VANDAL PROOF

FIRE ALARM CONTROL PANEL

TS FIRE ALARM TAMPER SWITCH FS FIRE ALARM FLOW SWITCH

DSD DUCT SMOKE DETECTOR

E<sub>VP</sub> VANDAL PROOF FIRE ALARM PULL STATION S SMOKE DETECTOR

FIRE ALARM STROBE ONLY EX CEILING MOUNTED FIRE ALARM STROBE ONLY

CEILING MOUNTED FIRE ALARM VOICE EVAC/STROBE COMBO

# COMMUNICATIONS

ACCESSIBLE CEILING

HDMI OUTLET, 1 1/2" CONDUIT ROUTED TO ACCESSIBLE CEILING, (4) HDMI

DATA/HDMI OUTLET (1 CAT6 / 1 HDMI). 1 1/4" CONDUIT ROUTED TO

- (2) DATA PORT OUTLET ROUGH-IN, (2 CAT6), 1" CONDUIT ROUTED TO ACCESSIBLE CEILING
- ACCESSIBLE CEILING DATA/HDMI OUTLET (2 CAT6 / 1 HDMI). 1 1/4" CONDUIT ROUTED TO
- INDICATED NUMBER OF DATA PORTS OUTLET ROUGH-IN, (INDICATED NUMBER OF CAT6), 1" CONDUIT ROUTED TO ACCESSIBLE CEILING
- CARD READER ROUGH-IN, 1" CONDUIT ROUTED TO ACCESSIBLE CEILING SECURITY CAMERA ROUGH-IN, 1" CONDUIT ROUTED TO ACCESSIBLE
- WIRELESS ACCESS POINT (1) CAT6 WITH QUICKPORT AND 10FT MAINTENANCE LOOP
- S SPEAKER

CLOCK

IOTA #IIS 125 SM DR


**ELECTRICAL SCHEDULES** INV2 250 WATT MINI-INVERTER. 120/277V IN/OUT. 305 WATT INPUT RATED. SURFACE MOUNTED. DIMMING RELAY. UL 924 LISTED.


6" ROUND POKE-THROUGH FLOOR BOX. (2) DUPLEX RECEPTACLES, (1) HDMI

PORT, (2) DATA JACKS. 1 1/4" CONDUIT CONNECTION FOR HDMI/DATA.

IOTA #IIS 250 HE DR INV3 125 WATT MINI-INVERTER. 120V IN/OUT. 150 WATT INPUT RATED. SURFACE MOUNTED. DIMMING RELAY. UL 924 LISTED.

FB LEGRAND #6ATC2PAA - 6MAAP2A-1125CHA, HDMI - #AV3000BK

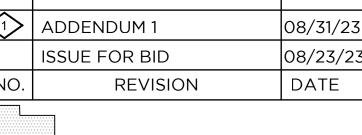

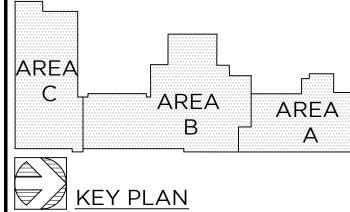



NORTH NO SCALE

COPYRIGHT © 2022 MACMILLAN ASSOCIATES CONSULTING ENGINEERS 714 EAST MIDLAND STREET • BAY CITY, MICHIGAN 48706 (989) 894-4300 F (989) 894-9930 www.macmillanassociates.com

PROJECT TITLE ADDITION AND RENOVATION:

MIDLAND COUNTY ESA

100 S Jefferson Ave, Suite 601

Saginaw, Michigan 48607


MIDLAND, MICHIGAN SCHEDULES AMD SYMBOLS

PROJECT NUMBER 2022006.1 PROJECT DATE AUGUST 23, 2023

CHECKED BY

E4.01

SHEET NUMBER

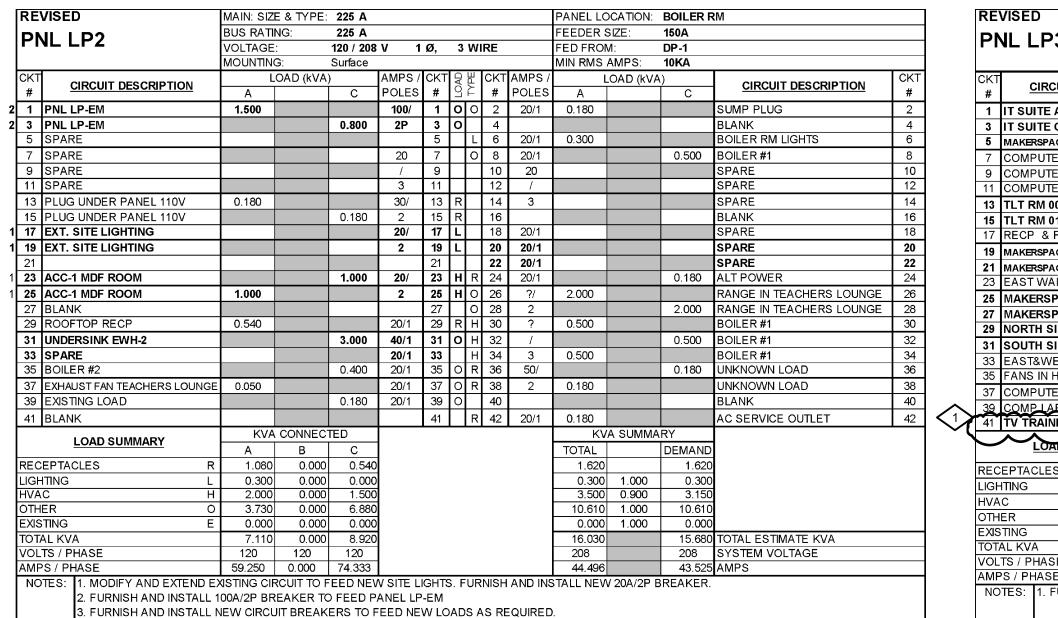

			RE	/ISED	MAIN: SIZ	E & TYPE:	225 A	MCB						PANEL LO	CATION:	MAINTEN	ANCE RM	
			DA	II I D2	BUS RAT	NG:	225 A							FEEDER S	IZE:			
			יואן	IL LP3	VOLTAGE		120 / 208	8 V 1	Ø,	3	WI	RE		FED FROM	1:	DP-1		
					MOUNTIN	G:	SURFAC	E						MIN RMS A	AMPS:	10KAIC		
RCUIT DESCRIPTION	CKT		СКТ	CIRCUIT DESCRIPTION	L	OAD (kVA	<u> </u>	AMPS /	CKT	βD	PE	СКТ	AMPS / POLES	L	OAD (kVA		CIRCUIT DESCRIPTION	CKT
	#		#	CINCOLL PECCHAL HON	Α		С	POLES	#			#	POLES	Α		С	Ontoon Besselli Hell	#
LUG	2		1	IT SUITE ABOVE COUNTER REC	0.540			20/1	1		R	2	20/1	0.360			MOTHER'S RM REC	2
	4		3	IT SUITE OFFICE 3A REC			0.360	20/1	3	R		4	20/1			0.180	LOUNGE ABOVE COUNTER REC	4
RM LIGHTS	6		5	MAKERSPACE ABOVE COUNTER REC	0.180			20/1	5			6	20/1	0.180			LOUNGE ABOVE COUNTER REC	6
#1	8		7	COMPUTER			0.180	20/1	7			8	20/1			0.180	LOUNGE ABOVE COUNTER REC	8
	10			COMPUTER	0.180			20/1	9		R	10	20/1	0.180			LOUNGE REC	10
	12		11	COMPUTER			0.180	20/1	11	R	R	12	20/1			0.180	MDF ROOM WALL REC	12
	14		13	TLT RM 007 LV XMFR (JANITOR'S	0.050			20/1	13	ा	R	14	20/1				RECP FAN RM #6A&B	14
	16		15	TLT RM 011 LV XMFR (JANITOR'S			0.050	20/1	15	0	R	16	20/1			0.540	WIRE MOLD EAST WALL #7	16
	18		17	RECP & FAN 2A&B	0.200			20/1	17	R	L	18	20/1	0.500			CORRIDOR LIGHTING	18
	20		19	MAKERSPACE ABOVE COUNTER REC			0.180	20/1	19	R	R	20	20/1			0.180	RECPTIONIST RECP EAST WALL	20
	22		21	MAKERSPACE ABOVE COUNTER REC	0.360			20/1	21	R	R	22	20/1	0.360			MDF ROOM CEILING REC	22
WER	24		23	EAST WALL RECP RM #3			0.180	20/1	23			24	20/1			0.360	MDF ROOM CEILING REC	24
IN TEACHERS LOUNGE	26		25	MAKERSPACE MARKERBOARDS	0.360			20/1	25	R	R	26	20/1	0.180			RECP	26
IN TEACHERS LOUNGE	28		27	MAKERSPACE TV REC			0.360	20/1	27	R		28	20/1			0.180	NORTH ROOM RECP	28
#1	30			NORTH SIDE LIGHTING	1.200			20/1	29	디		30	20/1	0.180			NORTH ROOM RECP	30
#1	32		31	SOUTH SIDE LIGHTING			1,200	20/1	31			32	30/				JANITOR RM EWH-1	32
#1	34		$\vdash$	EAST&WEST WALL RECP #4	0.180			20/1	33	R		34	2P	2.250			JANITOR RM EWH-1	34
WN LOAD	36			FANS IN HAPPY DAYS			0.180	20/1	35			36	20/1			0.500	KITCHEN IN HAPPY DAYS	36
WN LOAD	38		-	COMPUTER LAB4 SURGE SUPP	0.180			20/1	37	R	R	38	20/1	0.180			COMPUTER LAB 2 SURGE	38
	40			COMP LAR 3 RECP CIRCUIT		~~~	Q.48Q	28/1	30/	_	R	40	20/1				COMPUTER LAB 1 LIGHTING	40
VICE OUTLET	42	<b>  &lt;¹,&gt;</b>		TV TRAINING ROOM	0.360		VII.V-V	20/1	41	_		42						42
		~ (				CONNEC		$\overline{}$			<del>-</del>			ΚV	A SUMMA	RY		
				LOAD SUMMARY	A	В	С							TOTAL		DEMAND		
			REC	EPTACLES R	4.160	0.000	4.280	5						8.440		8.440		
			LIGH	TING L	1.700	0.000	1.200	5						2.900	1.000	2.900		
			HVA	с н	0.000	0.000	0.000	5						0.000	0.900	0.000		
			OTH	ER O	2.300	0.000	2.300	5						4.600	1.000	4.600		
			EXIS	TING E	0.000	0.000	0.000	<u> </u>						0.000	1.000	0.000		
ESTIMATE KVA N VOLTAGE			TOTA	AL KVA	8.160	0.000	7.780	5						15.940		15.940	TOTAL ESTIMATE KVA	
// VOLIAGE			VOL	TS / PHASE	120	120	120	1						208		208	SYSTEM VOLTAGE	
			AMP	S / PHASE	68.000	0.000	64.833							44.246		44.246	AMPS	
			NO.	TES: 1. FURNISH AND INSTALL N	IEW CIRC	JIT BREAK	ERS TO F	FEED NE	W LC	AD	S A	S RE	QUIRED	).				
									_									

MAIN: SIZE & TYPE: 100 A MLO

NEW

KT #	IL LP5	BUS RAT	ING:		225 A											
KT #		1/01 740										FEEDER:	SIZE:	200A		
#		VOLTAG			120 / 208	8 V 1	Ø,	3	WI	RE		FED FROI		DP-2		
#		MOUNTIN	IG:		Surface							MIN RMS	AMPS:	10KA		
	CIRCUIT DESCRIPTION		LOAD	(kVA)		AMPS /		LOAD	₽		AMPS /	L	OAD (kVA	<del></del>	CIRCUIT DESCRIPTION	C
1 li		A			С	POLES	#	7	Ĺ	#	POLES	Α		С		Ŀ
<u> </u>	BATH LTS STORAGE RM	0.300				20/1	1	L		2	20/1	0.540			LOCKER RM LTS. LOUNGE N RECPT. SE	Ľ
	RECPT				0.540	20/1	3	R		4	20/1			0.540	E GYM RECPT	Ľ
5 I	NORTH RECP. RM 103	0.540				20/1	5		Η	6	20/1	1.000			GYM UNIT HEATER ELEVATED	1
7	DEPARTMENT PLUGS				0.540	20/1	7	R		8	20/1			0.200	GYM STORAGE #1	<u></u>
9	LEFT GYM HEATER	1.000				20/1	9	Н	Н	10	20/1	1.000			RIGHT GYM HEATER	1
11 I	EF-3 & WATER HEATER REC				0.200	20/1	11	R		12	20/1				SPARE	1
13	SPARE					20/1	13			14	20/1				SPARE	1
15 (	GYM STORAGE RM. #2				0.360	20/1	15	R		16	20/1				DEMO	1
17	GYM WEST RECPT	0.540				20/1	17	R	R	18	20/1	0.900			GYM N RECPT. W OUTSIDE LTS	1
19 I	RECPT				0.540	20/1	19	R	R	20	20/1			0.900	GYM SW RECPT	2
21 (	GYM NW LIGHTS	0.630				20/1	21	L	L	22	20/1	0.630			GYM SW LIGHTS	1
23	GYM NE LIGHTS				0.630	20/1	23	L	L	24	20/1			0.630	GYM SE LIGHTS	1
25 (	CONFERENCE RM S RECPT	0.540				20/1	25	R	0	26	50	0.180			EXISTING LOAD	1
_	SPARE					20/1	27		0	28	/2			0.180	EXISTING LOAD	1 2
29	SPARE					20/1	29			30	20/1				SPARE	3
31 5	SPARE					20/1	31	П	П	32	20/1				SPARE	13
_	SPARE					20/1	33		0	34	20/1	0.100			PULL DOWN CURTAIN?	1 3
35 .	JOHNSON CONTROL PANEL				0.100	20/1	35	0		36	20/1				SPARE	13
37 I	BIG FANS	0.500				20/1	37	Н		38	20/1				SPARE	1 3
39	SPARE					50	39		0	40	20/1			0.180	EXISTING LOAD	
	SPARE					/2	41		0	42	20/1	0.180			EXISTING LOAD	1
		KV	A CON	NEC	ΓED							ку	A SUMMA	RY		_
	LOAD SUMMARY	А			С	1						TOTAL		DEMAND		
RECE	PTACLES	R 2.520			3.820	1						6.340		6.340		
		L 2.100			1.260	-						3,360		3.360		
IVAC		H 3.500			0.000	-						3.500		3.150		
THE		0 0.460			0.460	-						0.920		0.920		
		E 0.000			0.000	4						0.000		0.000		
	L KVA	8.580			5.540	4						14.120			TOTAL ESTIMATE KVA	
	S / PHASE	120	1		120	4						208		208	SYSTEM VOLTAGE	
	S / PHASE	71.500			46.167	-						67.885			AMPS	
	ES: 1. THIS PANEL SCHEDUL		) ON T			A NIE !	OUE	NI II		-15-1-5	TDAAC					—

	VISED	MAIN: SIZE	& TYPE:	225 A	MLO						PANEL LO	CATION:	JANITOR'	S CLOSET	
DI	NL LP6	<b>BUS RATIN</b>	NG:	225 A							FEEDER S	SIZE:	200A		
ГΙ	NL LFO	VOLTAGE:		120 / 208	3 V 1	Ø,	3	WI	RE		FED FROI	M:	DP-2		
		MOUNTING	<b>∋</b> :	SURFAC							MIN RMS	AMPS:	10KA		
CKT	CIRCUIT DESCRIPTION	Lo	DAD (KVA)	)	AMPS / POLES	CKT	AD	PΕ	CKT	AMPS /	L	OAD (KV	۹)	CIRCUIT DESCRIPTION	СК
#	CIRCOIT BESORII TICIN	Α	В	C	POLES	#	의	$\vdash$	#	POLES	Α	В	С	GIROSTI DESCRIT TICH	#
1	CORRIDOR LIGHTING	1.343			20/1	1	L	R	2	20/1	0.540			BEHAVIOR OFFICE POWER POLE 1	2
3	CONF/STG/OFFICE LIGHTING			1.232	20/1	3	L	R	4	20/1			0.540	BEHAVIOR OFFICE POWER POLE 1	4
5	PHYS THERAPY, TLT, LOUNGE, PERIM. LT	1.324			20/1	5	L	R	6	20/1	0.540			BEHAVIOR OFFICE POWER POLE 2	6
7	BH OFFICE, STORAGE, TLT, STAIR LTS			1.218	20/1	7	L	R	8	20/1			0.540	BEHAVIOR OFFICE POWER POLE 2	8
9	EXHAUST FAN 4	0.075			20/1	9	Н	R	10	20/1	0.500			BEHAVIOR OFFICE COPIER REC	10
11	WATER HEATER REC.			0.180	20/1	11	R	R	12	20/1			0.360	BEHAVIOR OFFICE CONV. REC	12
13	EXHAUST FAN 5	0.135			20/1	13	Н	R	14	20/1	0.360			BEHAVIOR OFFICE 318A REC	14
15	PT/OT OFFICE 319A REC			0.360	20/1	15	R	R	16	20/1			0.180	TLT RM 316 REC.	16
17	MENS TLT RM REC	0.180			20/1	17	R	R	18	20/1	0.900			STORAGE ROOMS REC.	18
19	STAFF LOUNGE MICROWAVE REC			0.180	20/1	19	R	R	20	20/1			1.080	CORRIDOR REC.	20
21	STAFF LOUNGE MICROWAVE REC	0.180			20/1	21	R	R	22	20/1	0.360			S. STAIRWELL REC. / WC REC	22
23	STAFF LOUNGE ABOVE COUNTER REC			0.180	20/1	23			24	20/1			0.540	PT/OT OFFICE POWER POLE 1	24
25	STAFF LOUNGE ABOVE COUNTER REC	0.180			20/1	25	R	R	26	20/1	0.540			PT/OT OFFICE POWER POLE 1	26
27	STAFF LOUNGE FRIDGE REC			0.500	20/1	27		R	28	20/1			0.540	PT/OT OFFICE POWER POLE 2	28
29	STAFF LOUNGE CONV. REC	0.360			20/1	29	R	R	30	20/1	0.540			PT/OT OFFICE POWER POLE 2	30
31	SPEECH PATH. POWER POLE 1			0.540	20/1	31	R	R	32	20/1			0.540	PT/OT OFFICE POWER POLE 3	32
33	SPEECH PATH. POWER POLE 1	0.540			20/1	33		R	34	20/1	0.540			PT/OT OFFICE POWER POLE 3	34
35	SPEECH PATH. POWER POLE 2			0.540	20/1	35				20/1			0.720	PT/OT OFFICE CONV. REC.	36
37	SPEECH PATH. POWER POLE 2	0.540			20/1	37		R		20/1	0.540			PT/OT OFFICE CONV. REC.	38
39	LP-6A			4.260	100/	39		R	40	20/1			0.500	PT/OT OFFICE COPIER REC.	40
41	LP-6A	4.260			2P	41	_		42	20/1	0.360			PT/OT OFFICE 319B REC	42
		KVA	CONNEC	TED						•	ΚV	A SUMMA	ARY		
	LOAD SUMMARY	A		С	1						TOTAL		DEMAND		
REC	EPTACLES R	11.960		12.280	5						24.240		17.120		
	HTING L	2.667		2.450							5.118	1.000	5.118		
HVA				0.000	-						0.210		0.189		
OTH				0.000							0.000		0.000		
	STING E	0.000		0.000							0.000		0.000		
	AL KVA	14.837		14.730	-						29.568		22 427	TOTAL ESTIMATE KVA	
	.TS / PHASE	120		120	1						208		208	SYSTEM VOLTAGE	
	PS / PHASE	123.644		122.753	1						142.152		107.821		
	OTES:			50	1									<u> </u>	
110															

	II I DCA	BUS RATI	NG:	100 A							FEEDER:	SIZE:	100A		
יור	NL LP6A	VOLTAGE	:	120 / 208	V 1	Ø,	3	WI	RE		FED FROI	M:	LP-6		_
		MOUNTING	G:	SURFAC	E						MIN RMS	AMPS:	10KA		_
СКТ	CIDCUIT DESCRIPTION	L	OAD (KV	A)	AMPS / POLES	CKT	ΑD	Ы	CKT	AMPS /	L	OAD (KV	۹)	CIDCUIT DECCRIPTION	
#	CIRCUIT DESCRIPTION	Α	В	С	POLES	#	g	<b>≿</b>	#	POLES	Α	B	C	CIRCUIT DESCRIPTION	
1	SPEECH PATH. W. WALL REC	0.540			20/1	1	R	R	2	20/1	0.720			TEACHER CONSULTANT CONV REC	_
3	SPEECH PATH. CONV. REC			0.540	20/1	3	R	R	4	20/1			0.540	TEACHER CONSULTANT POWER POLE 1	
5	SPEECH PATH. COPIER REC	0.500			20/1	5	R	R	6	20/1	0.540			TEACHER CONSULTANT POWER POLE 1	•
7	SPPECH PATH, OFFICE 313A REC			0.540	20/1	7	R	R	8	20/1			0.540	TEACHER CONSULTANT POWER POLE 2	•
9	CONF RM 300B REC	1.080			20/1	9	R	R	10	20/1	0.540			TEACHER CONSULTANT POWER POLE 2	•
11	CONF RM 300A REC			0.900	20/1	11	R	R	12	20/1			0.180	TEACHER CONSULTANT COPIER REC.	•
13	LOBBY 300 DOOR OP & REC	0.100			20/1	13	0	R	14	20/1	0.540			TEACHER CONSULTANT 311A REC	
15	ELEV. HALL, STORAGE, STAIR REC			0.540	20/1	15	R	R	16	20/1			0.180	WATER COOLER REC	
17	TLT RM XMFRS	0.100			20/1	17			18	20/1					
19					20/1	19	П		20	20/1					1
21					20/1	21			22	20/1					
23					20/1	23	П		24	20/1					
25					20/1	25	П		26	20/1					,
27					20/1	27			28	20/1					•
29					20/1	29			30	20/1					•
31					20/1	31	П		32	20/1					•
33					20/1	33			34	20/1					•
35					20/1	35			36	20/1					•
37					20/1	37	П		38	20/1					
39					20/1	39			40	20/1					
41					20/1	41			42	20/1					•
	LOAD CUMMARY	KVA	CONNE	CTED							KV	'A SUMMA	∖RY		
	LOAD SUMMARY	Α		С	1						TOTAL		DEMAND	1	
REC	EPTACLES R	4.460		3.960							8.420		8.420	]	
LIGH	ITING L	0.000		0.000							0.000	1.000	0.000	1	
HVA	.C H	0.000		0.000							0.000	0.900	0.000	1	
ОТН	ER O	0.100		0.000							0.100	1.000	0.100	1	
EXIS	TING	0.000		0.000							0.000	1.000	0.000	<u> </u>	
TOTA	AL KVA	4.560		3.960							8.520		8.520	TOTAL ESTIMATE KVA	•
VOL:	TS / PHASE	120		120	1						208			SYSTEM VOLTAGE	•
AMP	PS / PHASE	38.000		33.000							40.962		40.962	AMPS	•
NO	TES:														

PANEL LOCATION: JANITOR'S CLOSET

ΚE	VISED		E & TYPE:		MCB						PANEL LO		BOILER R	M	
DN	NL LP-EM	BUS RATI	NG:	<b>100</b> A							FEEDER S	SIZE:			
	AL FL-FIAI	VOLTAGE	:	120 / 208	V 1	Ø,	3 ∖	VIR	E		FED FROM	<b>V</b> I:	LP-2		
		MOUNTIN	G:	SURFAC							MIN RMS	AMPS:			
CKT	CIRCUIT DESCRIPTION	L	.OAD (kVA	)	AMPS /	СКТ	LOAD	<u>.</u>   C	KTA	MPS/	L	OAD (kVA	.)	CIRCUIT DESCRIPTION	Ck
#	CIRCOTT BESCRIPTION	Α		С	POLES	#	요수		# F	POLES	Α		С	CIRCOTI DESCRIPTION	#
1	EXIT LIGHTS	0.300			20/1	1	L	ा	2	20/1	0.100			FIRE ALARM	2
3	WALL PACKS			0.200	20/1	3	L	ा	4	20/1			0.100	FIRE ALARM	4
5	EXISTING LOAD	0.500			20/1	5	0 (		6	20/1	0.100			SIMENS TEMP CONTROLS	6
7	GARAGE			0.500	30/	7			8	20/1				SPARE	8
9	GARAGE	0.500			2	9	0	1	10	30/				SPARE	10
11	BLANK					11		1	12	2				SPARE	1:
	LOAD SUMMARY	KVA	CONNEC	TED							KV	A SUMMA	RY		
	LOAD SUMMARY	Α		С	1						TOTAL		DEMAND		
REC	CEPTACLES R	0.000		0.000							0.000		0.000		
LIGH	HTING L	0.300		0.200							0.500	1.000	0.500		
HVA	C H	0.000		0.000							0.000	0.900	0.000		
ОТН	IER O	1.200		0.600							1.800	1.000	1.800		
	STING E	0.000		0.000							0.000	1.000	0.000		
EXIS		1.500		0.800							2.300		2.300	TOTAL ESTIMATE KVA	
	AL KVA	1.500			1						208		208	SYSTEM VOLTAGE	
TOT.	AL KVA TS / PHASE	120		120											

۷E۱	V	MAIN. SIZ	E & TYPE:	200 A	MCB						PANEL LC	JCA HON.			
DN	IL RP1B	BUS RATI	NG:	<b>225</b> A							FEEDER S	SIZE:	200A		
ГГ	IL REID	VOLTAGE	:	120 / 208	V 3	Ø,	4	WI	RE		FED FROM	M:	MDP		
		MOUNTING	G:								MIN RMS	AMPS:	14KAIC		
CKT	CIRCUIT DESCRIPTION	L	OAD (KVA)	)		CKT	LOAD	Æ		AMPS /	L	.OAD (KVA	١)	CIRCUIT DESCRIPTION	Т
#	CINCOLL PESCIAL LICIA	Α	В	C	POLES	#		$\subseteq$	#	POLES	Α	В	С	GINGGIT BESCHI TICH	L
1	SECURE ENTRANCE LIGHTS	1.152			20/1	1		R	2	20/1	0.360			RECEPTION OFFICE REC	
-	IDF		0.250		20/1	3		R	4	20/1		0.900		WAITING AREA REC	
5	IDF			0.250	20/1	5	R	R	6	20/1			0.540	SECURE VEST. & LOBBY REC	
7	CORRIDOR 104 LIGHTS	1.036			20/1	7	L	R	8	20/1	0.540			LOBBY REC	T
9	CLSRM 114,116, SENSORY, LOCKER LTS		1.387		20/1	9	L	R	10	20/1		0.540		CLINIC REC	Ī
11	CLSRM 115, 113, TLT LTS			0.946	20/1	11	L	R	12	20/1			0.180	CLINIC TLT REC	Ī
13	LIFE SKILLS, SIM, PAES LTS	0.738			20/1	13	L	R	14	20/1	0.540			NURSE OFFICE REC	I
15	LIFE SKILLS DRYER		1.400		30/	15		R	16	20/1		0.900		PAES ROOM REC.	1
17	LIFE SKILLS DRYER			1.400	2P	17	R	R	18	20/1			0.360	CLINIC FRIDGE & COUNTER REC	ŀ
19	LIFE SKILLS WASHER	0.500			20/1	19	R	R	20	20/1	0.900			SIMULATION RM REC	1
21	FIRE ALARM CP AND ANNUNCIATOR		0.050		20/1	21	0	R	22	20/1		0.180		LIFE SKILLS FRIDGE	1
23	SECURE VESTIBULE DOOR OP.			0.250	20/1	23	0	R	24	20/1			0.180	LIFE SKILLS ABOVE COUNTER REC	
25	WAITING AREA DOOR OP.	0.100			20/1	25	0	R	26	20/1	0.180			LIFE SKILLS ABOVE COUNTER REC	
27	CIRCULATION 103 DOOR OP.		0.050		20/1	27	0	R	28	20/1		0.540		LIFE SKILLS TV, CONV. REC	٦
29	EAST ENTRANCE DOOR OP.			0.100	20/1	29	0	R	30	20/1			0.720	CIRCULATION 103 REC	1
31	COURTYARD ENTRANCE DOOR OP	0.100			20/1	31	0	R	32	20/1	0.720			SENSORY HALL & CONF. RM RE	1
33	LIFE SKILLS STOVE REC		2.750		30/	33	R	R	34	20/1		0.540		CONFERENCE 119 REC	
35	LIFE SKILLS STOVE REC			2.750	2P	35	R	R	36	20/1			0.360	TOILET RM 104C ABOVE COUNTER REC	1
37	LIFE SKILLS COUNTER REC	0.180			20/1	37	R	R	38	20/1	0.540			JANITOR 104G & TLT CONV. REC	
39	CLSRM 113 CHARGE STATION REC		0.180		20/1	39	R	R	40	20/1		0.180		CLASSROOM 113 ABOVE COUNTER REC	
41	CLSRM 115 CHARGE STATION REC			0.180	20/1	41	R	R	42	20/1			0.720	CLSRM 113 TEACHING WALL REC	
	LOAD CHMMADY	KVA	CONNEC	TED							KV	A SUMMA	RY		
	LOAD SUMMARY	Α	В	С	1						TOTAL		DEMAND		
REC	PTACLES R	4.460	8.360	7.640	1						20.460		15.230		
.IGH	TING L	2.926	1.387	0.946	1						5.259	1.000	5.259		
ΗVΑ	С	0.000	0.000	0.000	1						0.000	0.950	0.000		
OTH	R O	0.200	0.100	0.350	1						0.650	1.000	0.650		
XIS	TING E	0.000	0.000	0.000	]						0.000	1.000	0.000		
OT/	IL KVA	7.586	9.847	8.936	1						26.369		21.139	TOTAL ESTIMATE KVA	
OL.	S / PHASE	120	120	120	1						208		208	SYSTEM VOLTAGE	
MP	S / PHASE	63.214	82.056	74.470	]						73.195		58.677	AMPS	

NEW		MAIN: SIZI	E & TYPE:	200 A	MLO						PANEL LO	JCA HON.			
DNI	L RP1B SUB	<b>BUS RATII</b>	NG:	<b>225</b> A							FEEDER S	SIZE:	200A		
I 14	LINFID SOD	VOLTAGE		120 / 208	V 3	Ø,	4 \	WIF	RE		FED FROM	M:	RP1B FEE	D-THRU I	
		MOUNTING	3:								MIN RMS	AMPS:	14KAIC		
CKT	CIRCUIT DESCRIPTION	L	OAD (KVA	)	AMPS /	СКТ	LOAD	ľF	CKT	AMPS /	L	.OAD (KVA	١)	CIRCUIT DESCRIPTION	С
#	CIRCUIT DESCRIPTION	Α	В	O	POLES	#	\ <u>\</u> 01	_	#	POLES	Α	В	С	CINCOIT BESCRIPTION	
43 (	CLSRM 114 CHARGE STATION RE	0.180			20/1	43	R	R	44	20/1	0.540			CLSRM 113 FURNITURE BASE FEED	_
45 (	LSRM 116 CHARGE STATION RE		0.180		20/1	45	R	R	46	20/1		0.180		CLSRM 115 ABOVE COUNTER REC	٦.
47 5	SPARE				20/1	47		R	48	20/1			0.720	CLSRM 115 TEACHING WALL REC	
49 E	XHAUST FAN 2	0.061			20/1	49	Н	R	50	20/1	0.540			CLSRM 115 FURNITURE BASE FEED	,
51 (	OTHER ENTRANCES CANOPYLTS		0.075		20/1	51	L	R	52	20/1		0.720		CLSRM 116 TEACHING WALL REG	
53 I	NVERTERS IN IDF RM			0.300	20/1	53	L	R	54	20/1			0.180	CLSRM 116 COUNTER REC	
55 T	LT RM 104C XMFR (JANITOR'S CLOSET)	0.100			20/1	55	0	R	56	20/1	0.540			CLSRM 116 EXT. WALL REC	
57 T	LT RM 104D XMFR (JANITOR'S CLOSET)		0.100		20/1	57	0	R	58	20/1		0.540		CLSRM 116 FURNITURE BASE FEED	
59 T	OILET RM 104D ABOVE COUNTER REC			0.360	20/1	59	R	R	60	20/1			0.720	CLSRM 114 TEACHING WALL REG	
61 (	ABINET HEATER AT MAIN ENTRANCE	0.050			20/1	61	Н	R	62	20/1	0.180			CLSRM 114 COUNTER REC	
63 L	IFE SKILLS ISLAND STOVETOP		2.250		20/1	63	_	R	64	20/1		0.540		CLSRM 114 EXT. WALL REC	
65 L	IFE SKILLS ISLAND STOVETOP			2.250	20/1	65		R	66	20/1			0.540	CLSRM 114 FURNITURE BASE FEED REC	
_	IFE SKILLS DOWNDRAFT	0.180			20/1	67	R	R	68	20/1	0.540			WEST CORRIDOR/VEST. REC	
	IFE SKILLS KITCHEN EQUIP		0.180		20/1	69	R		70	20A		1.000		ACC-1	T.
	SPARE				20/1	71		Н	72	2P			1.000	ACC-1	j -
73 5	SPARE				20/1	73			74	20/1				SPARE	Ī
	SPARE				20/1	75			76	20/1				SPARE	ŀ.
	SPARE				20/1	77			78	20/1				SPARE	
	SPARE				20/1	79	$\top$	7	80	20/1				SPARE	<u> </u>
	SPARE				20/1	81		1	82	20/1				SPARE	
	SPARE				20/1	83	$\vdash$	1	84	20/1				SPARE	
		KVA	CONNEC	TFD							KV	A SUMMA	RY		<u> </u>
	LOAD SUMMARY	A	В	С	1						TOTAL		DEMAND		
RECE	PTACLES R	2.700	4.590	4.770	1						12.060		11.030		
JIGHT		0.000	0.075	0.300	-						0.375		0.375		
HVAC		0.000	1.000	1.000							2.111	0.950	2.005		
OTHE		0.100	0.100	0.000	4						0.200		0.200		
EXIST		0.000	0.000								0.000		0.000		
	L KVA	2.911	5.765		-						14.746			TOTAL ESTIMATE KVA	
	S / PHASE	120	120	120	7						208			SYSTEM VOLTAGE	
	6 / PHASE	24.258	48.042	50.583	1						40.932		37.780		
	ES:	_ 1.200	10.0 12	30.000	<u> </u>						10.002		0700	J	

۷E	vv	MAIN: SIZE											ADDITION	AREA C JANITORS	
DN	NL RP1C	BUS RATI	NG:	225 A							FEEDER S	SIZE:	SEE ONEL	INE	
	AL IXF IO	VOLTAGE	•	120 / 208	V 3	Ø,	4	WI	RE		FED FROM	<b>√</b> 1:	MDP		
		MOUNTING	Э:	SURFACI							MIN RMS	AMPS:	14KAIC		
CKT	OLDOUIT DESCRIPTION	L	OAD (kVA	.)	AMPS / POLES	СКТ	Ð	Ы	CKT	AMPS /	L	OAD (kVA	١)	OLDOUIT DECODIDATION	CK.
#	CIRCUIT DESCRIPTION	Α		С	POLES	#	9	۲	#	POLES	Α		С	CIRCUIT DESCRIPTION	#
1	CLASS RM 145,141,139,135 LTS	1.683			20/1	1	L	R	2	20/1	0.540			CLASSRM 145 SW WALL REC	2
3	CLASS 133, HIVE, MAT RM LTS		1.500		20/1	3		R	4	20/1		0.540		CLASSRM 145 NE WALL REC	4
	BATH, EXER & QUIET RM LTS			1.500	20/1	5		R	6	20/1			0.540	CLASSRM 145 TV & W REC	6
7	CORRIDOR LTS	0.850			20/1	7		R	8	20/1	0.540			CLASSRM 141 TV & W REC	8
	CLASSRM 141 S WALL REC		0.540		20/1	9	_		10	20/1		0.540		CLASSRM 141 NE WALL REC	10
	CLASSRM 139 TV & W REC			0.540	20/1	11	R		12	20/1			0.540	CLASSRM 139 NE WALL REC	12
	CLASSRM 139 E&S WALL REC	0.540			20/1	13	R		14	20/1	0.540			CLASSRM 135 TV & W REC	14
	CLASSRM N WALL REC	5.5 15	0.540		20/1	15	R		16	20/1	0.0.10	0.540		CLASSRM 135 SE WALL REC	16
	HIVE GENERAL RECPTS		0.0.0	1.080	20/1	17	R		18	20/1		0.0.10	0.180	IDF	18
	CHANGE RMS & STAFF TLT REC	0.900			20/1	19	R		20	20/1	0.180			IDE	20
	EXERCISE RM RECPTS	0.000	1.080		20/1	21		R	22	20/1	0.100	0.720		NE CLASSRM RECPTS	22
	JANITORS CLOSET RECPT		1.000	0.180	20/1	23	R		24	20/1		0.720	0.720	BATHROOM RECPTS	24
	QUIET RM CORRIDOR REC	0.360		0.100	20/1	25	R		26	20/1	0.720		0.720	NE CLASSRM RECPTS	26
	MAIN CORRIDOR REC	0.500	1.080		20/1	27	R		28	20/1	0.120	0.540		VESTIBULE 106 & STAIR REC	28
	CONF. RM 143 REC		1.000	0.360	20/1	29	R		30	20/1		0.540	0.720	CONF. RM 137 RECPTS	30
_	CLASSRM 133 N&E REC	0.540		0.000	20/1	31		R	32	20/1	0.360		0.720	CLASSRM 133 S. REC	32
	CLASSRM 133 TV & W REC	0.540	0.540		20/1	33	R		34	20/1	0.300	1.080		MAT ROOM 130 REC	34
	WATER FOUNTAIN		0.540	0.180	20/1	35	R		36	20/1		1.000		KITCHEN EQUIP	36
	CH-1	0.050		0.100	20/1	37	Н		38	20/1	0.180			KITCHEN EQUIP	38
	CH-2	0.030	0.050		20/1	39	_	R	40	20/1	0.100	0.180		KITCHEN EQUIP	40
	EF-6		0.050	0.073	20/1	41	Н		42	20/1		0.160		KITCHEN EQUIP	42
		0.400		0.073							0.400		0.160		
	TLT RM ABOVE COUNTER REC	0.180	0.400		20/1	43	R		44	20/1	0.180	0.450		WASHER	4/
	TLT RM ABOVE COUNTER REC		0.180	0.200	20/1	45	R		46	30/		2.150	2.450	DRYER	46
_	KITCHEN ISLAND REC	0.050		0.360	20/1	47	R	_	48	2	0.050		2.150	DRYER	48
	EXTERIOR LIGHTS	0.256			20/	49	-	의	50	20/1	0.050			TLT RM LOW VOLTAGE XMFR	50
	EXTERIOR LIGHTS		0.256	0.400	2P	51	L	<u></u>	52	60/		0.000	0.000	RP1C-A SUBPANEL	52
53	KITCHEN EQUIP	10.00	0011150	0.180	20/1	53	R	0	54	2P	10.0			RP1C-A SUBPANEL	54
	LOAD SUMMARY	L	CONNEC									A SUMMA			
		A	В	С							TOTAL		DEMAND		
	EPTACLES R	5.760	10.250		ı						24.100		17.050		
	HTING L	2.789	1.756								6.045		6.045		
IVA		0.050	0.050								0.173		0.164		
	ER O	0.050	0.000								0.050		0.050		
	STING E	0.000	0.000								0.000	1.000	0.000		
	AL KVA	8.649	12.056								30.367			TOTAL ESTIMATE KVA	
	TS / PHASE	120	120	120							208			SYSTEM VOLTAGE	
MIP	PS / PHASE DTES: I	72.073	100.467	80.521							84.293		64.700	AMPS	

NEW PNL RP1C-A		MAIN: SIZ	MAIN: SIZE & TYPE: 60 A MLO									PANEL LOCATION:					
		BUS RATING: 100 A									FEEDER SIZE: 60A						
		VOLTAGE	VOLTAGE: 120 / 208 V 1 Ø, 3 WIRE								FED FROM: RP1C						
		MOUNTING:									MIN RMS AMPS: 10KAIC						
CKT #	CIRCUIT DESCRIPTION	L	.OAD (kVA)	1	AMPS / CKT ♀ \ CKT AMPS					AMPS /	LOAD (kVA)			OLDOUIT DESCRIPTION			
		Α		С	POLES	#	βí	<b>≿</b>	#	POLES	Α	,	С	CIRCUIT DESCRIPTION	#		
1	ACC-1	1.000			20A	1	Н	0	2	20/1	0.100			DOOR OPERATOR	2		
3	ACC-1		1.000		2P	3	Н	0	4	20/1		0.100		DOOR OPERATOR	4		
5	SPARE				20/1	5			6	20/1				SPARE	6		
7	SPARE				20/1	7		T	8	20/1				SPARE	8		
9	SPARE				20/1	9			10	20/1				SPARE	10		
11	SPARE				20/1	11			12	20/1				SPARE	12		
13	SPARE				20/1	13			14	20/1				SPARE	14		
15	SPARE				20/1	15			16	20/1				SPARE	16		
	SPARE				20/1	17		T	18	20/1				SPARE	18		
19					20/1	19	П	寸	20	20/1					20		
21					20/1	21		1	22	20/1					22		
23					20/1	23		1	24	20/1					24		
25					20/1	25		寸	26	20/1					26		
27					20/1	27		寸	28	20/1					28		
29					20/1	29	П	寸	30	20/1					30		
		KVA							KV	A SUMMA	RY		•				
LOAD SUMMARY		A	В	С	1						TOTAL		DEMAND	1			
REC	EPTACLES	R 0.000	0.000	0.000	<u> </u>						0.000		0.000				
		L 0.000		0.000	-1						0.000	1.000	0.000	<b>≟</b>			
IVA		H 1.000		0.000	-1						2.000		1.900				
TH		0.100		0.000	-1						0.200		0.200	4			
		E 0.000		0.000	-1						0.000		0.000				
	AL KVA	1.100	1.100	0.000	1						2.200		2.100	TOTAL ESTIMATE KVA			
VOLTS / PHASE		120	120	120							208		208	SYSTEM VOLTAGE			
\MF	S / PHASE	9.167	9.167	0.000	]						6.107		5.829	AMPS			

NΕ	N	MAIN: SIZI	MCB					PANEL LOCATION: MAIN LEVEL N.WING AREA A CLOSET						
PNL RP2A		BUS RATING: 200 A								FEEDER S	SIZE:	200A		
		VOLTAGE: 120 / 208 V 3 Ø, 4 W						IRE				MDP		
		MOUNTING							AMPS:	10KAIC				
скт	CIRCUIT DESCRIPTION	L	OAD (kVA)		AMPS /	CKT	LOAD TYPE	CKT	TAMPS /	LOAD (kVA		<del></del>	CIRCUIT DESCRIPTION	CK
#	<u> </u>	Α		С	POLES	#		#	POLES	Α		С	Ontoon Deporting Trong	#
1	NORTH OFFICES, CONF. LTS	1.289			20/1	1	L R		20/1	0.720			OFFICE 228,230 REC	2
3	N. CORR., SUPER, CONF, STAIR LTS		1.284		20/1	3	L R	4	20/1		0.720		OFFICE 224,226 REC	4
5	SPARE				20/1	5	R	6	20/1			0.720	OFFICE 220,222 REC	6
7	OFFICE 212B REC	0.540			20/1	7	RR	8	20/1	0.720			OFFICE 221, 223 REC	8
9	RECEPTION & LOUNGE 212 REC		0.720		20/1	9	RR	10	20/1		0.720		OFFICE 225,227 REC	1
11	CONF. 212, SUPER TV REC			0.360	20/1	11	RR	12	20/1			0.720	OFFICE 229,231 REC	1
13	CONF. 212 WALL/FB REC	0.900			20/1	13	RR	14	20/1	0.720			OFFICES CORRIDOR REC	1
15	SUPERINTENDANT CONV. REC		0.540		20/1	15	RR	_	20/1		0.900		ADMIN CONF. RM WEST REC	1
	SUPERINTENDANT DESK REC			0.180	20/1	17	RR		20/1		1 2 2	0.720	ADMIN CONF. RM EAST REC	1
	SUPERINTENDANT FRIDGE REC	0.180			20/1	19	RR	_	20/1	0.360			ADMIN CONF. RM TV REC	1 2
	SUPERINTENDANT COFFEE REC		0.180		20/1	21	RR	_	20/1	,	0.720		ADMIN CONF. RM FB REC	
	WORK ROOM CONV. REC		01100	0.360	20/1	23	RR		20/1			0.720	CORRIDOR 201 REC.	1 2
	RPSS OFFICE PRINTER REC	0.180			20/1	25	RR	-	20/1	0.360			RPSS OFFICE POWER POLE 1	2
	WORK ROOM ABOVE COUNTER	0.100	0.180		20/1	27	RR	28	20/1	0.000	0.360		RPSS OFFICE POWER POLE 1	
29	WORK ROOM ABOVE COUNTER		0.100	0.180	20/1	29	RR	30	20/1		0.000	1.080	RPSS OFFICE TV/CONV. REC	1 3
31	CONFERENCE RM / TLT RM REC	0.540		0.100	20/1	31	RR	32	20/1	0.540		1.000	RPSS PRIVATE OFFICE REC	1 3
33	TOILET 203 REC	0.540	0.180		20/1	33	RR	34	20/1	0.540	0.360		CAREER OFFICE POWER POLE 1	3
35	TOILET 205 REC		0.100	0.180	20/1	35	RR	_	20/1		0.300	0.360	CAREER OFFICE POWER POLE 1	1 3
	EXHAUST FAN 3	0.190		0.100	20/1	37	HR	-	20/1	1.080		0.300	CAREER OFFICE TV/CONV. REC	+-
		0.190	0.700						<del> </del>	1.000	0.540			
39	CORRIDOR TABLE REC		0.720		20/1 20/	39 41	R R H R		20/1		0.540	0.180	CAREER PRIVATE OFFICE REC	4
	ACC-1					$\vdash$	_	-		0.000		0.160	CAREER OFFICE PRINTER REC	-
	ACC-1		0.050		2P	43	HR	_	20/1	0.360	0.000		RPSS OFFICE POWER POLE 2	4
	DOOR OPERATOR		0.050	0.400	20/1	45	OR	46	20/1		0.360	0.000	RPSS OFFICE POWER POLE 2	4
47	WORK ROOM COPIER REC		_	0.180	20/1	47	R R	48	20/1			0.360	CAREER OFFICE POWER POLE 2	4
	TLT BM XMER (STORAGE)	~~~~~~~~~~~~~~~~~~~~~~~~~~~~~~~~~~~~~~	$\sim$	<b>~~</b>	2001~	70	O R	50	20/1	0.360			CAREER OFFICE POWER POLE 2	5
	TV ROOM 216		0.360		20/1	51	R	52	20/1				SPARE	5
53	OP AND			$\sim$	20/1	<i>5</i> %_	<u> </u>	54	20/1				SPARE	5
LOAD SUMMARY		KVA						KVA SUMMARY			1			
		Α	В	С						TOTAL		DEMAND	-	
REC	EPTACLES R	7.560	7.560	6.300	4					21.420		15.710	4	
	ITING L	1.289	1.284	0.000						2.573	1.000	2.573		
HVA	С Н	0.190	0.000							0.190	0.950	0.181	4	
ОТН		0.050	0.050							0.100		0.100	<b>.</b>	
	TING E	0.000	0.000							0.000		0.000		
	AL KVA	9.089								24.283			TOTAL ESTIMATE KVA	
VOL	TS / PHASE	120	120	120	1					208			SYSTEM VOLTAGE	
	S / PHASE	75.742	74.117	52.500	I					67.405		51 529	AMPS	



SHEET NUMBER

E4.04

1 ADDENDUM 1

PROJECT NUMBER

CHECKED BY

2022006.1

PROJECT DATE
AUGUST 23, 2023

ISSUE FOR BID